


PLAN

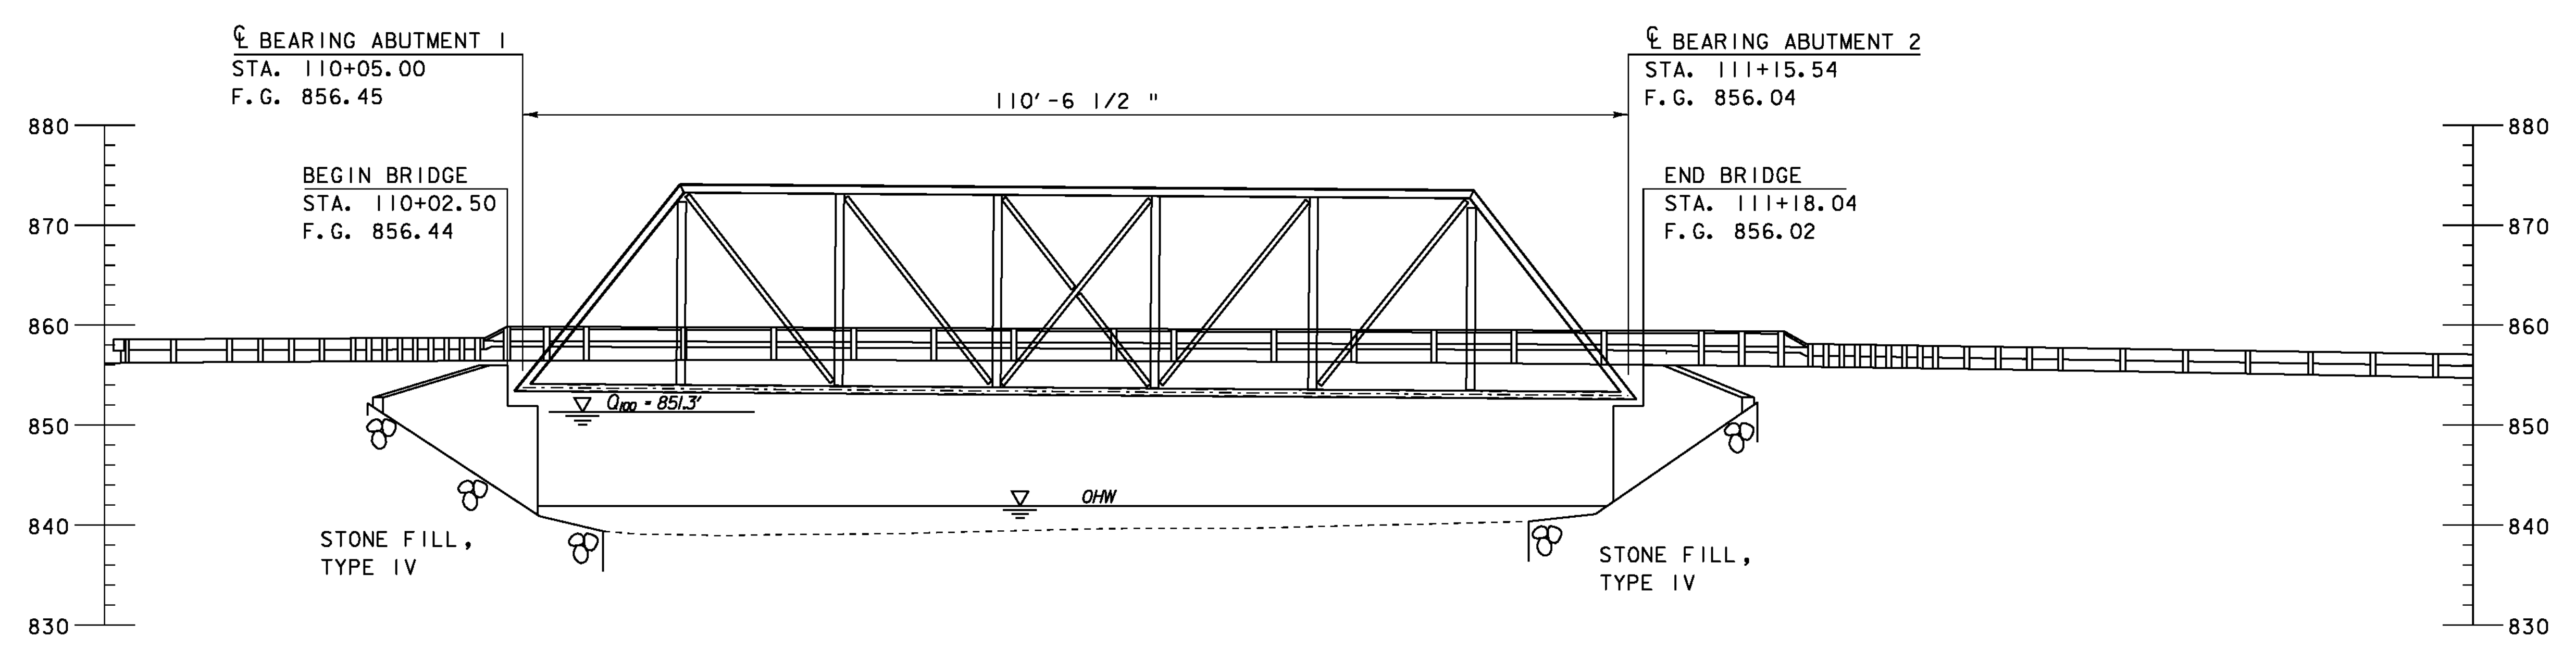

ELEVATION DOWNSTREAM FACIA

SCALE 1" = 10'-0"

PROJECT NAME: BRIDGEWATER	PLOT DATE: 31-DEC-2009
PROJECT NUMBER: BRS 0149(4)	DRAWN BY: J. SALVATORI
FILE NAME: s86e062pe.dgn	CHECKED BY: T. FILLBACH
PROJECT LEADER: K. HIGGINS	SHEET 17 OF 58
DESIGNED BY: T. FILLBACH	PLAN & ELEVATION