



29A
GRANGE VERY FINE SANDY LOAM
0 - 3% SLOPES
K = 0.49

64B
COLTAN FINE SANDY LOAM
3 - 8% SLOPES
K = 0.24

8A
AGAWAM FINE SANDY LOAM
0 - 3% SLOPES
K = 0.28

23
ONDAWA FINE SANDY LOAM
0 - 3% SLOPES
K = 0.24

23
ONDAWA FINE SANDY LOAM
0 - 3% SLOPES
K = 0.24

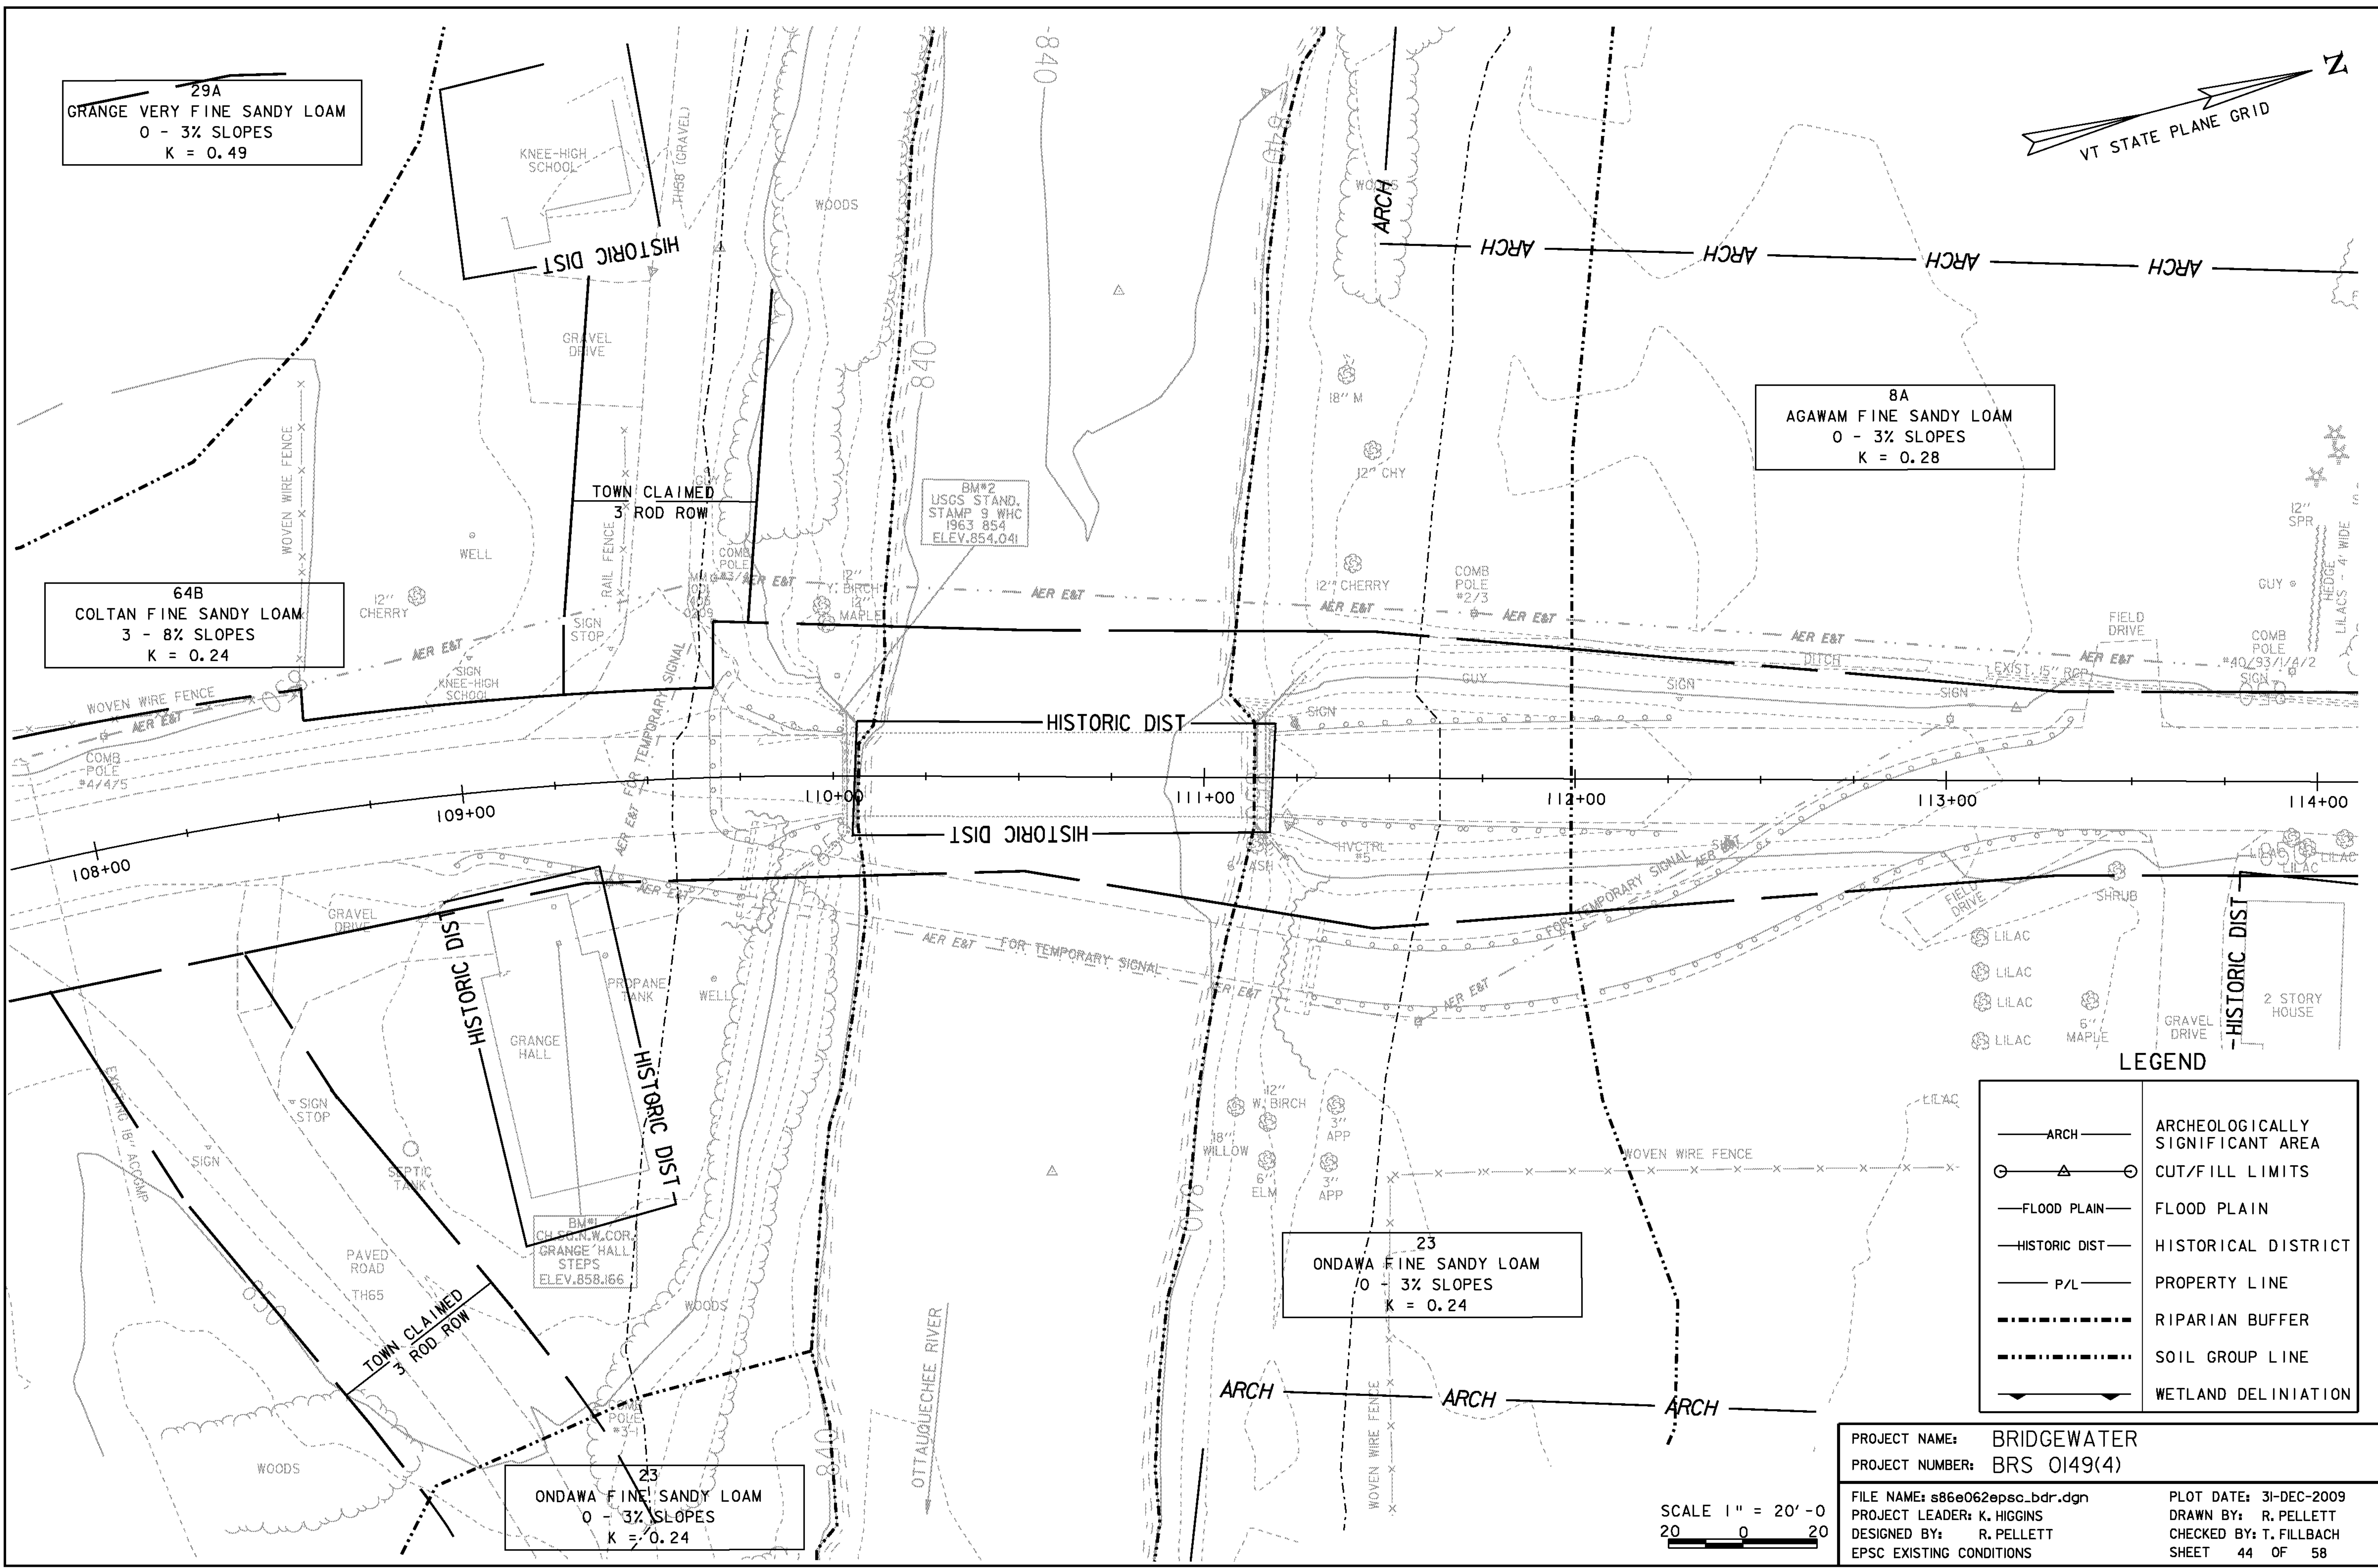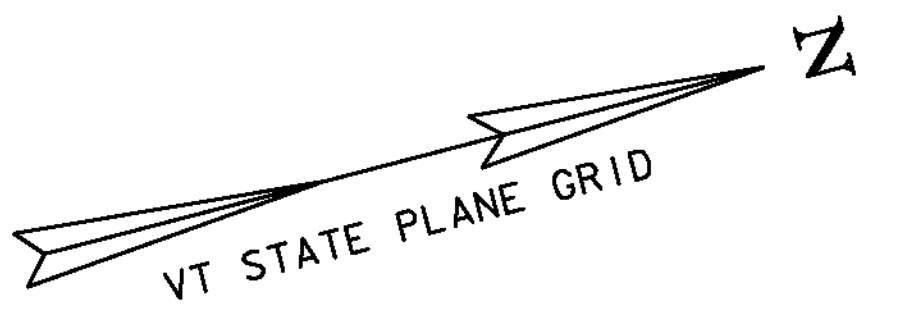

LEGEND

— ARCH —	ARCHEOLOGICALLY SIGNIFICANT AREA
○ — Δ — ○	CUT/FILL LIMITS
— FLOOD PLAIN —	FLOOD PLAIN
— HISTORIC DIST —	HISTORICAL DISTRICT
— P/L —	PROPERTY LINE
— - - - -	RIPARIAN BUFFER
— · · · · ·	SOIL GROUP LINE
— —	WETLAND DELINIATION

PROJECT NAME: BRIDGEWATER
 PROJECT NUMBER: BRS 0149(4)
 FILE NAME: s86e062epsc_bdr.dgn
 PROJECT LEADER: K. HIGGINS
 DESIGNED BY: R. PELLETT
 EPSC EXISTING CONDITIONS

PLOT DATE: 31-DEC-2009
 DRAWN BY: R. PELLETT
 CHECKED BY: T. FILLBACH
 SHEET 44 OF 58

SCALE 1" = 20' - 0
 20 0 20