


111+00

111+25

110+75

END BRIDGE  
 111+18.04

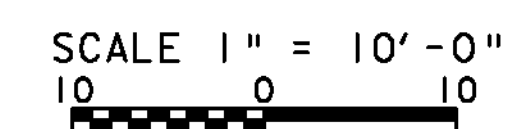

PROJECT NAME:	BRIDGEWATER	PLOT DATE:	31-DEC-2009
PROJECT NUMBER:	BRS 0149(4)	DRAWN BY:	J. SALVATORI
FILE NAME:	s86e062xs.dgn	DESIGNED BY:	T. FILLBACH
PROJECT LEADER:	K. HIGGINS	CHECKED BY:	T. FILLBACH
DESIGNED BY:	T. FILLBACH	MAINLINE SECTIONS #4	SHEET 52 OF 58