




111+75

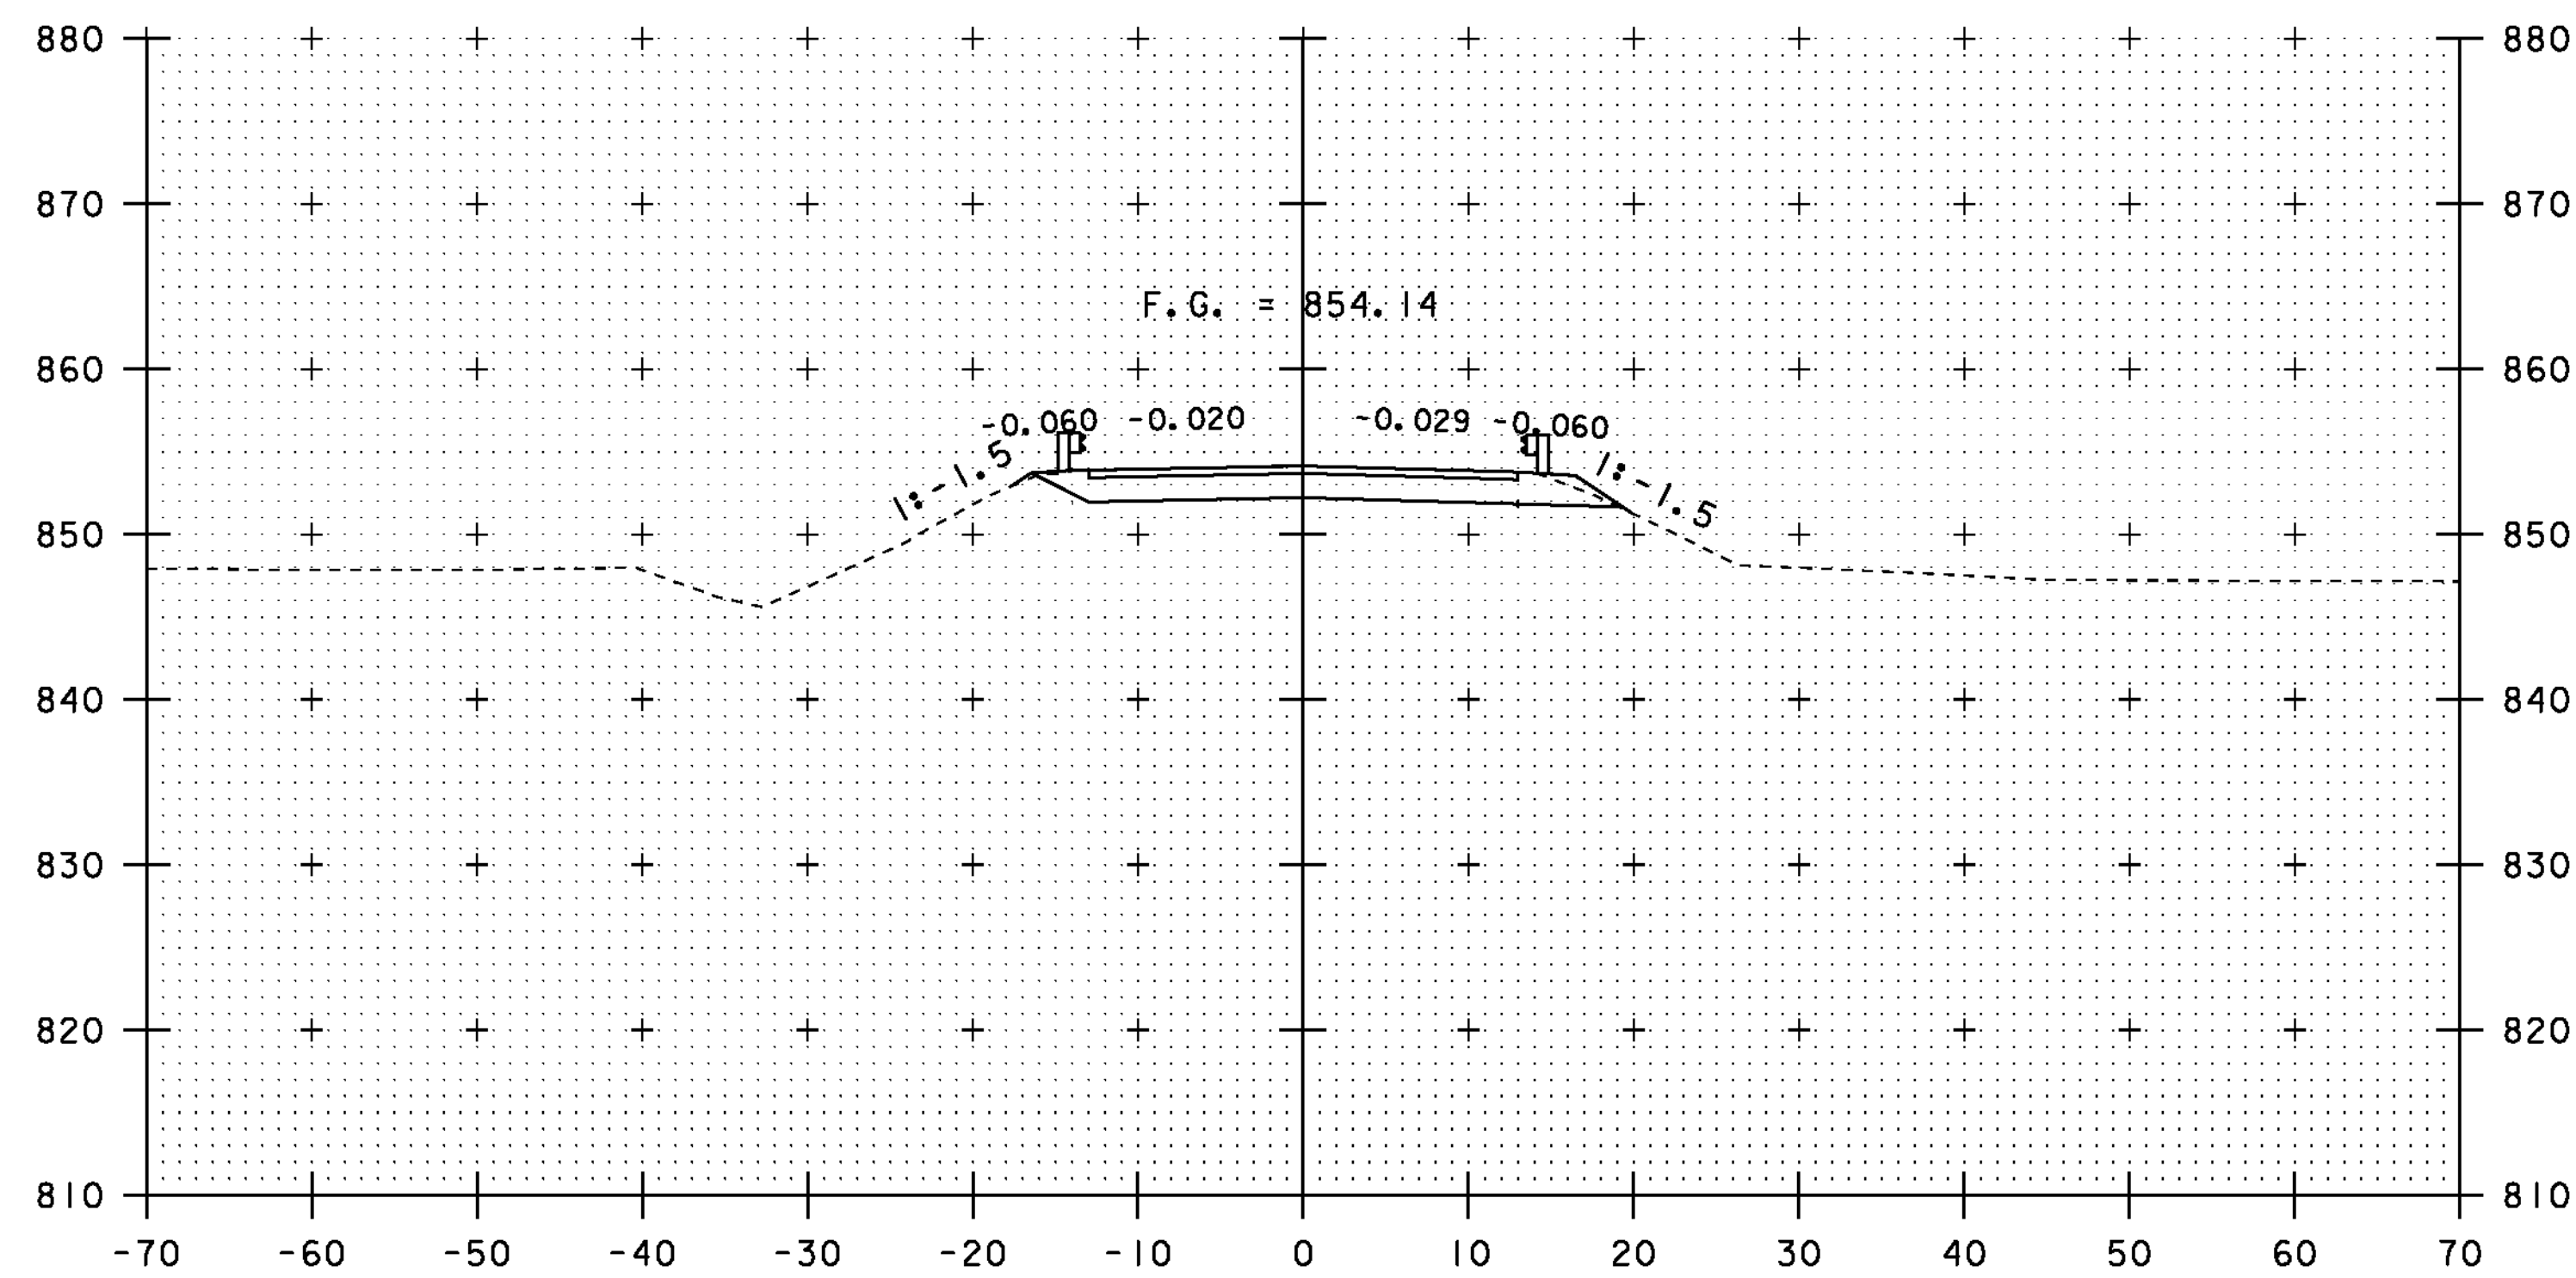

112+25

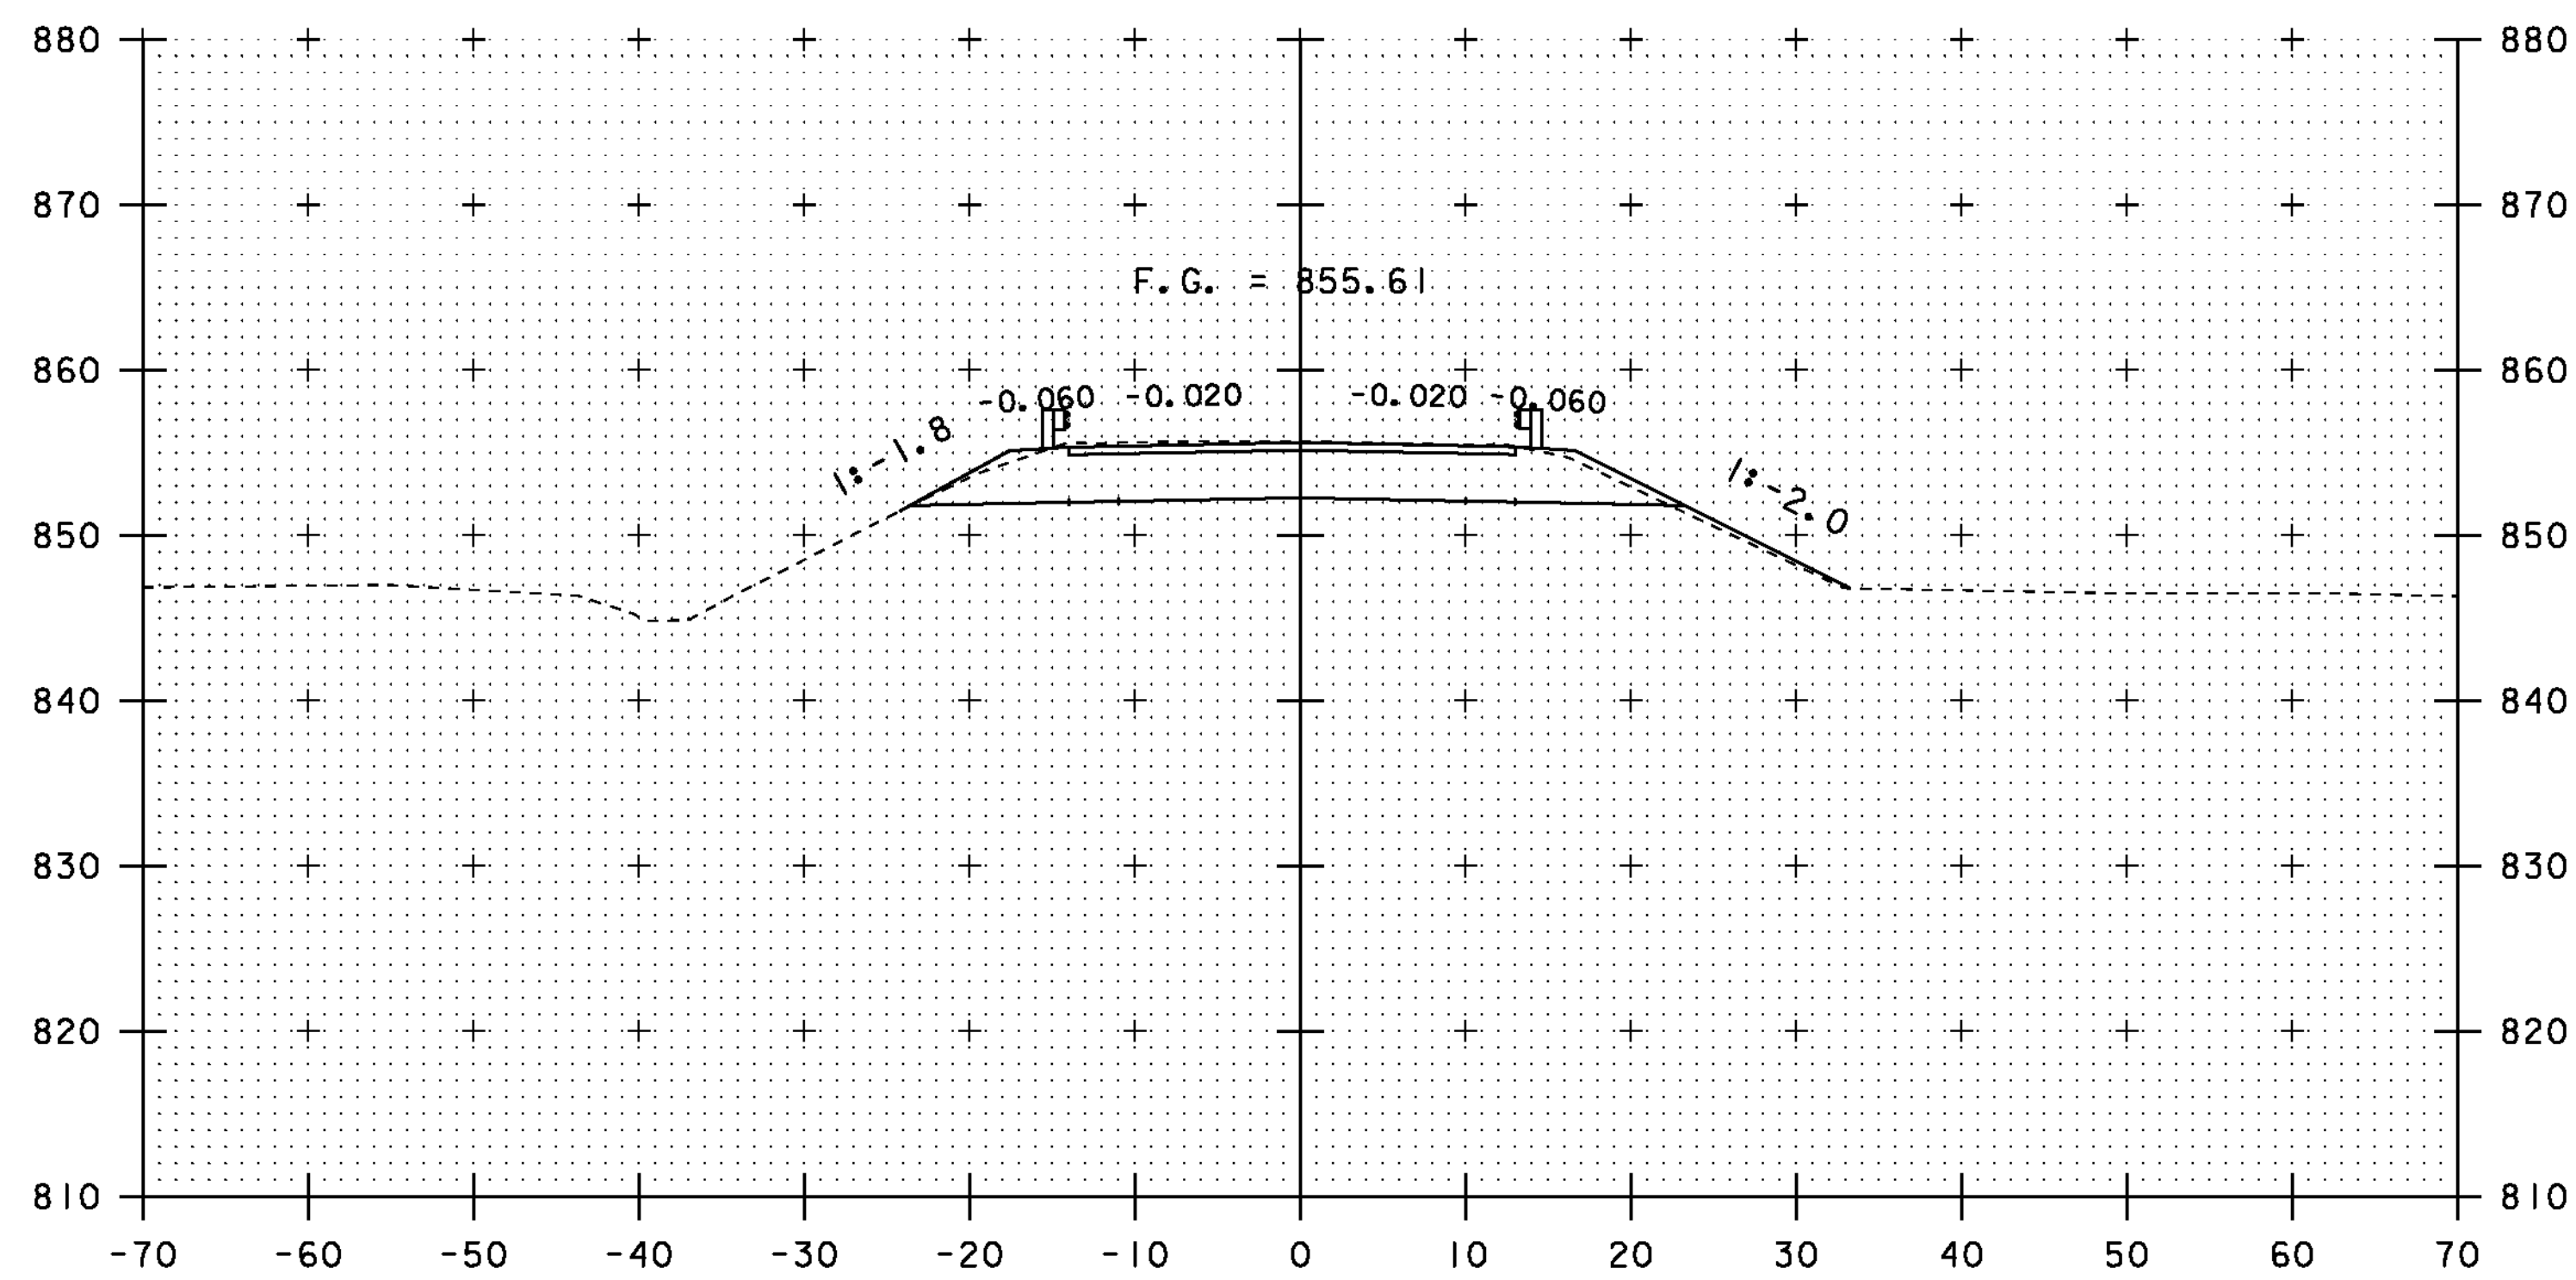

111+50

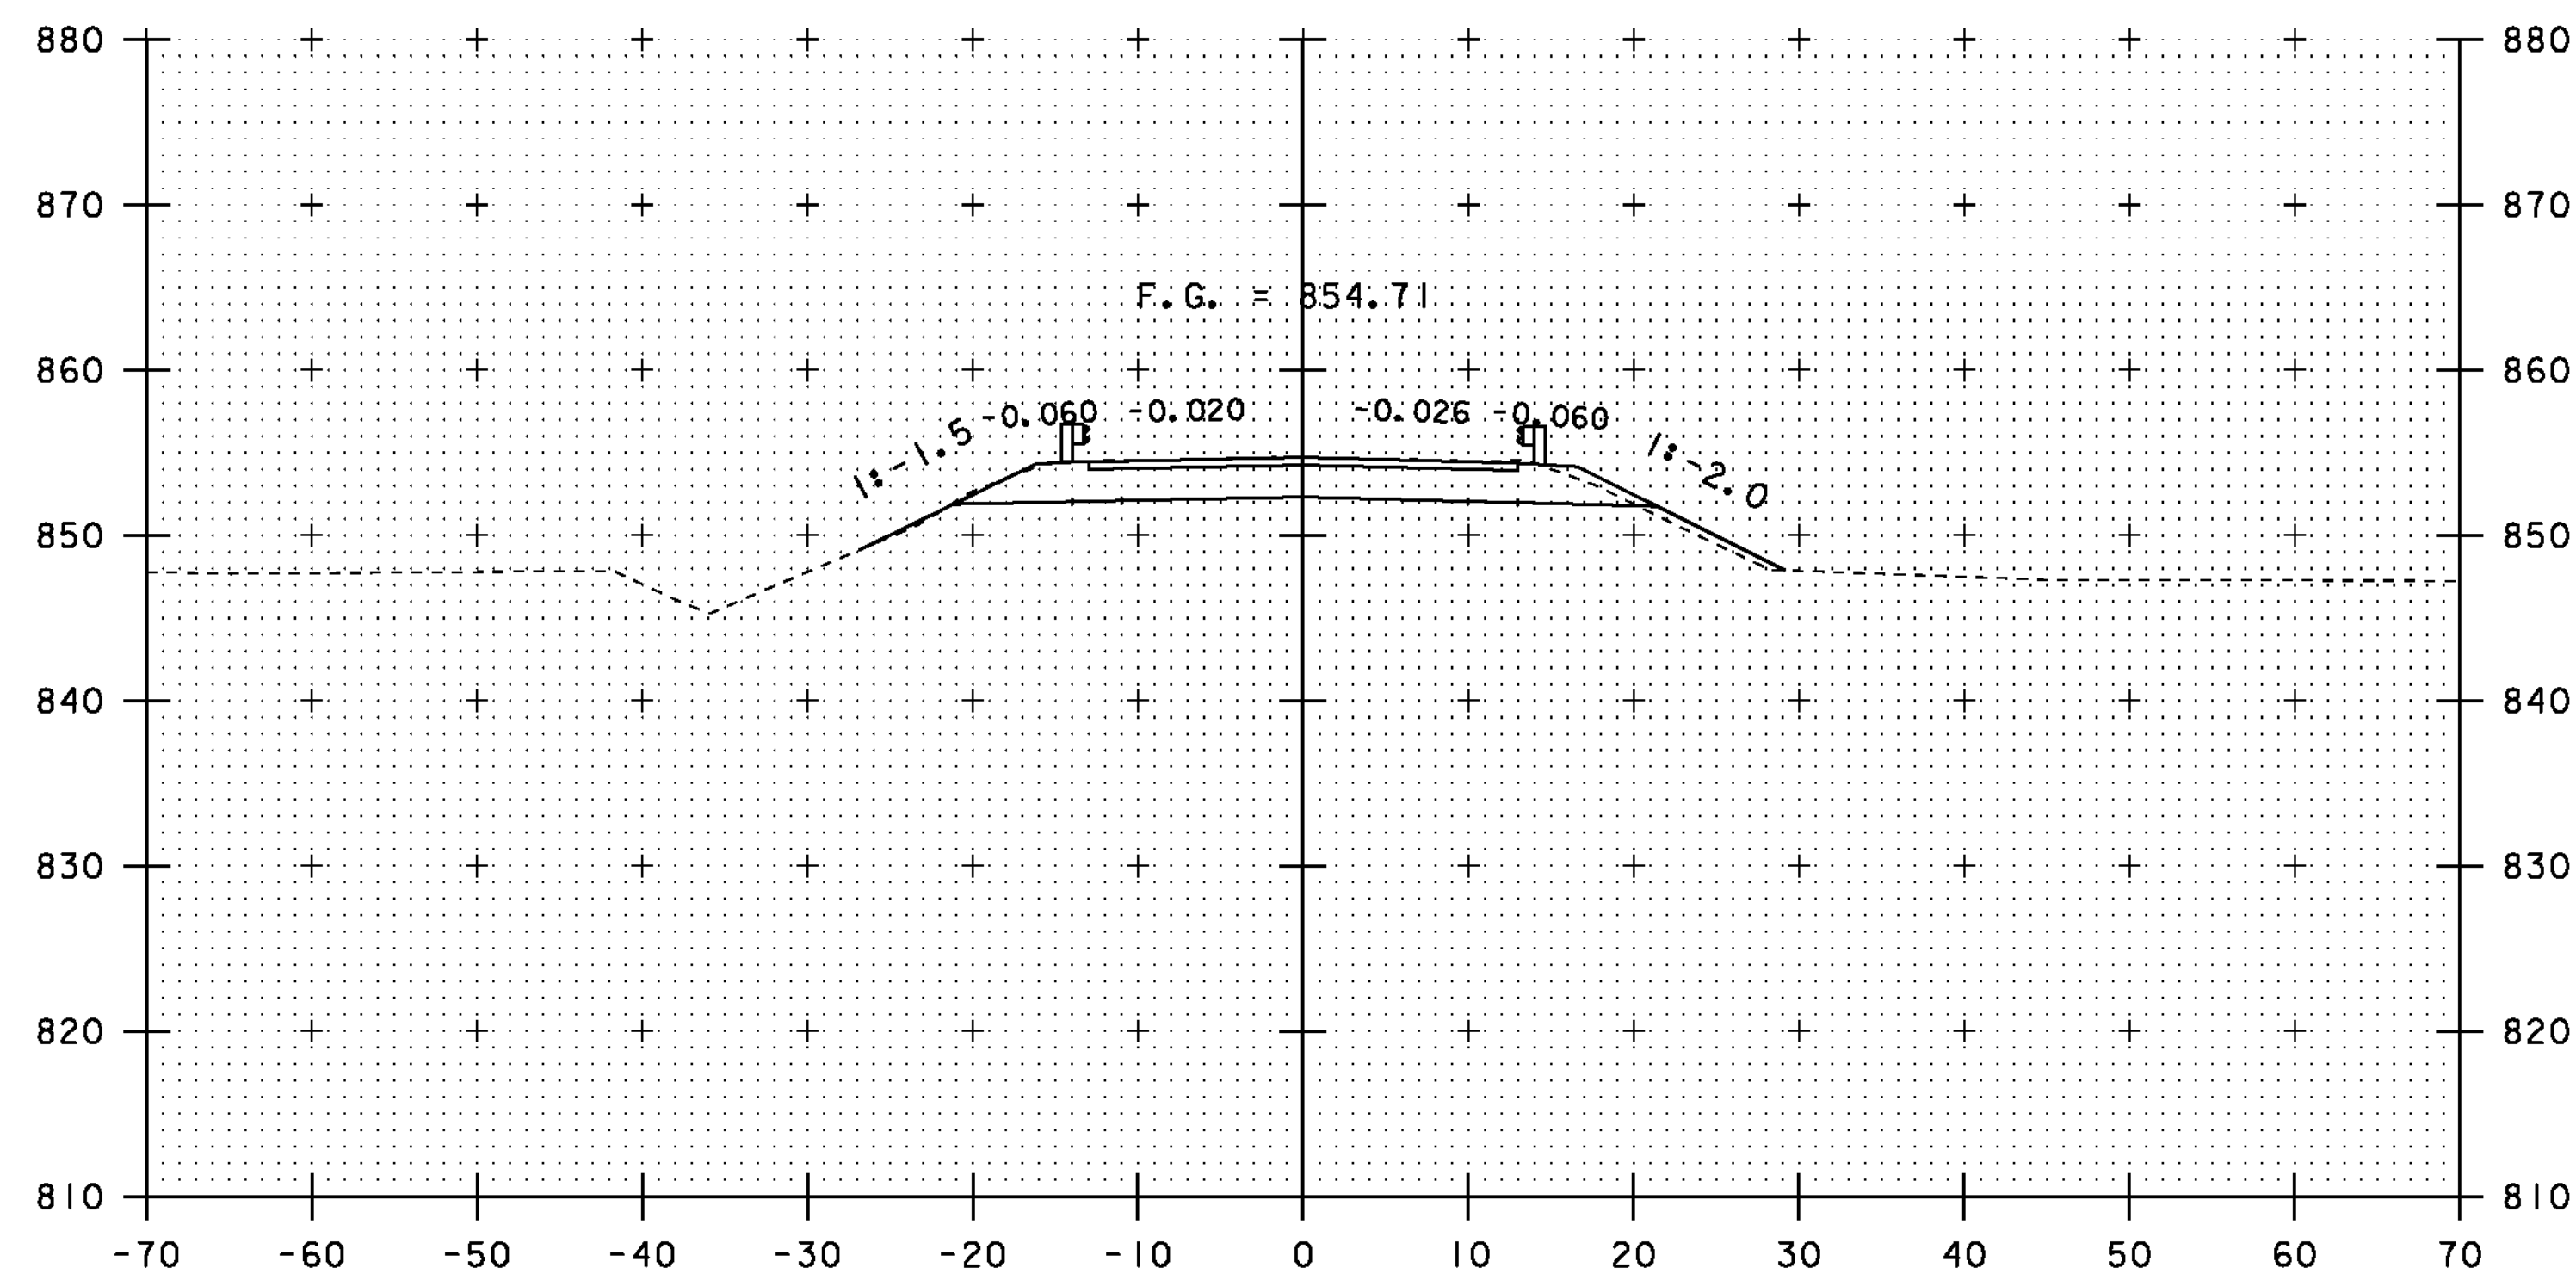

END PROJECT
112+00

SCALE 1" = 10' - 0"
10 0 10

PROJECT NAME:	BRIDGEWATER	PLOT DATE:	31-DEC-2009
PROJECT NUMBER:	BRS 0149(4)	DRAWN BY:	J. SALVATORI
FILE NAME:	s86e062xs.dgn	DESIGNED BY:	T. FILLBACH
PROJECT LEADER:	K. HIGGINS	CHECKED BY:	T. FILLBACH
DESIGNED BY:	T. FILLBACH	MAINLINE SECTIONS #5	SHEET 53 OF 58