




610+25

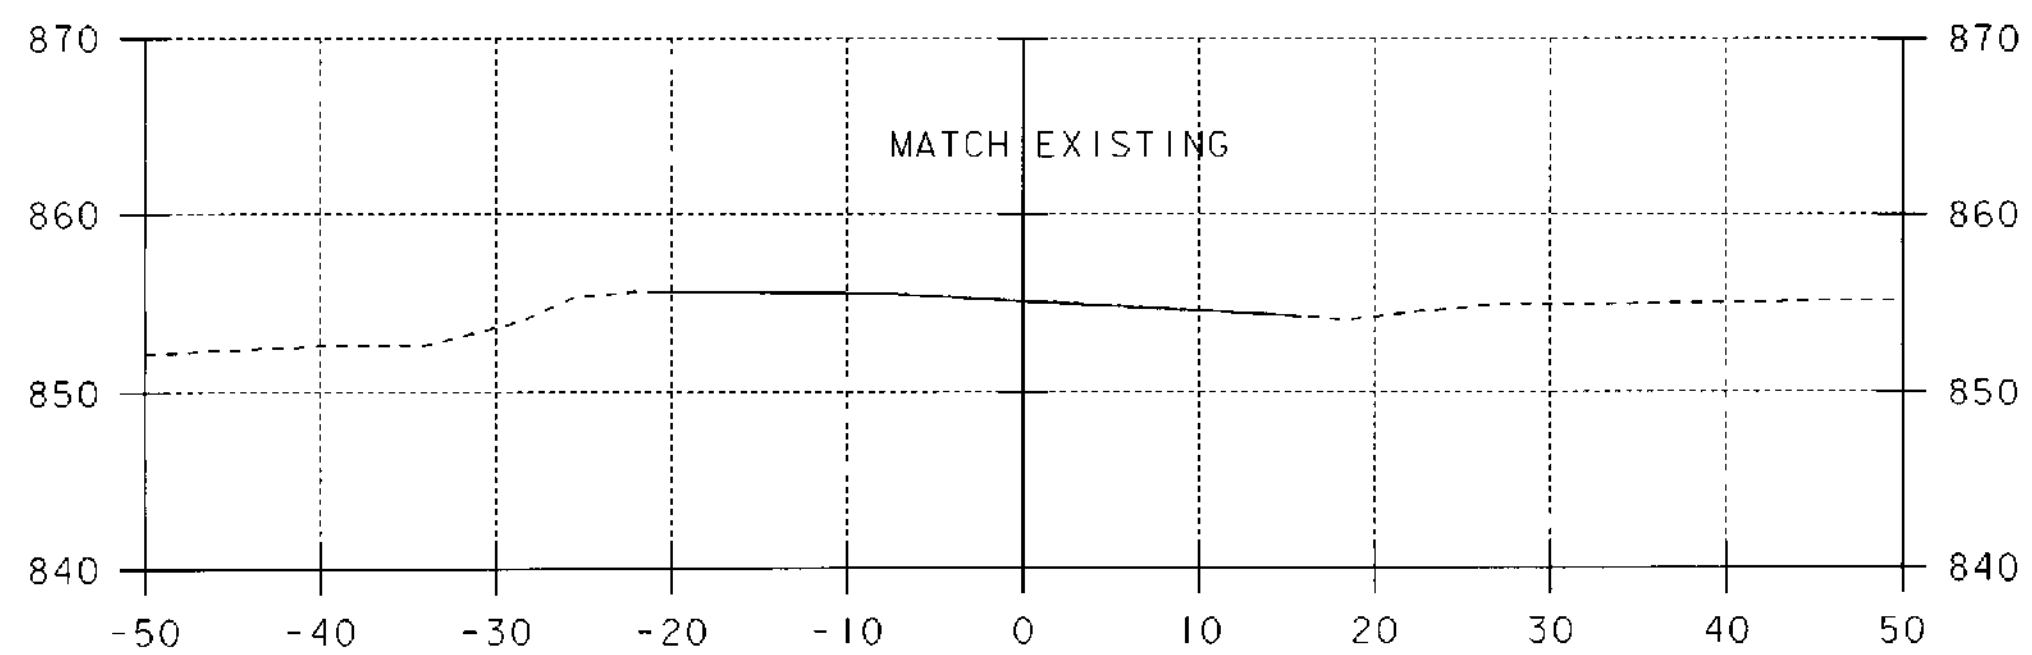


610+00

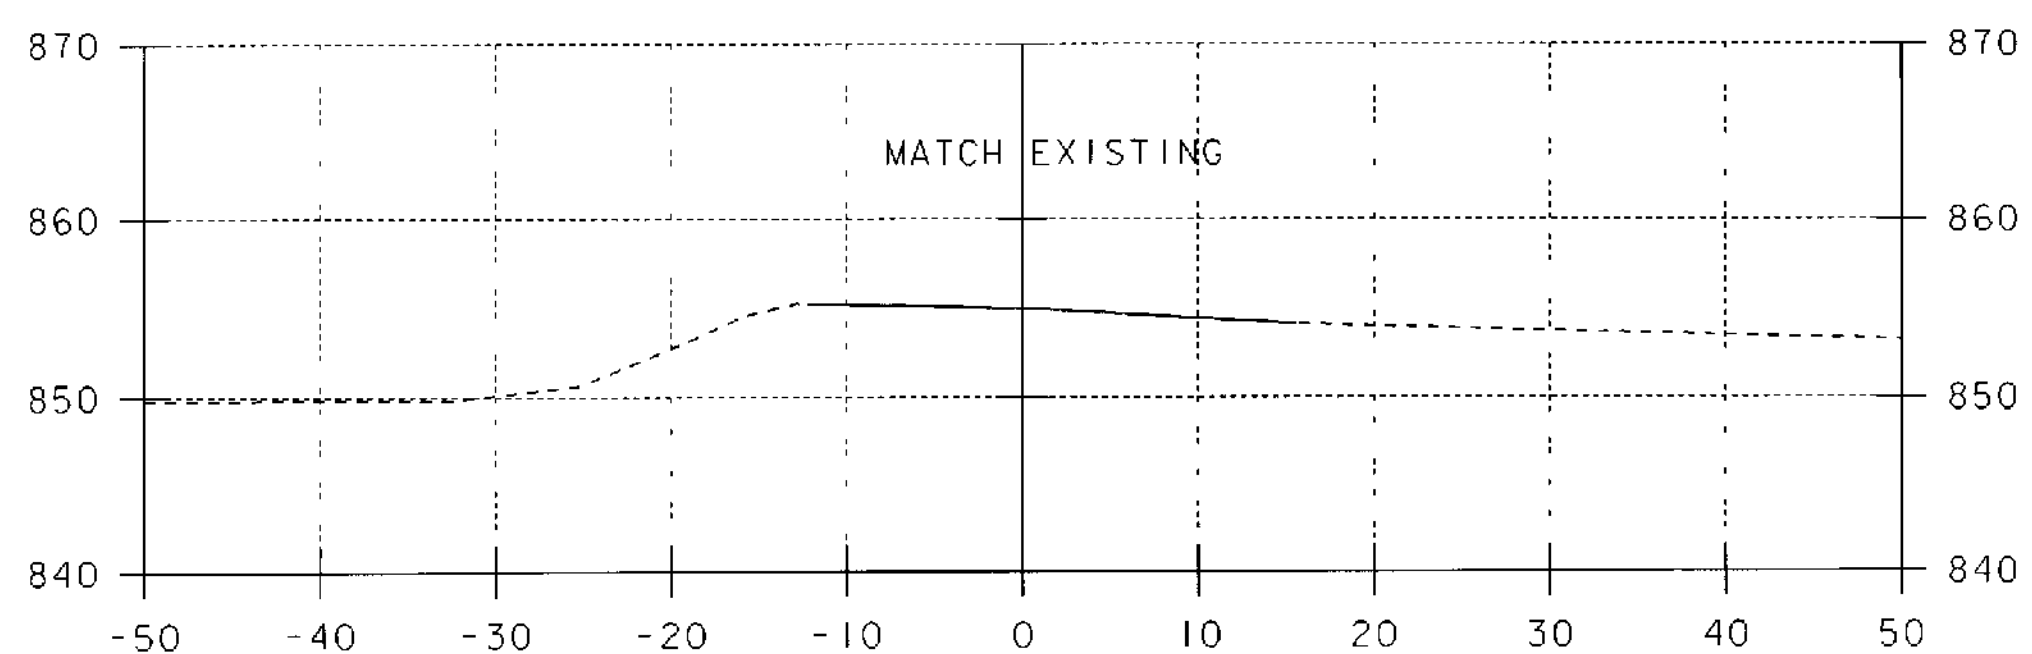


609+50

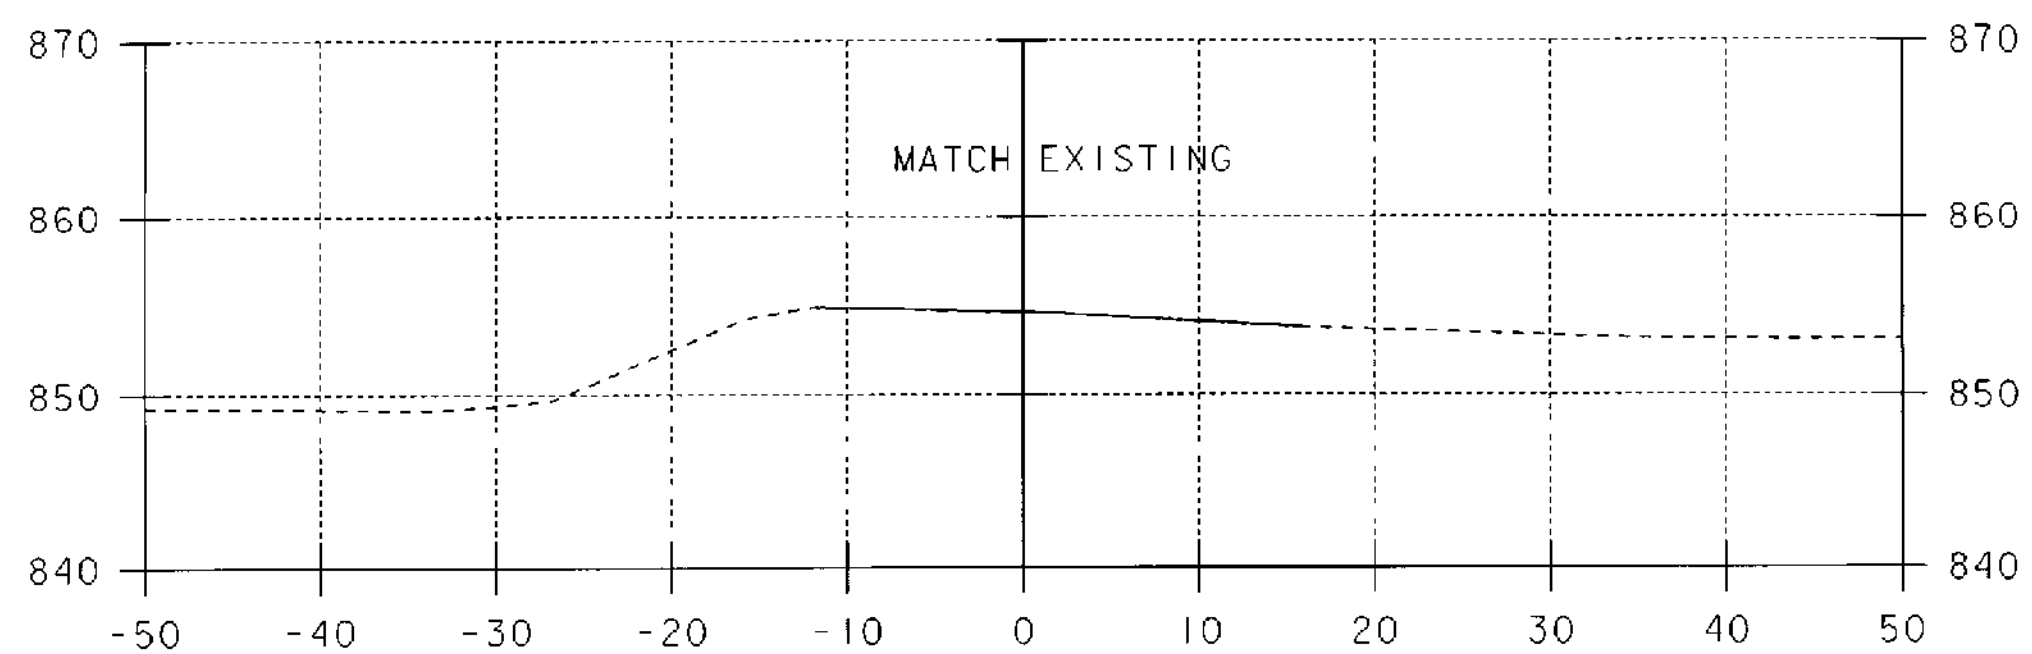


609+00

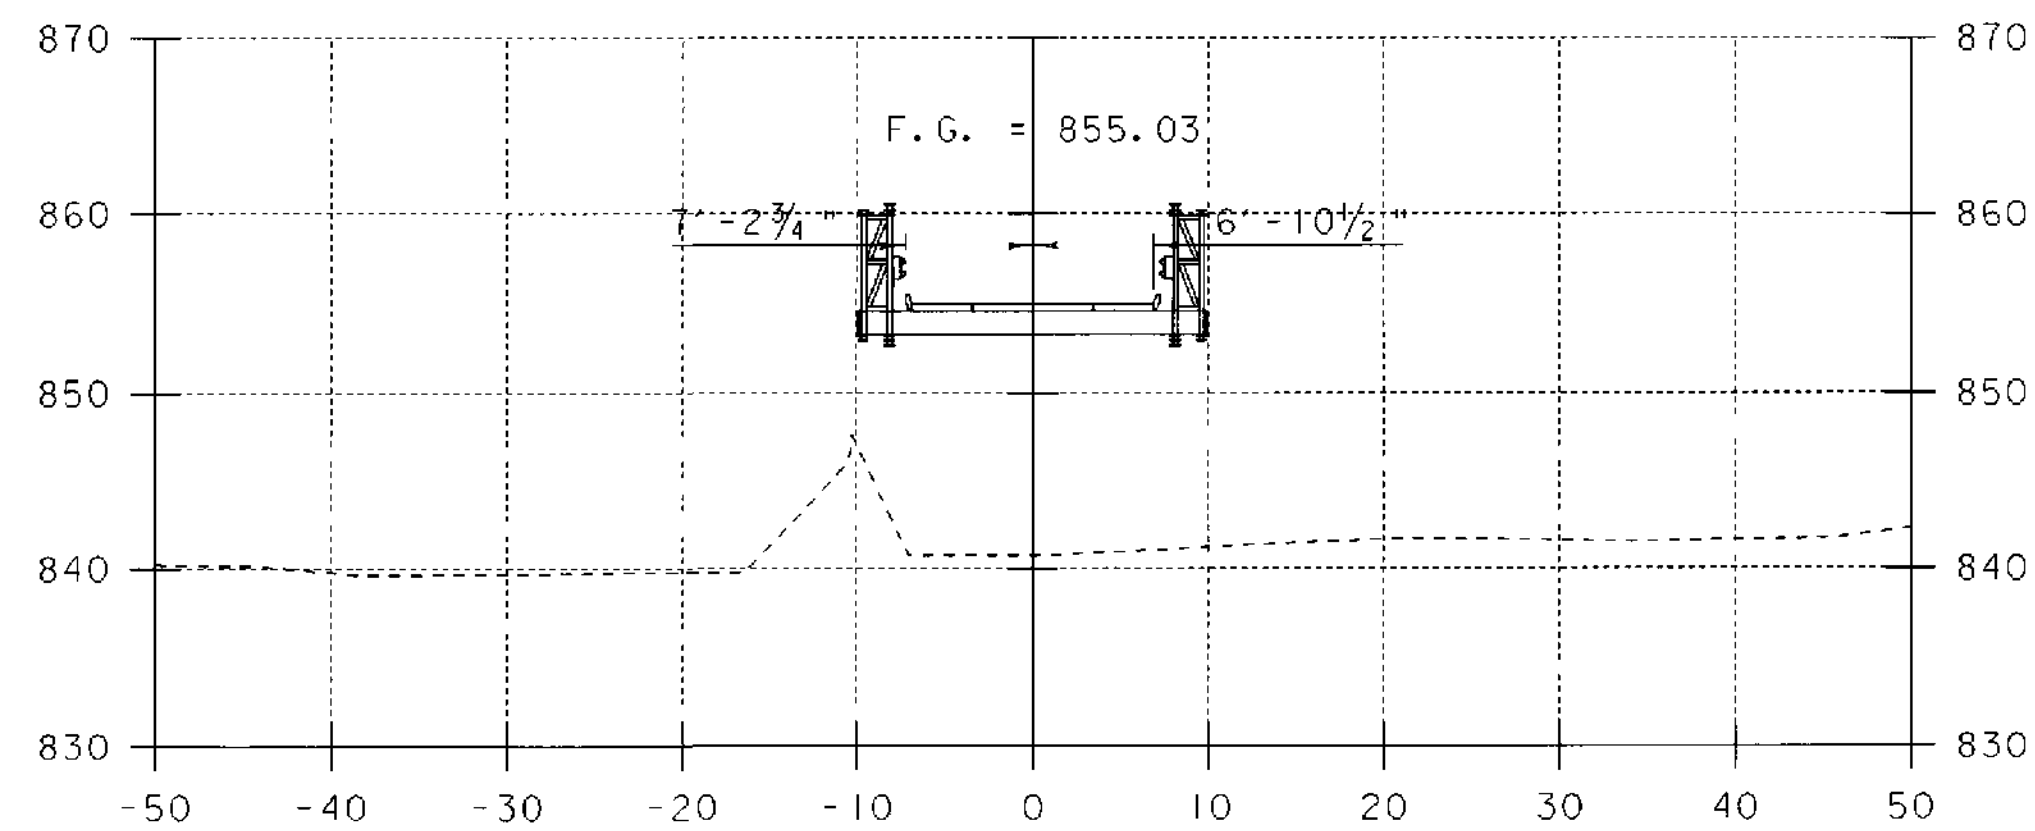


611+00

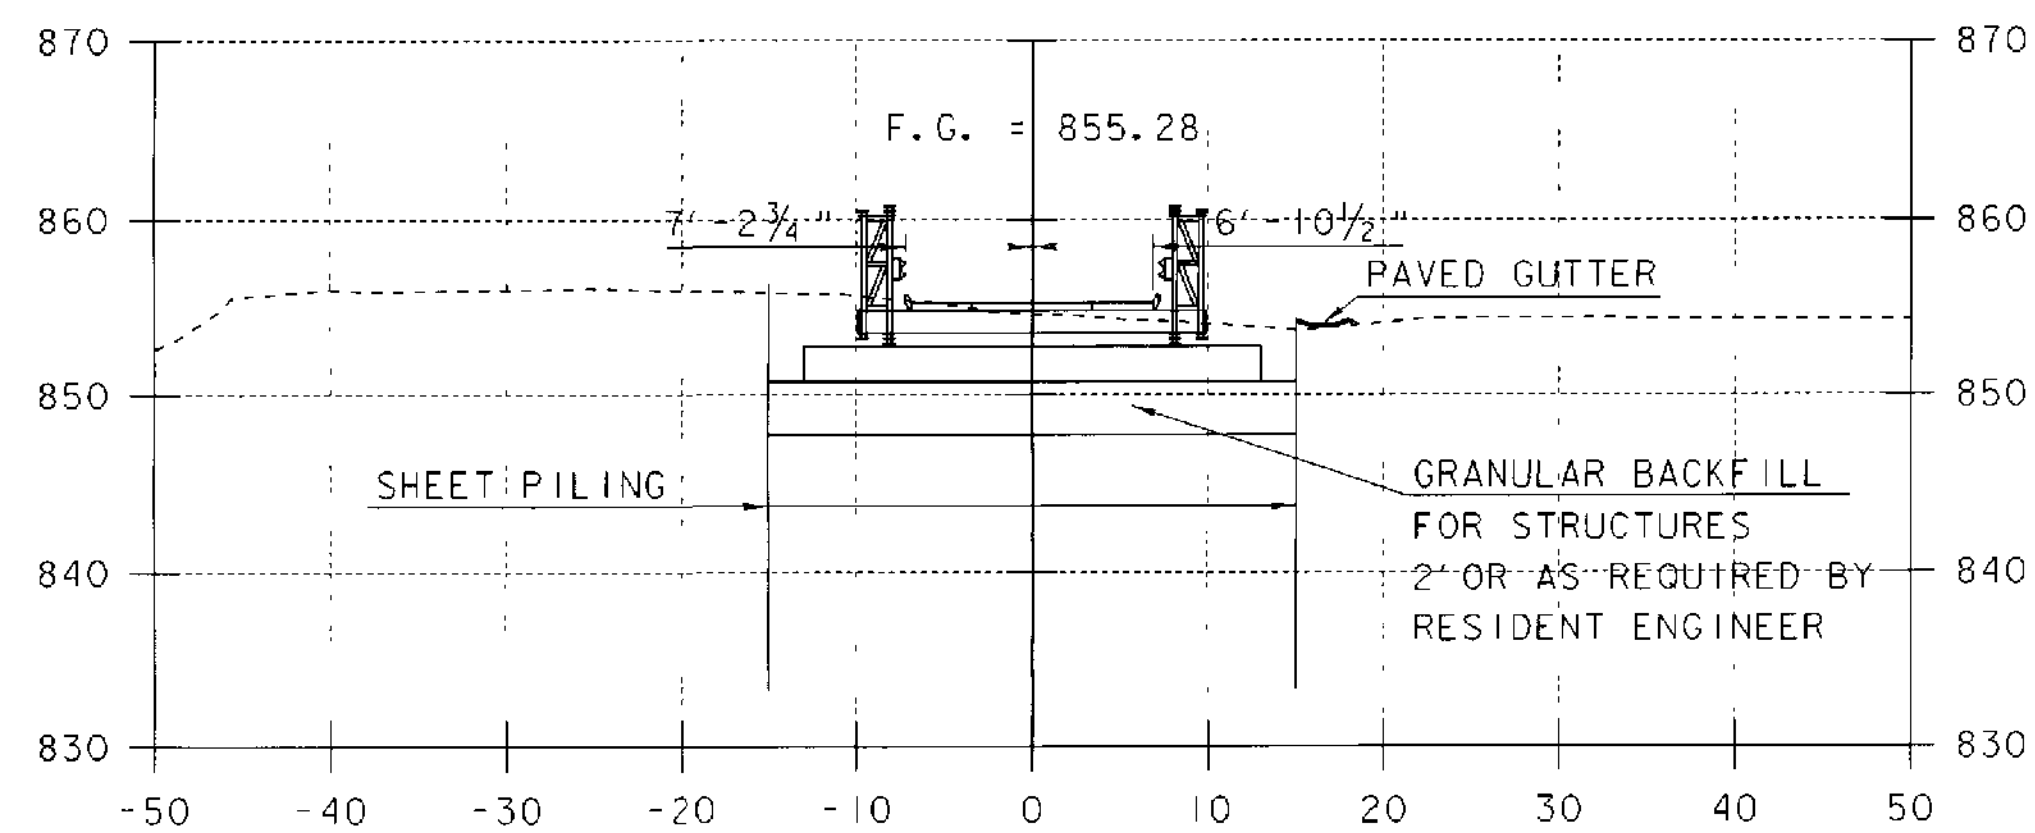

610+75

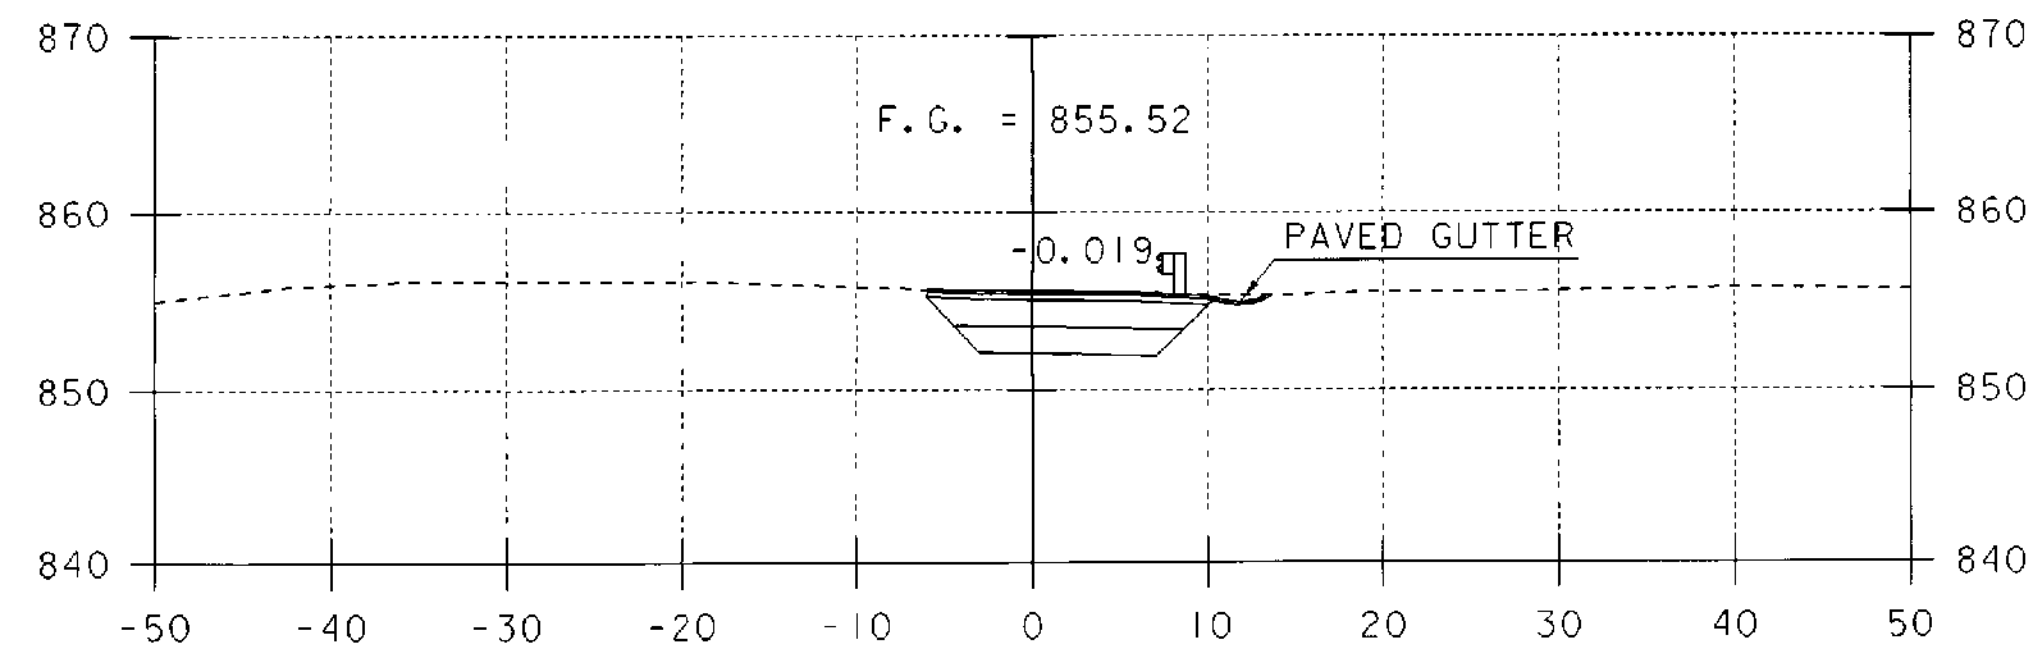

610+50

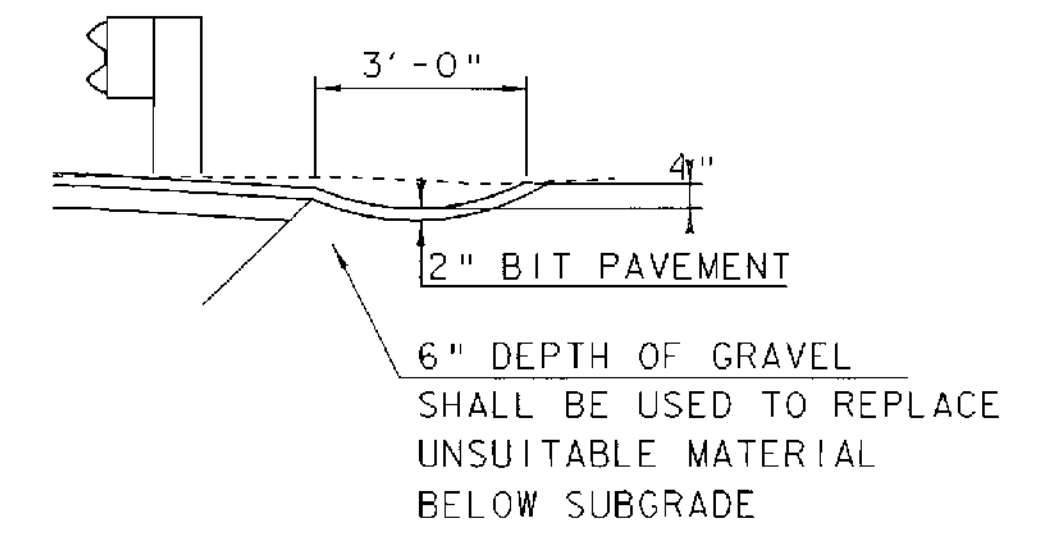

PAVED GUTTER
CROSS SECTION

NOT TO SCALE

TEMPORARY BRIDGE CROSS SECTIONS

PROJECT NAME: BRIDGEWATER
PROJECT NUMBER: BRS 0149 (4)

FILE NAME: /s/tr5/86e062/se062xs.dgn PLOT DATE: 14-SEP-2005
PROJECT LEADER: C. KELLER DRAWN BY: T. FILLBACH
DESIGNED BY: T. FILLBACH CHECKED BY: T. SUMNER
se062xs1.i SHEET 15 OF 18