


DIRECTIONS FOR SETTING AND DETACH OF  
PILE SINK BARS AS ABUTMENT No. 1

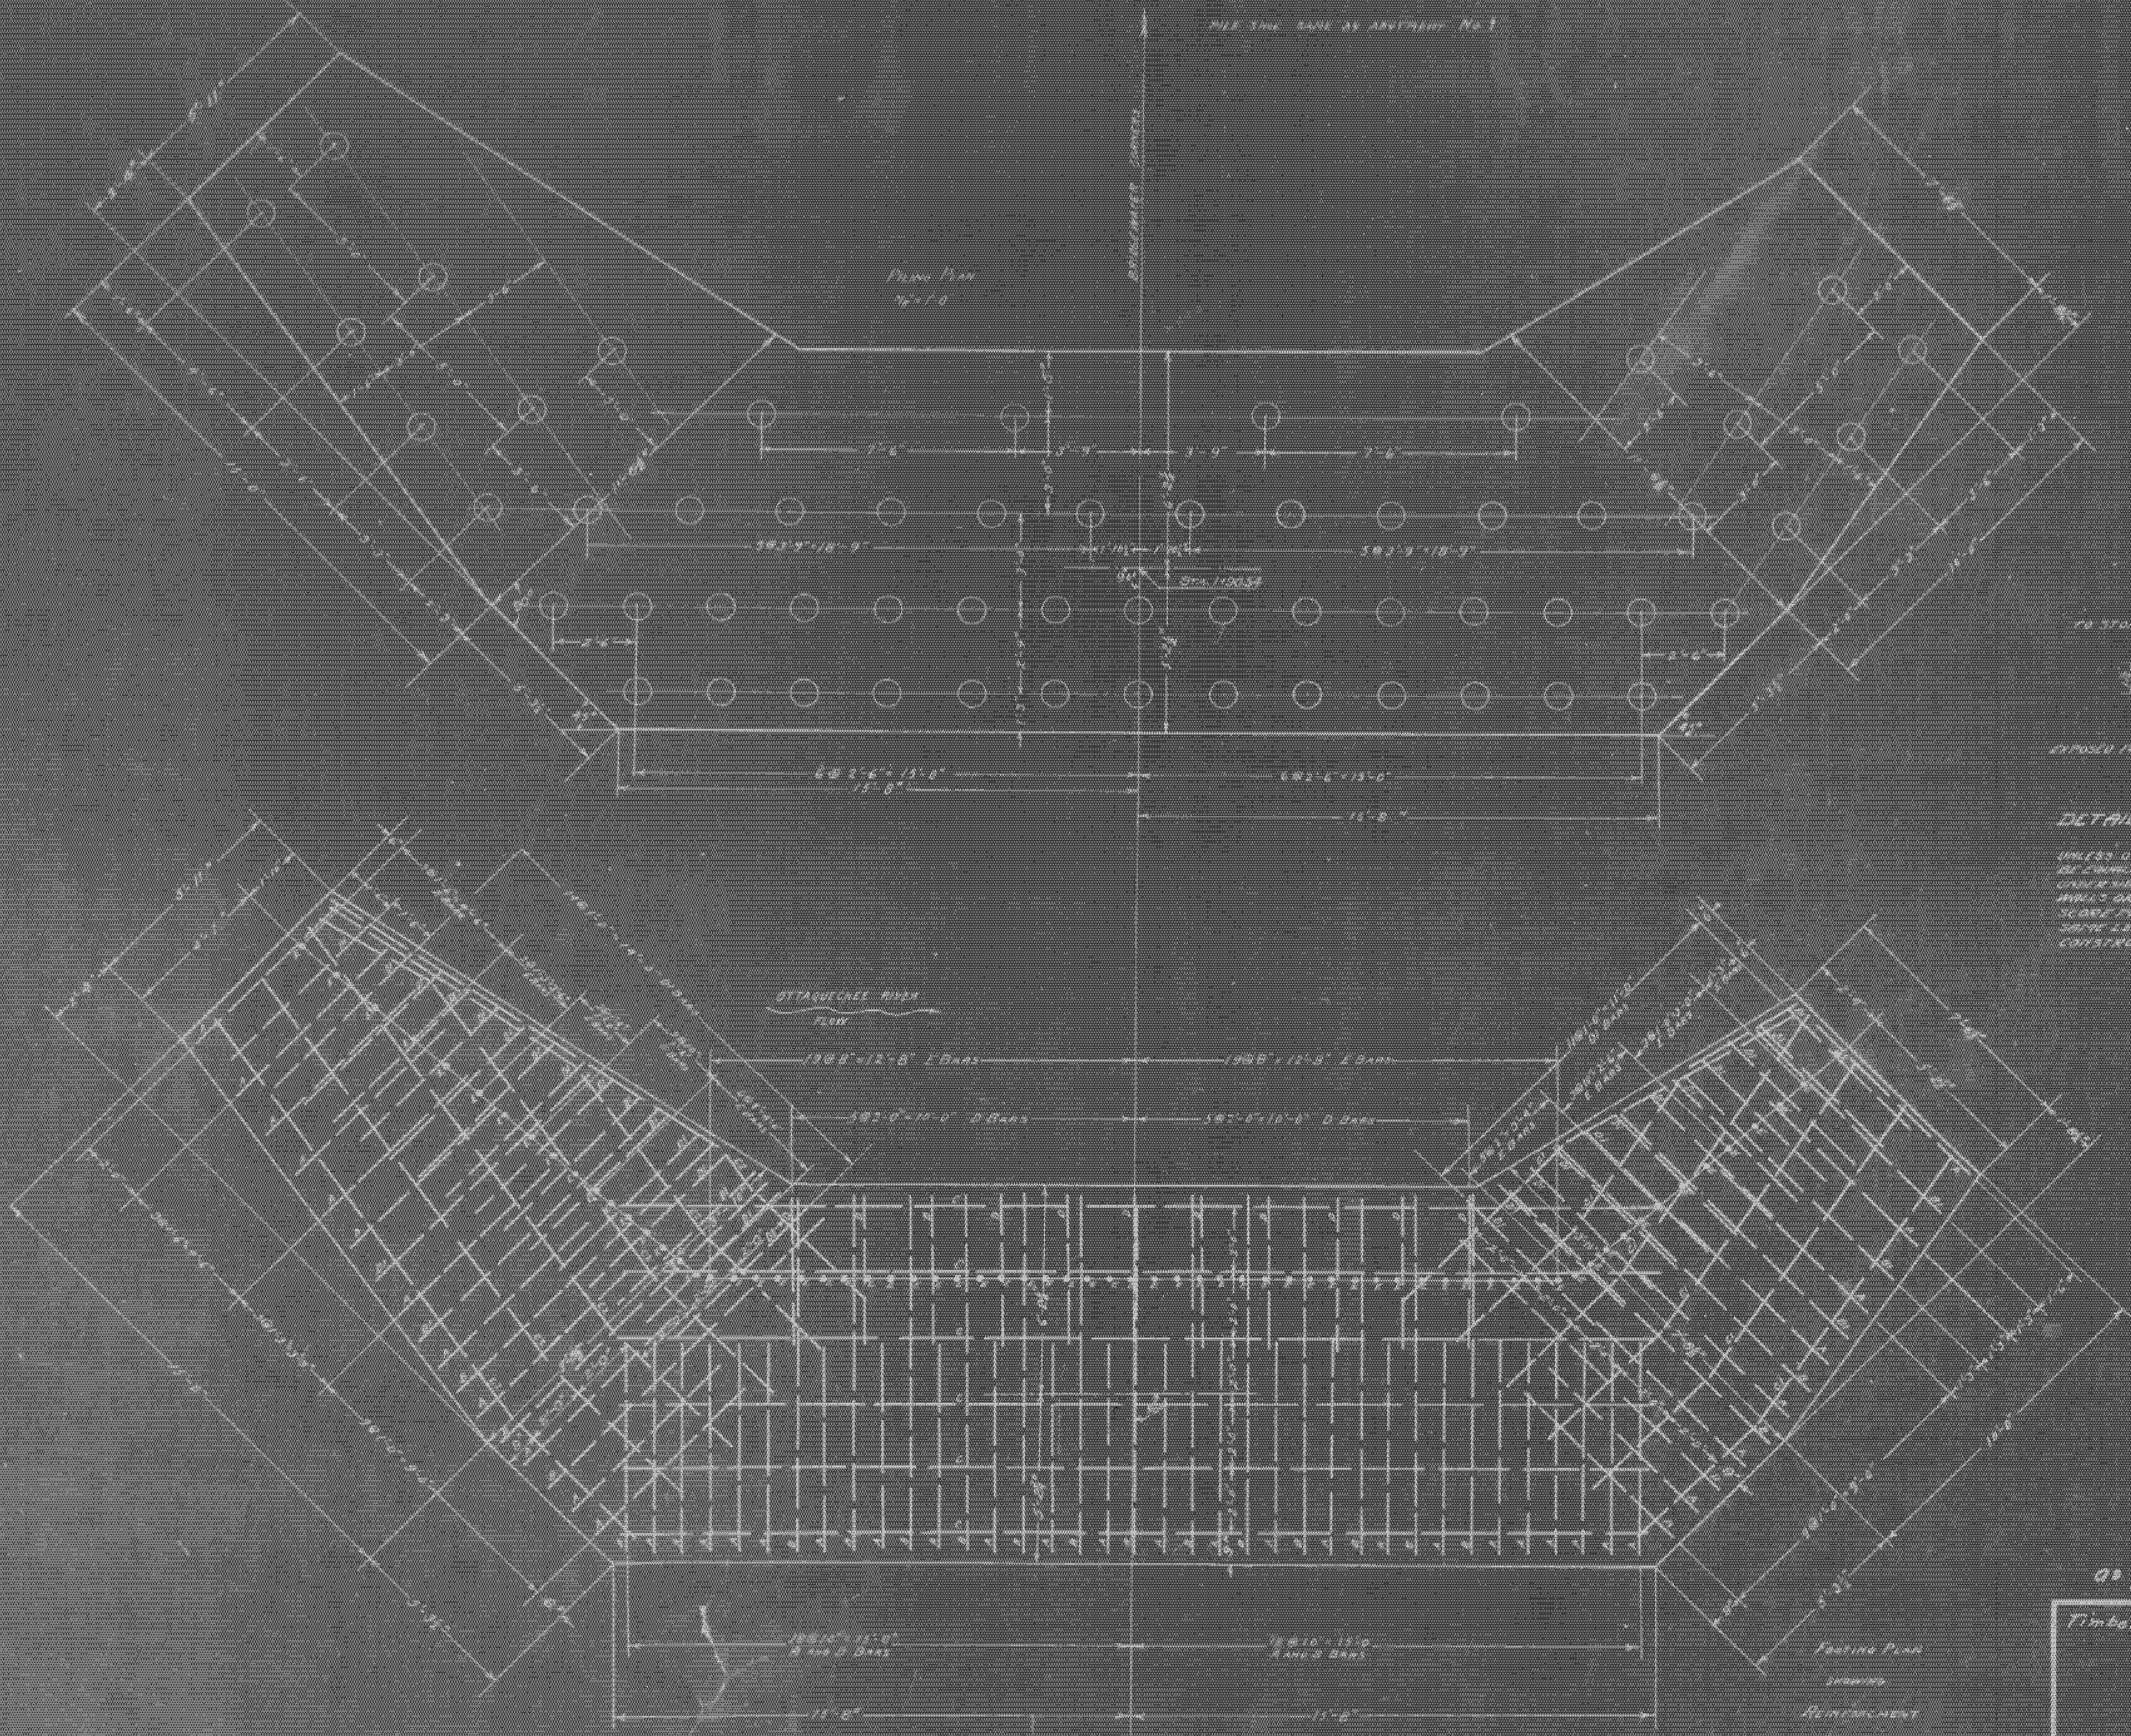

**DETAILS - SCORE MARKS & CONSTRUCTION JOINTS  
PIERS AND ABUTMENTS**  
UNLESS OTHERWISE DIRECTED BY THE CONTRACTOR, SCORE MARKS SHALL BE CAREFULLY SPACED PERIODICALLY AT ABOUT 2'-0" TO 3'-0" TO STOP AT CORNERS OF WALLS AND SHALL BE CARVED THROUGH TOPS OF WALLS OR PILES'S SURFACE AND NOT BE EXPOSED TO WIND. SCORE MARKS SHALL LINE HORIZONTALLY AND SHALL BE AT SAME LEVELS IN ALL PIERS AND ABUTMENTS ON THE JOB. CONSTRUCTION JOINTS MAY BE MADE AT ANY SCORE MARK.

ABUTMENT No. 2  
BRIDGE No. 79  
DISTRICT No. 5  
BRIDGEWATER, Vt.

as per plan.  
Timber piling 1009.1 Lx  
(or length 127)

Surveyed by Putnam  
Designed by Religan  
Drawn by Redgen  
Traced by Bennett  
Checked by W. J. H. H. H.  
Series 5 No. 79-109  
Sheet 6 of 11 Sheets

Footings Plan  
SHOWING  
REINFORCEMENT  
AS PER PLAN