

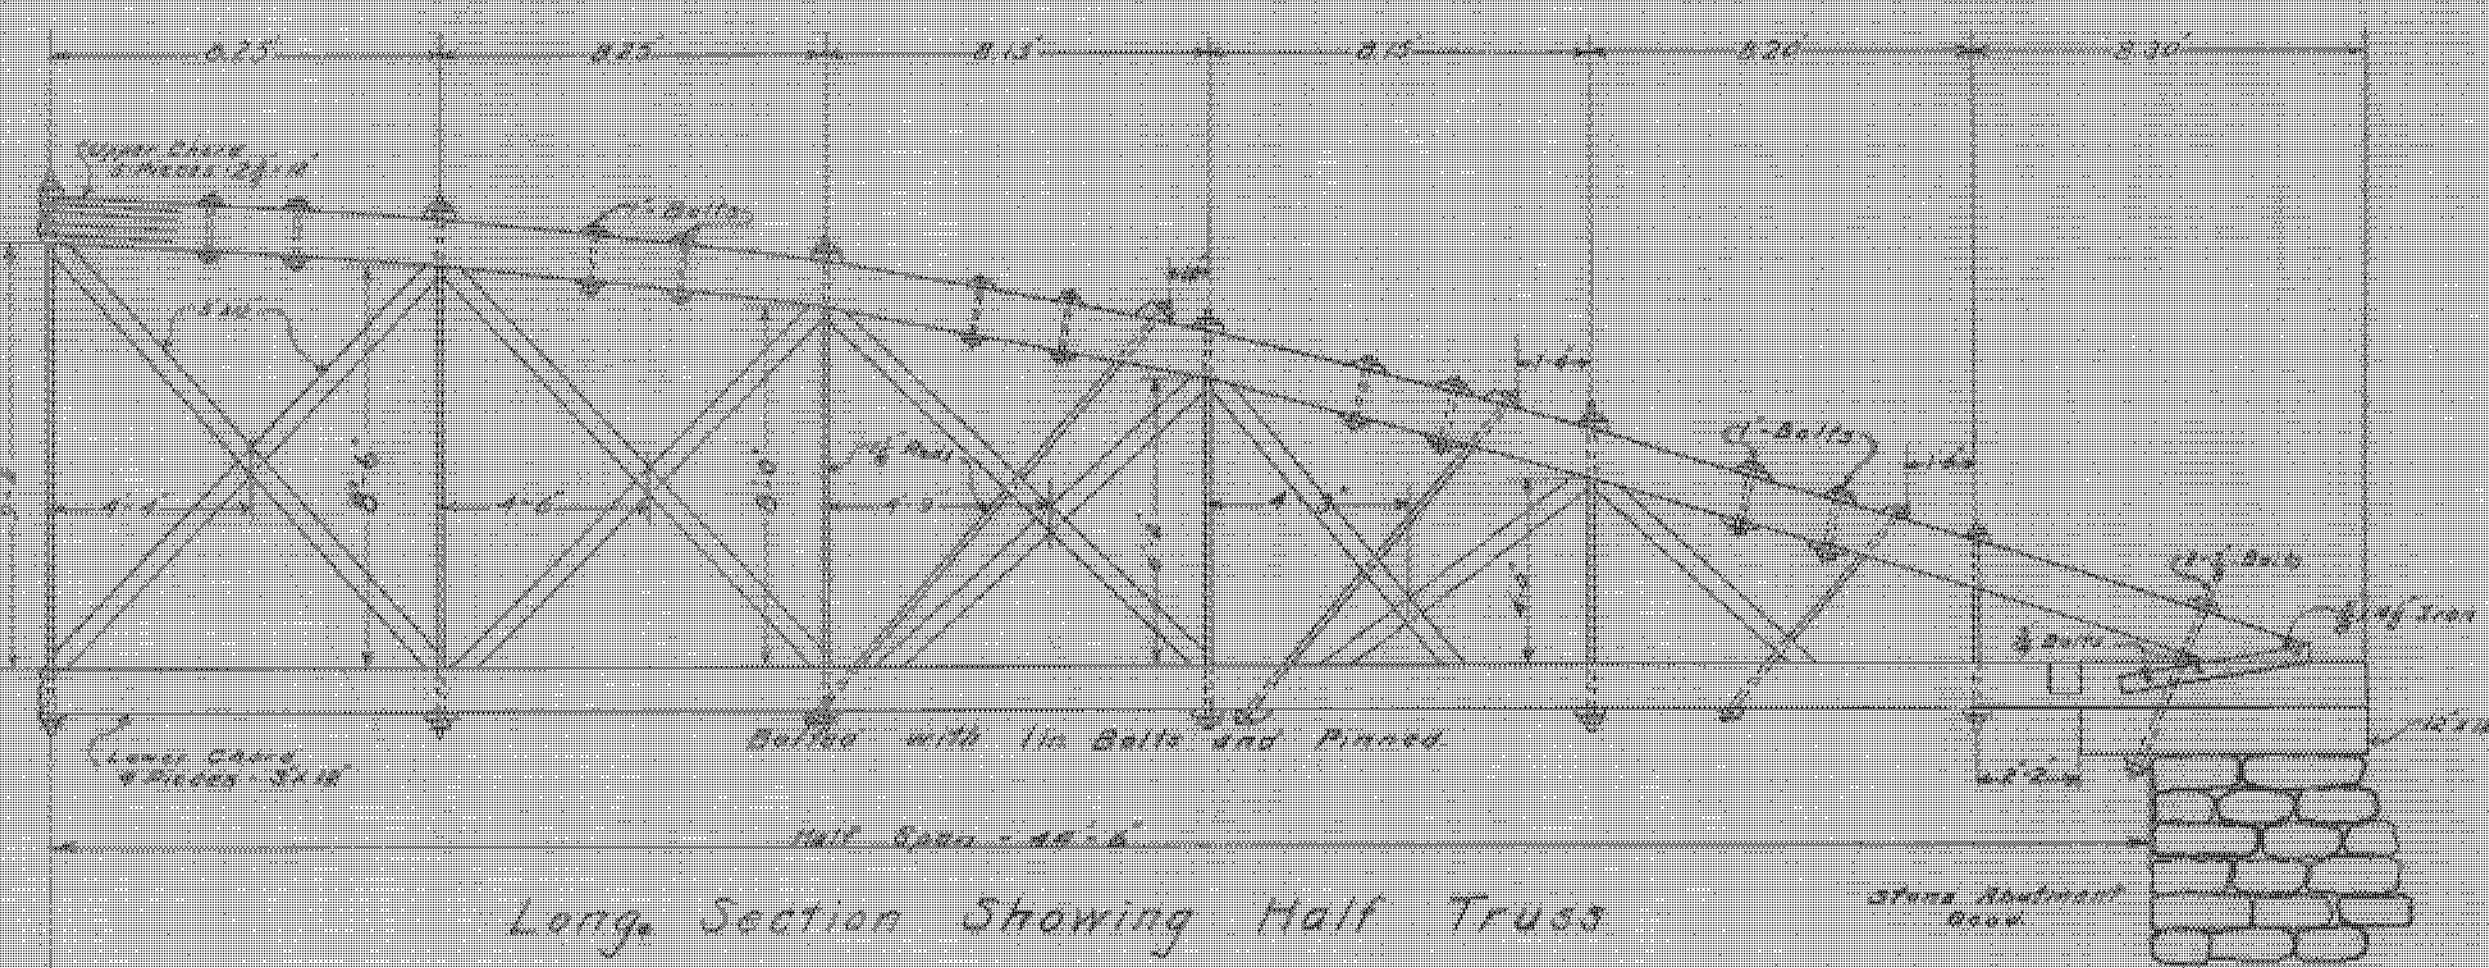





Fed. Aid Dist. No.	State Proj. No.	Fed. Aid Year	Sheet No.	Total Sheets
9	VI	20	36	66

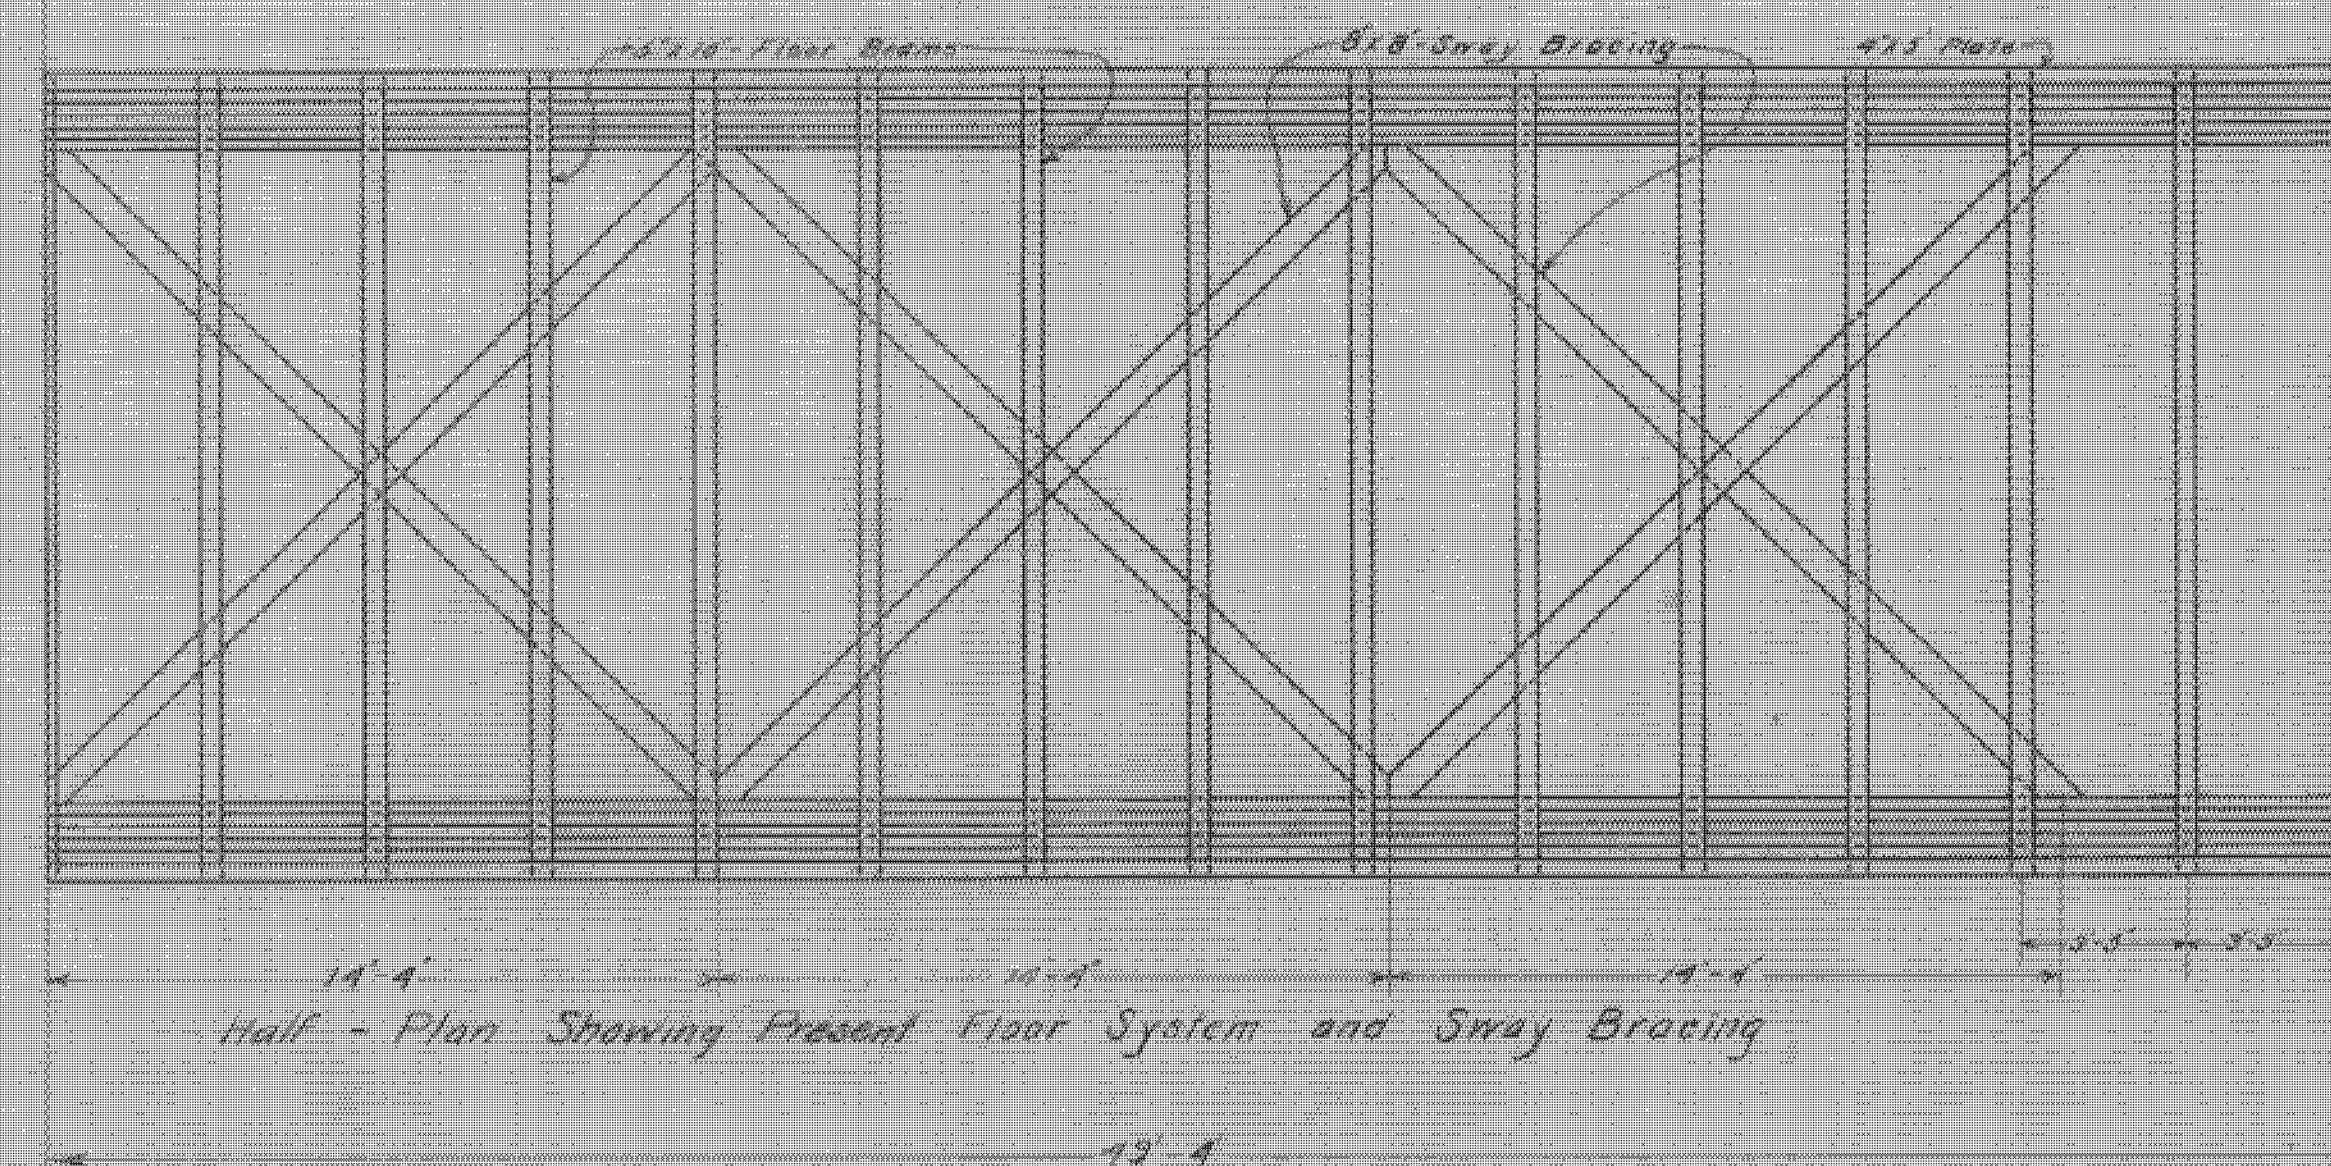

Note:
 ① Trusses, roof, and siding to remain unchanged except where replacements are required on account of poor condition of present structure.

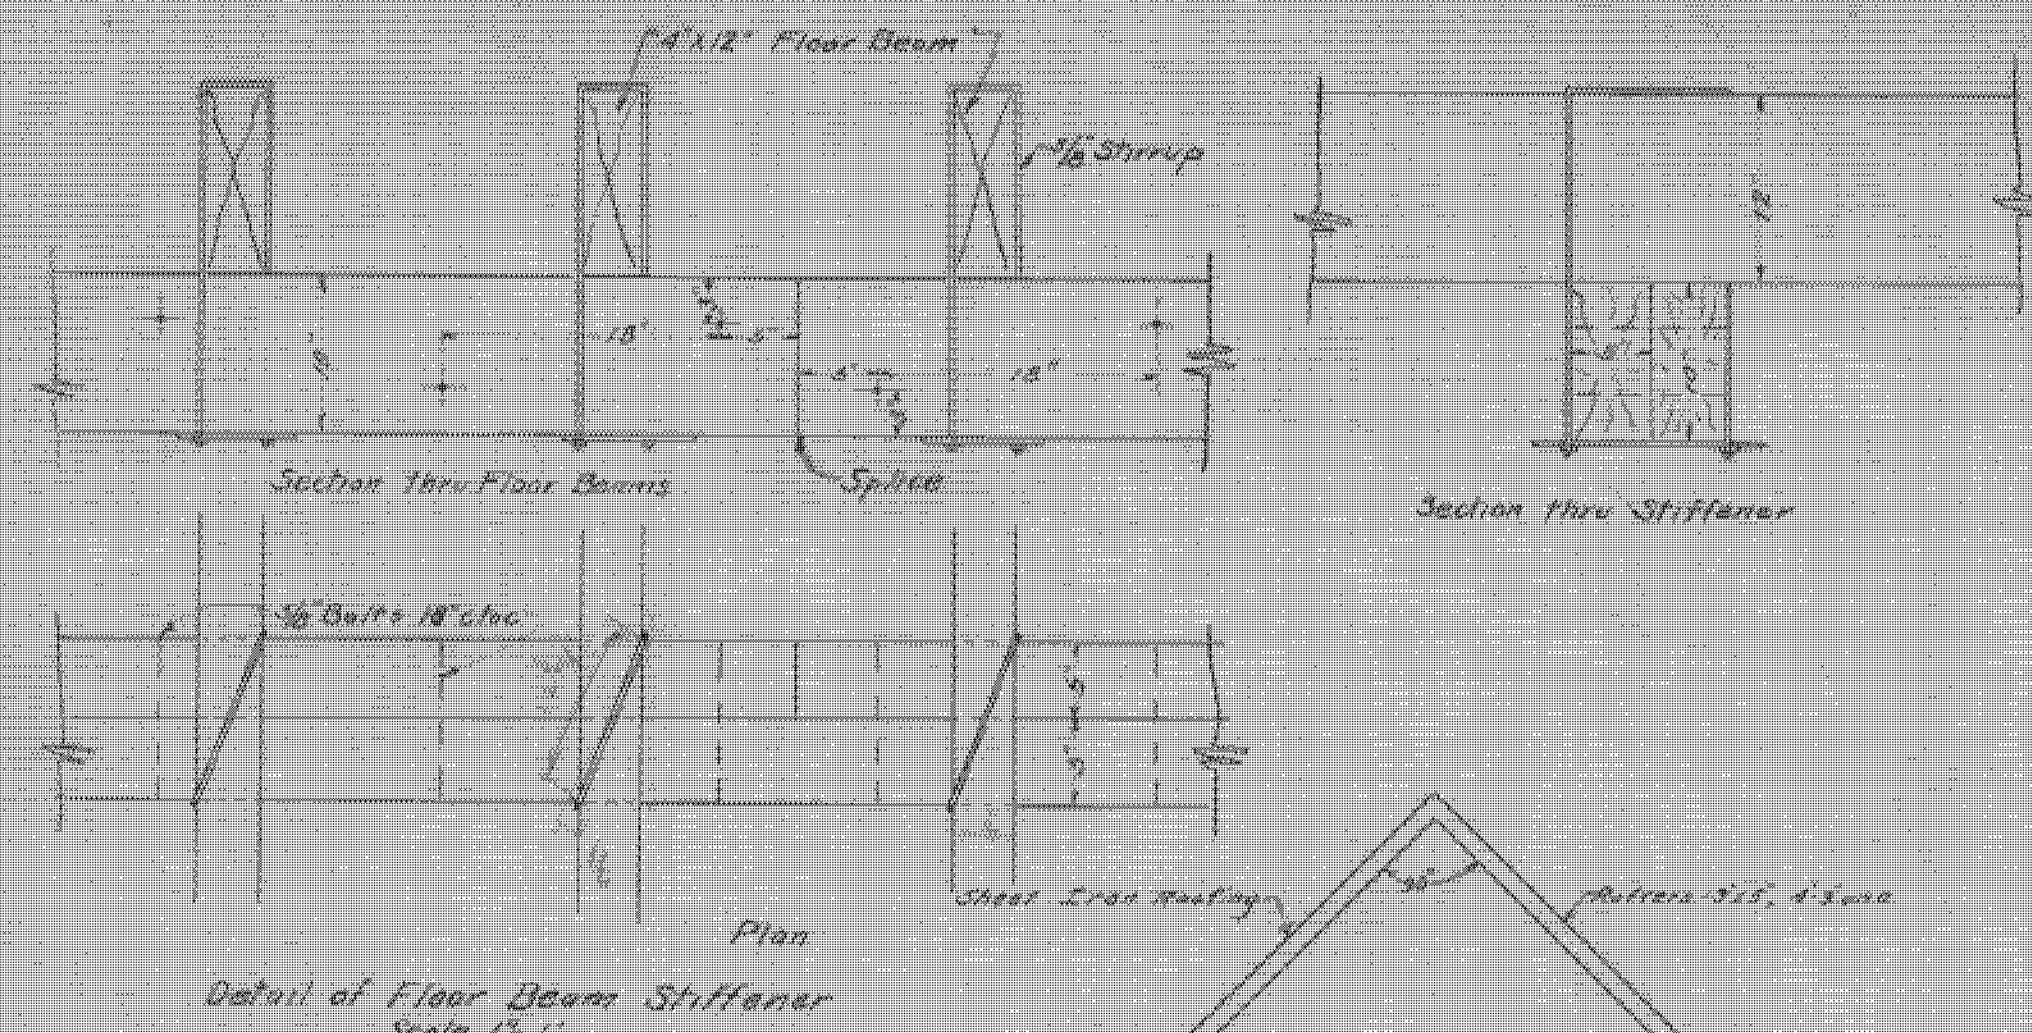

Note:
 Floor Beam Stiffeners to be made up of present 5x18 floor beams bolted together as indicated. Splices to be staggered.

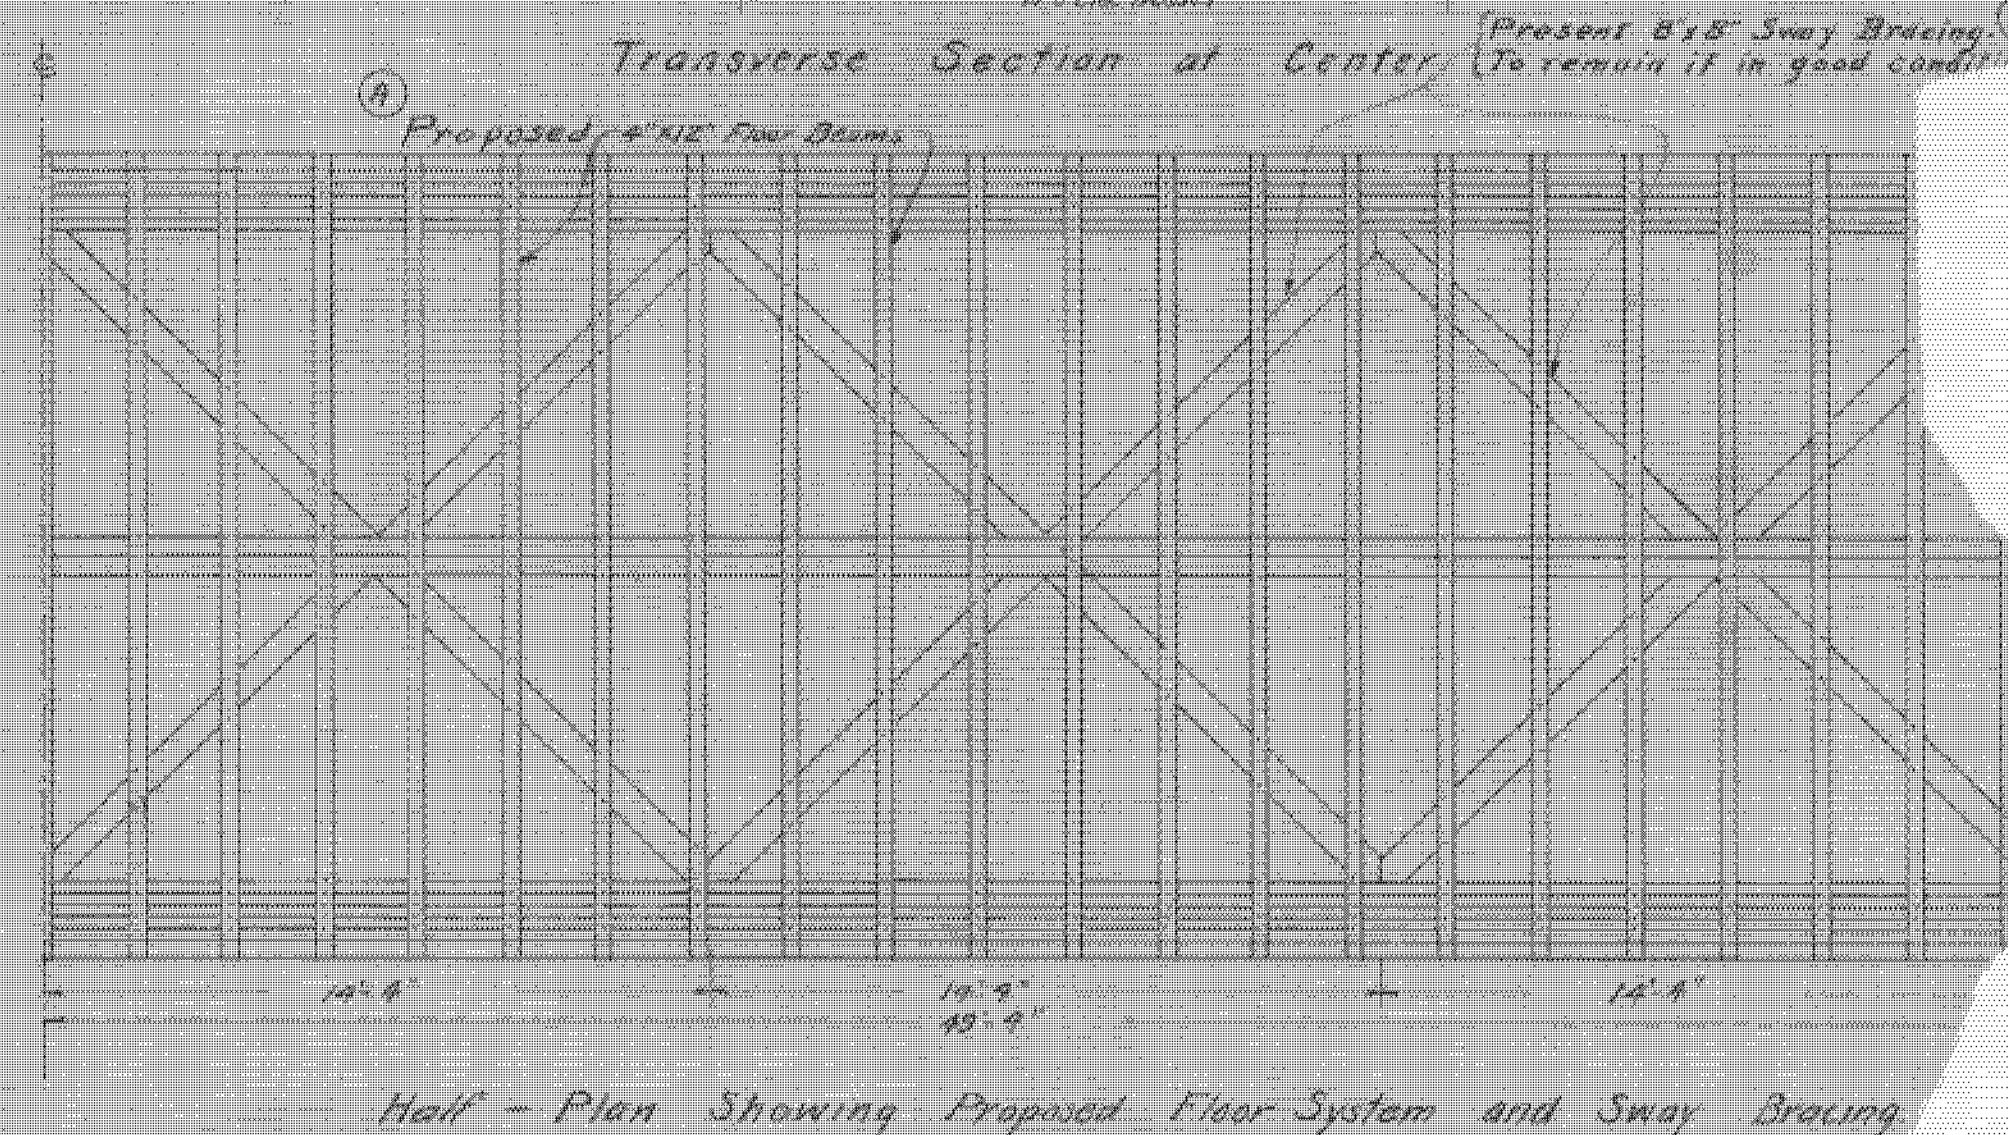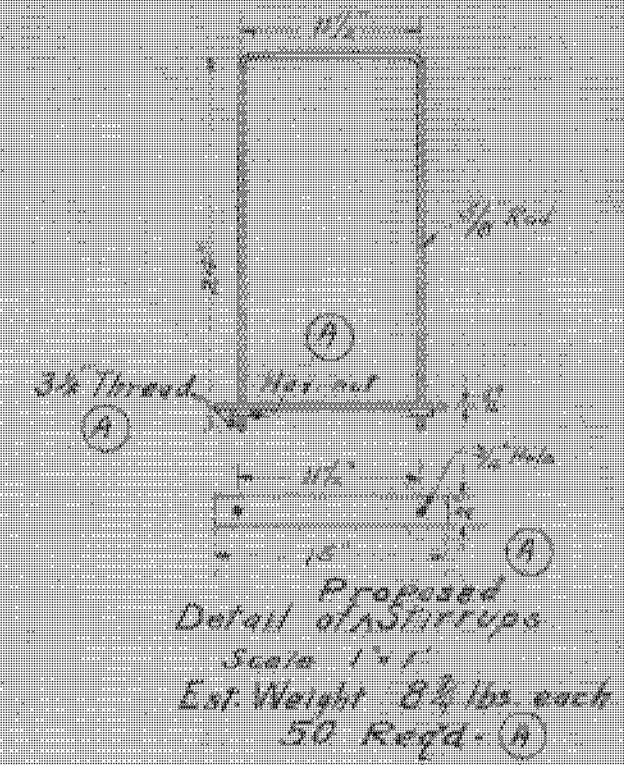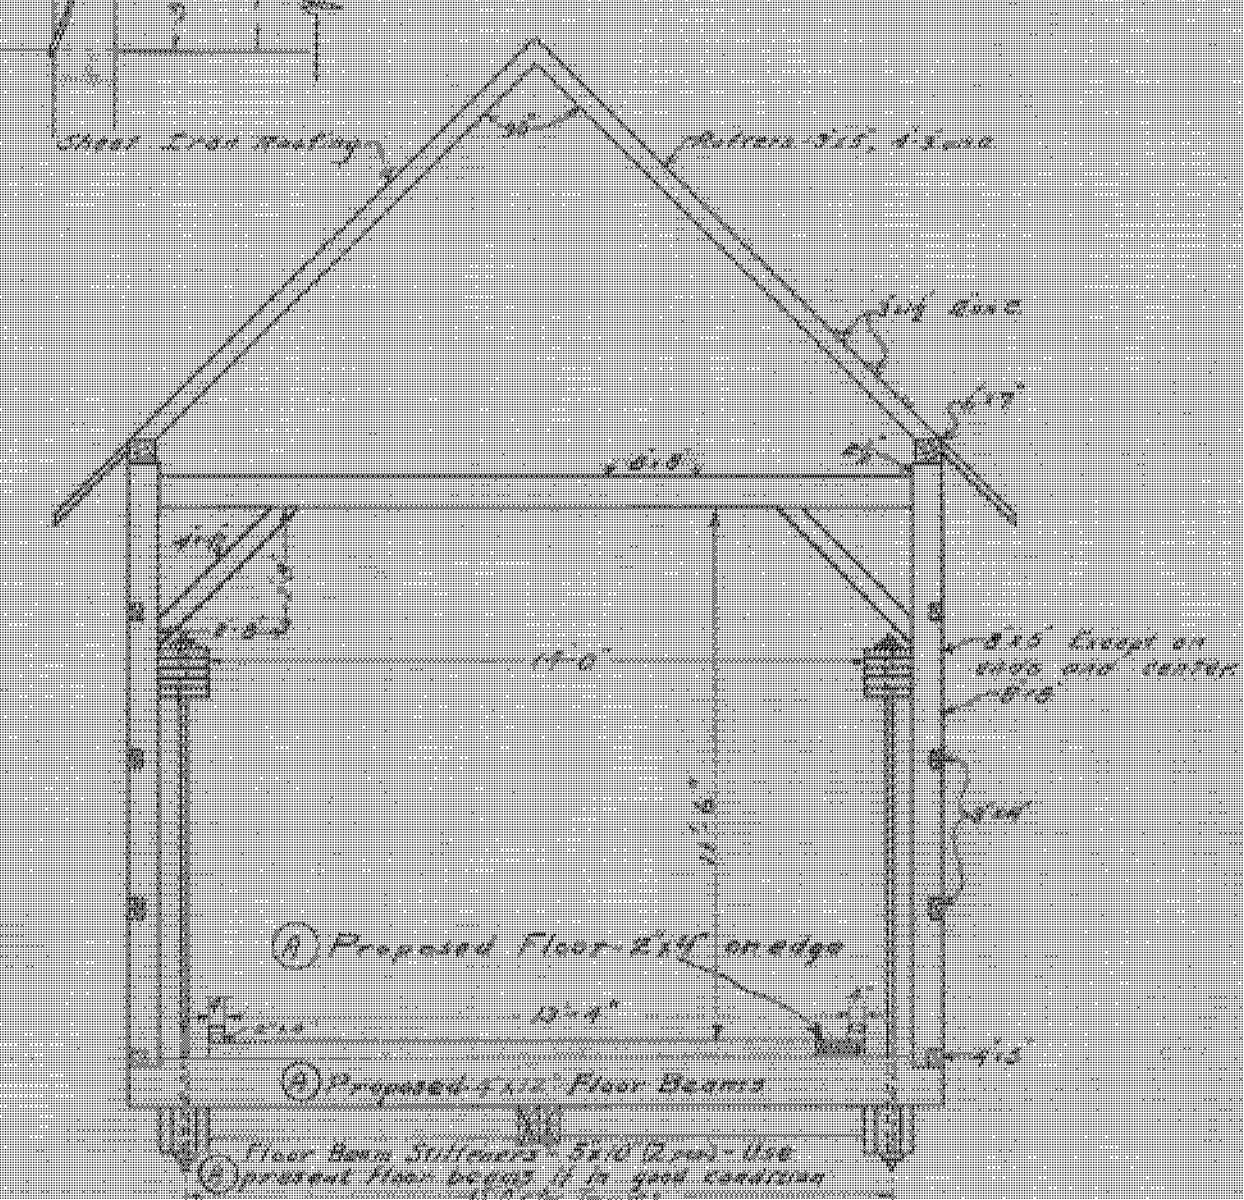

BRIDGE NO-
 OTTAQUE
 BRIDGE
 DEC.

2x4 FLOOR
 4x12 FLOOR
 10-6 T