


RECEIVED

DESIGNED BY RLP DRAWN BY _____

JAN 17 2011

RESUBMIT _____ APPROVED


BY KMH DATE 1/20/11

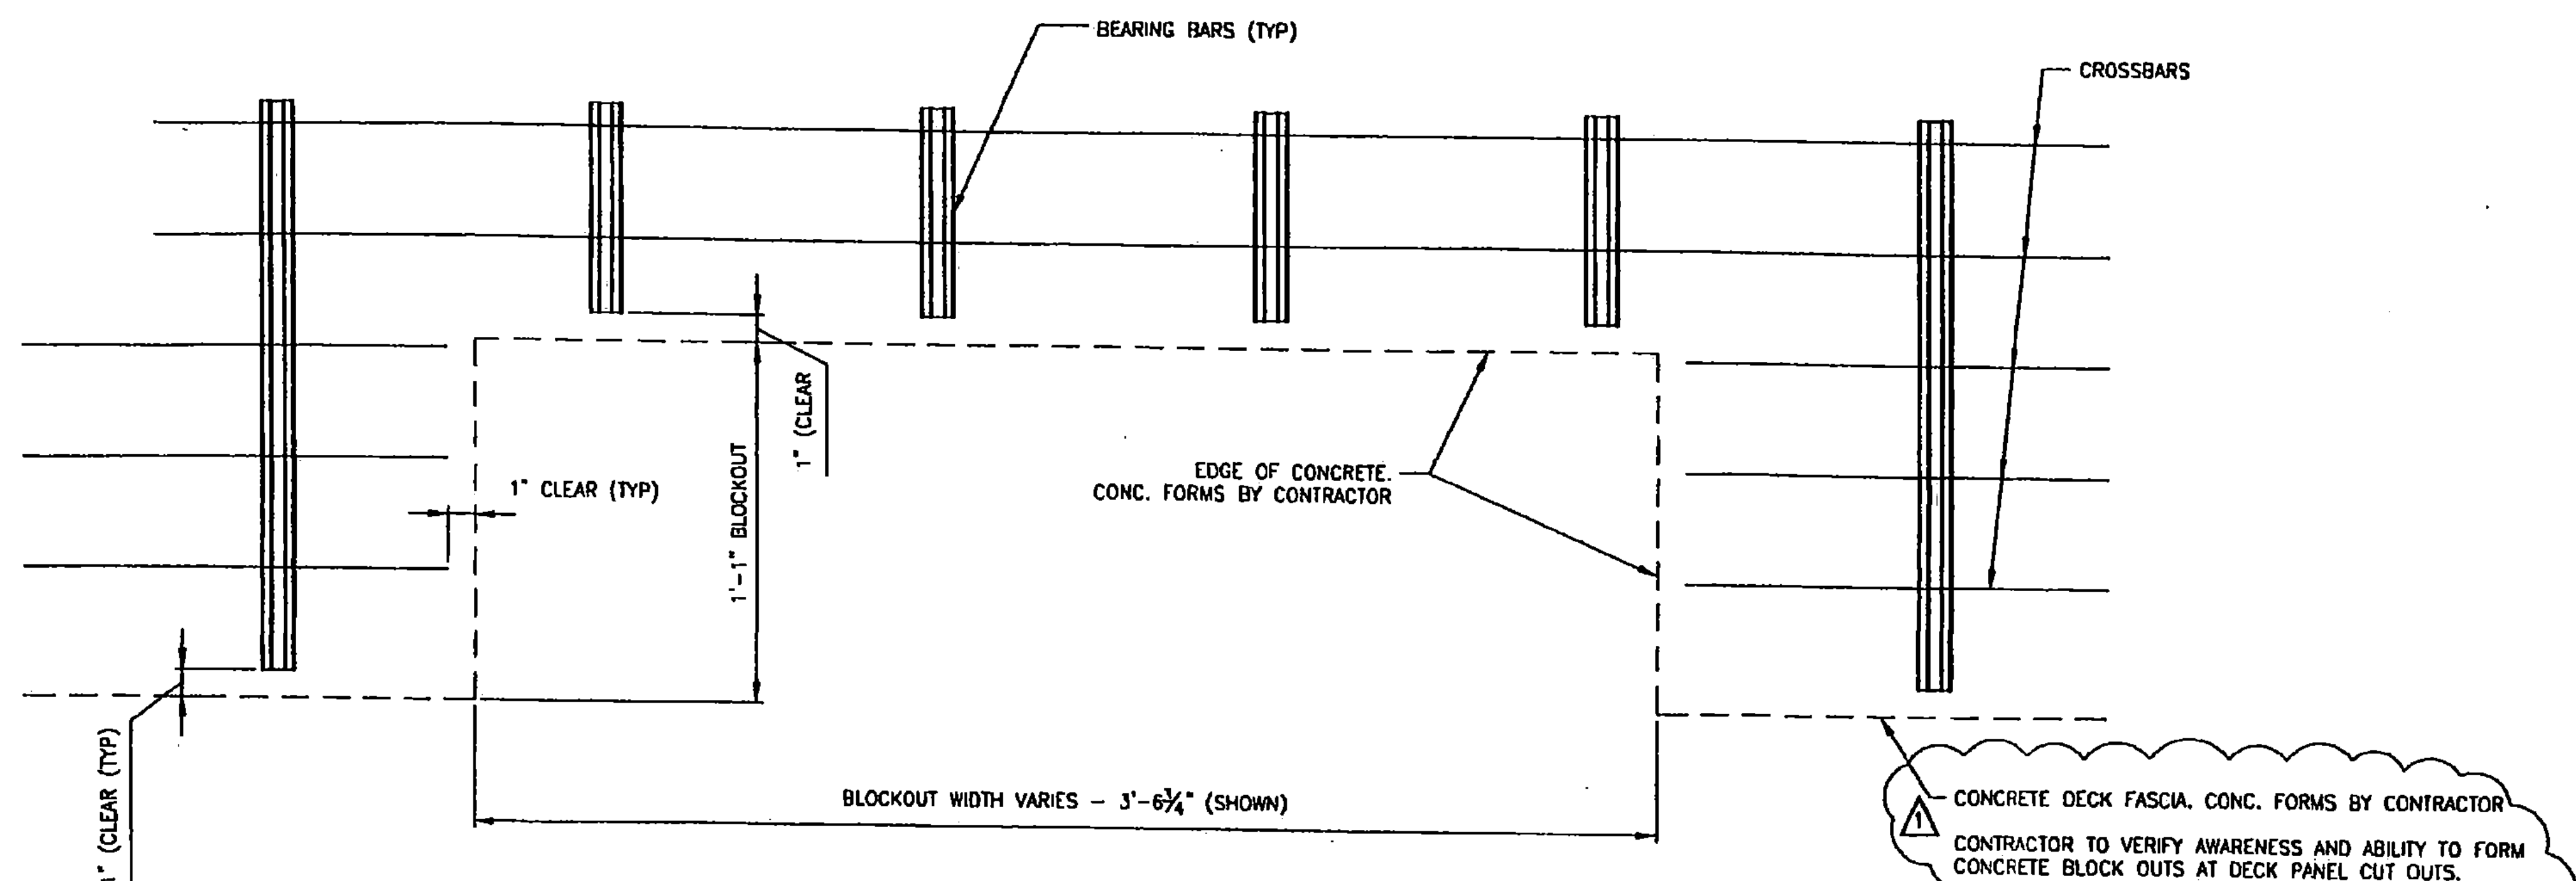

DETAIL 1 (FROM LBE1)
SUPPLEMENTAL BARS NOT SHOWN


CONCRETE DECK FASCIA, CONC. FORMS BY CONTRACTOR
CONTRACTOR TO VERIFY AWARENESS AND ABILITY TO FORM CONCRETE BLOCK OUTS AT DECK PANEL CUT OUTS.

APPROVER SUPPLIED DIMENSION. REMOVED VERIFICATION NOTE OF REQUIRED CLEAR SPACE FOR #6 RE-BAR HOOK.

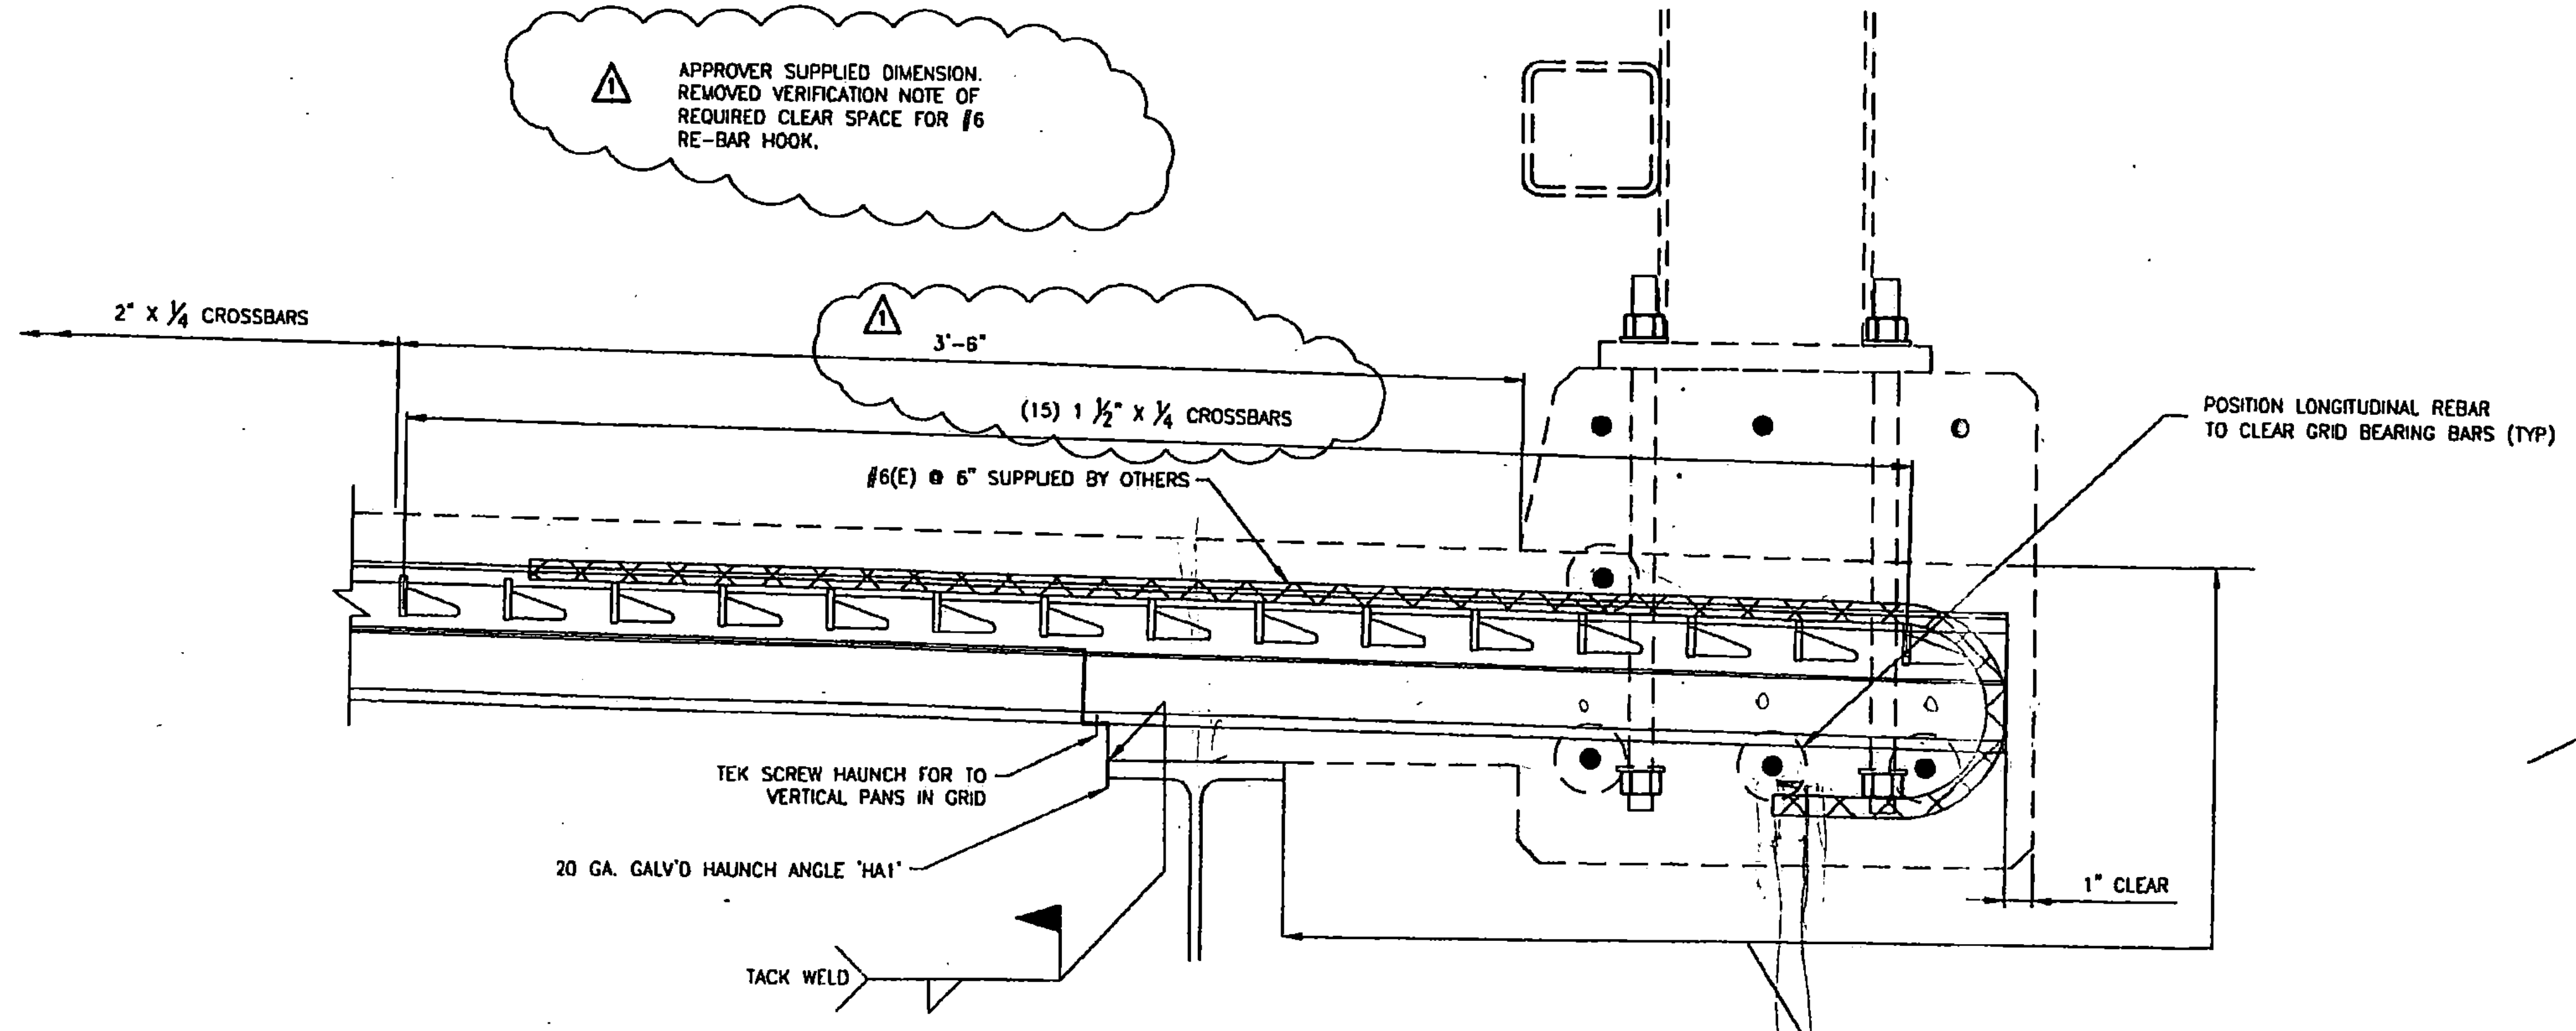

DETAIL 2 (FROM LBE3)

NOTE: FIELD CUT #4 SUPPLEMENTAL REBARS IN GRID IF REQ'D TO CLEAR RAIL POST ANCHORS

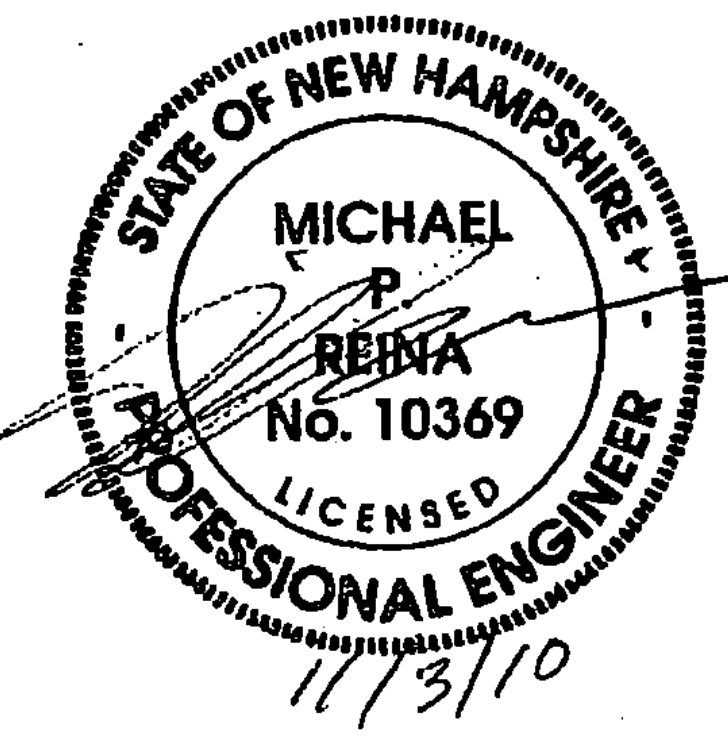

APPROVED:	DATE:
L. B. FOSTER CO.	
<small>PITTSBURGH, PENNSYLVANIA 15220</small>	
FOR: MILLER CONSTRUCTION	
STATE OF VERMONT AGENCY OF TRANSPORTATION	
TOWN OF BRIDGEWATER, COUNTY OF WINDSOR	
VT. ROUTE 100A, BR14 PROJ. NO. BRS 0149 (4)	
MISC. DETAILS	
REV	DESCRIPTION
1	WPO 08/18/10 SDO339
2	RLP 09/11/10 LBE4

185 PREFAB DECK PANELS