


RECEIVED
 SK'D BY JK SK'D BY _____
 JAN 17 2011
 REQUESTED _____ APPROVED _____
 BY KMH DATE 1/20/11

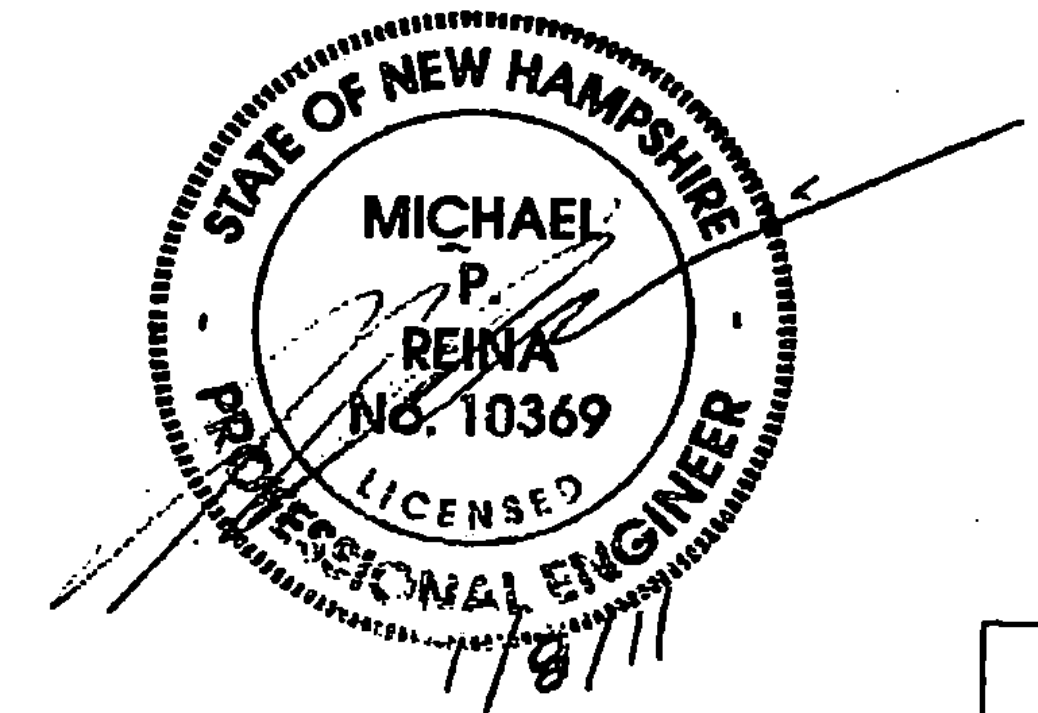

APPROVED:	
L. B. FOSTER CO.	
<small>PITTSBURGH, PENNSYLVANIA 15220</small>	
FOR: MILLER CONSTRUCTION	
STATE OF VERMONT AGENCY OF TRANSPORTATION	
TOWN OF BRIDGEWATER, COUNTY OF WINDSOR	
VT. ROUTE 100A, BR14 PROJ. NO. BRS 0149 (4)	
PLAN LAY OUT FOR SHEAR STUD PLACEMENT	
DATE	REV. NO.
12/10/10	500339
BY	CHKD
LB9	LB9

186 PREFAB DECK PANELS