



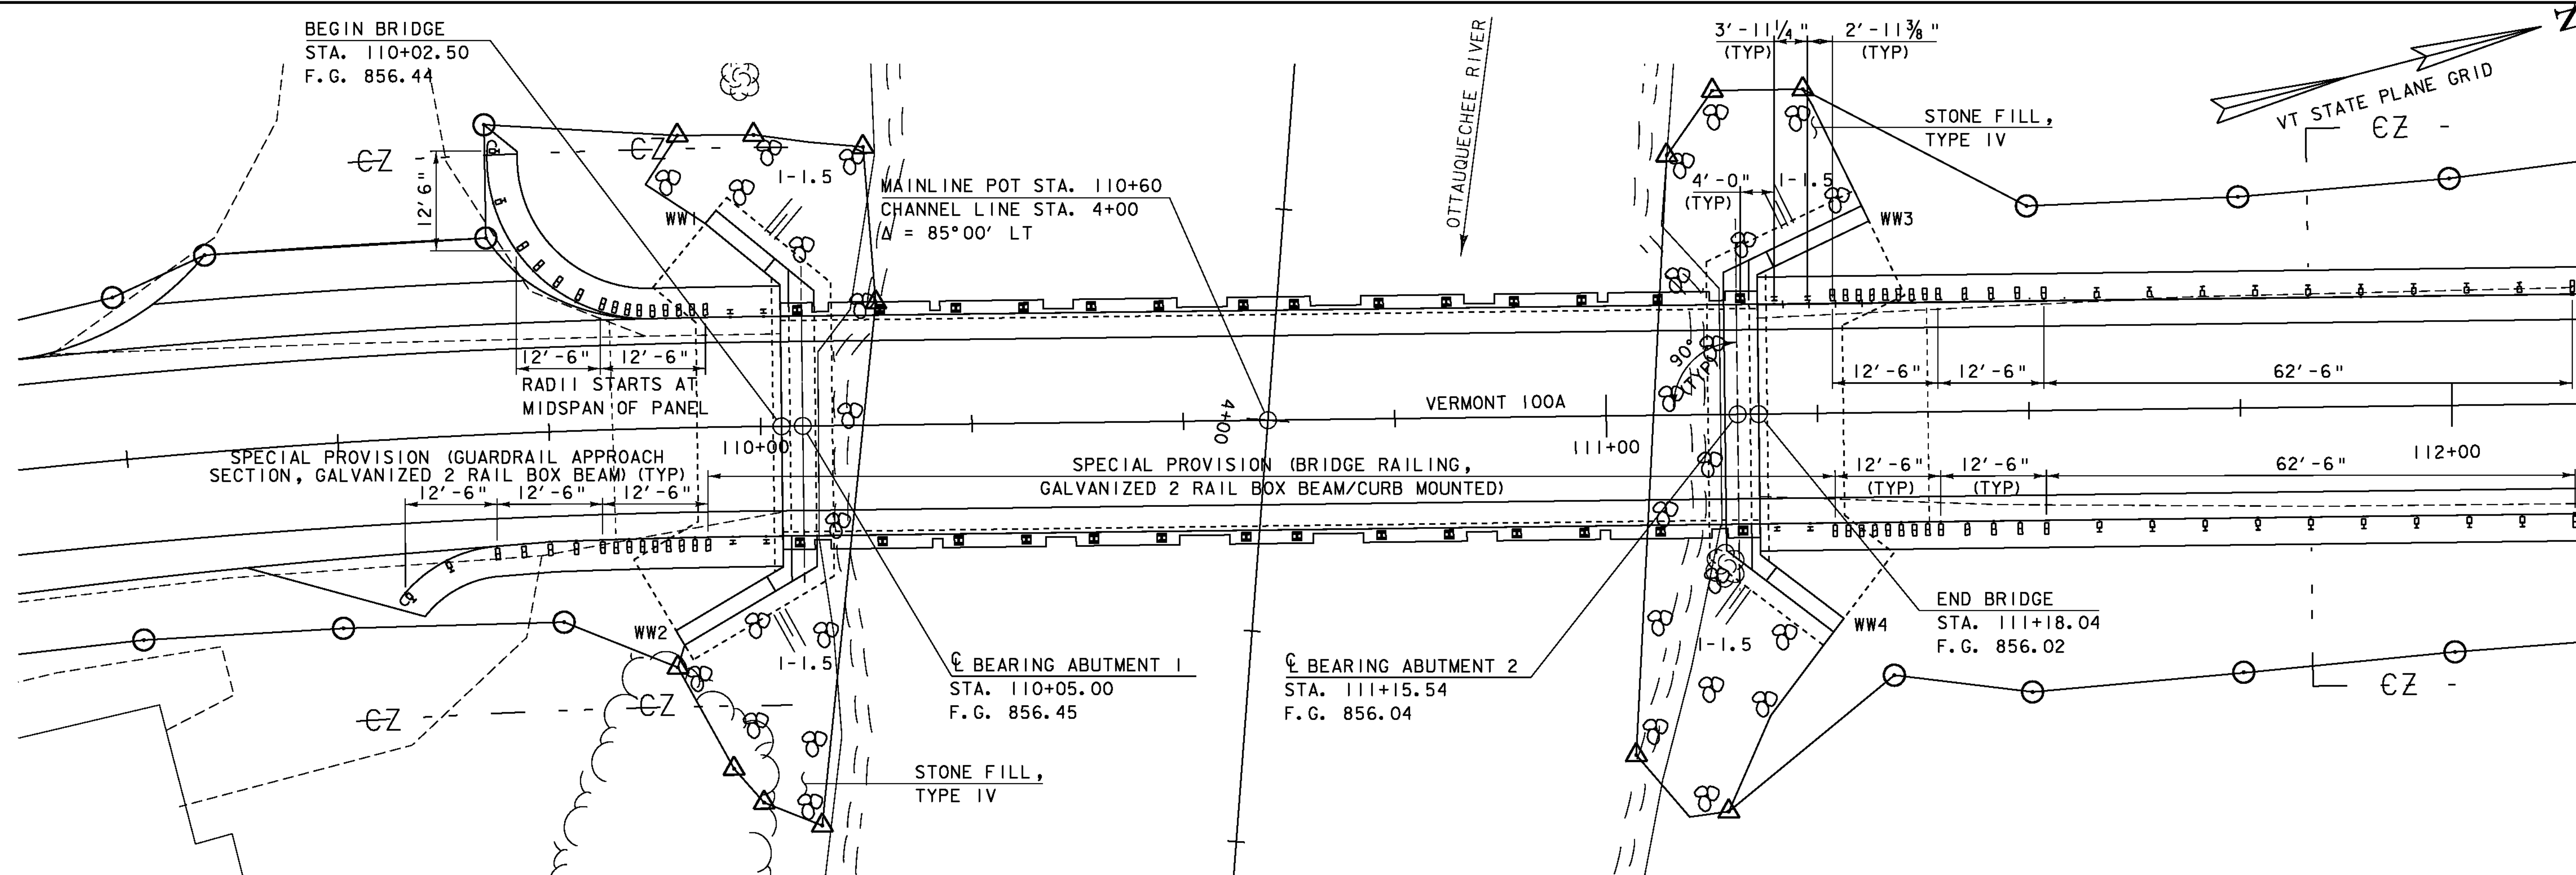

PLAN

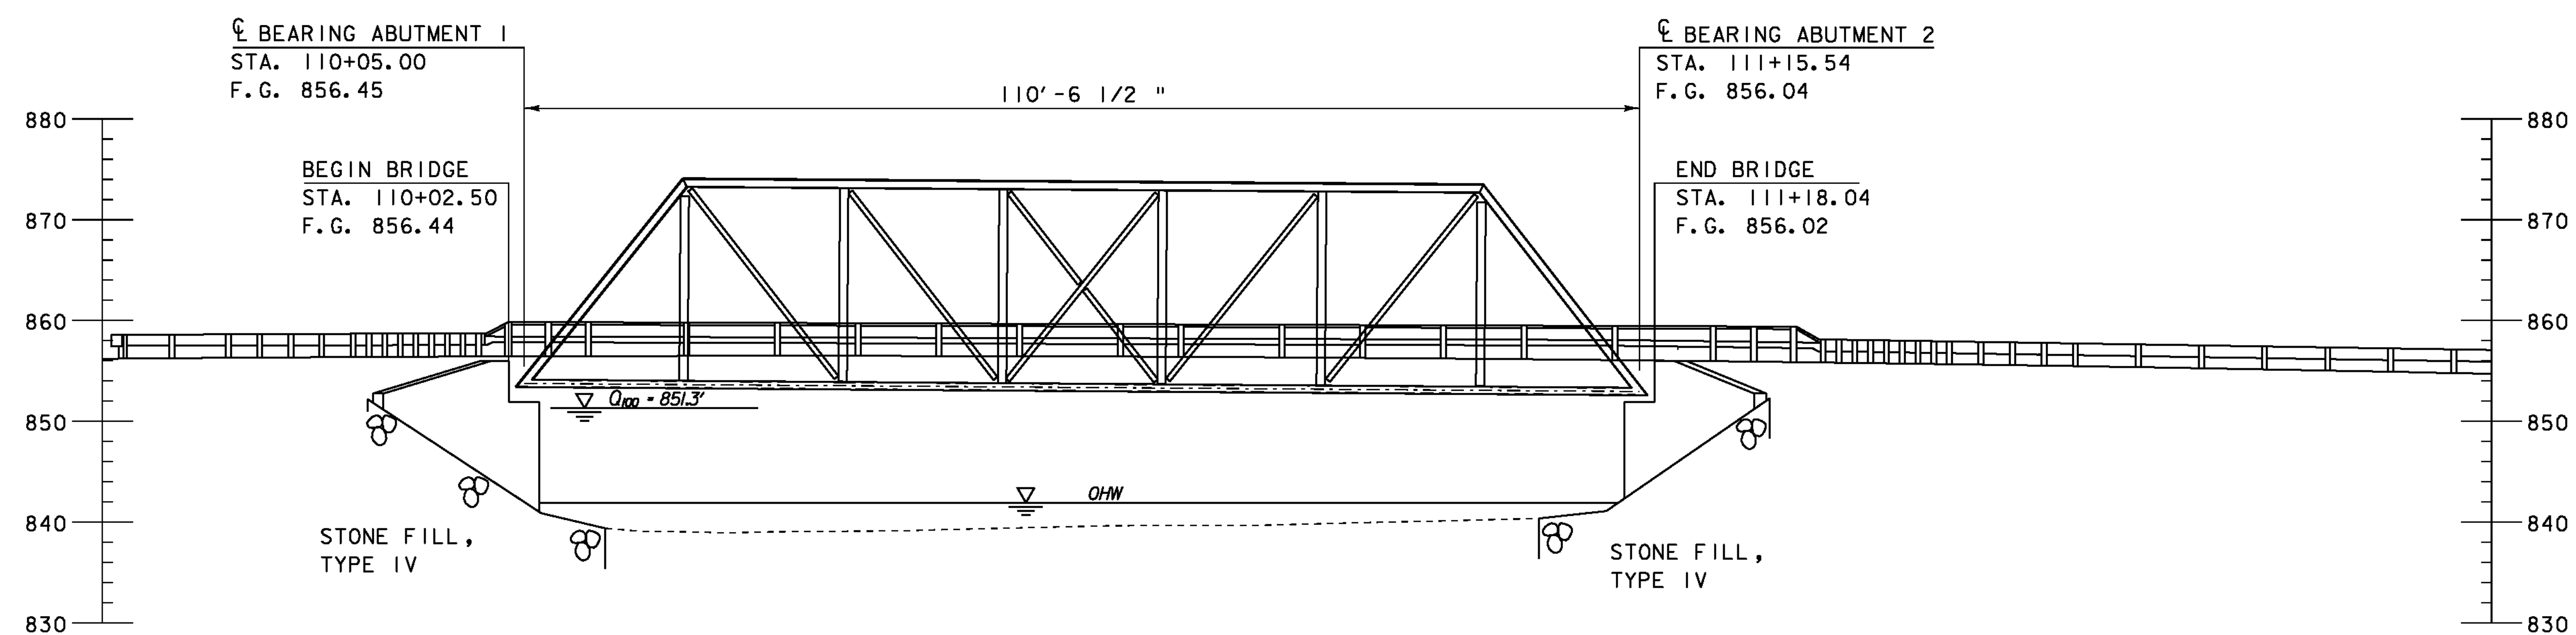

ELEVATION DOWNSTREAM FACIA

SCALE 1" = 10'-0"
10 0 10

PROJECT NAME: BRIDGEWATER
PROJECT NUMBER: BRS 0149(4)

FILE NAME: s86e062pe.dgn
PROJECT LEADER: K. HIGGINS
DESIGNED BY: T. FILLBACH
PLAN & ELEVATION

PLOT DATE: 31-DEC-2009
DRAWN BY: J. SALVATORI
CHECKED BY: T. FILLBACH
SHEET 17 OF 58