

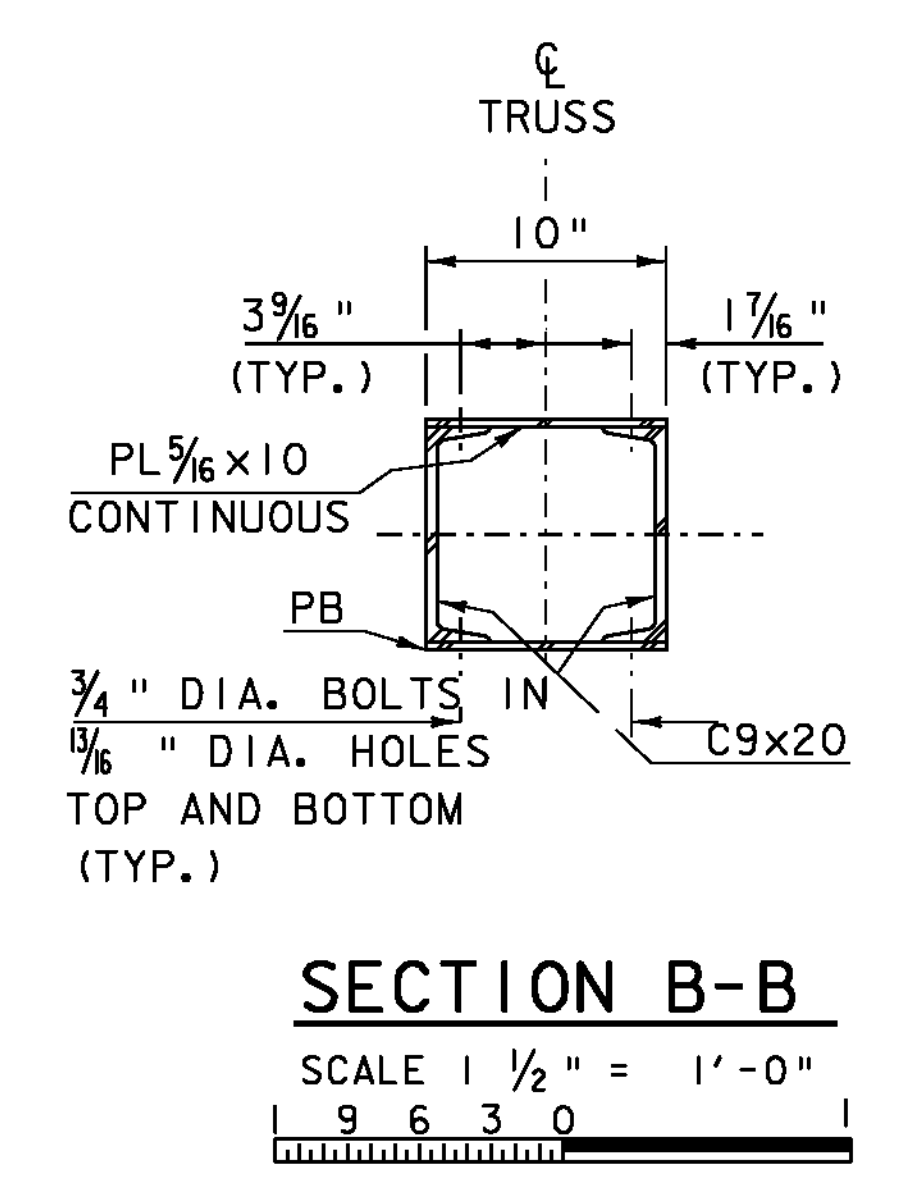
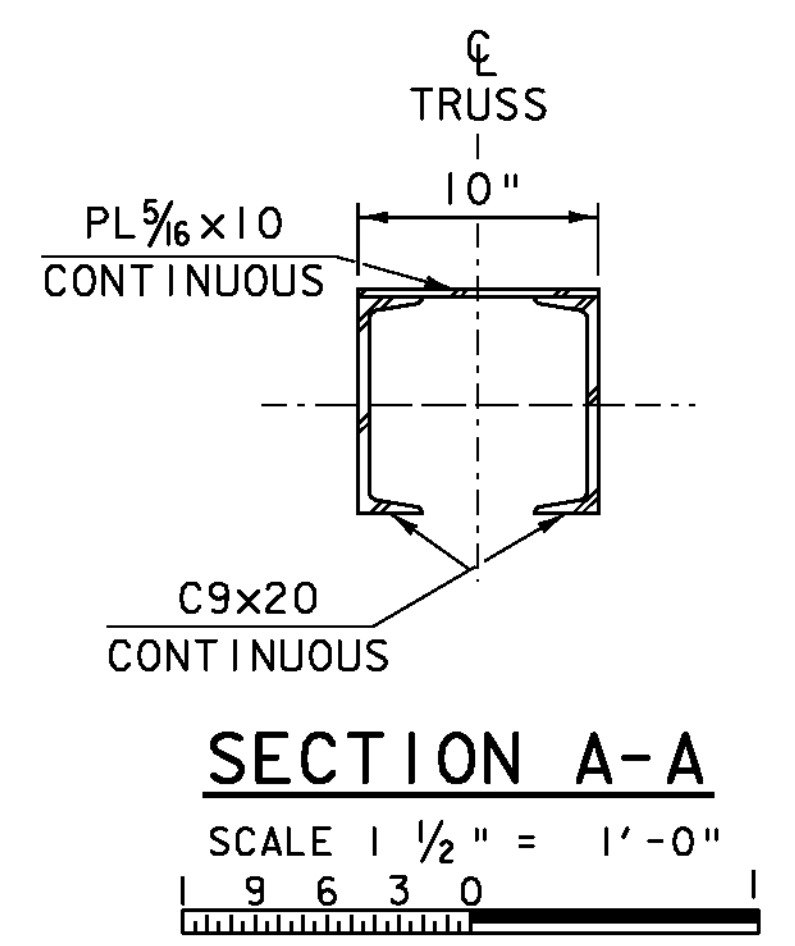
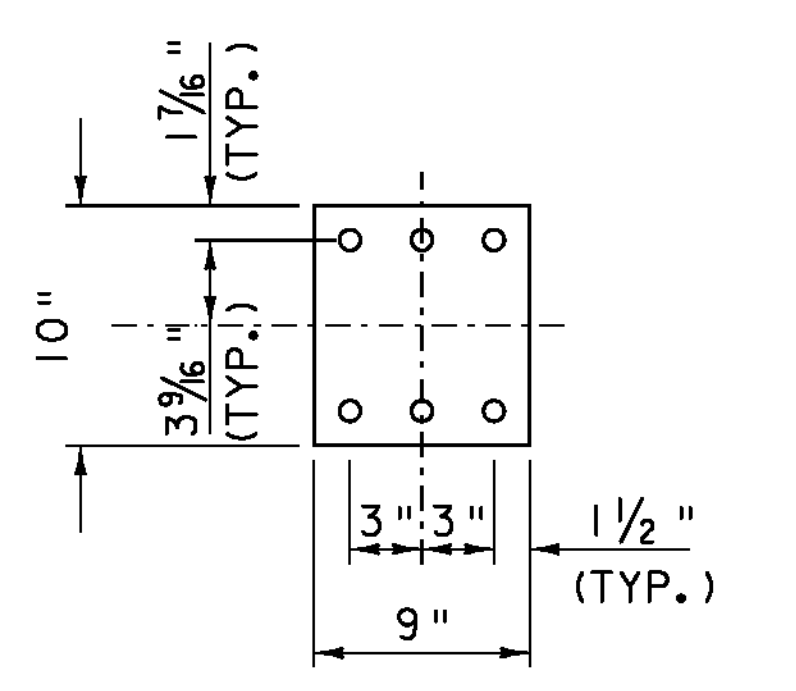


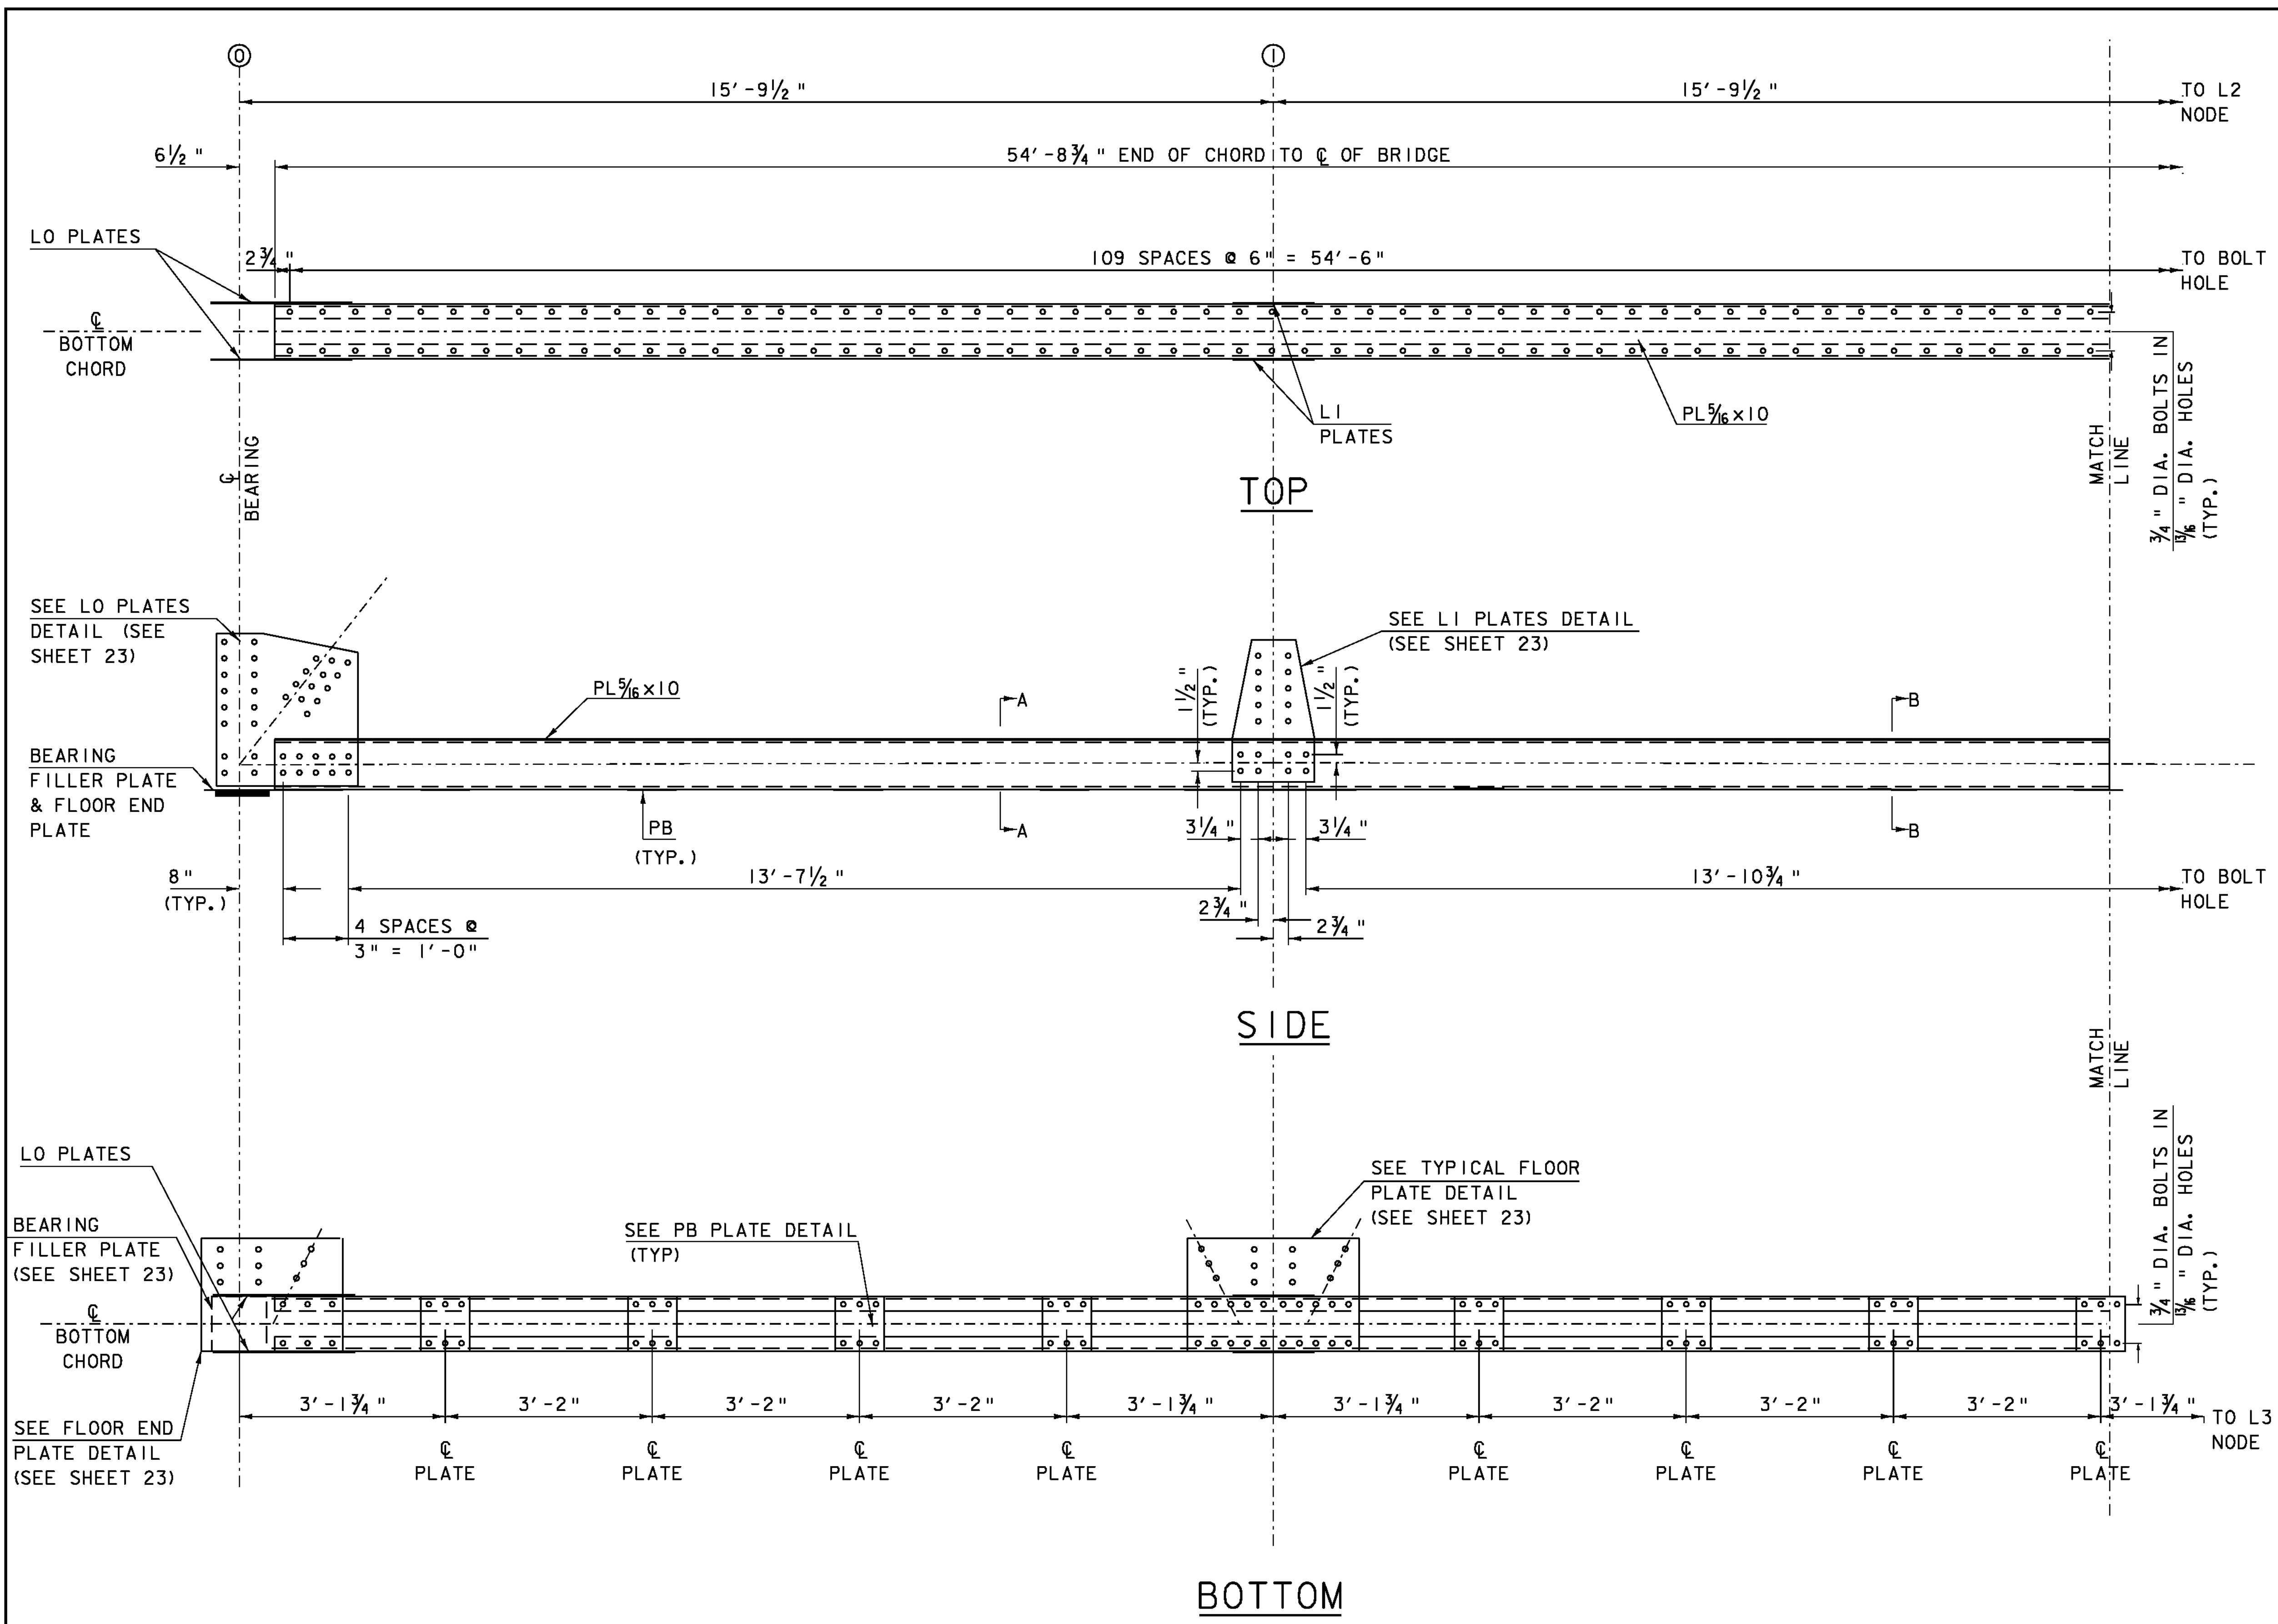

BOTTOM CHORD "L0-L2"

2C9x20 (FCM)

PL 5/16 x 10 (FCM)

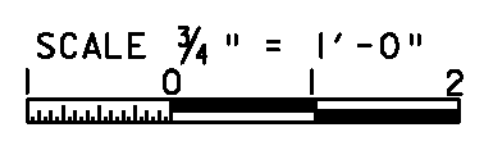

- NOTES:
1. SEE PLATE DETAILS FOR BOLT HOLE SPACING
 2. MIN. BOLT HOLE TO AND EDGE DISTANCE 1 1/2" UNLESS NOTED
 3. 7/8" DIA. BOLTS UNLESS NOTED
 4. 5/16" DIA. HOLES UNLESS NOTED

PROJECT NAME:	BRIDGEWATER
PROJECT NUMBER:	BRS 0149(4)
FILE NAME:	s86e062truss.dgn
PROJECT LEADER:	K. HIGGINS
DESIGNED BY:	T. FILLBACH
BOTTOM CHORD L0-L2	
PLOT DATE:	31-DEC-2009
DRAWN BY:	C. MOONEY
CHECKED BY:	T. FILLBACH
SHEET	21 OF 58