

**LO CAP DETAIL**


PL 3/8 x 17 x 1'-6 1/2"  
L4x4x3/8x8 1/2"

SCALE 3" = 1'-0"



**PORTAL TOP CHORD "EPI"**

2-C10x20x24'-6 1/4" (EXISTING)  
PL 5/8 x 17 x 24'-6 5/8" (NEW)

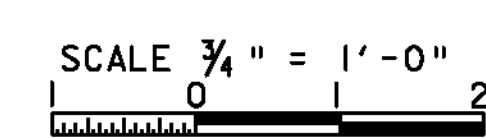

MIN. BOLT HOLE END AND EDGE DISTANCE 1 1/2" UNLESS NOTED  
7/8" DIA. BOLTS UNLESS NOTED  
5/8" DIA. HOLES UNLESS NOTED

PROJECT NAME: BRIDGEWATER	PLOT DATE: 31-DEC-2009
PROJECT NUMBER: BRS 0149(4)	DRAWN BY: C. MOONEY
FILE NAME: s86e062truss.dgn	CHECKED BY: T. FILLBACH
PROJECT LEADER: K. HIGGINS	SHEET 26 OF 58
DESIGNED BY: T. FILLBACH	
PORTAL TOP CHORD "EPI"	