



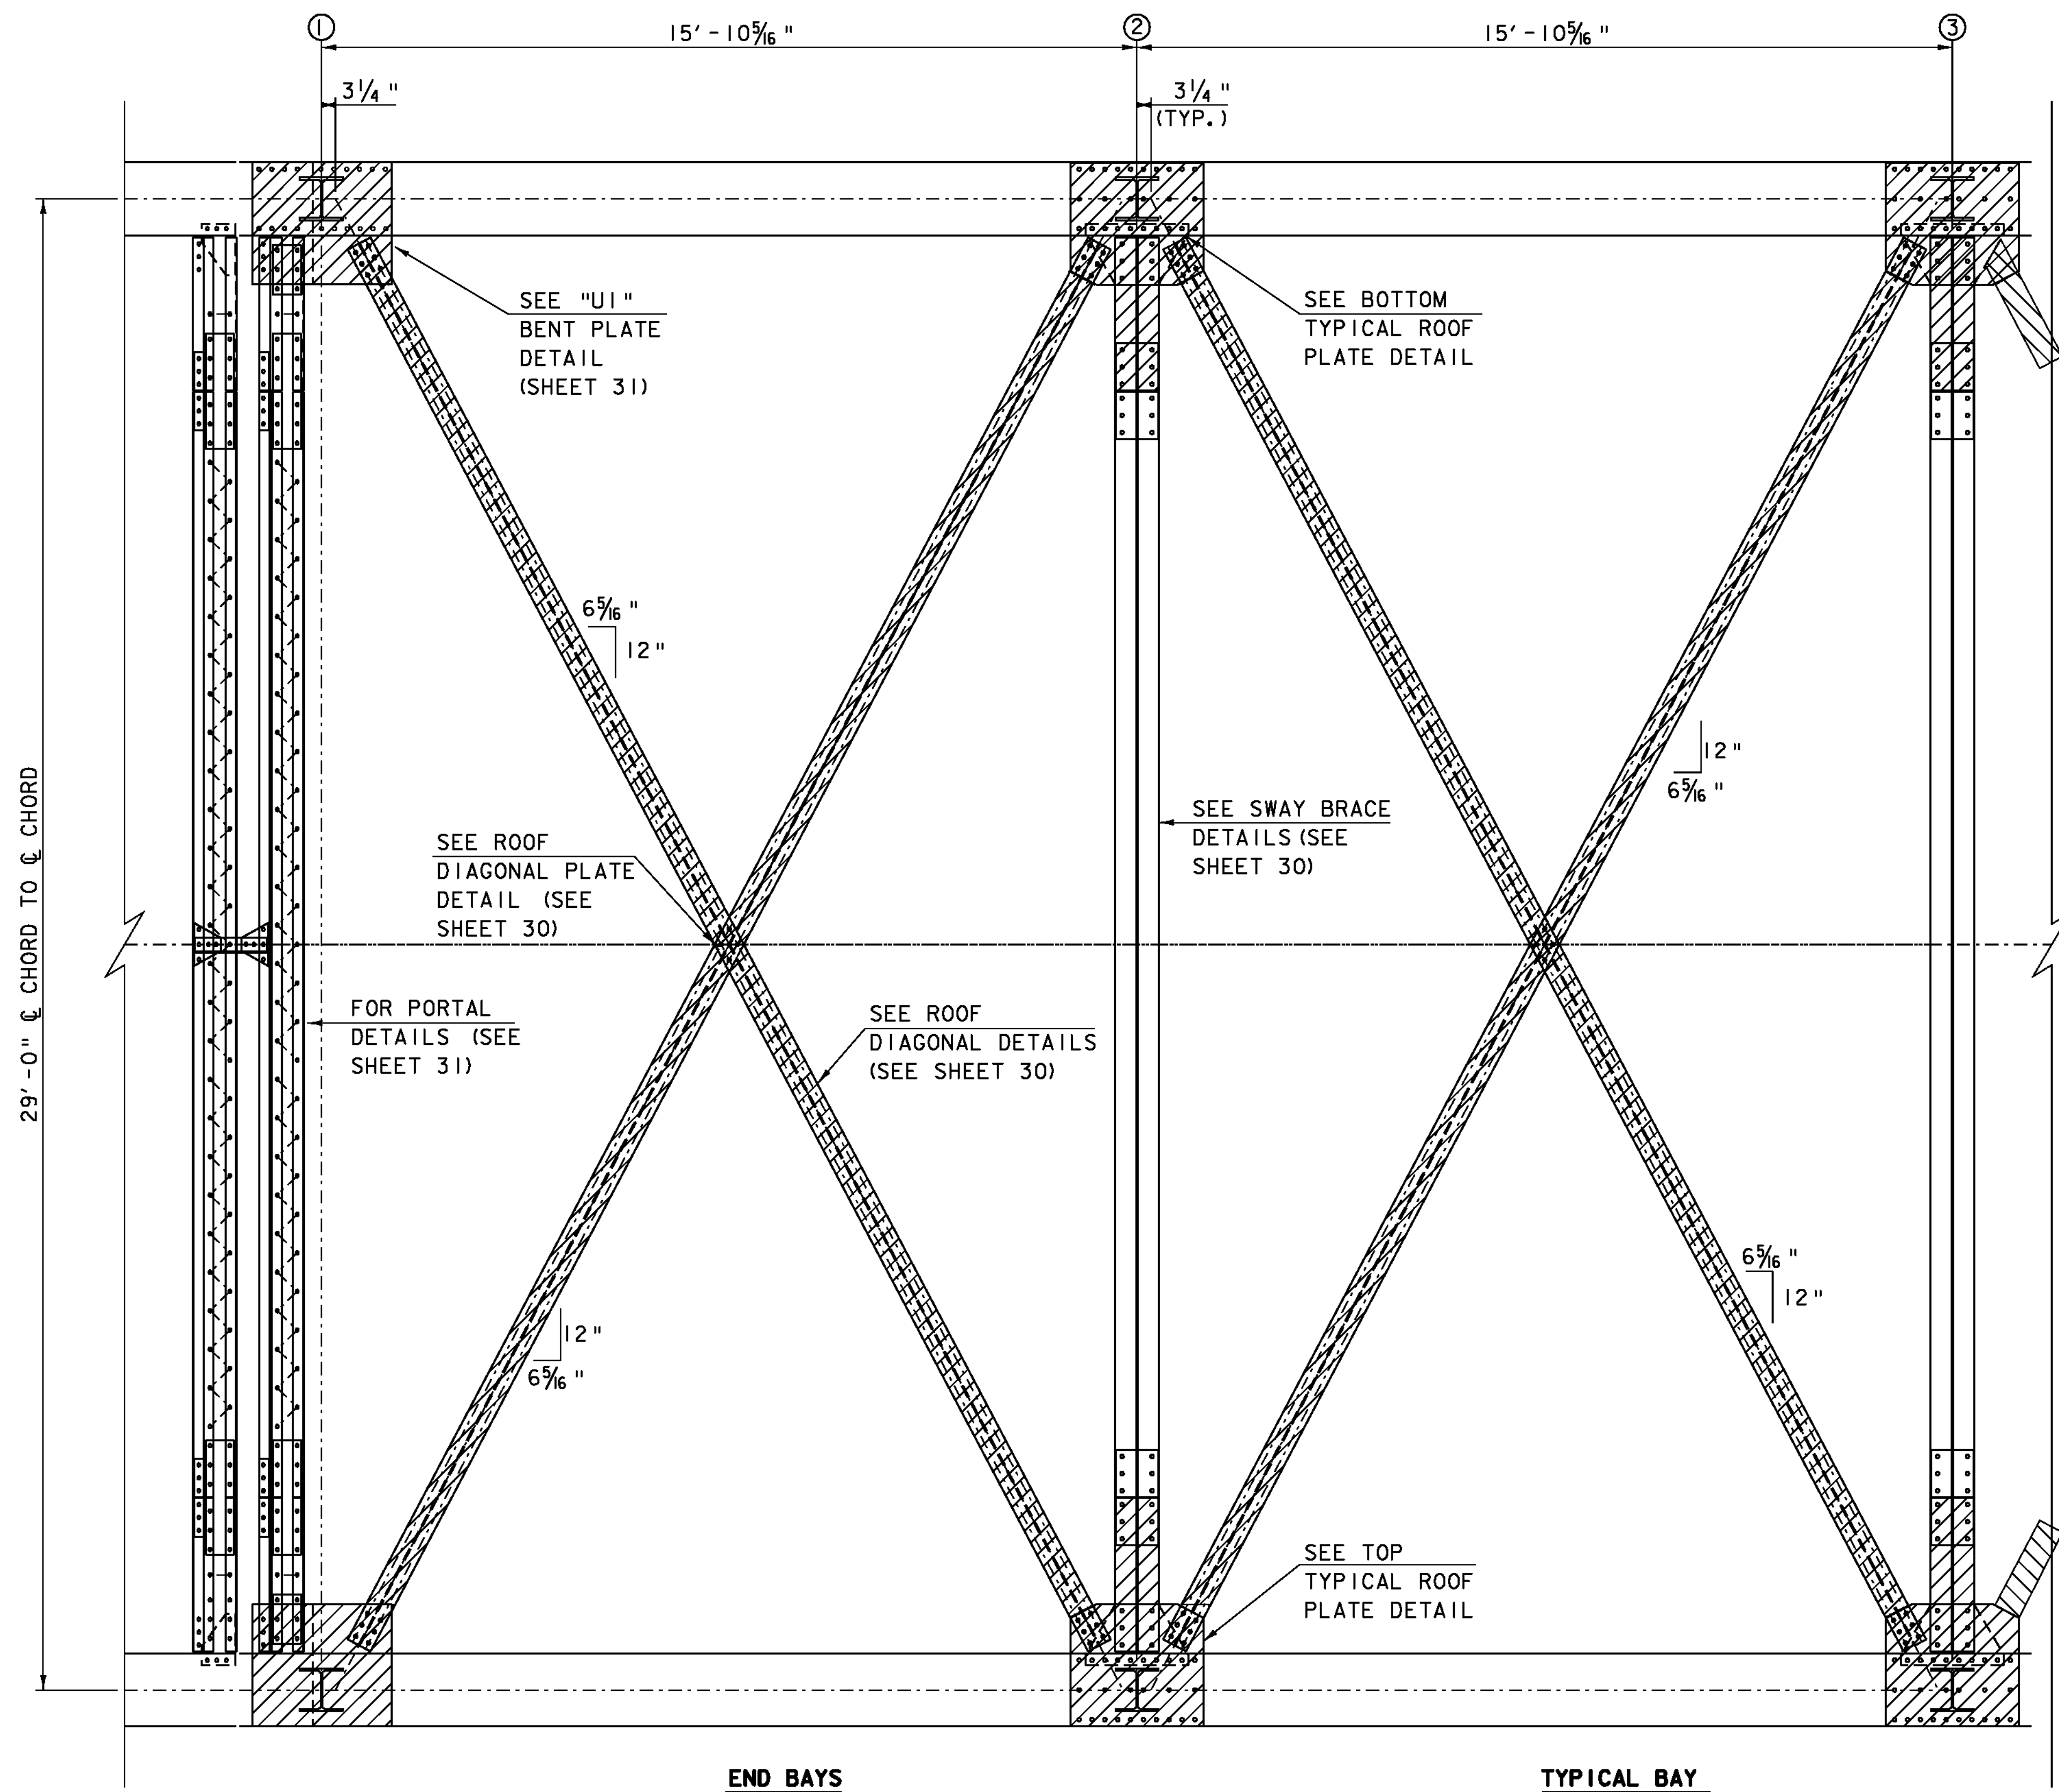

ROOF SYSTEM FRAMING PLAN


SCALE 1/2" = 1'-0"

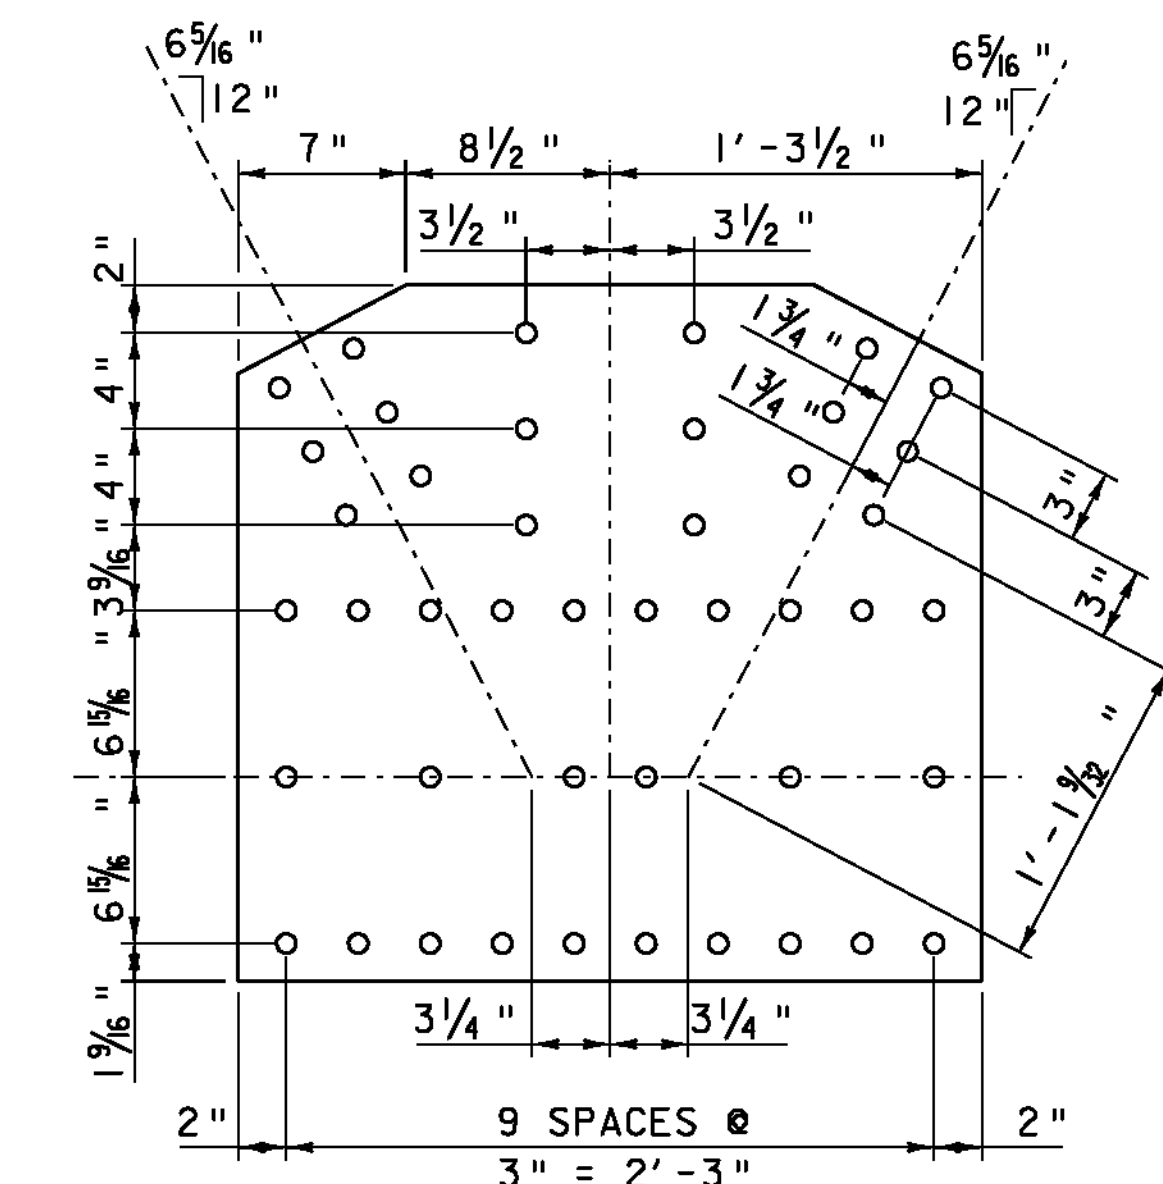

TOP TYPICAL ROOF PLATE

PL 5/16 x 29 x 2' - 7"


SCALE 1 1/2" = 1'-0"

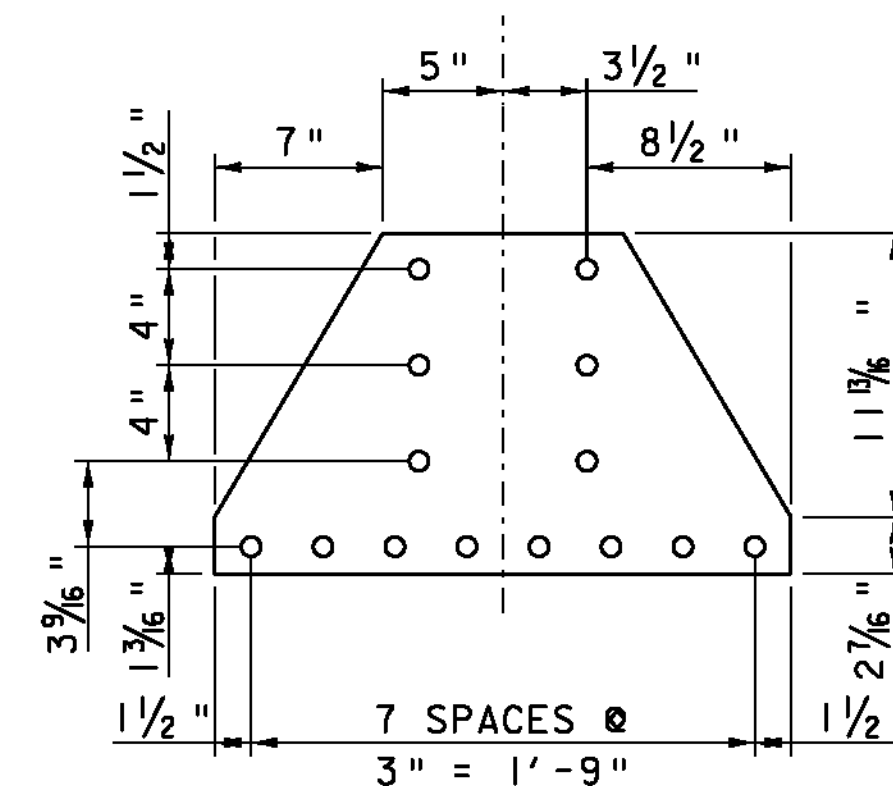

BOTTOM TYPICAL ROOF PLATE

PL 5/16 x 14 1/4 x 2' - 0"

SCALE 1 1/2" = 1'-0"

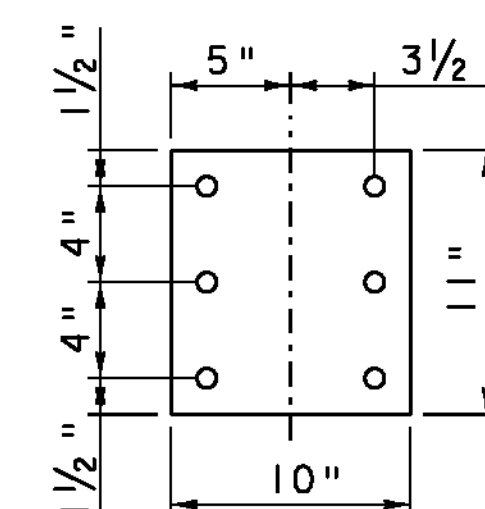

ROOF FILLER PLATE

PL 5/16 x 10 x 11"

SCALE 1 1/2" = 1'-0"

NOTE:

1. HATCHED COMPONENTS ARE NEW
2. 3/4" DIAMETER BOLTS IN 5/16" HOLE, UNLESS OTHERWISE NOTED.
3. MINIMUM BOLT EDGE AND DISTANCE = 1 1/2", UNLESS OTHERWISE NOTED.

PROJECT NAME: BRIDGEWATER

PROJECT NUMBER: BRS 0149(4)

FILE NAME: s86e062roof.dgn

PROJECT LEADER: K. HIGGINS

DESIGNED BY: T. FILLBACH

ROOF FRAMING PLAN

PLOT DATE: 31-DEC-2009

DRAWN BY: C. MOONEY

CHECKED BY: T. FILLBACH

SHEET 29 OF 58