




109+25

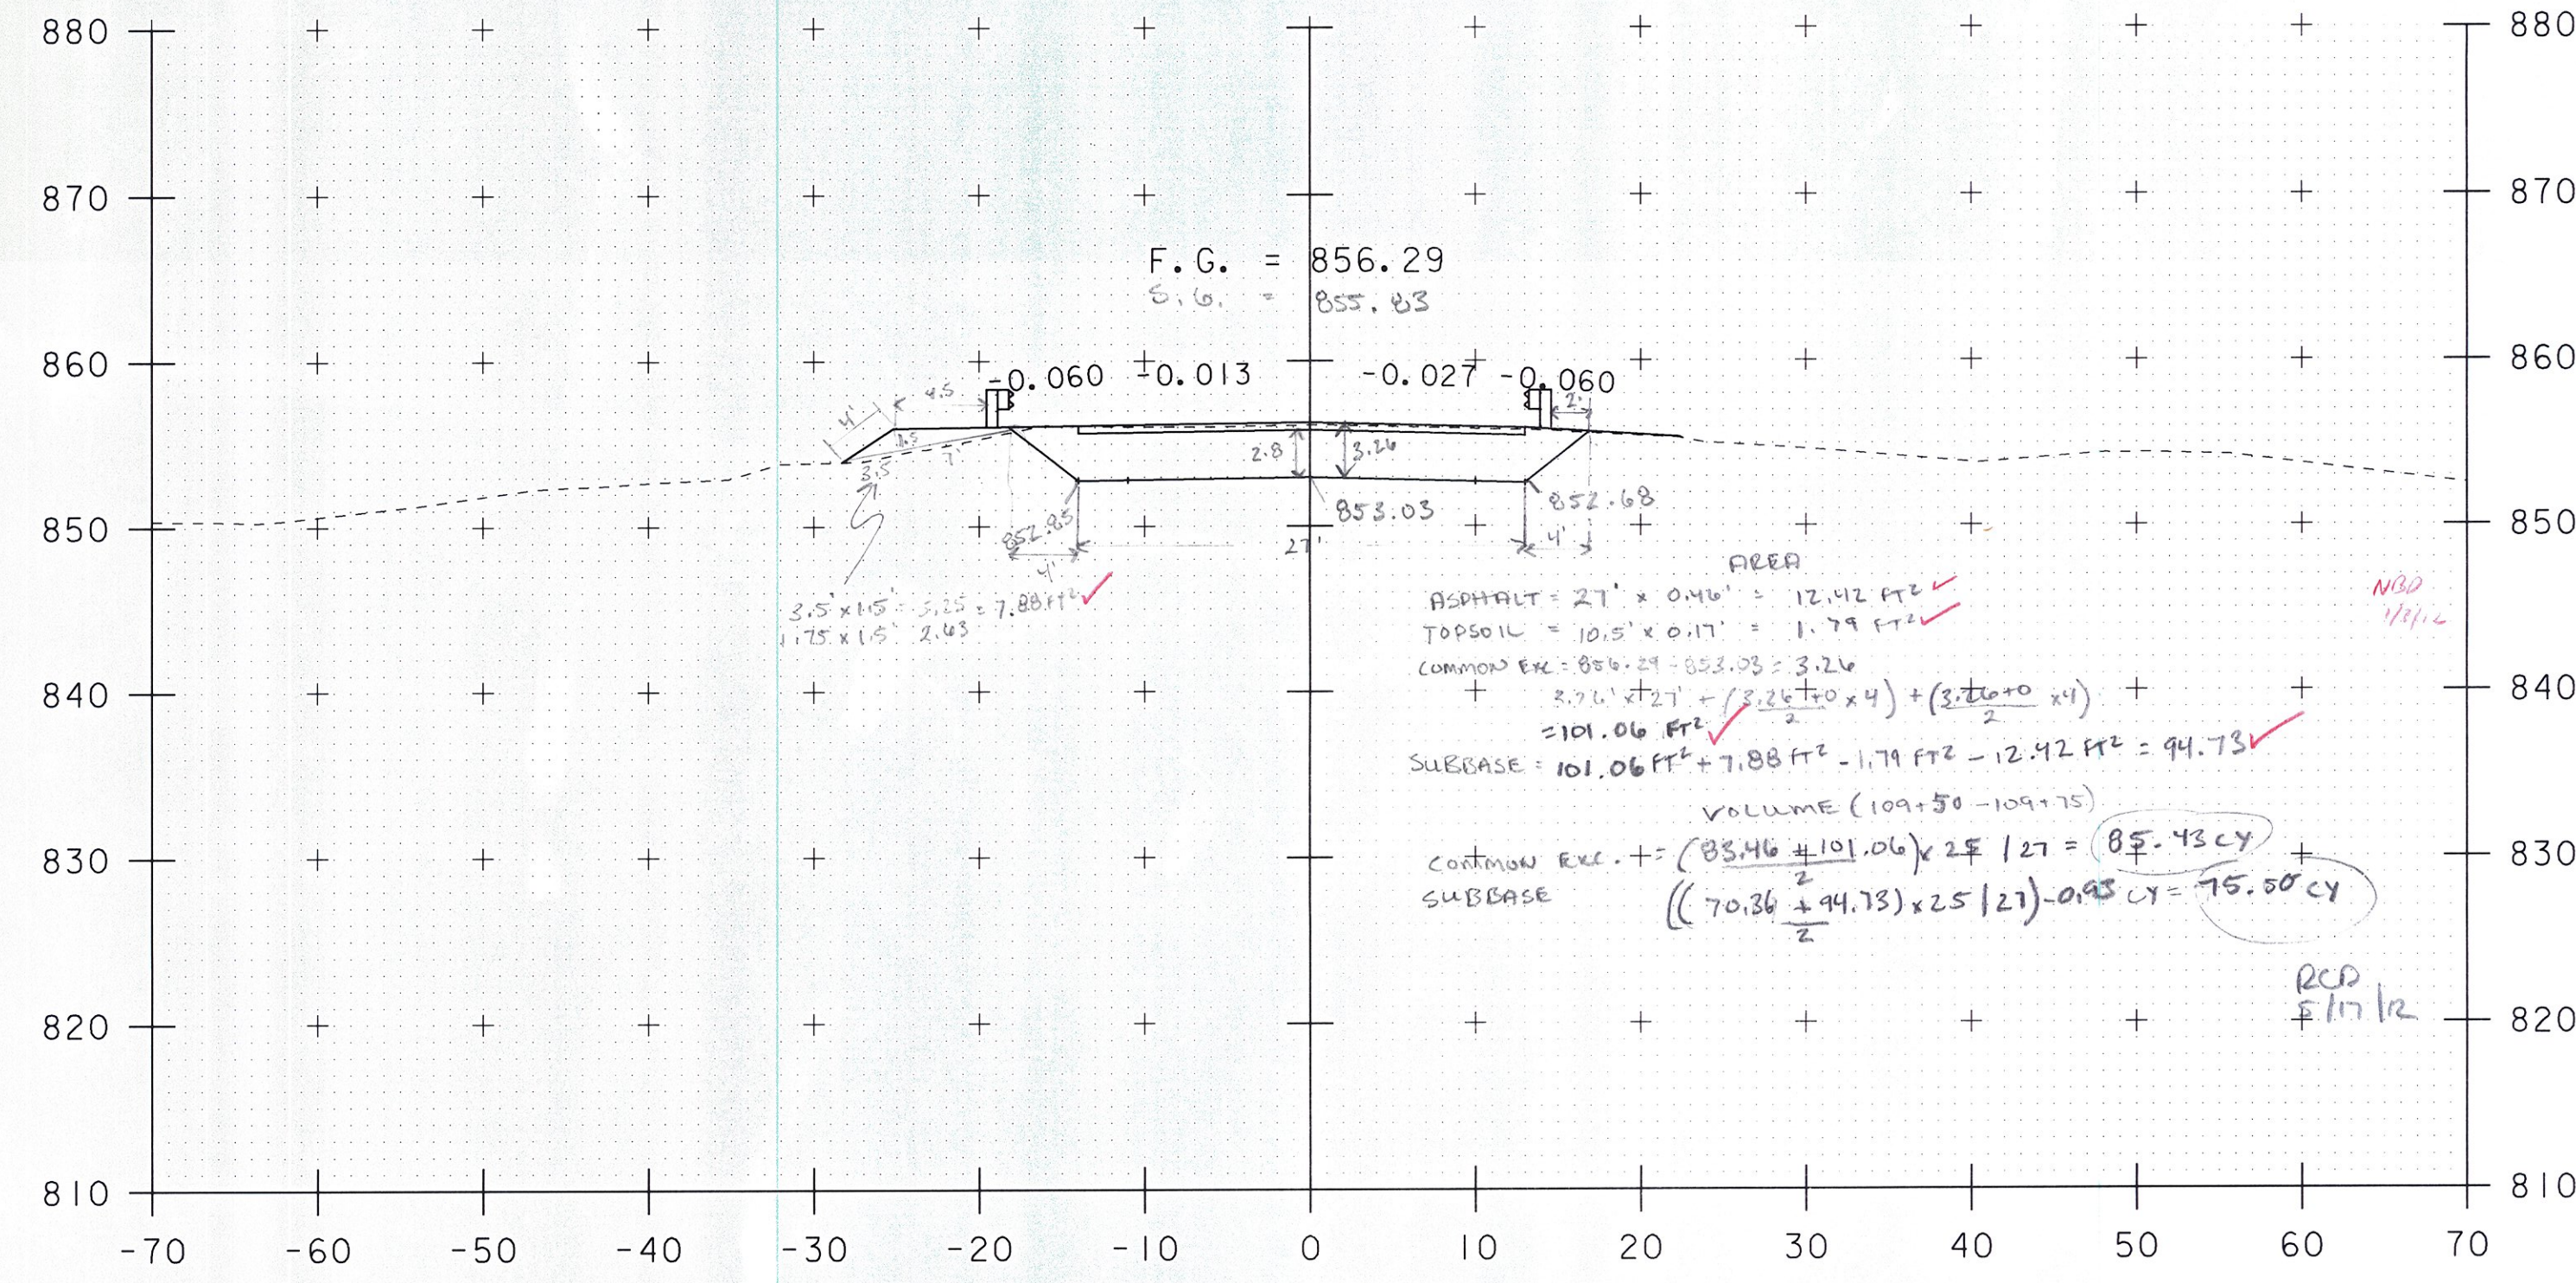


109+75

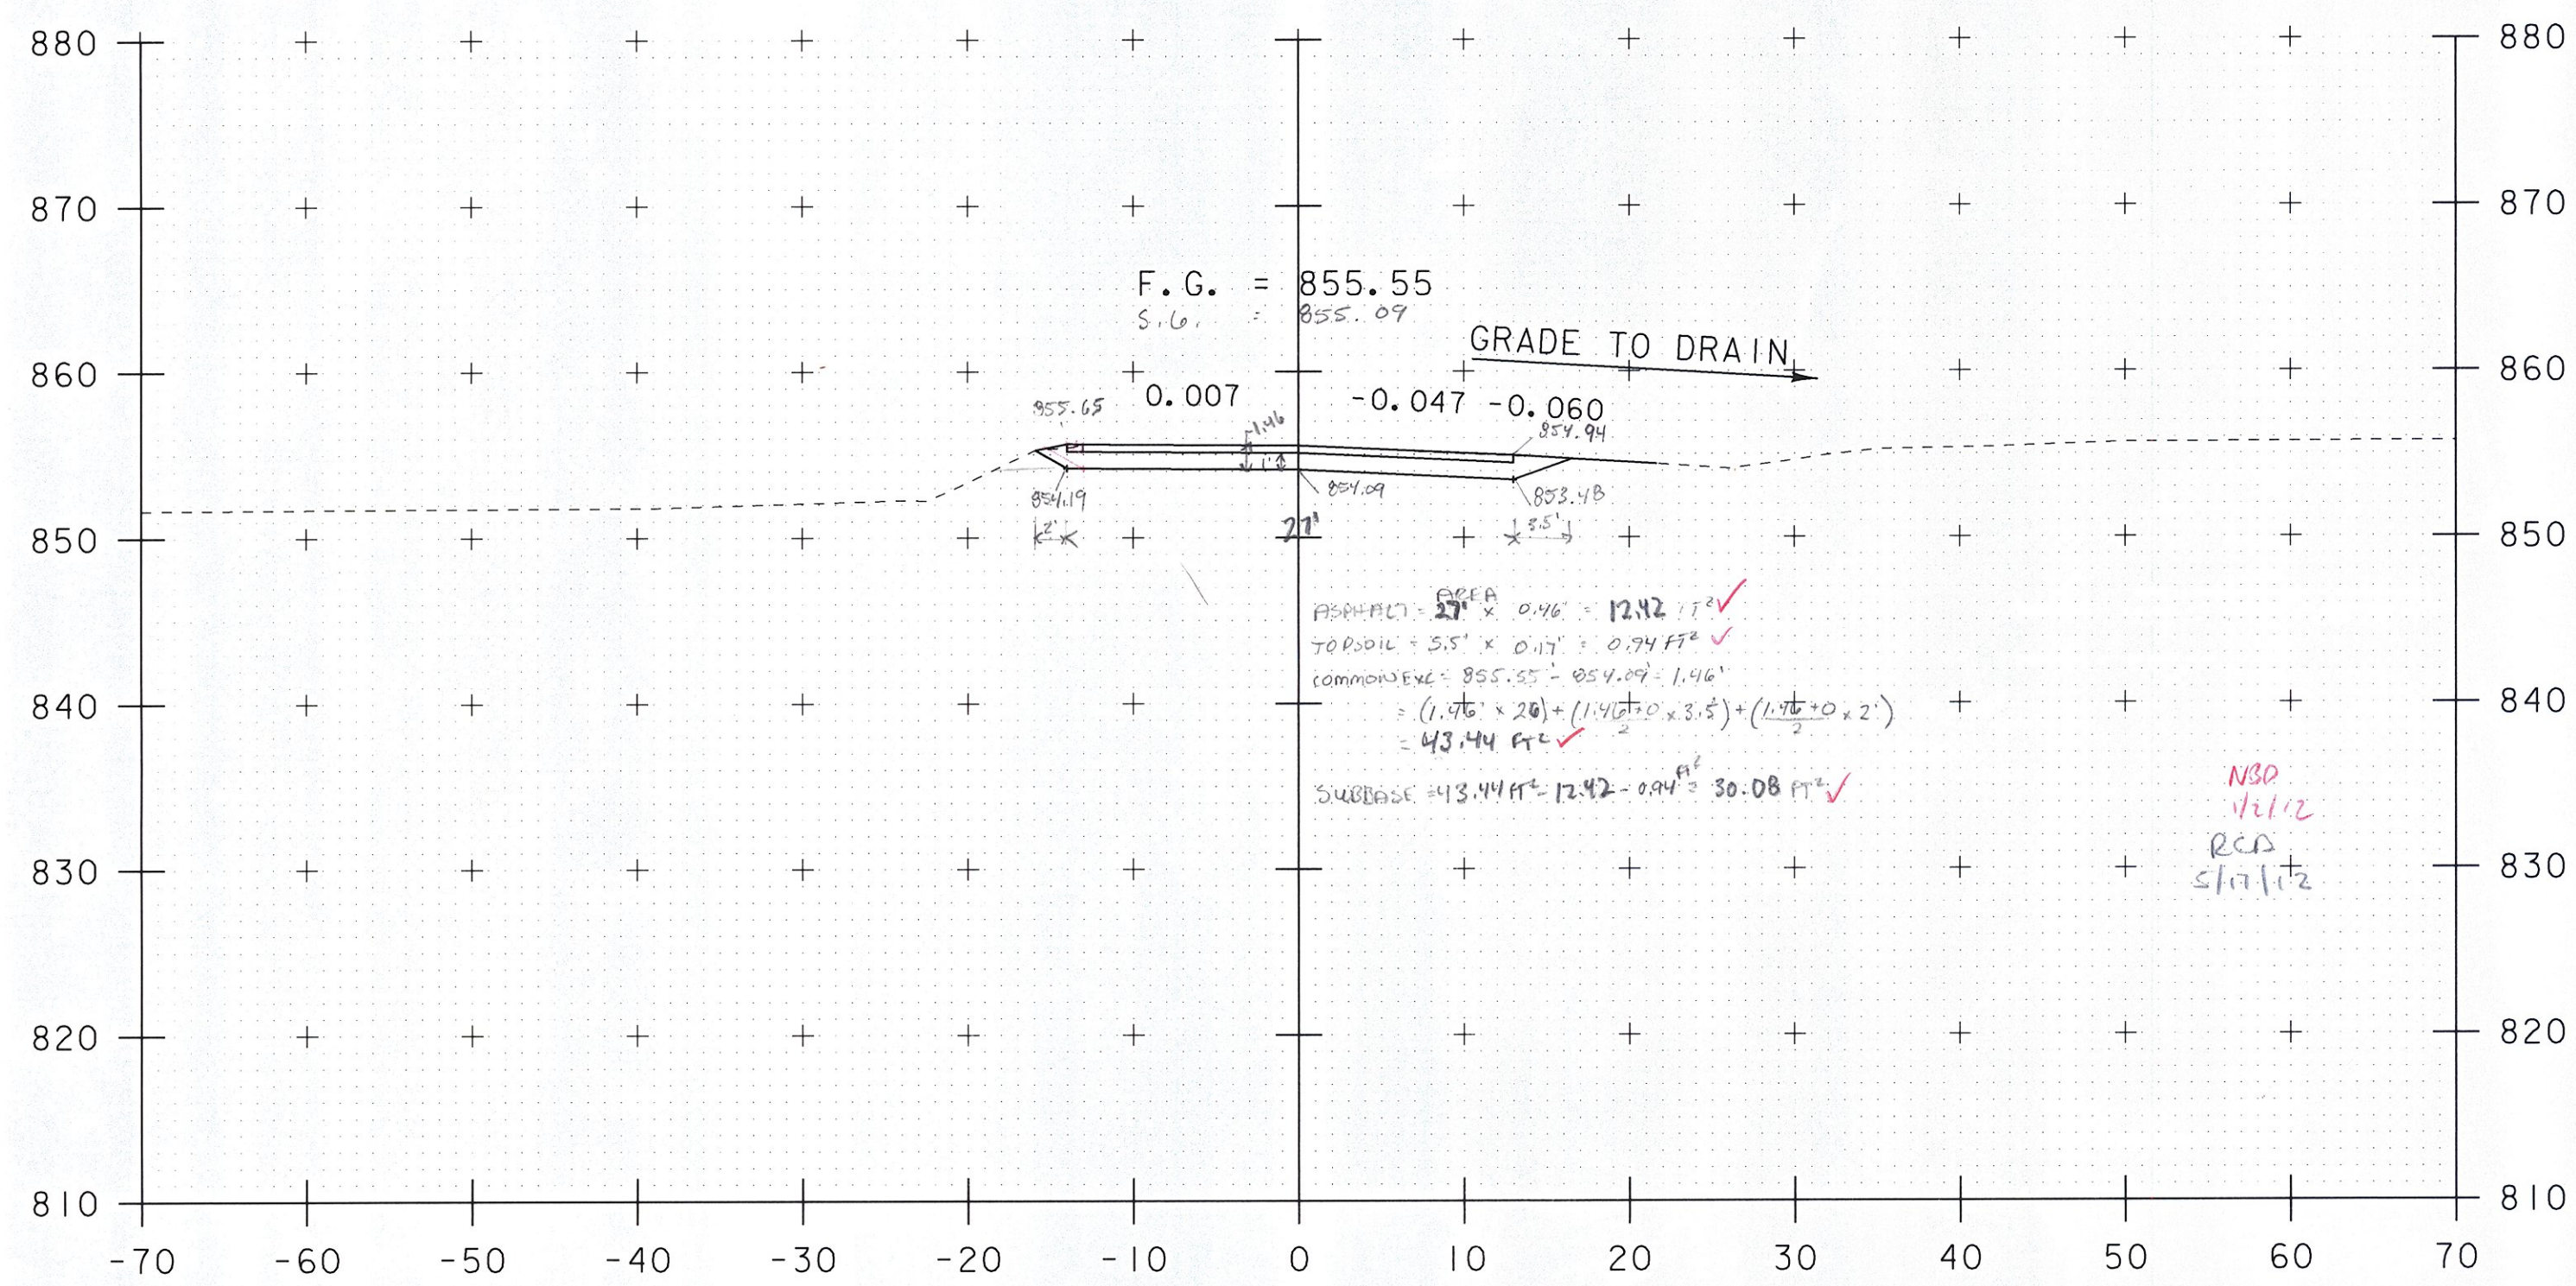

109+00

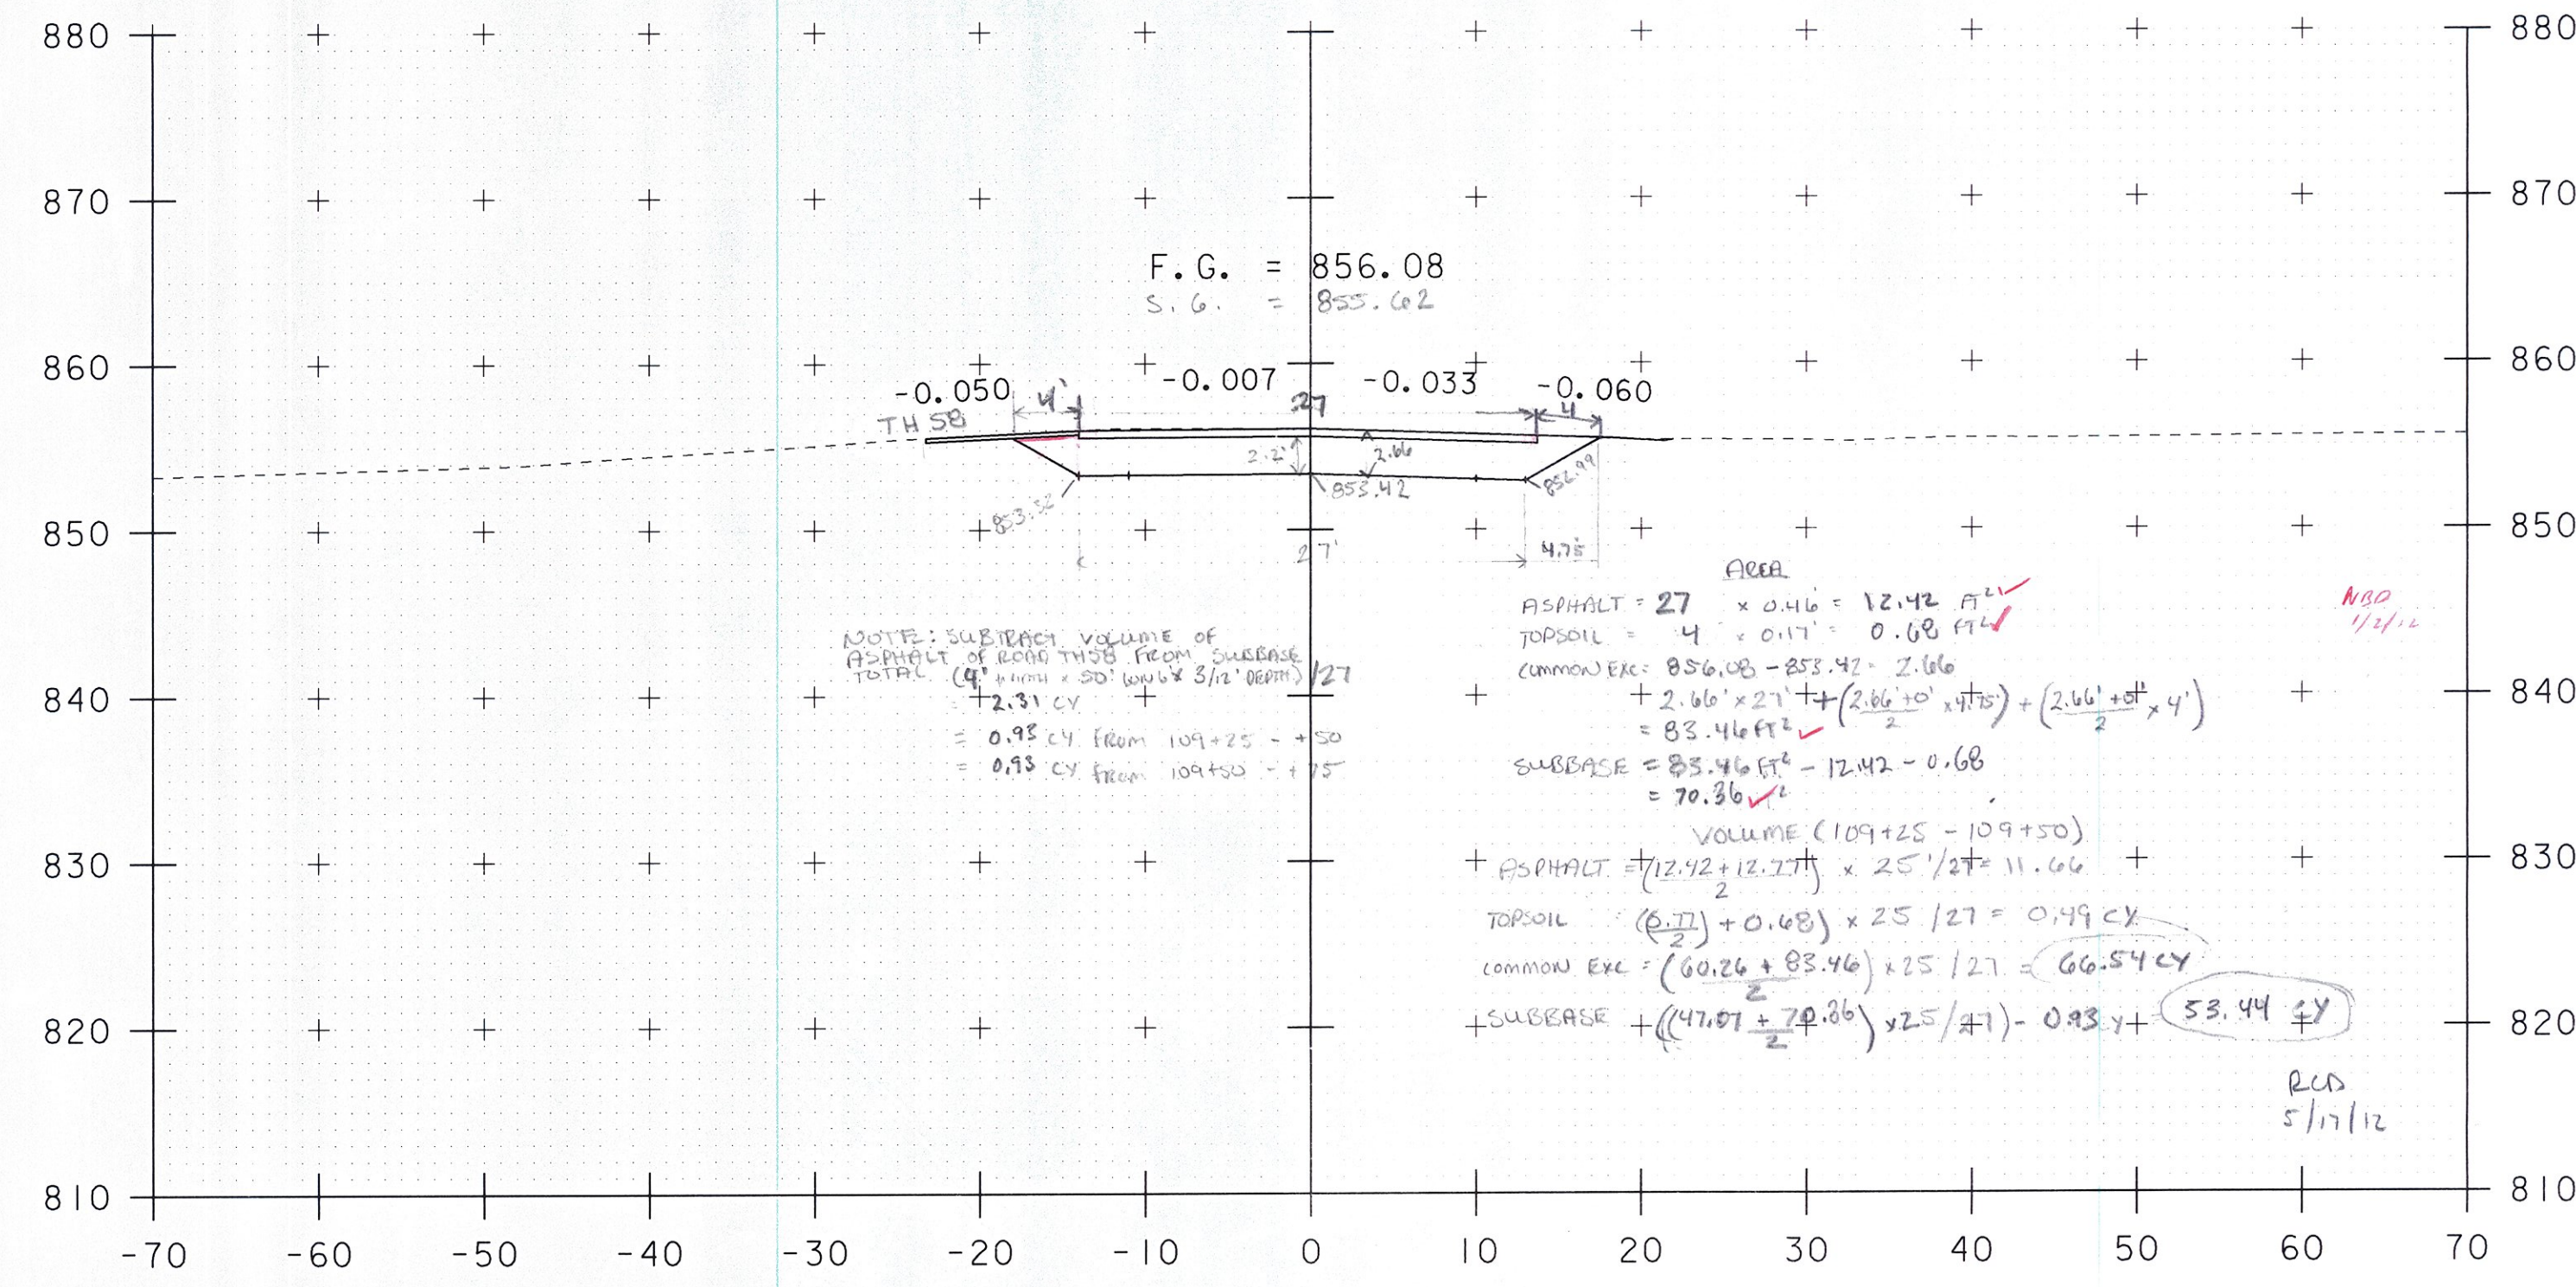

BEGIN PROJECT
109+50

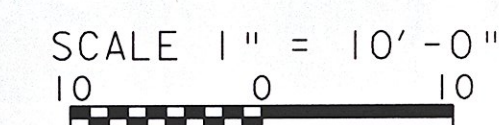

PROJECT NAME: BRIDGEWATER	PLOT DATE: 31-DEC-2009
PROJECT NUMBER: BRS 0149(4)	DRAWN BY: J. SALVATORI
FILE NAME: s86e062xs.dgn	CHECKED BY: T. FILLBACH
PROJECT LEADER: K. HIGGINS	SHEET 50 OF 58
DESIGNED BY: T. FILLBACH	
MAINLINE SECTIONS #2	