




111+75

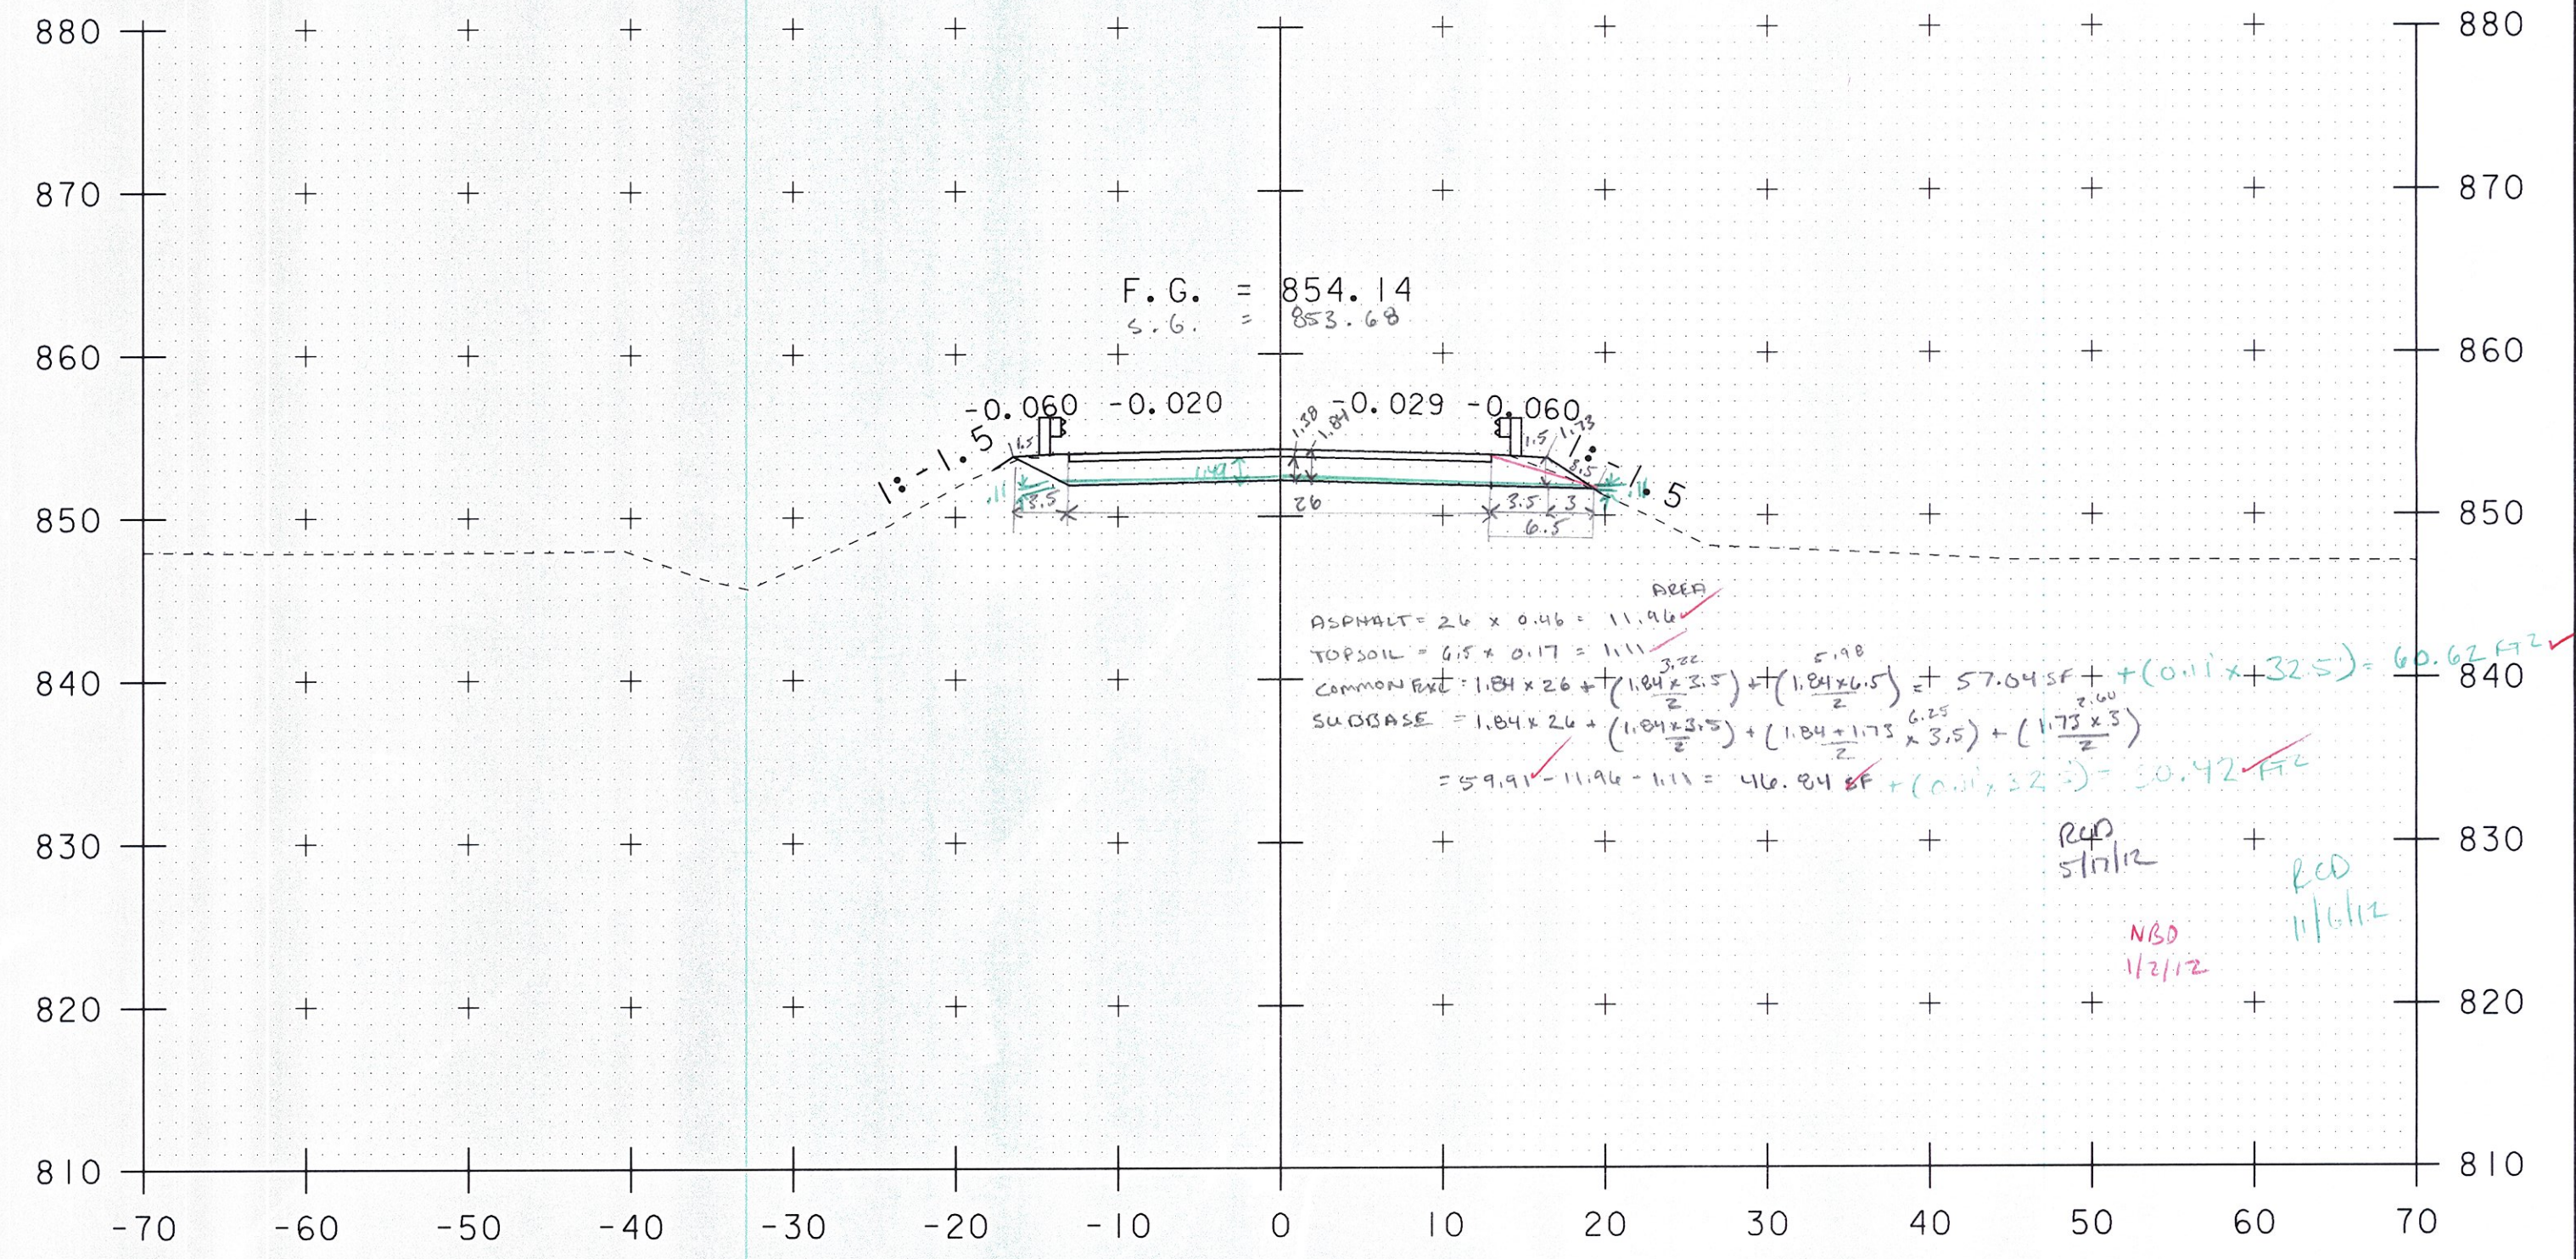


112+25

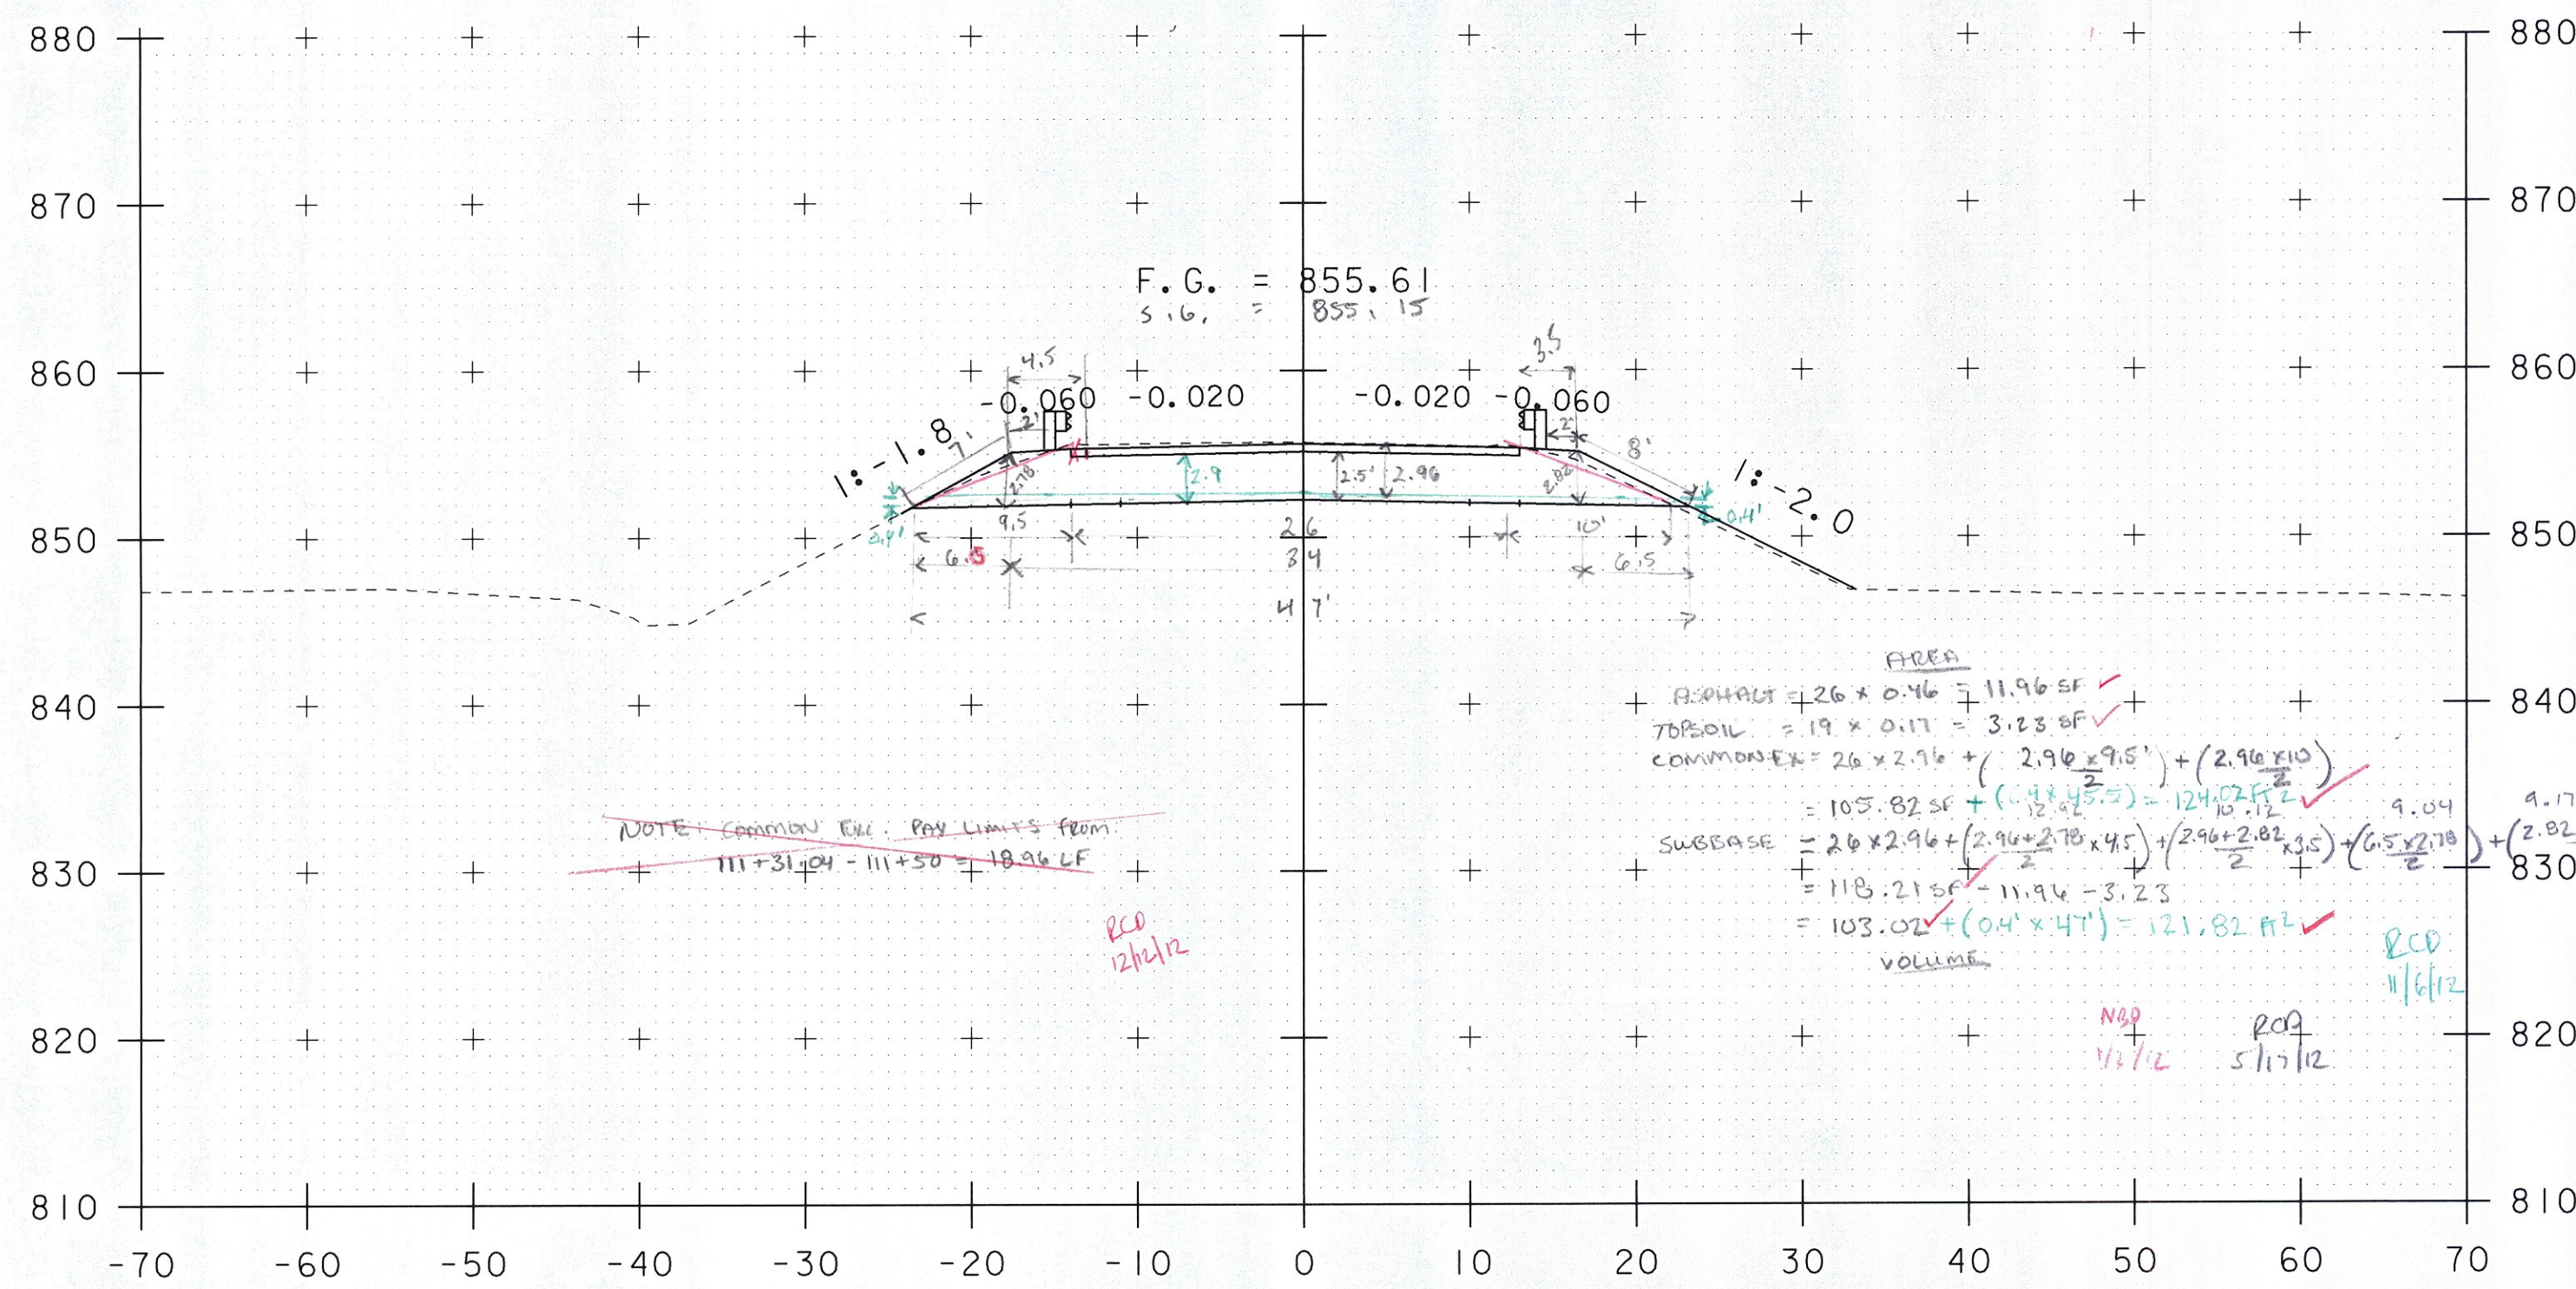

111+50

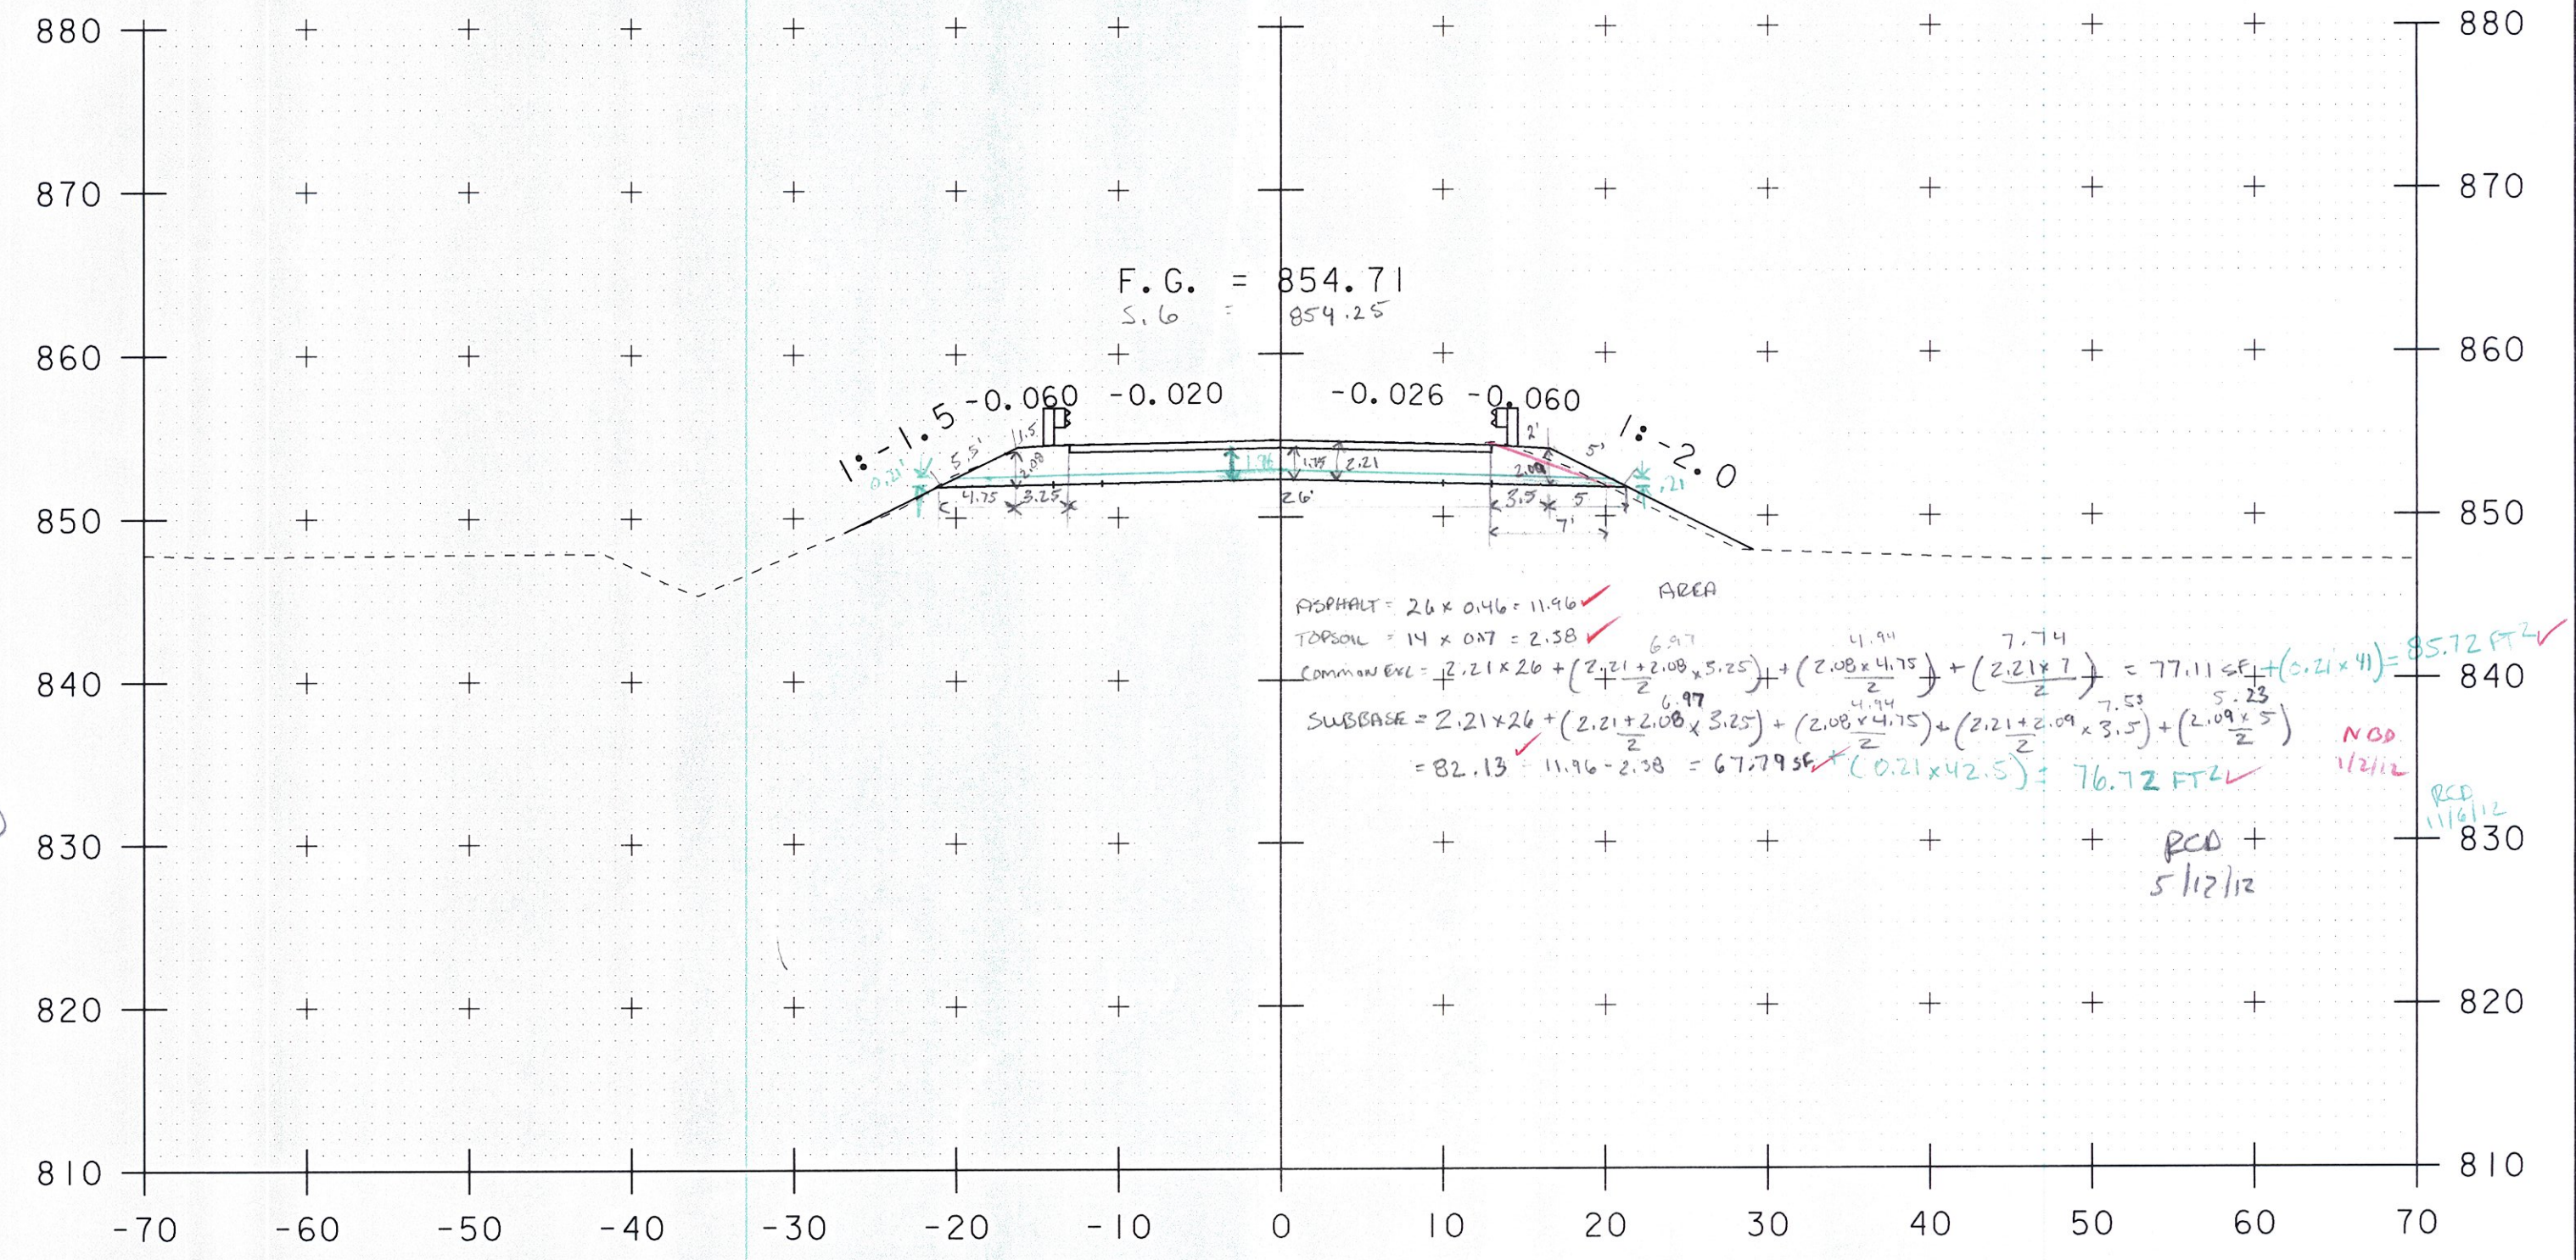

END PROJECT  
112+00

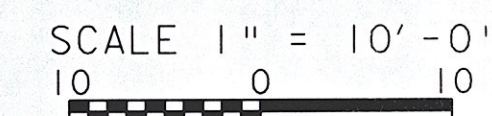

PROJECT NAME: BRIDGEWATER  
PROJECT NUMBER: BRS 0149(4)

FILE NAME: s86e062xs.dgn  
PROJECT LEADER: K. HIGGINS  
DESIGNED BY: T. FILLBACH  
MAINLINE SECTIONS #5

PLOT DATE: 31-DEC-2009  
DRAWN BY: J. SALVATORI  
CHECKED BY: T. FILLBACH  
SHEET 53 OF 58