


112+75

113+25

112+50

END APPROACH
113+00

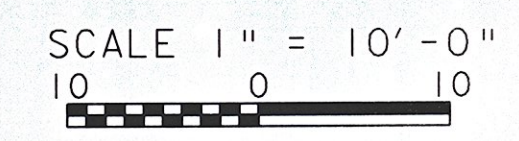

PROJECT NAME: BRIDGEWATER	PLOT DATE: 31-DEC-2009
PROJECT NUMBER: BRS 0149(4)	DRAWN BY: J. SALVATORI
FILE NAME: s86e062xs.dgn	CHECKED BY: T. FILLBACH
PROJECT LEADER: K. HIGGINS	SHEET 54 OF 58
DESIGNED BY: T. FILLBACH	
MAINLINE SECTIONS *6	