


3+82 LT
STOP GRUBBING MATERIAL


3+75

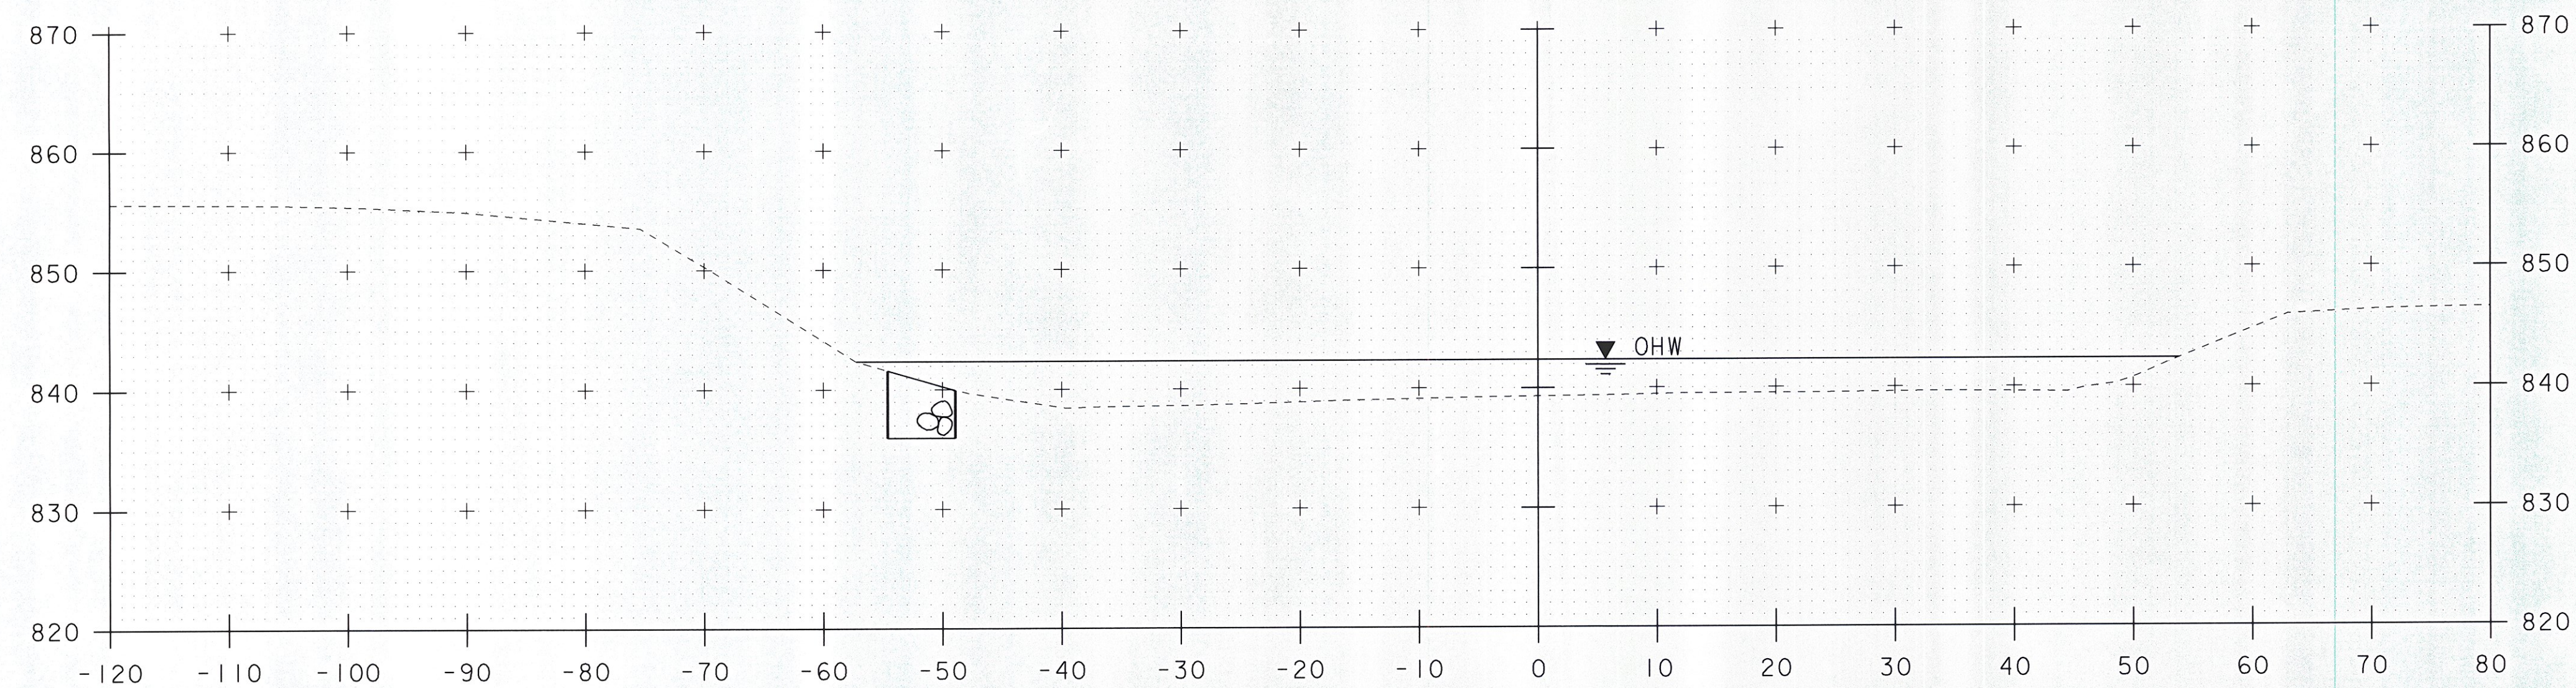

3+47 LT
BEGIN UNCLASSIFIED CHANNEL EXCAVATION,
STONE FILL, TYPE IV
GEOTEXTILE UNDER STONE FILL
GRUBBING MATERIAL

3+54 RT
BEGIN UNCLASSIFIED CHANNEL EXCAVATION,
STONE FILL, TYPE IV
GEOTEXTILE UNDER STONE FILL
GRUBBING MATERIAL

3+50

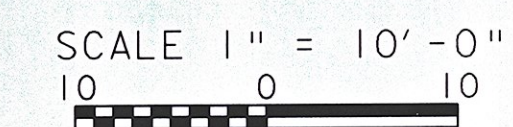

PROJECT NAME: BRIDGEWATER
PROJECT NUMBER: BRS 0149(4)

FILE NAME: s86e062xs.dgn
PROJECT LEADER: K. HIGGINS
DESIGNED BY: T. FILLBACH
CHANNEL SECTIONS *2

PLOT DATE: 31-DEC-2009
DRAWN BY: J. SALVATORI
CHECKED BY: T. FILLBACH
SHEET 56 OF 58