


4+29 RT  
 STOP UNCLASSIFIED CHANNEL EXCAVATION,  
 STONE FILL, TYPE IV  
 GEOTEXTILE UNDER STONE FILL  
 GRUBBING MATERIAL

4+40 LT  
 STOP UNCLASSIFIED CHANNEL EXCAVATION,  
 STONE FILL, TYPE IV  
 GEOTEXTILE UNDER STONE FILL  
 GRUBBING MATERIAL

4+25

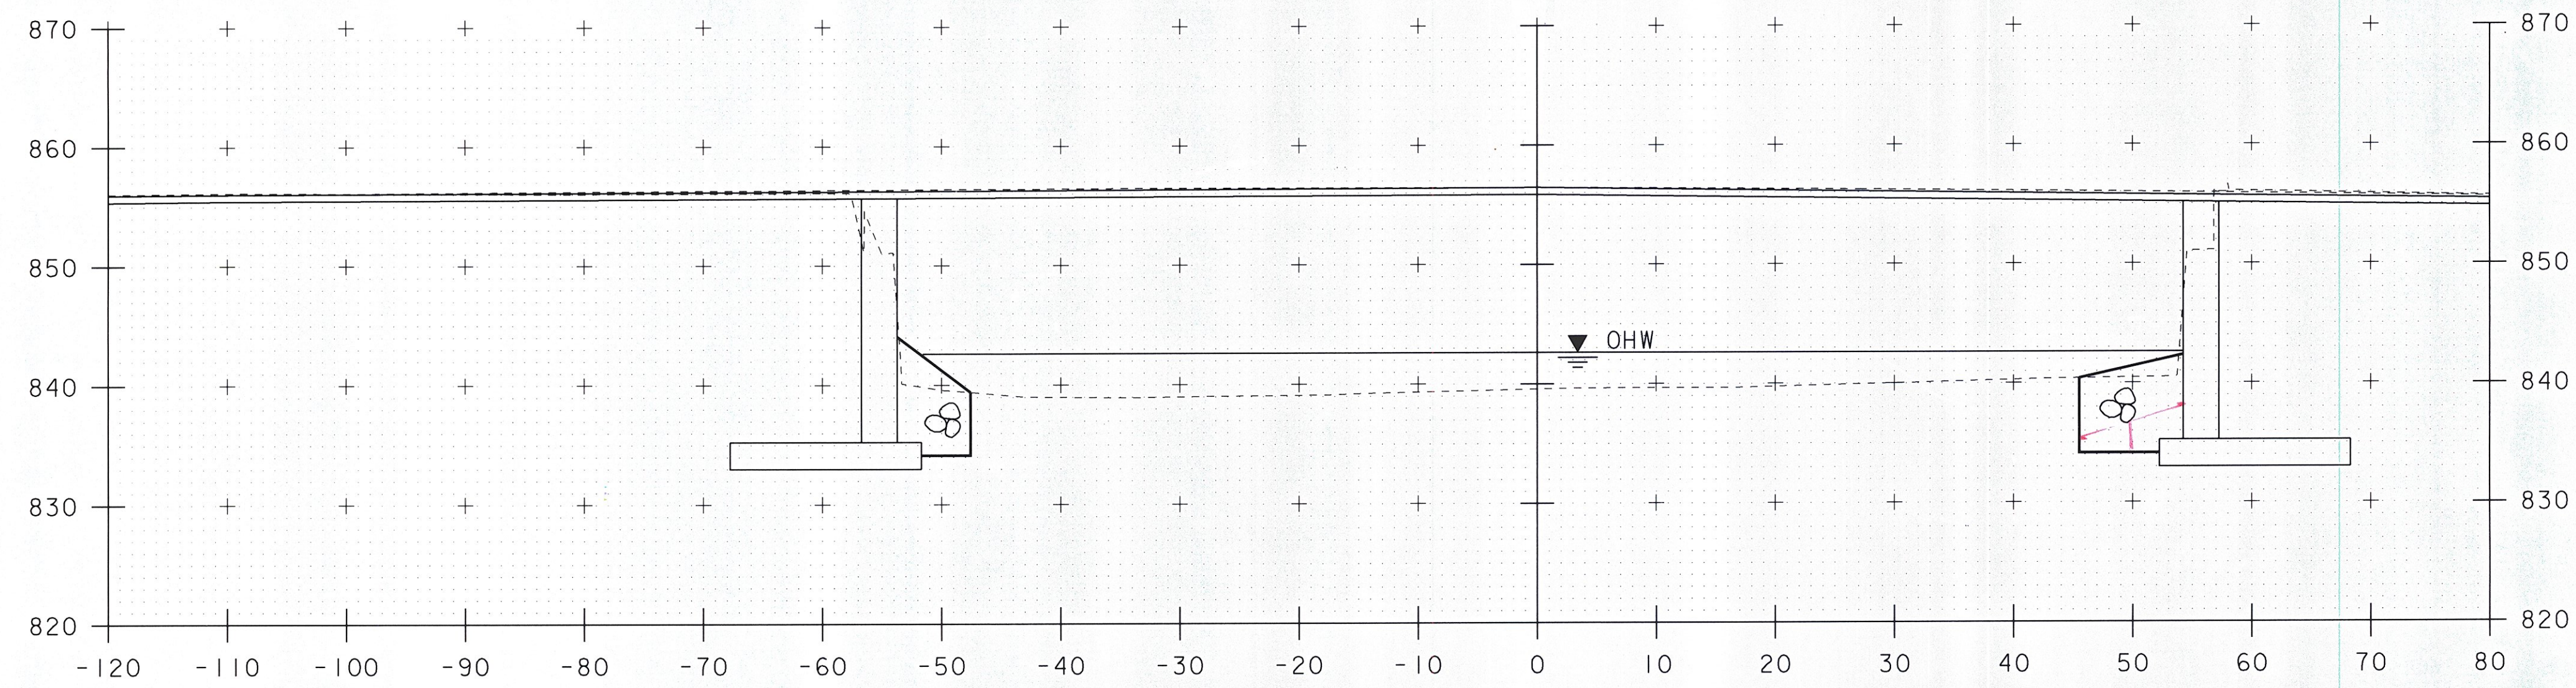

3+90 RT  
 STOP GRUBBING MATERIAL

4+10 LT  
 RESUME GRUBBING MATERIAL

4+18 RT  
 RESUME GRUBBING MATERIAL

NO GRUBBING MATERIAL  
 BENEATH NEW BRIDGE

4+00

SCALE 1" = 10'-0"  
 10 0 10

PROJECT NAME: BRIDGEWATER	
PROJECT NUMBER: BRS 0149(4)	
FILE NAME: s86e062xs.dgn	PLOT DATE: 31-DEC-2009
PROJECT LEADER: K. HIGGINS	DRAWN BY: J. SALVATORI
DESIGNED BY: T. FILLBACH	CHECKED BY: T. FILLBACH
CHANNEL SECTIONS #3	SHEET 57 OF 58