

STEEL BEAM GUARDRAIL
 STA 610+00.42 RT - STA 610+68.75 RT
 STA 612+31.25 RT - STA 614+61.93 RT
 STA 700+44.57 LT - STA 610+68.76 LT
 STA 612+31.22 LT - STA 614+49.24 LT

CONSTRUCT DRIVES
 STA 614+55.46 LT
 STA 614+72.76 RT

ANCHOR FOR STEEL BEAM RAIL
 STA 610+08.42 RT
 STA 614+53.93 RT
 STA 700+36.57 LT
 STA 614+41.24 LT

TEMPORARY LINE STRIPING
YELLOW:
 STA 609+00 - STA 609+75
 STA 614+34.52 - STA 615+00
 STA 700+53.21 - STA 700+90
WHITE:
 STA 609+00 LT - STA 700+09.53 LT
 STA 700+34 RT - 610+71.75 LT
 STA 609+00 RT - STA 610+71.75 RT
 STA 612+28.25 LT - STA 615+00 LT
 STA 612+28.25 RT - STA 615+00 RT

REMOVAL AND DISPOSAL OF GUARD RAIL
 STA 610+76.16 LT - STA 610+82.94 LT


TEMPORARY STOP BAR
 STA 609+75 RT
 STA 614+34.52 LT
 STA 700+53.21 LT

REMOVAL AND DISPOSAL OF WOVEN WIRE FENCE
 STA 612+50.8 RT - STA 613+62.5 RT
 (APPROX 200')

PROJECT NAME: BRIDGEWATER
 PROJECT NUMBER: BRS 0149(4)

FILE NAME: 86e062/se062bdr.dgn
 PROJECT LEADER: C.S. KELLER
 DESIGNED BY: T. FILLBACH
 se0621a1

PLOT DATE: 14-SEP-2005
 DRAWN BY: STR 5
 CHECKED BY: T. SUMNER
 SHEET 5 OF 18

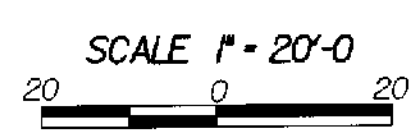

LAYOUT