


808128-7

NOTES—
 SECTION A-A SIMILAR SECTION A-A ABUTMENT NO. 1.
 SECTION B-B SIMILAR TO SECTION B-B ABUTMENT NO. 1.
 ELEVATION C-C SIMILAR TO ELEVATION C-C ABUTMENT NO. 1.
 DETAIL OF COPING SAME AS ON ABUTMENT NO. 1.
 CONSTRUCTION NOTES SAME AS ABUTMENT NO. 1.
 ALL CONCRETE TO BE CLASS B-(1-21-9)

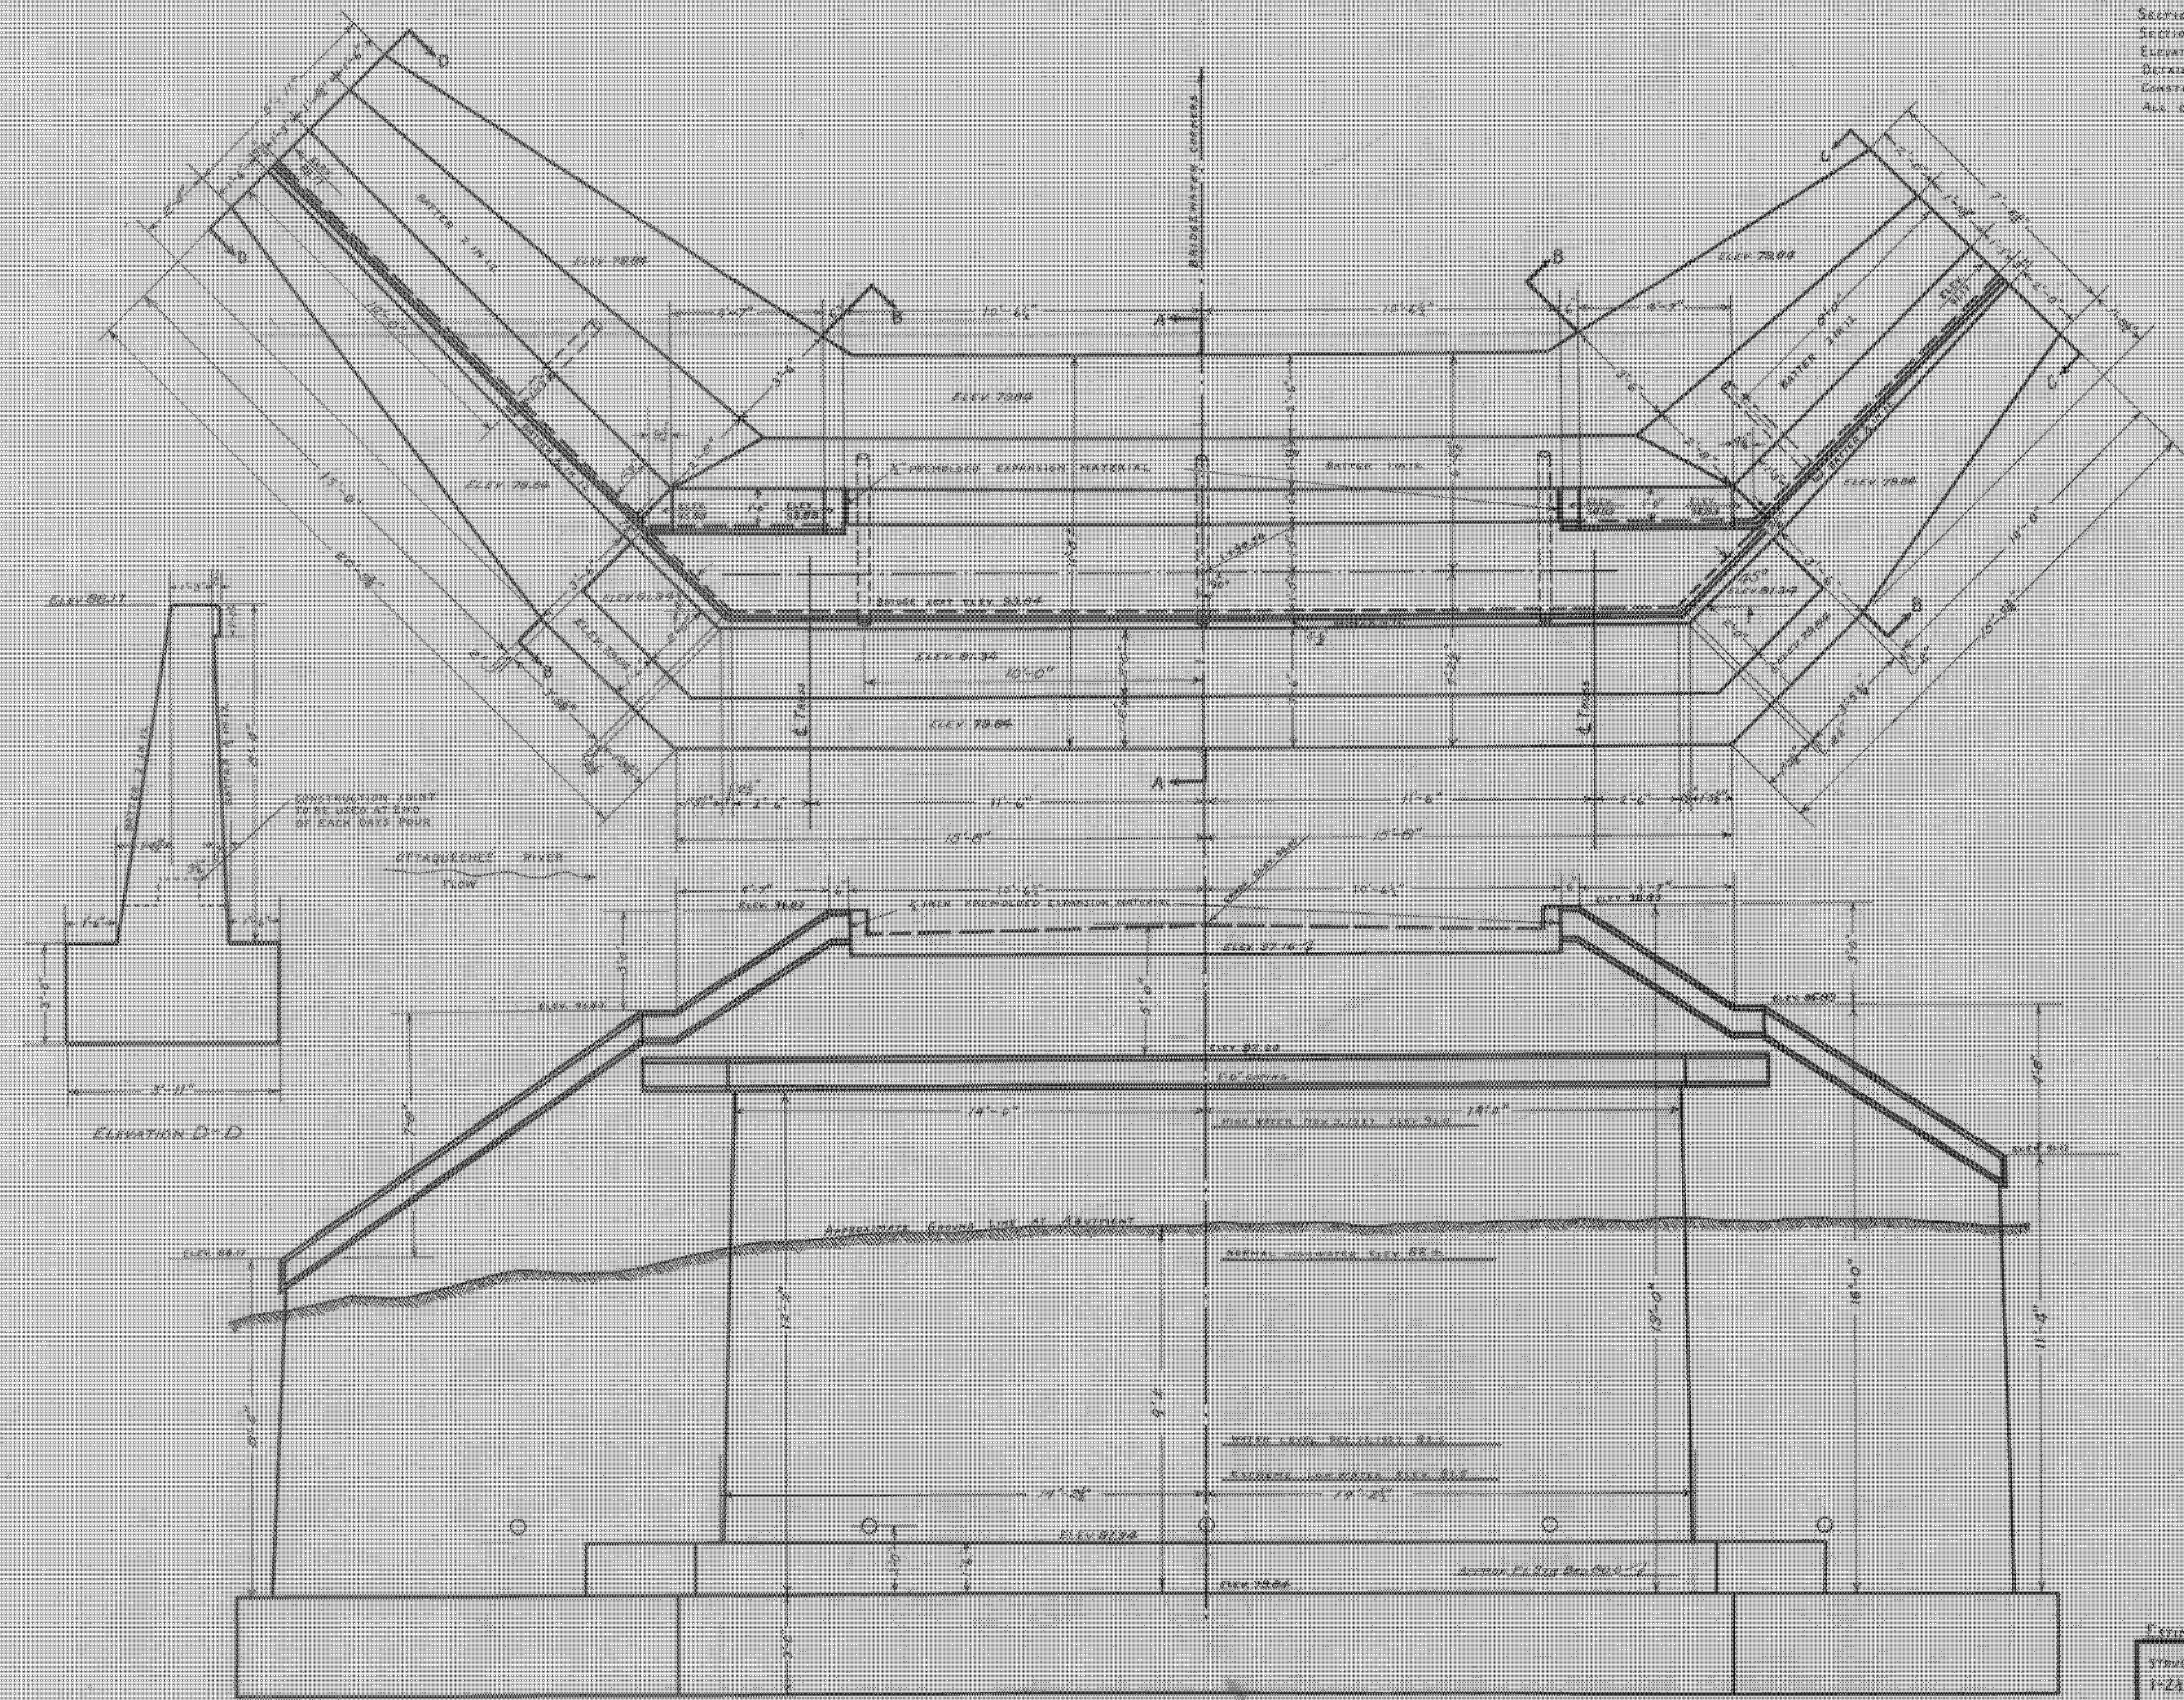

ABUTMENT NO. 2
 BRIDGE NO. 79
 DISTRICT NO. 5
 BRIDGEWATER, VT.

ESTIMATED QUANTITIES

STRUCTURE EXCAVATION	370	CU.YDS.
1-2 1/2 CONCRETE	179	CU.YDS.
REINFORCING STEEL	3070	LBS.
TIMBER PILING	1450	LIN. FT.

Surveyed by POTHAM
 Designed by H.P. RADIGAN
 Drawn by H.P. RADIGAN - W.G. BARRETT
 Traced by W.G. BARRETT
 Checked by H.P. RADIGAN
 Series 5 No. 79-102
 Sheet 7 of 11 Sheets