




610+25

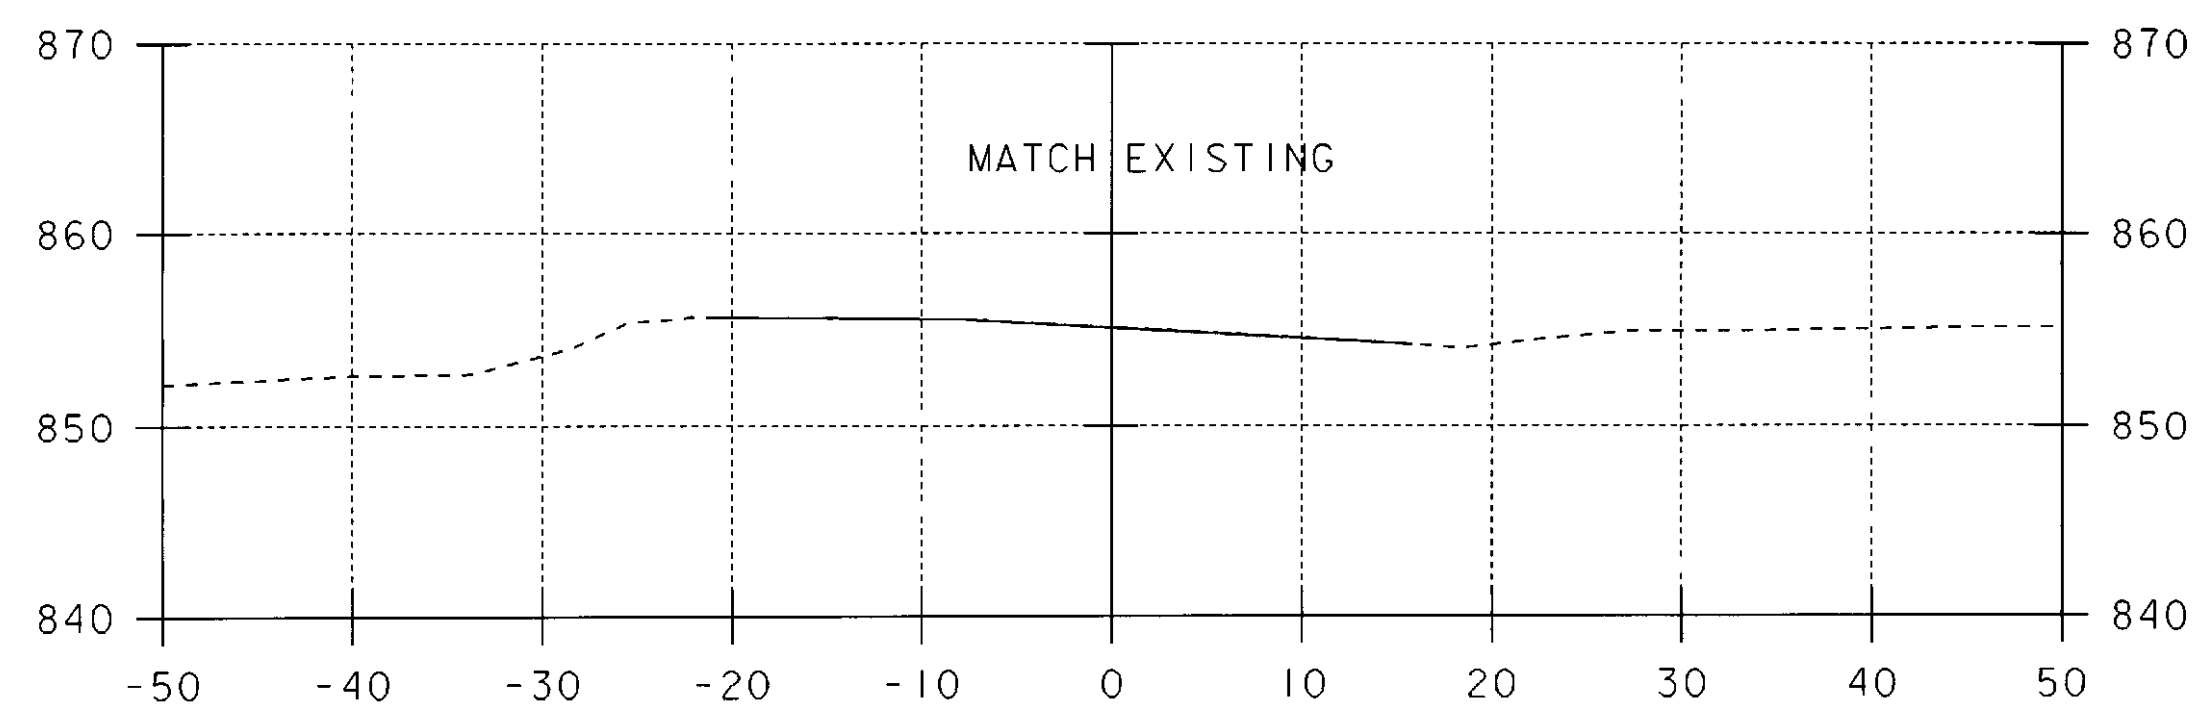


610+00

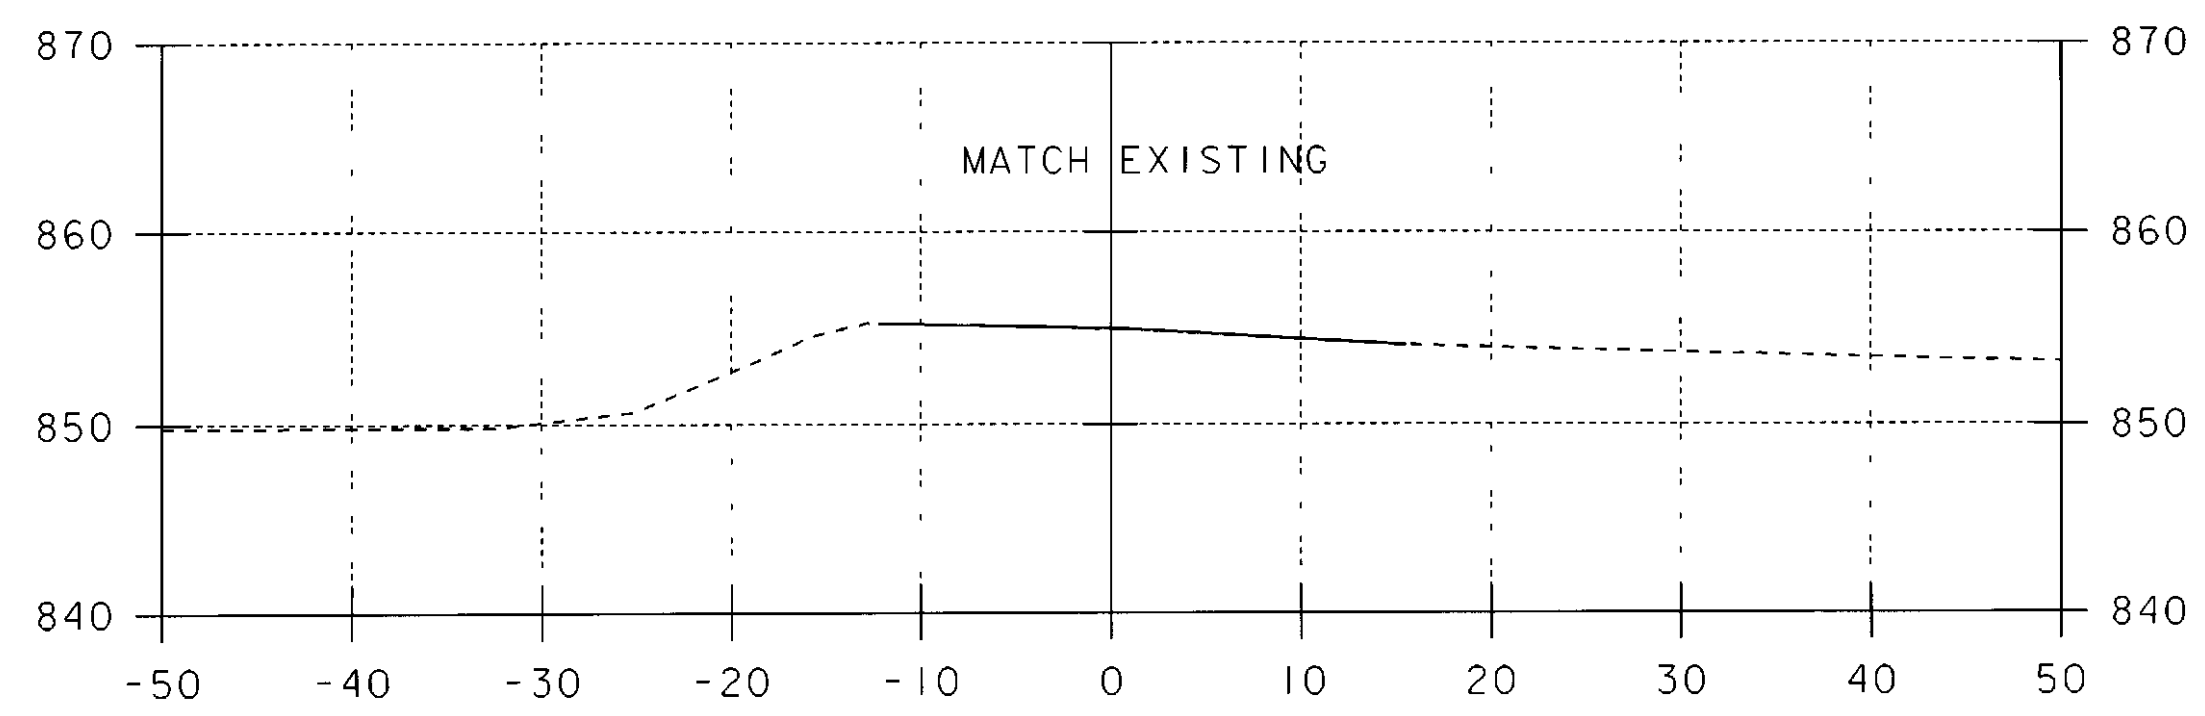


609+50

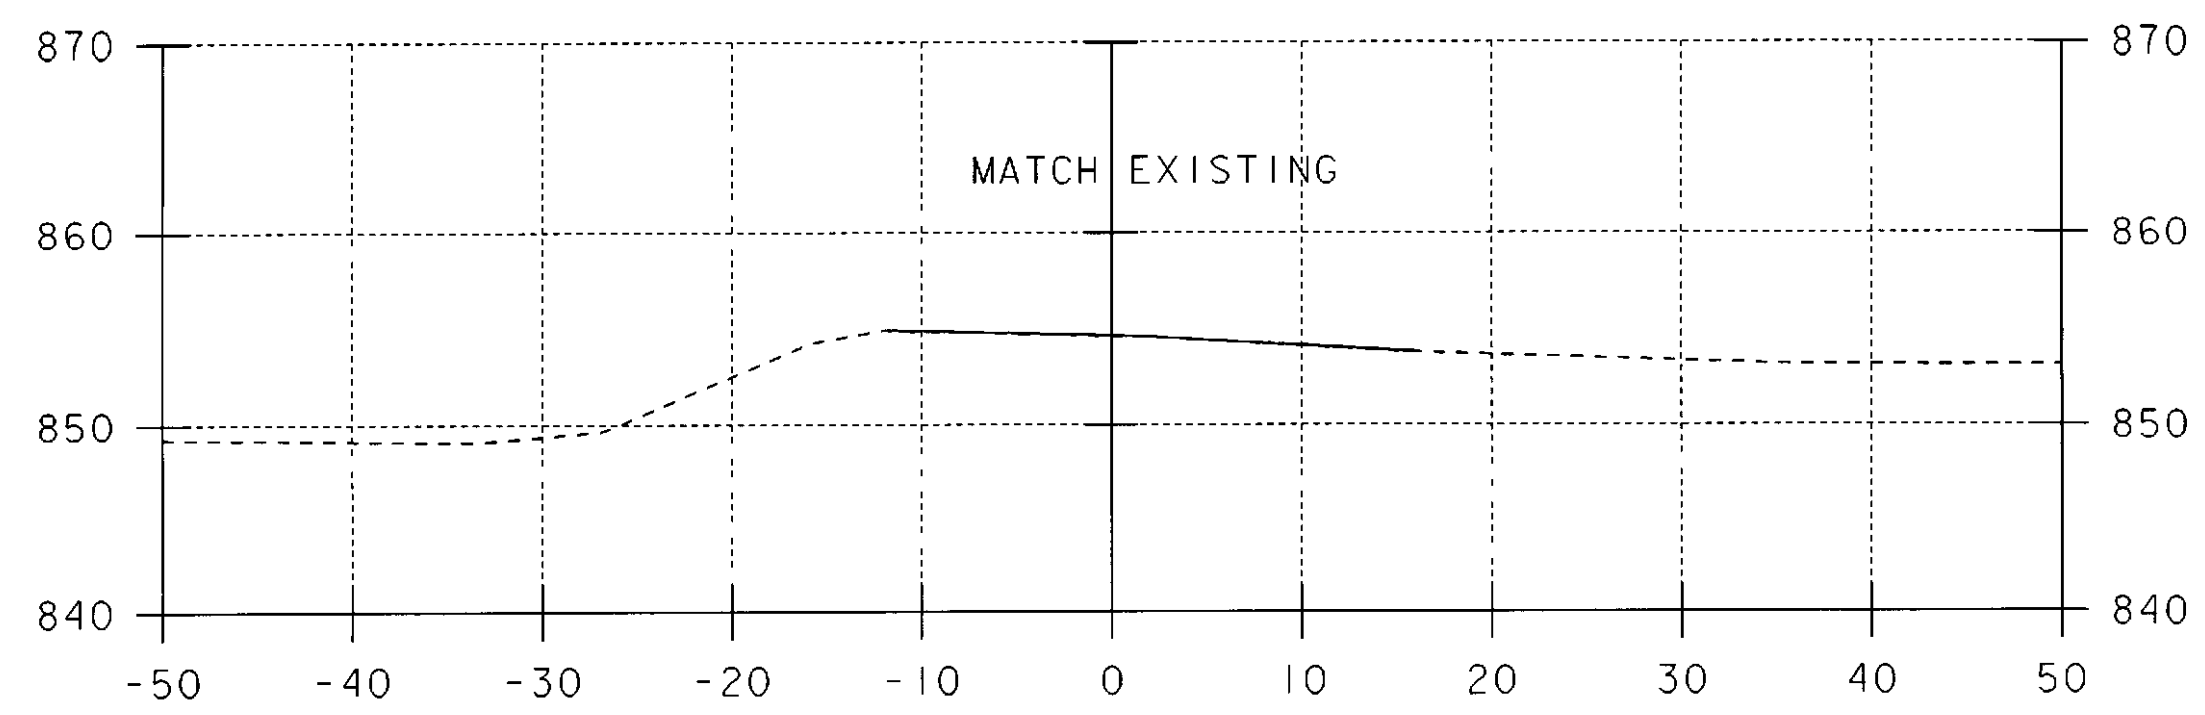


609+00

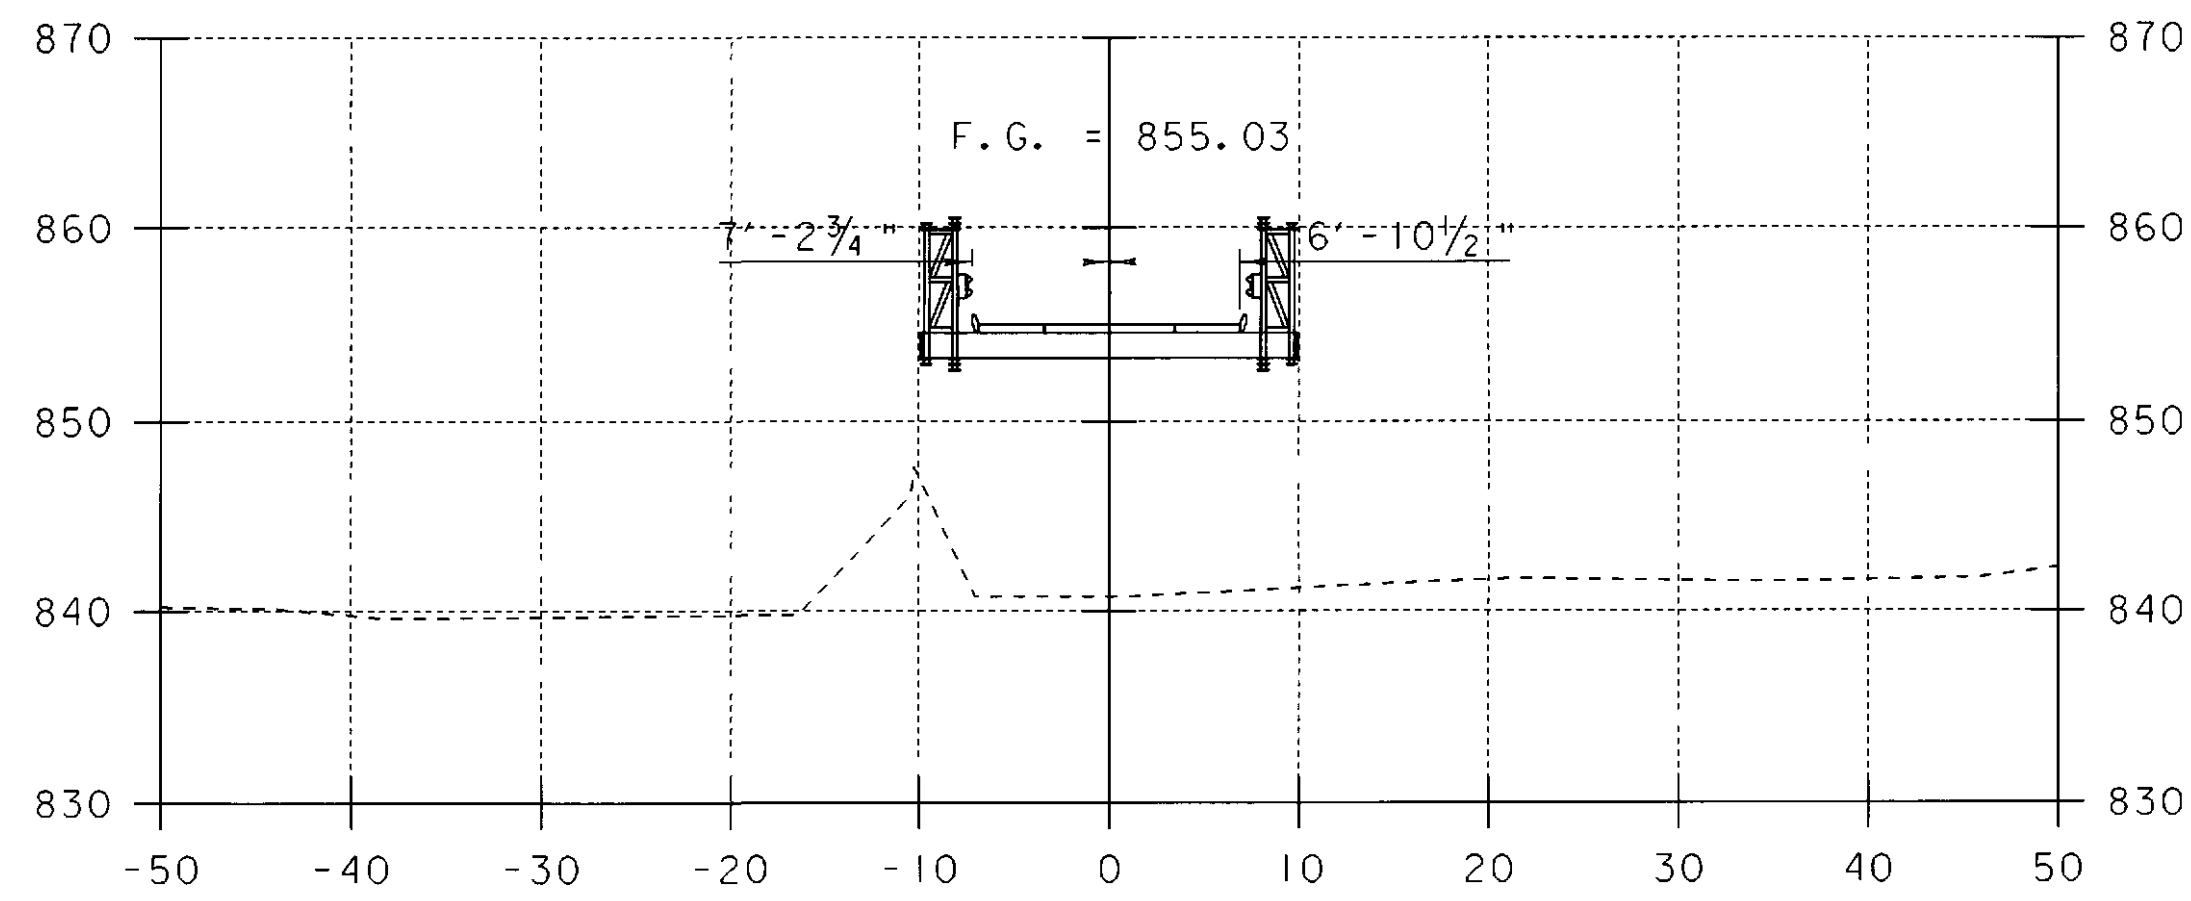


611+00

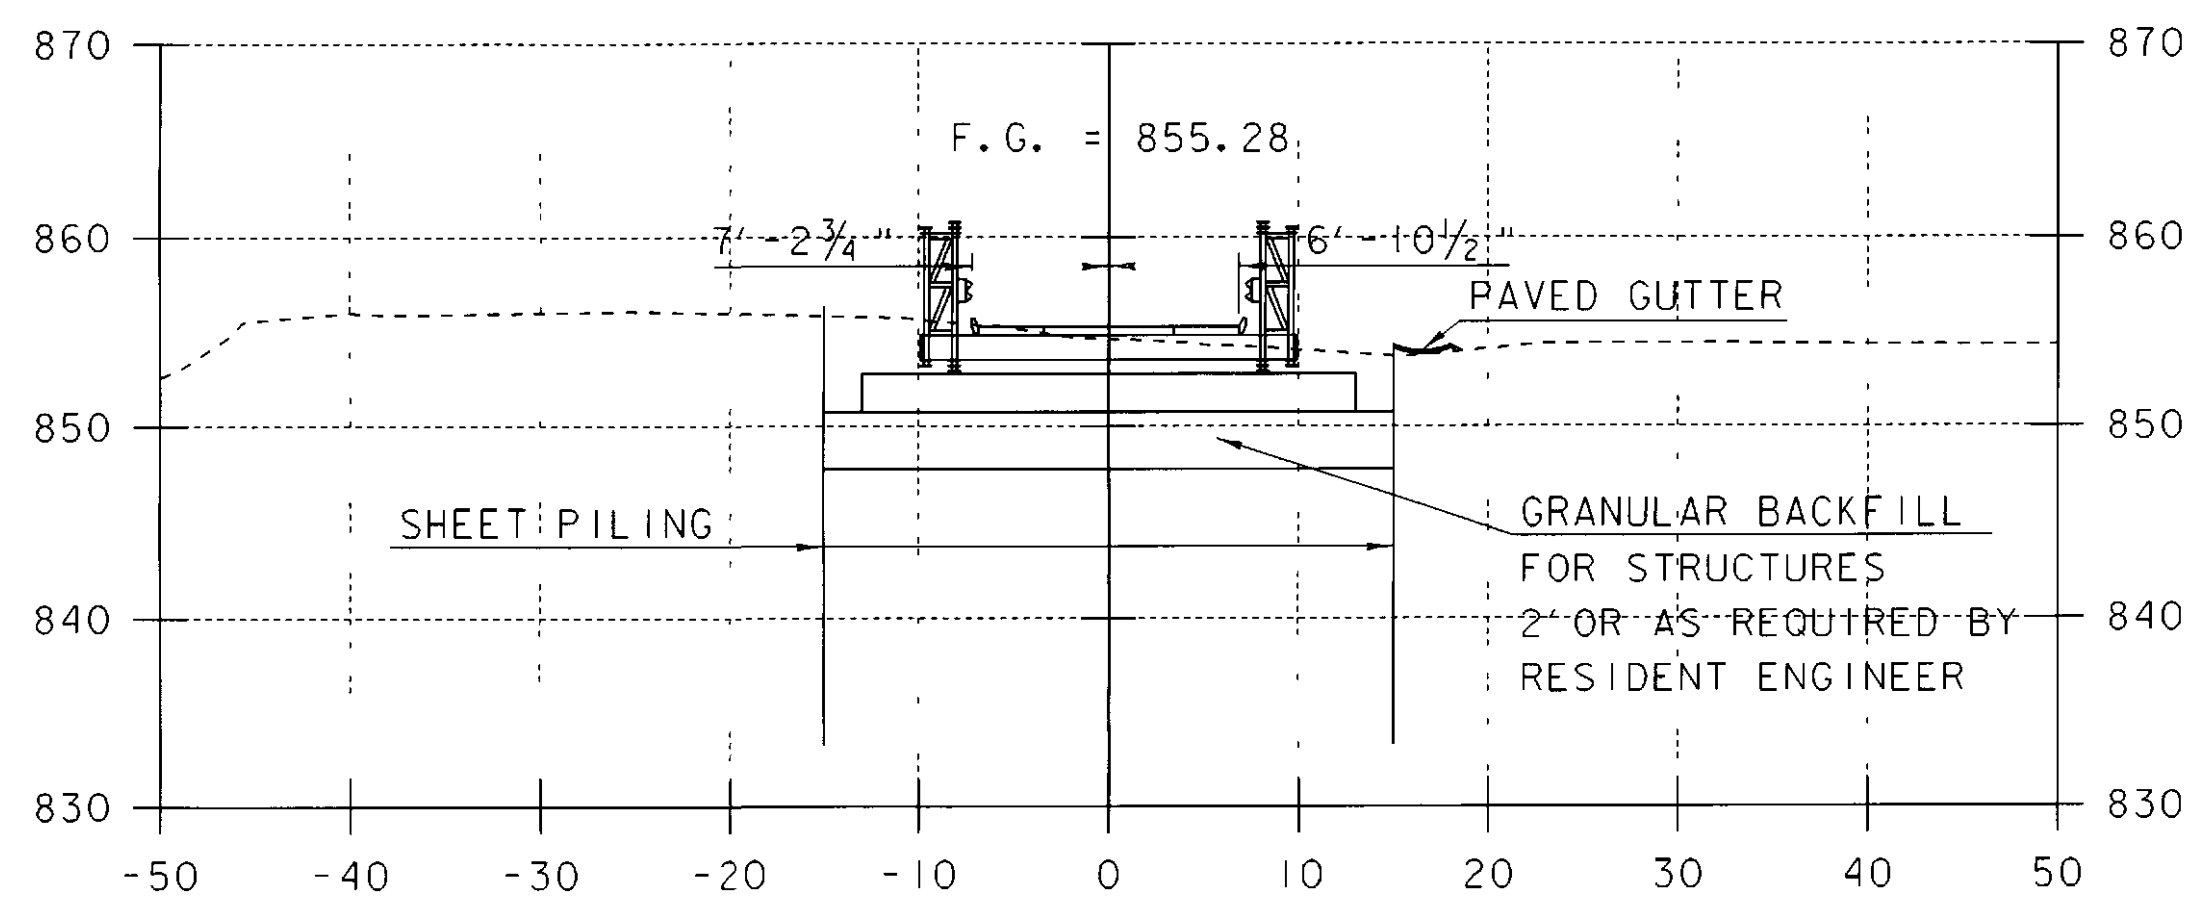

610+75

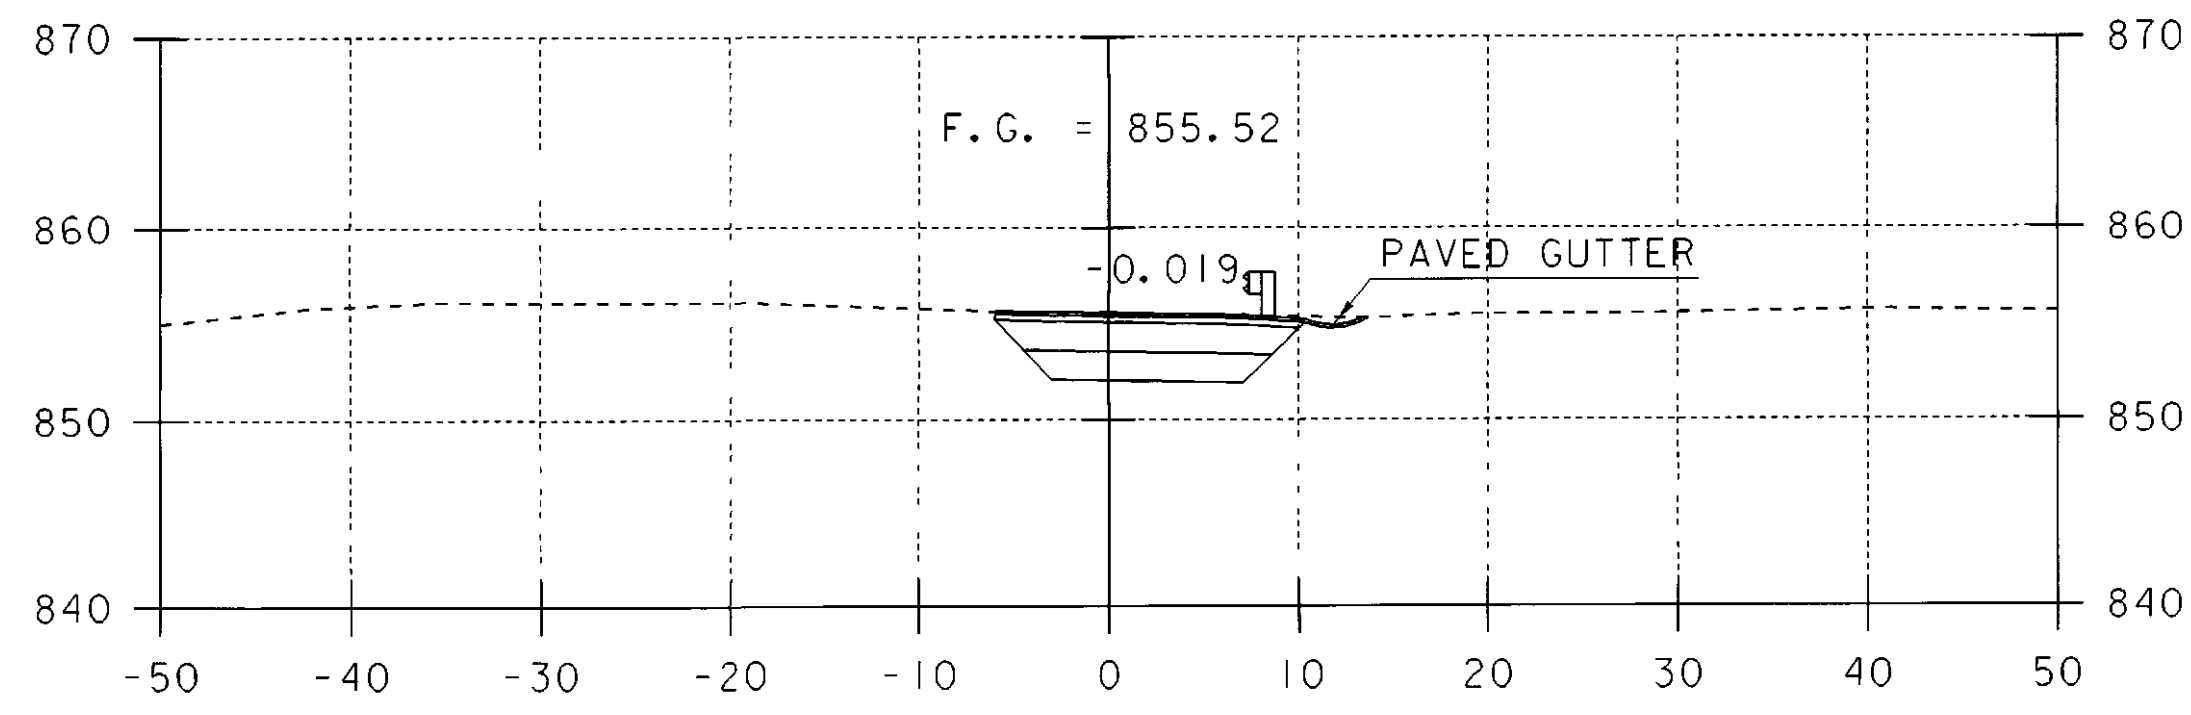

610+50

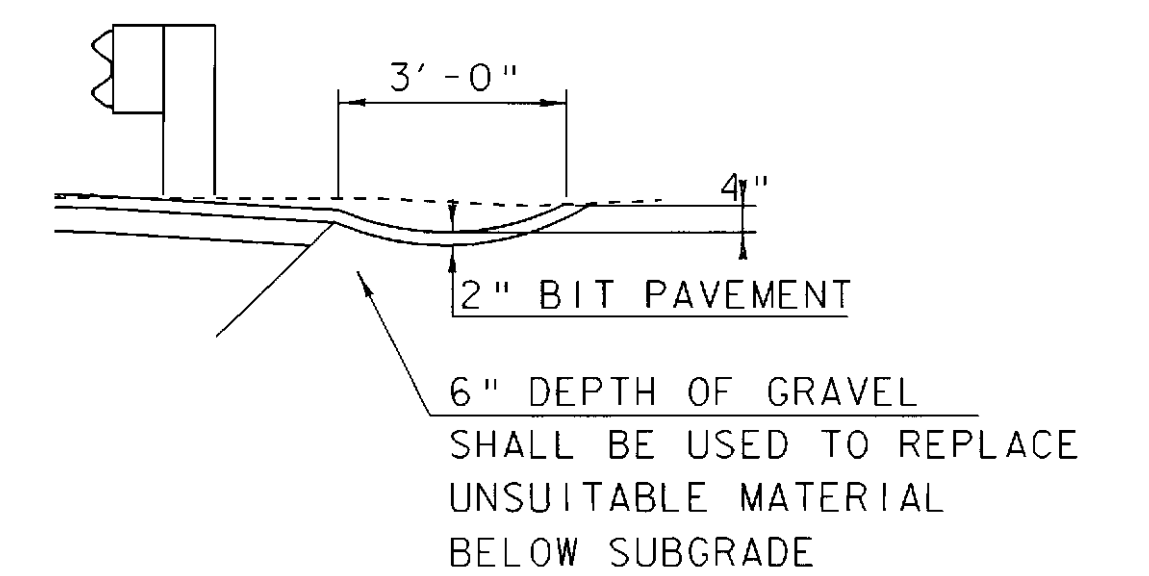

PAVED GUTTER  
CROSS SECTION

NOT TO SCALE

## TEMPORARY BRIDGE CROSS SECTIONS

PROJECT NAME:	BRIDGEWATER	PLOT DATE:	14-SEP-2005
PROJECT NUMBER:	BRS 0149 (4)	DRAWN BY:	T. FILLBACH
FILE NAME:	/str5/86e062/se062xs.dgn	CHECKED BY:	T. SUMNER
PROJECT LEADER:	C. KELLER	SHEET	15 OF 18
DESIGNED BY:	T. FILLBACH		
se062xs1.i			