


- NOTES:
- PAVEMENT WILL BE PLACED AGAINST EXISTING PAVEMENT
 - CRUSHED GRAVEL AND SAND BORROW WILL TRANSITION ON A 1:1 SLOPE, WHETHER THE TRANSITION IS PARALLEL OR PERPENDICULAR TO THE CENTERLINE


MAINLINE MATERIAL TRANSITION DIAGRAM

NOT TO SCALE

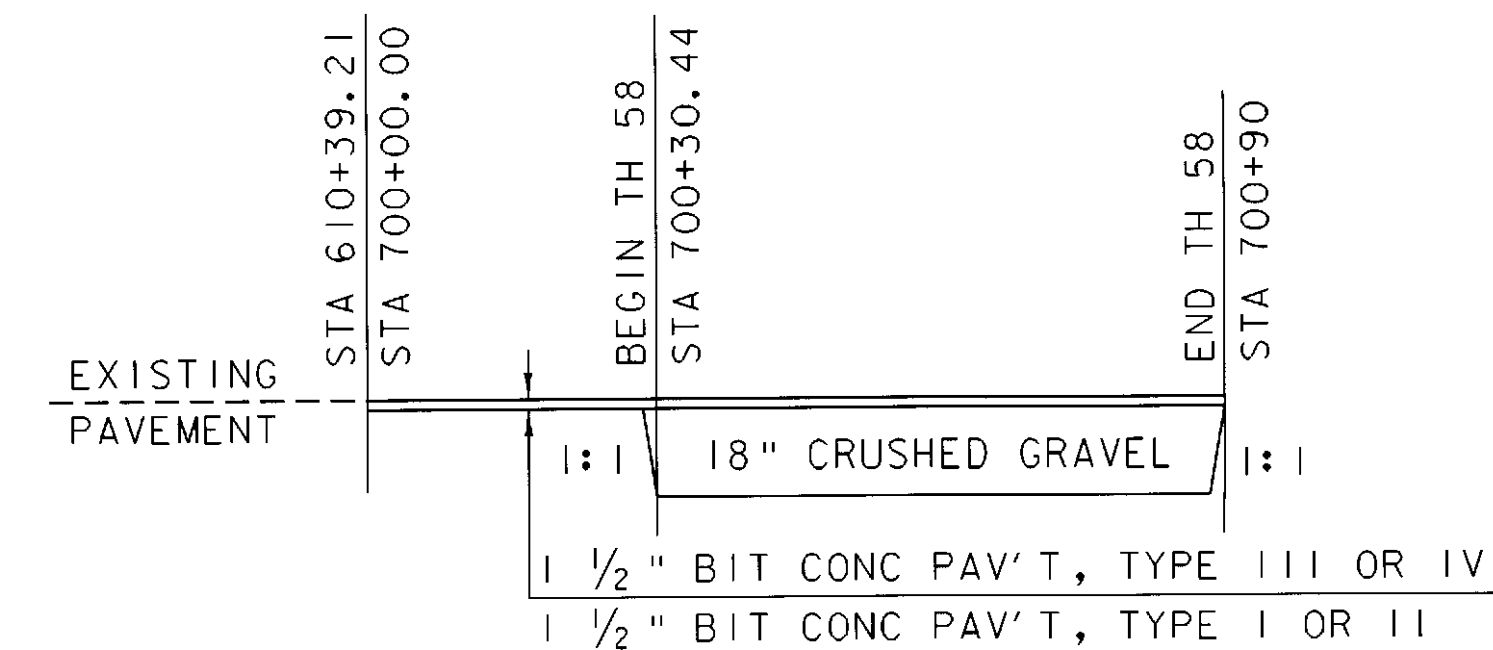

SIDELINE MATERIAL TRANSITION DIAGRAM

NOT TO SCALE

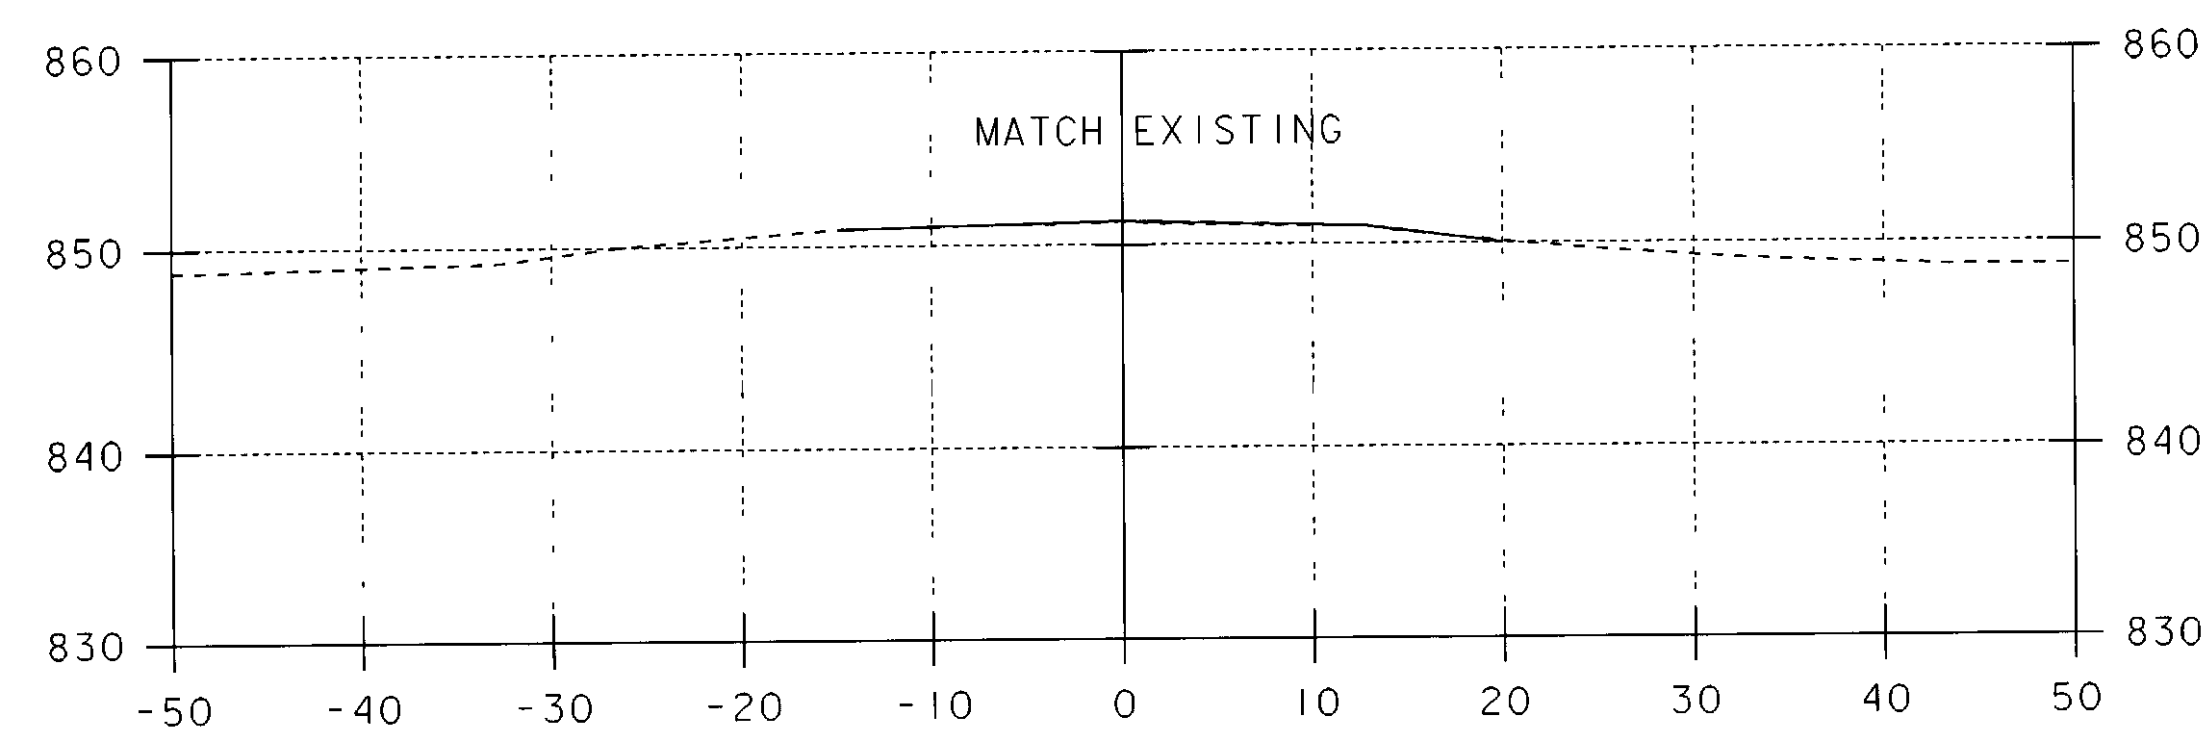

614+75

TEMPORARY BRIDGE CROSS SECTIONS

PROJECT NAME:	BRIDGEWATER
PROJECT NUMBER:	BRS 0149 (4)
FILE NAME: /str5/86e062/se062xs.dgn	PLOT DATE: 14-SEP-2005
PROJECT LEADER: C. KELLER	DRAWN BY: T. FILLBACH
DESIGNED BY: T. FILLBACH	CHECKED BY: T. SUMNER
se062xs4.i	SHEET 18 OF 18