


134 STRUCTURAL
STEEL

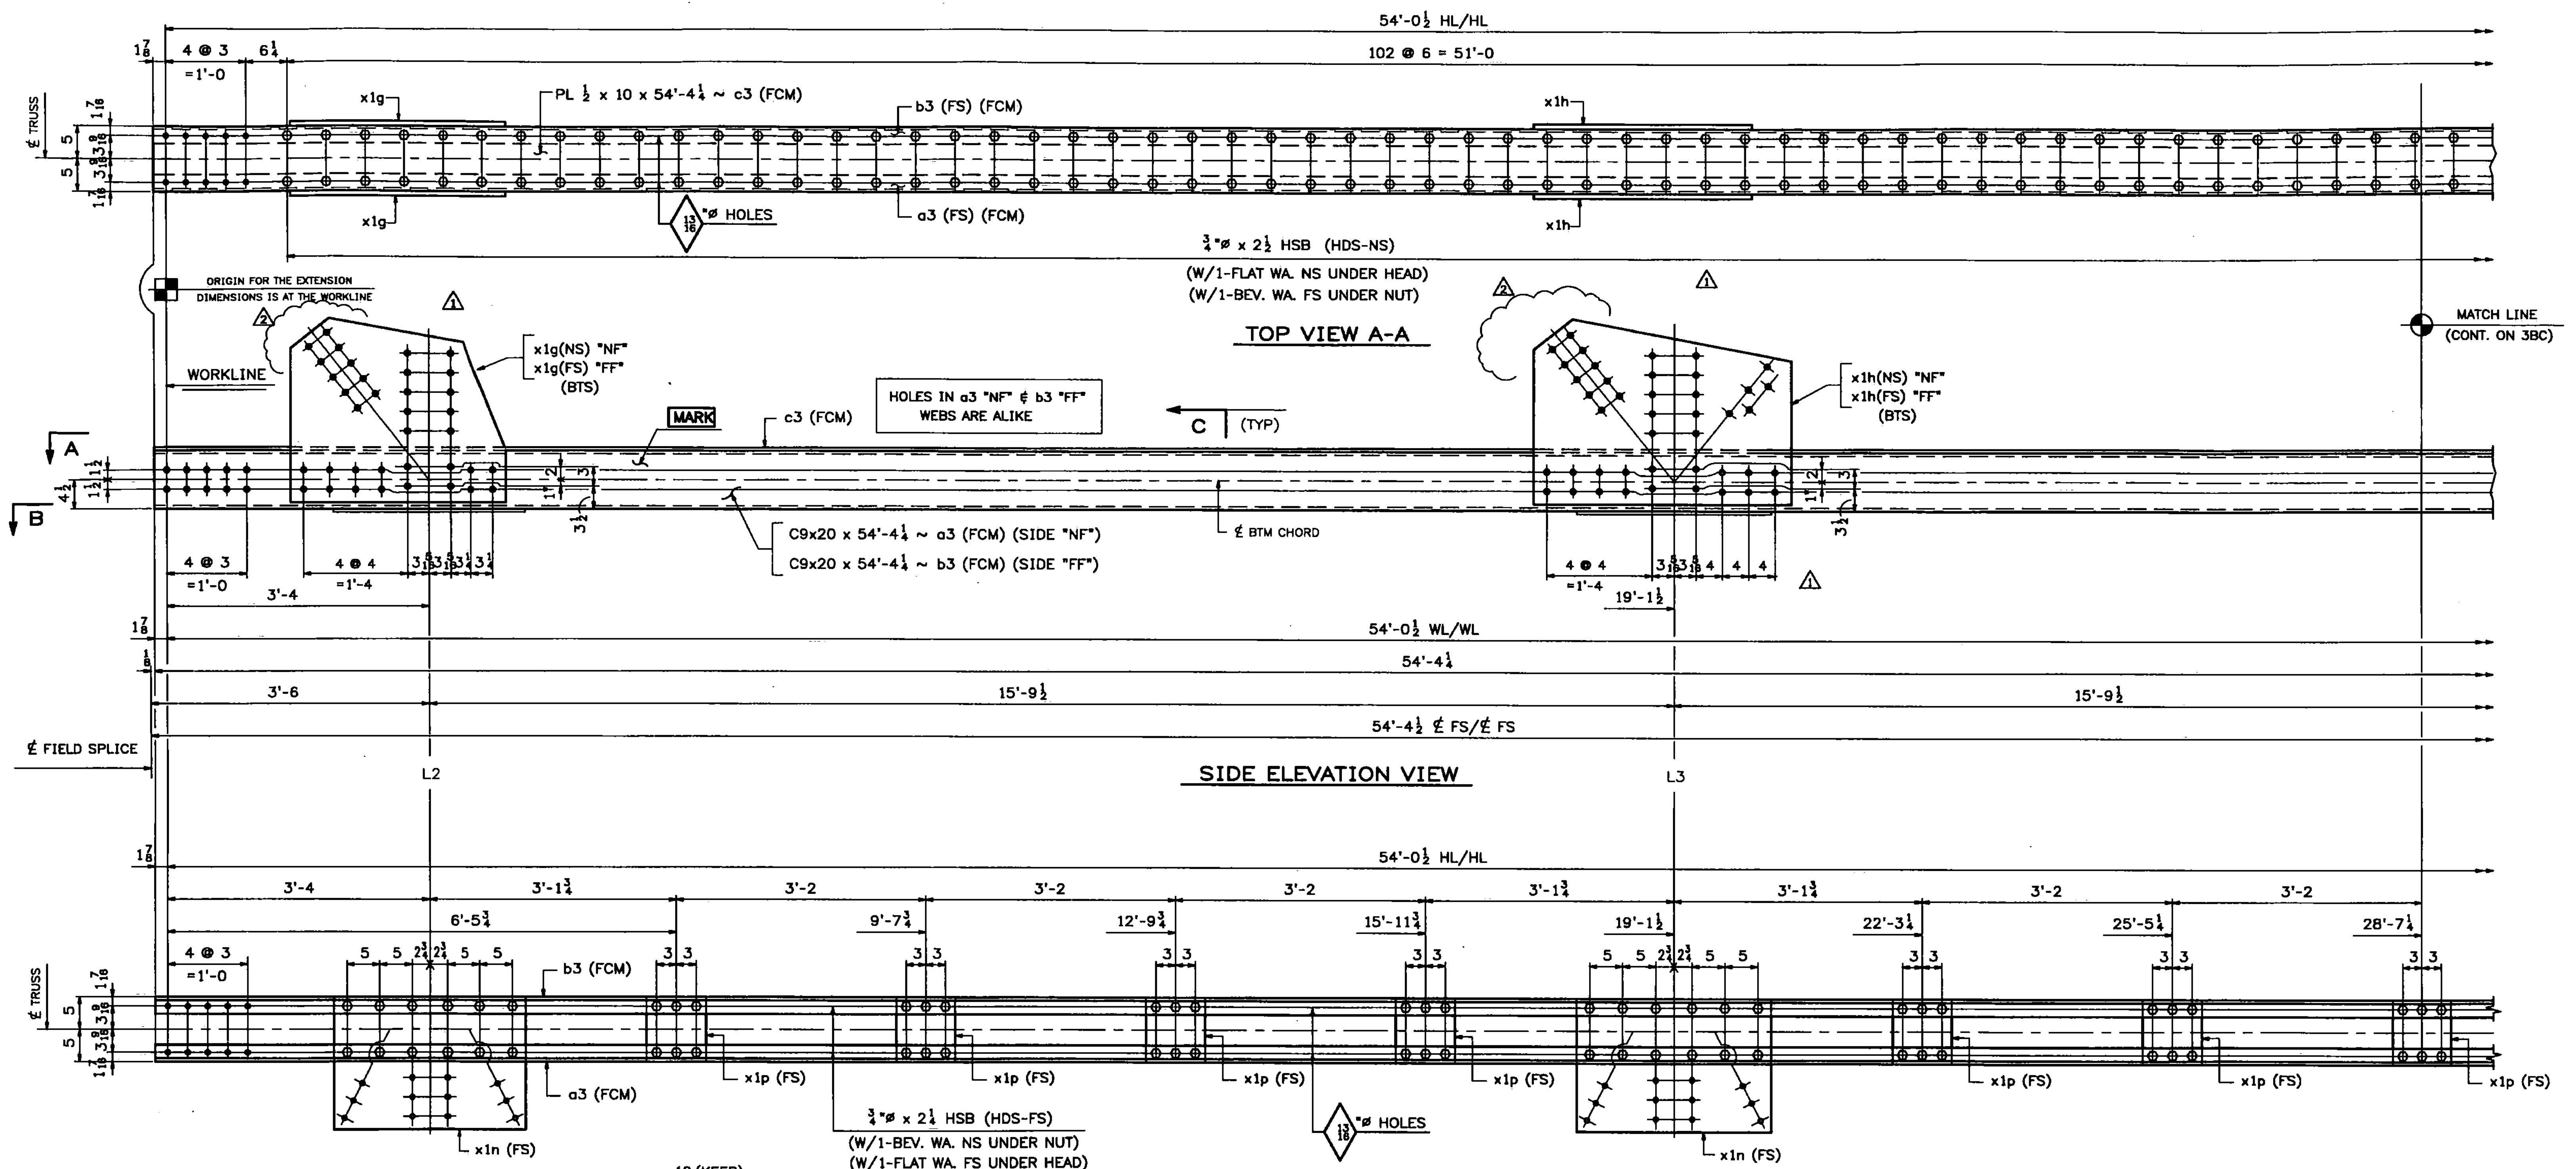

SECTION - C
(TYPICAL CHORD SECTION)
(ENLARGED)

ONE - BOTTOM CHORD - 3BC2W
(L2-L2' WEST)

SHOP NOTE:
ALL STEEL FOR BOTTOM CHORD
ASSEMBLY SHALL BE GALVANIZED

- NOTES:
1. FOR GENERAL NOTES SEE DWG. GN1.
 2. FOR STANDARD DETAILS SEE DWG. X1.
 3. "NF" - DENOTES NEAR FACE OF ASS'Y.
 4. "FF" - DENOTES FAR FACE OF ASS'Y.
 5. "BF" - DENOTES BOTH FACES OF ASSEMBLY.
 6. FCM - DENOTES FRACTURE CRITICAL MATERIAL.
 7. ALL BOLTS SHALL BE FULLY TORQUED (UN).
 8. BTS - DENOTES BOLT TO SHIP OR SECURE FOR SHIPMENT.
 9. HDS - DENOTES BOLT HEADS.

WORK THIS DWG. WITH DWG. 3BC & 3C.

Vermont Agency of Transportation

RECEIVED

CK'D BY TCF OK'D BY SSS

7:43 am, Apr 12, 2011

RESUBMIT _____ APPROVED X
BY KMH DATE 4-12-11

03/23/11	REVISED AS PER APPROVAL COMMENTS	JM	PWR			
02/28/11	REVISED AS PER APPROVAL COMMENTS	JM	PWR			
0						
REV.	DATE	REMARKS	DWN	CHK	APVL	SHOP
MATERIAL:		SURFACE PREP. & PAINT:		HOLES:		SHOP BOLTS:
M270-50 (U.N.)		SEE DWG GN1		1/8" @ (U.N.)		AS NOTED
DESCRIPTION: BOTTOM CHORD 3BC2W						
CASCO BAY STEEL STRUCTURES, INC.						
75 SPRING HILL ROAD			SACO, MAINE 04072		TENSOR 3018	
PHONE (207) 282-7360			FAX. (207) 282-1179			
STRUCTURE: Vermont Route 100A			DRAWN:	DATE:		
Bridge No. 14			RB	9/27/10		
Bridgewater			CHKD:	DATE:		
County of Windsor			WJL	10/18/10		
LOCATION: BRIDGEWATER, VERMONT			JOB NO.	DWG NO.		
PROJ NO. BRS 0149(4)			454	3AC		
CUSTOMER: VT AOT				REV.		