


135 STRUCTURAL
STEEL

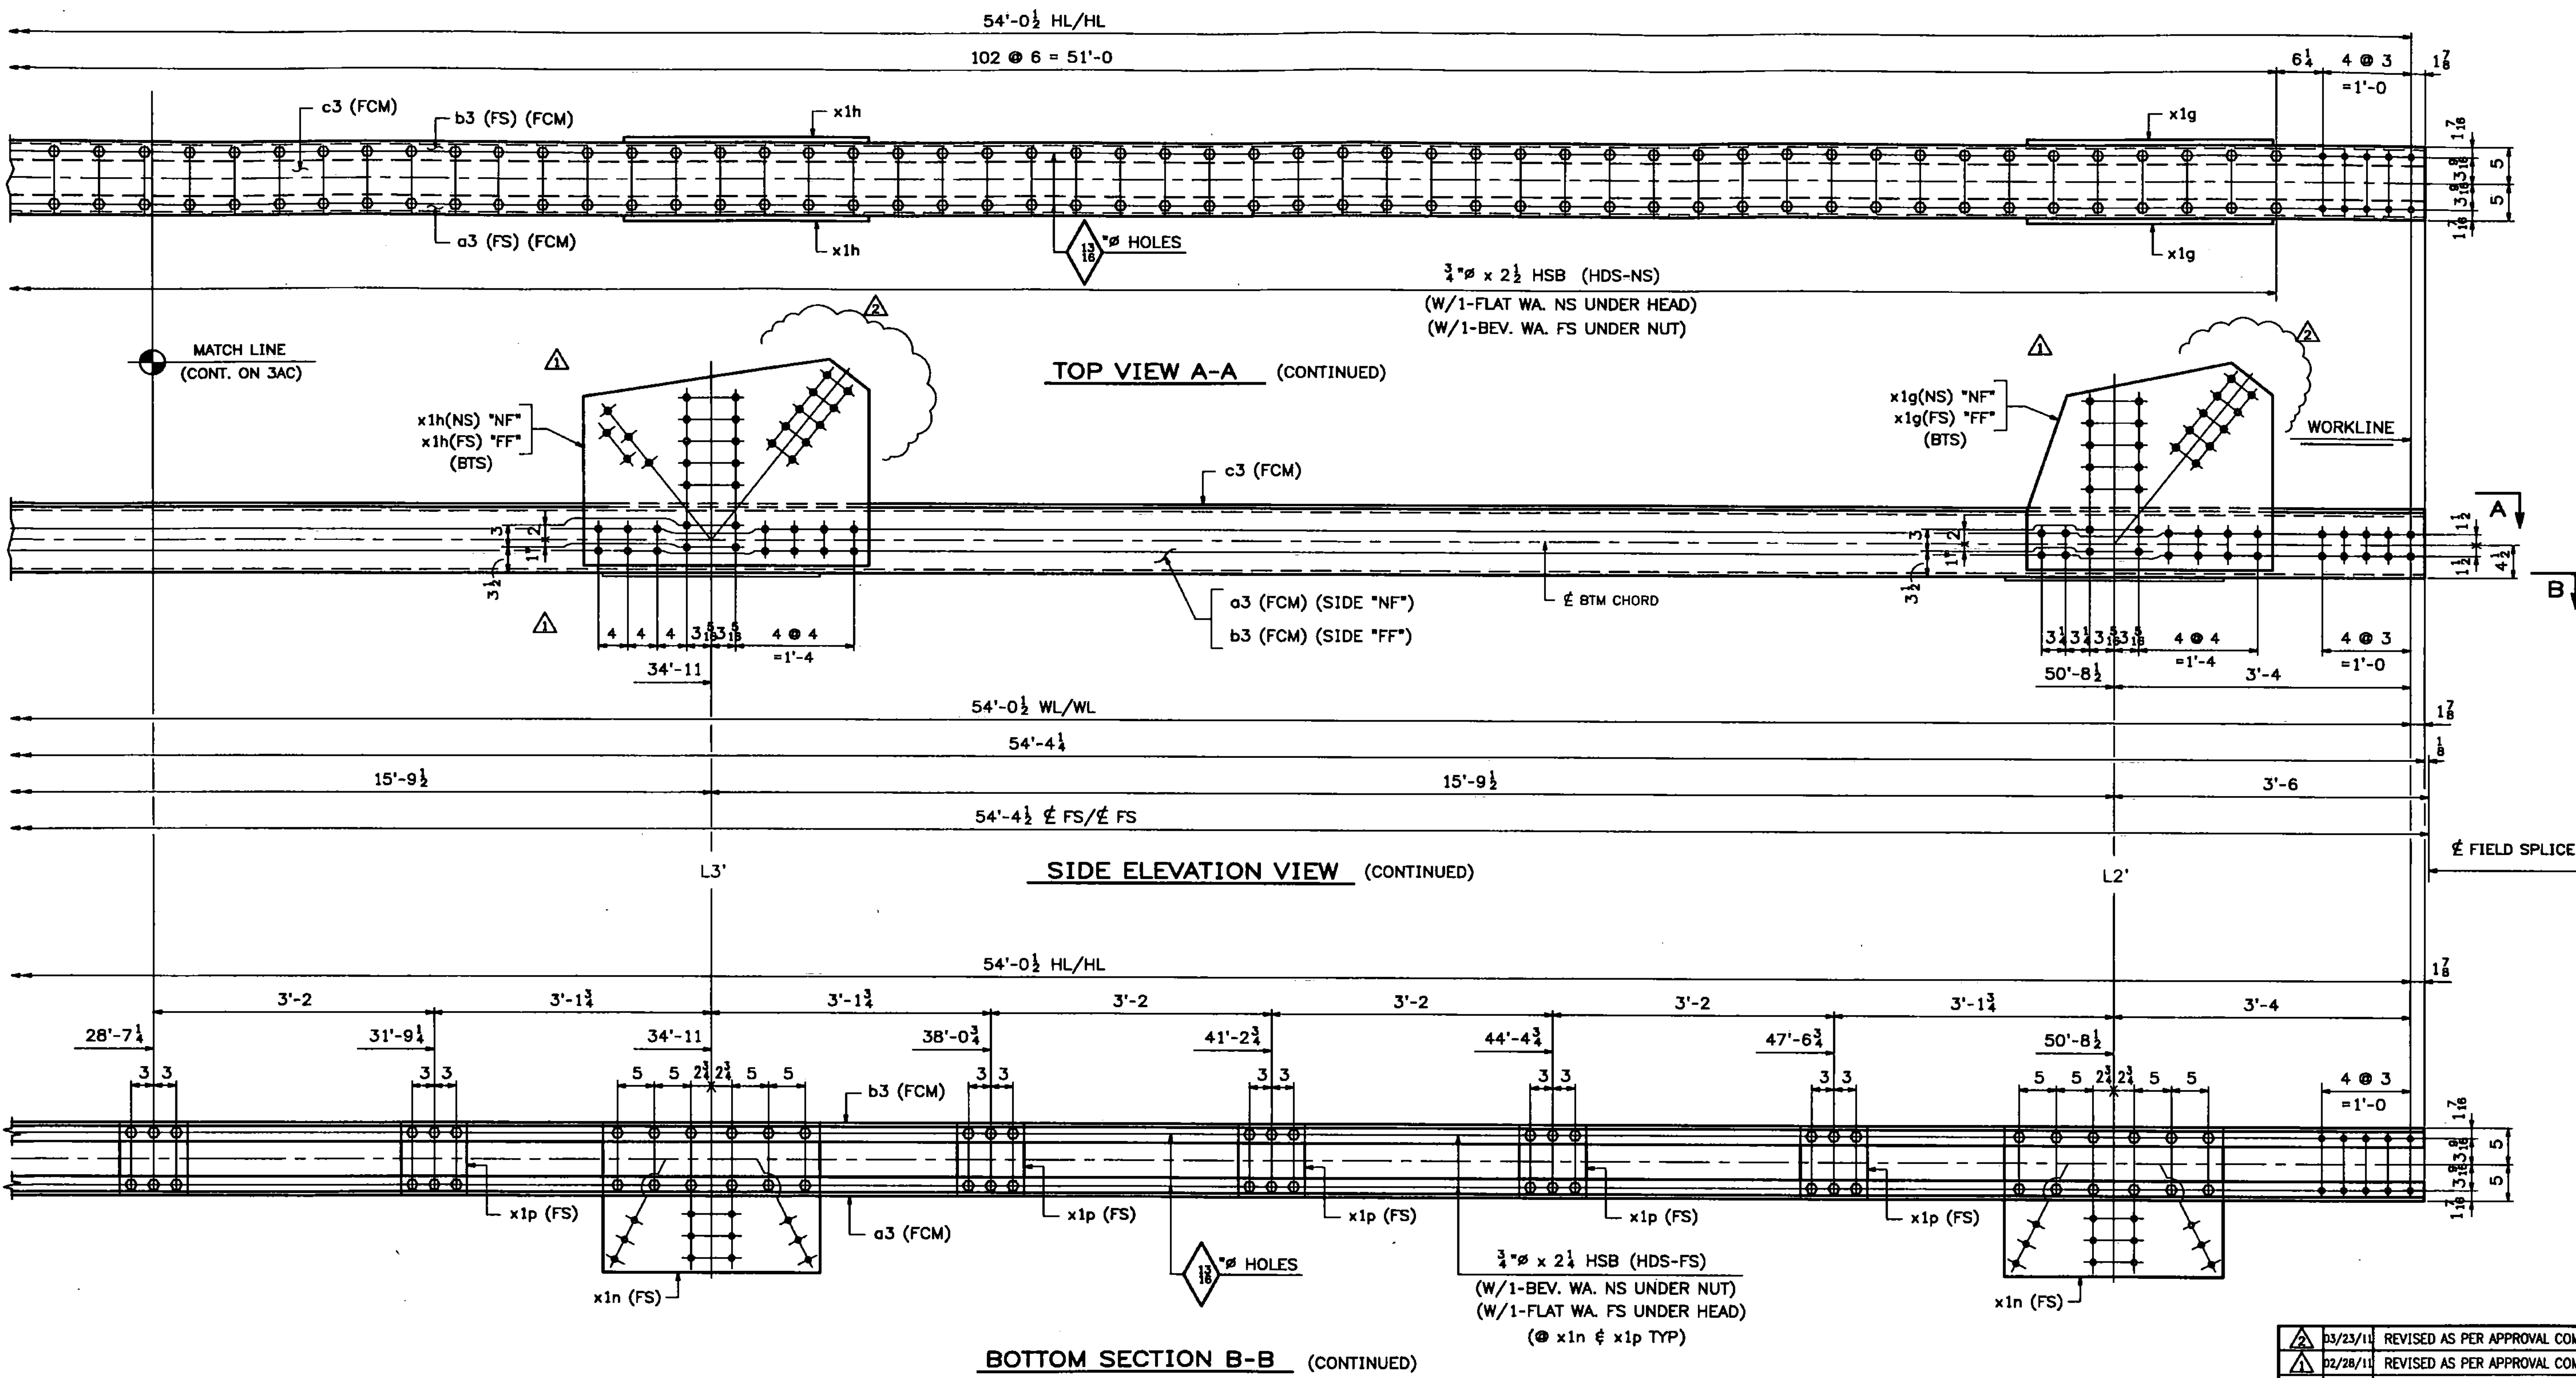

ONE - BOTTOM CHORD - 3BC2W (CONTINUED)
(L2-L2' WEST)

SHOP NOTE:
ALL STEEL FOR BOTTOM CHORD
ASSEMBLY SHALL BE GALVANIZED

Vermont Agency of Transportation

RECEIVED

CK'D BY TCF OK'D BY SSS

7:43 am, Apr 12, 2011

RESUBMIT APPROVED X
BY KMH DATE 4-12-11

WORK THIS DWG. WITH DWG. 3AC & 3C.

03/23/10	REVISED AS PER APPROVAL COMMENTS	JM	PWR		
02/28/11	REVISED AS PER APPROVAL COMMENTS	JM	PWR		
0					
REV. DATE	REMARKS	DWN	CHK	APVL	SHOP
MATERIAL: M270-50 (U.N.)		SURFACE PREP. & PAINT: SEE DWG GN1		Holes: 1/8" (U.N.)	
DESCRIPTION: BOTTOM CHORD 3BC2W		SHOP BOLTS: AS NOTED			
CASCO BAY STEEL STRUCTURES, INC.					
75 SPRING HILL ROAD		SACO, MAINE 04072		PHONE (207) 282-7360 FAX. (207) 282-1179	
STRUCTURE: Vermont Route 100A		DRAWN: RB		DATE: 9/27/10	
Bridge No. 14		CHKD: WJL		DATE: 10/18/10	
Bridgewater		JOB NO. 454		DWG NO. 3BC	
County of Windsor		REV. 1		REV. 1	
LOCATION: BRIDGEWATER, VERMONT		JOB NO. 454		DWG NO. 3BC	
PROJ NO. BRS 0149(4)		REV. 1		REV. 1	
CUSTOMER: VT AOT		REV. 1		REV. 1	