


RECEIVED


DESIGNED BY RLP DATE 1/20/11
APPROVED BY [Signature] DATE 1/20/11
BY KMH DATE 1/20/11

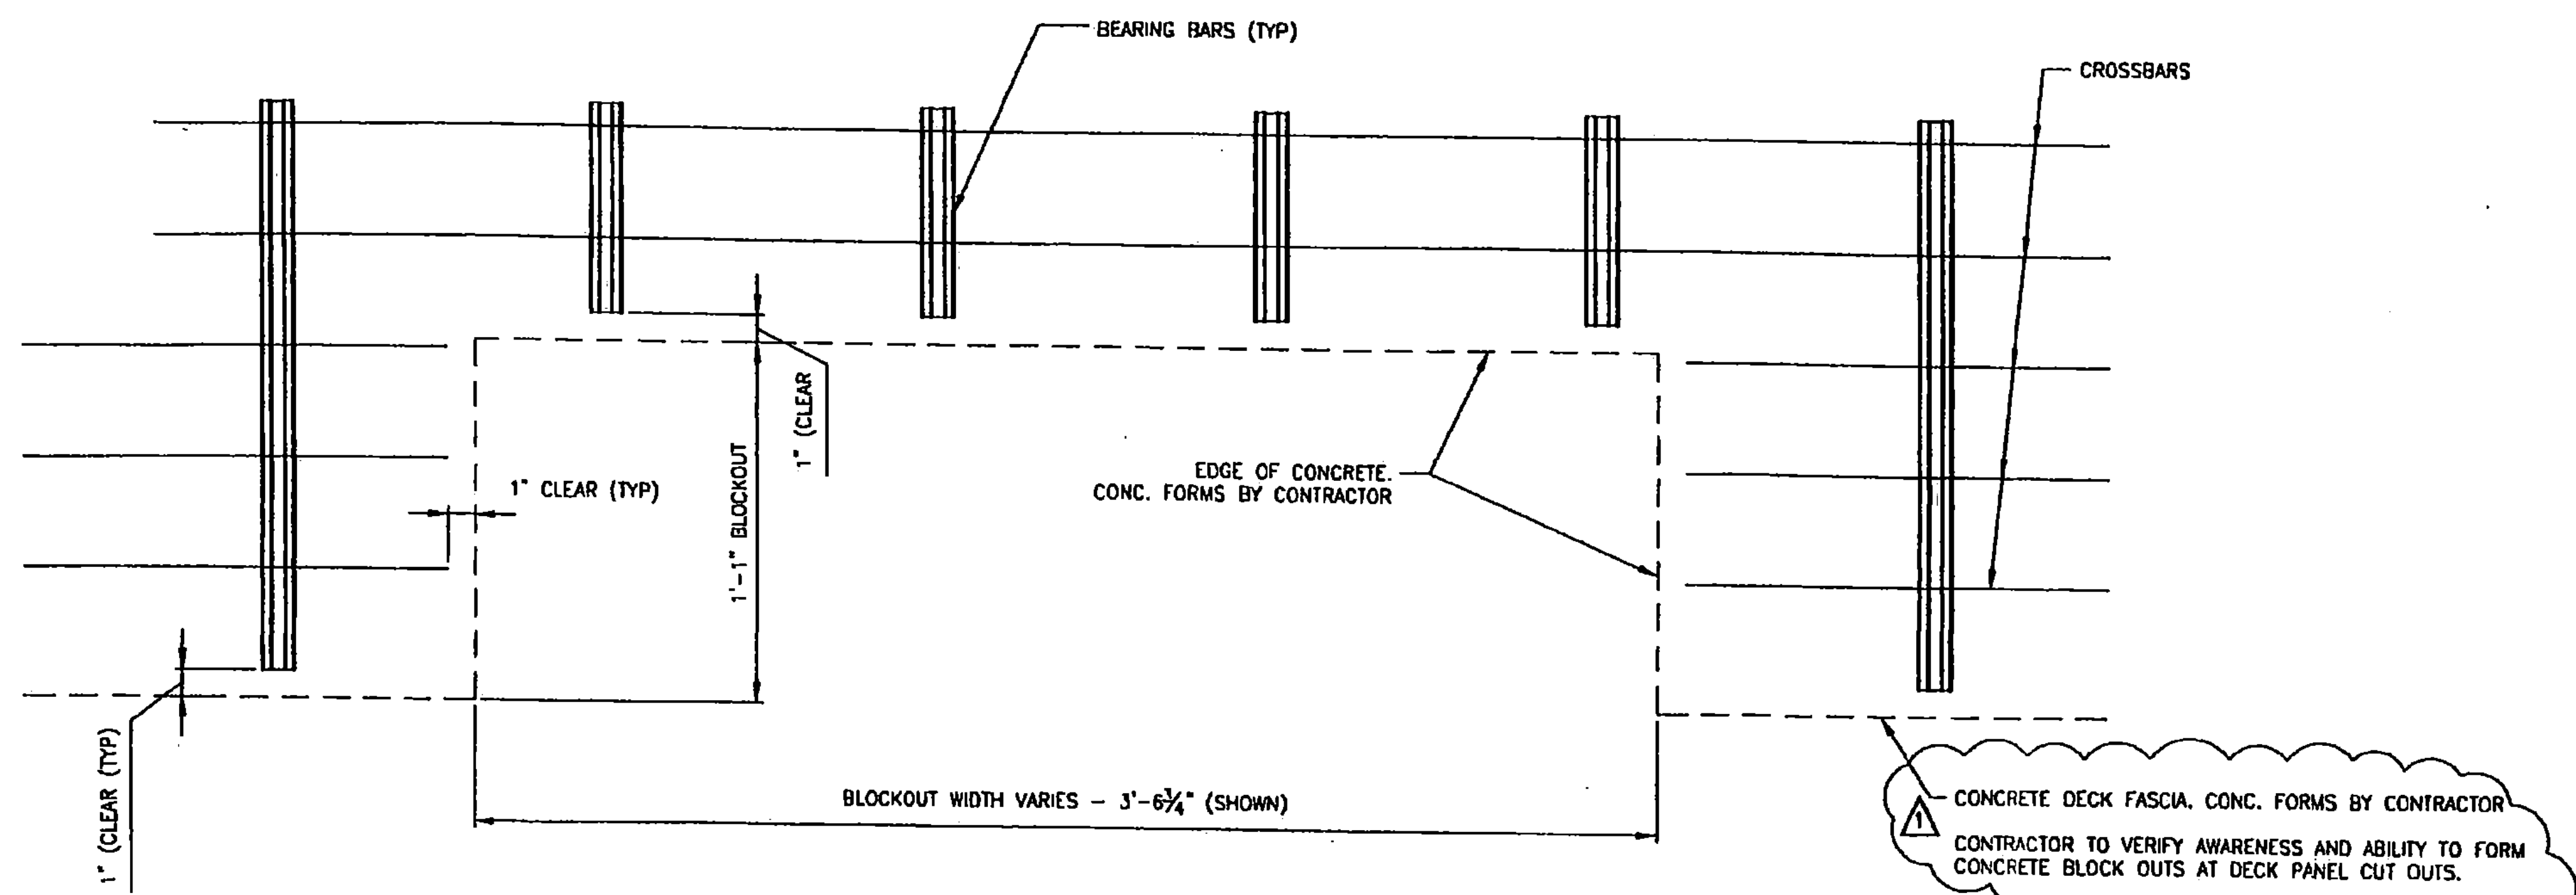


DETAIL 1 (FROM LBE1)
SUPPLEMENTAL BARS NOT SHOWN

CONCRETE DECK FASCIA, CONC. FORMS BY CONTRACTOR
CONTRACTOR TO VERIFY AWARENESS AND ABILITY TO FORM CONCRETE BLOCK OUTS AT DECK PANEL CUT OUTS.

APPROVER SUPPLIED DIMENSION. REMOVED VERIFICATION NOTE OF REQUIRED CLEAR SPACE FOR #6 RE-BAR HOOK.

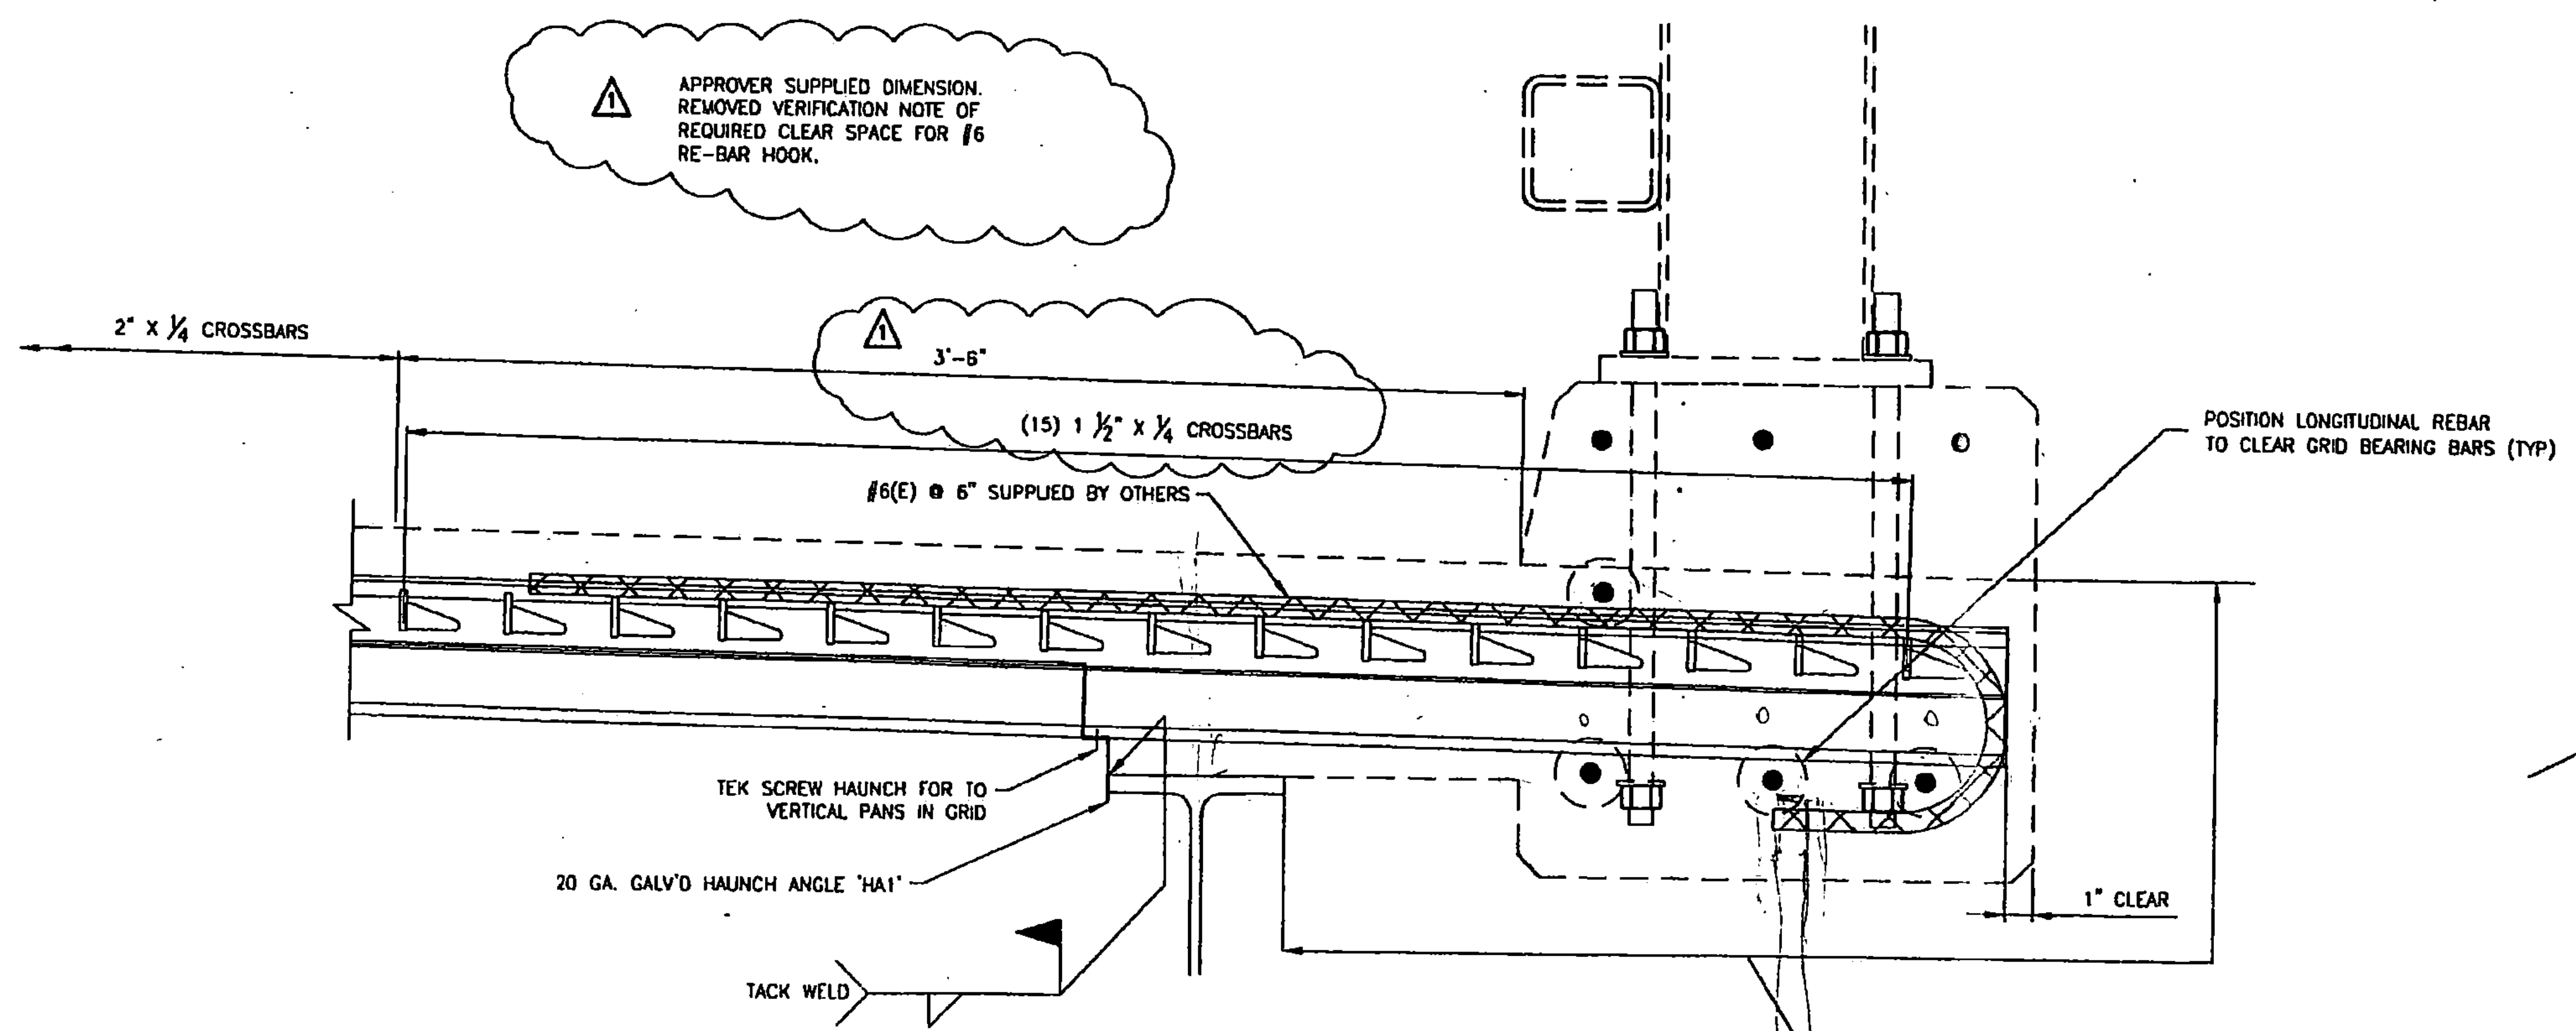

DETAIL 2 (FROM LBE3)
NOTE: FIELD CUT #4 SUPPLEMENTAL REBARS IN GRID IF REQ'D TO CLEAR RAIL POST ANCHORS

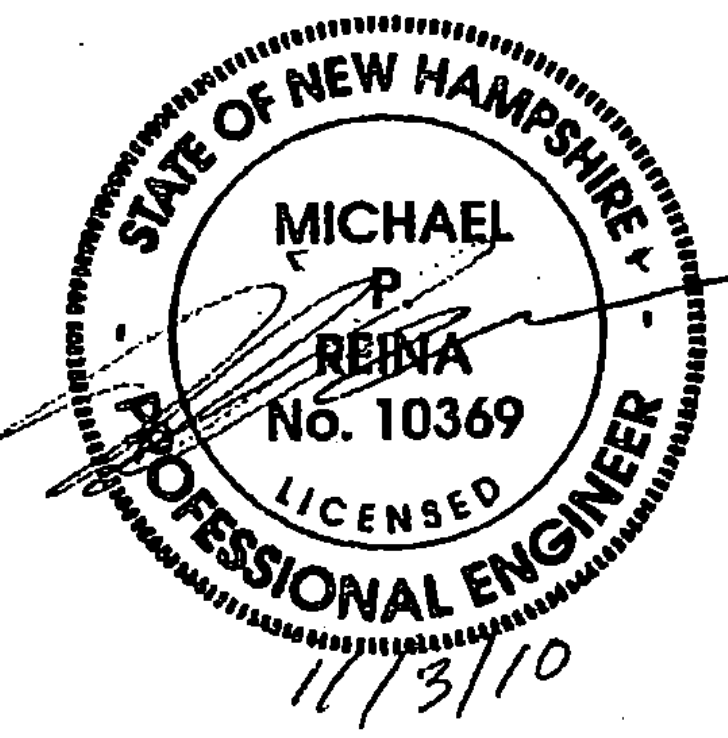

APPROVED:	
L. B. FOSTER CO. PITTSBURGH, PENNSYLVANIA 15220	
FOR: MILLER CONSTRUCTION STATE OF VERMONT AGENCY OF TRANSPORTATION TOWN OF BRIDGEWATER, COUNTY OF WINDSOR VT. ROUTE 100A, BR14 PROJ. NO. BRS 0149 (4) MISC. DETAILS	
REVISED PER APPROVER'S COMMENTS	B L J 10/27 10
DATE WPO	DATE SDO339
DATE RLP	DATE LBE4
REV. NO.	1

185 PREFAB DECK PANELS