




108+25

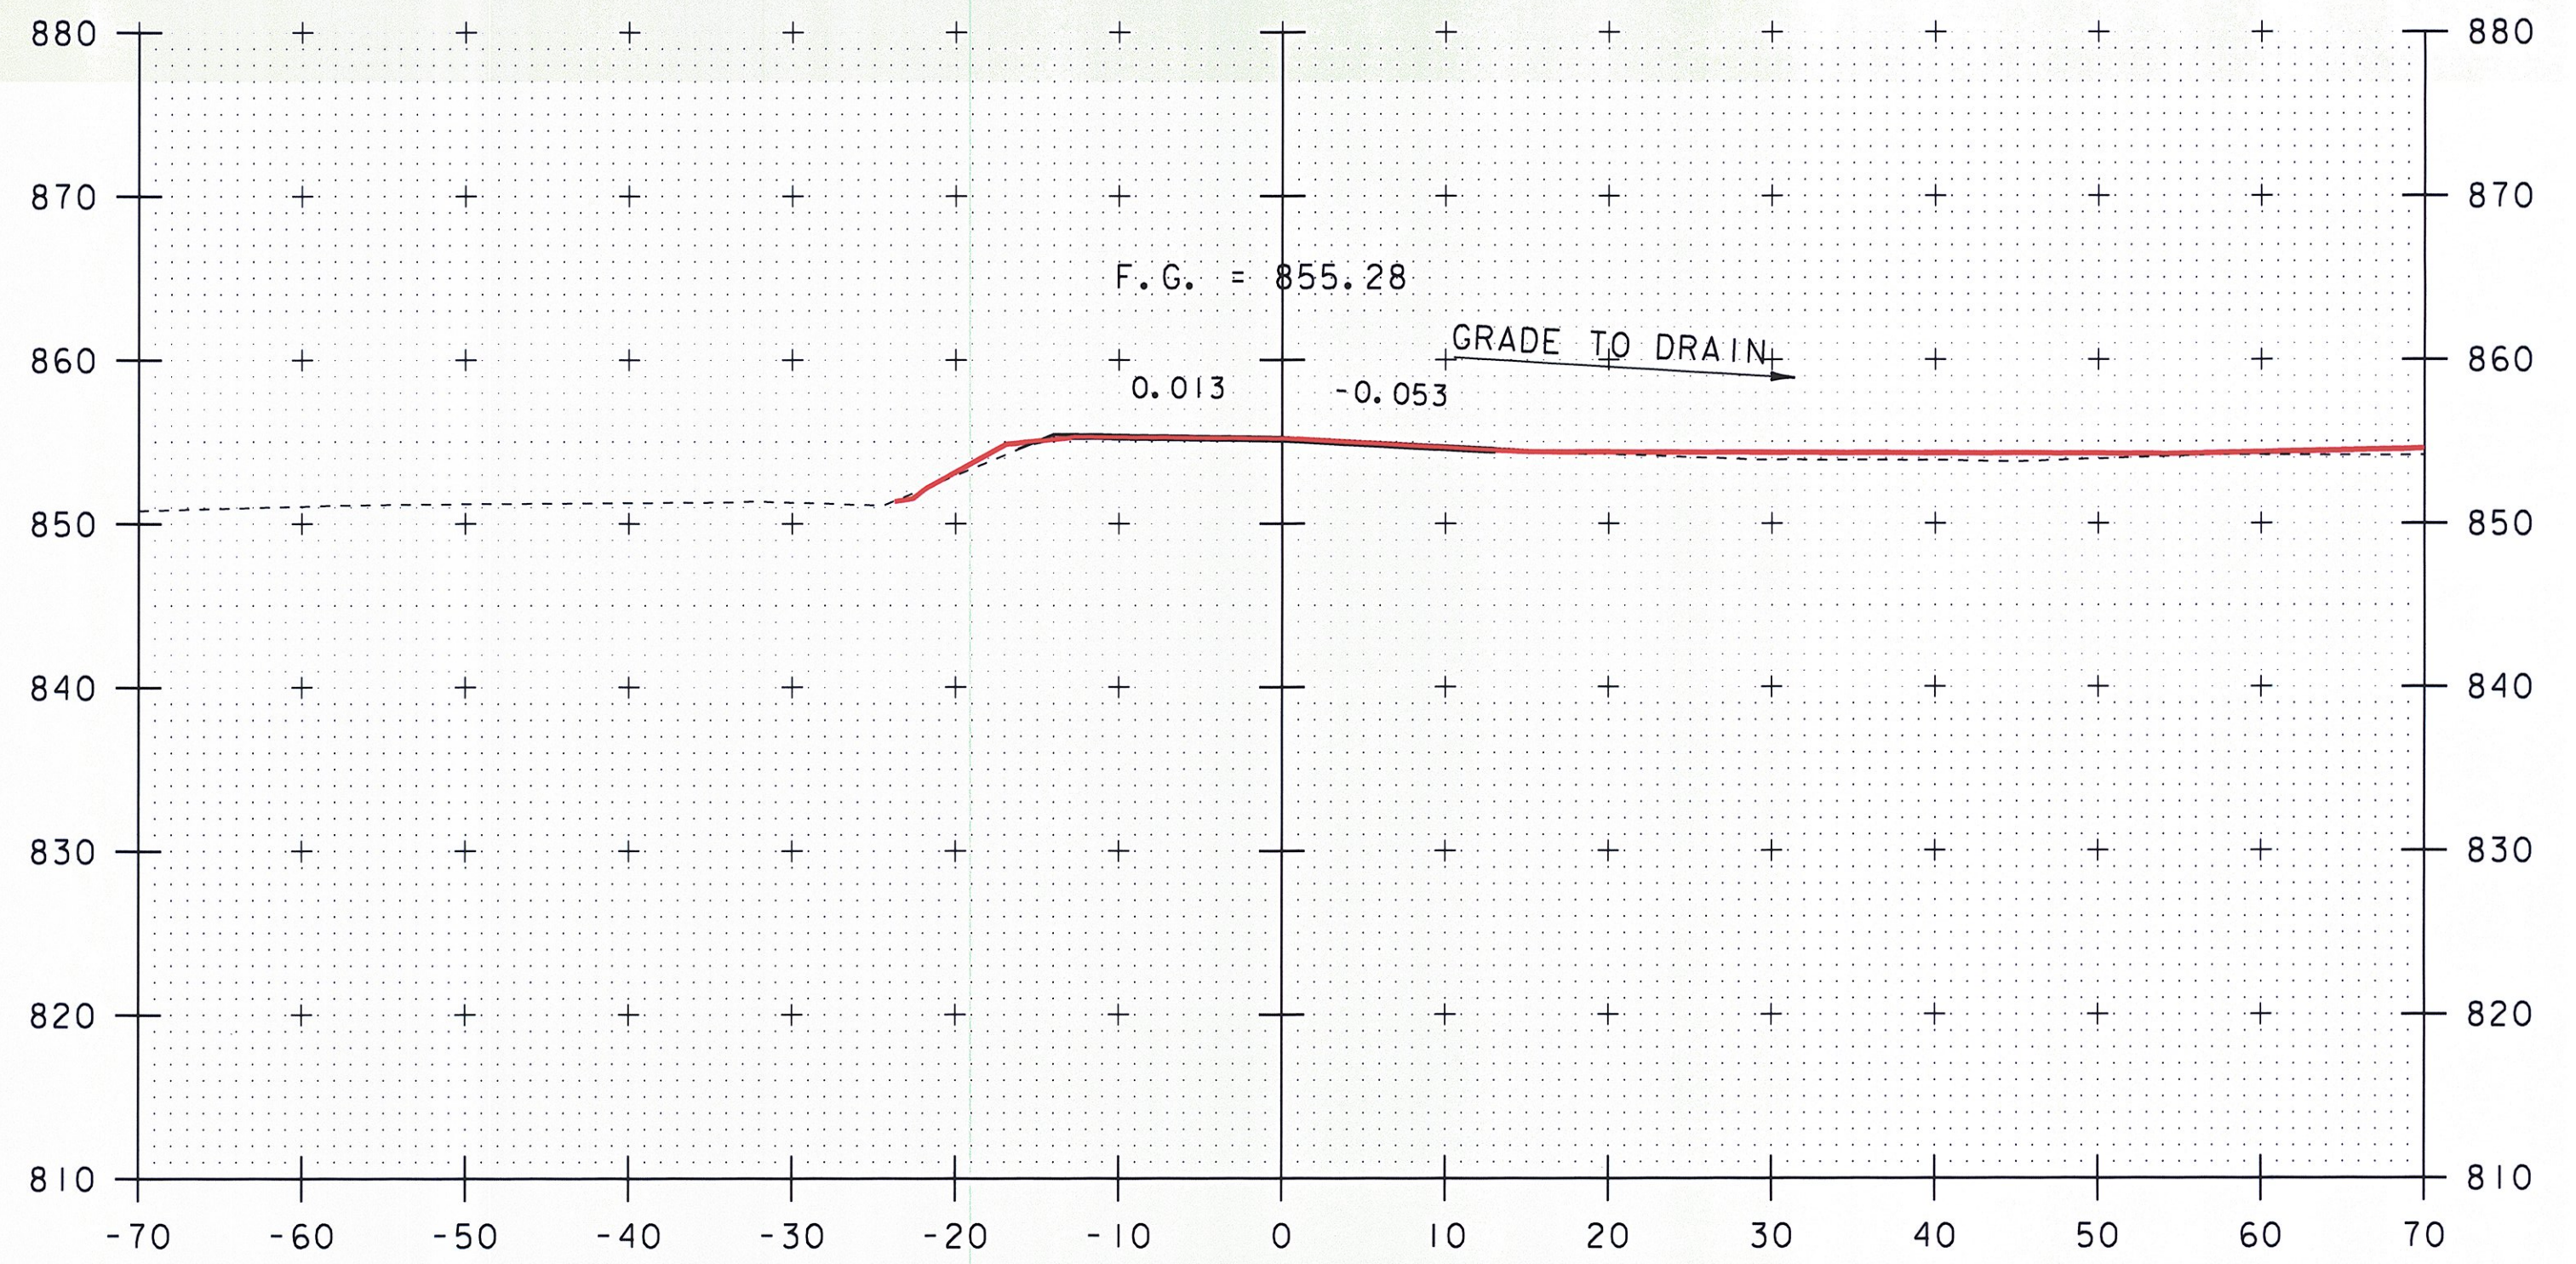

108+75

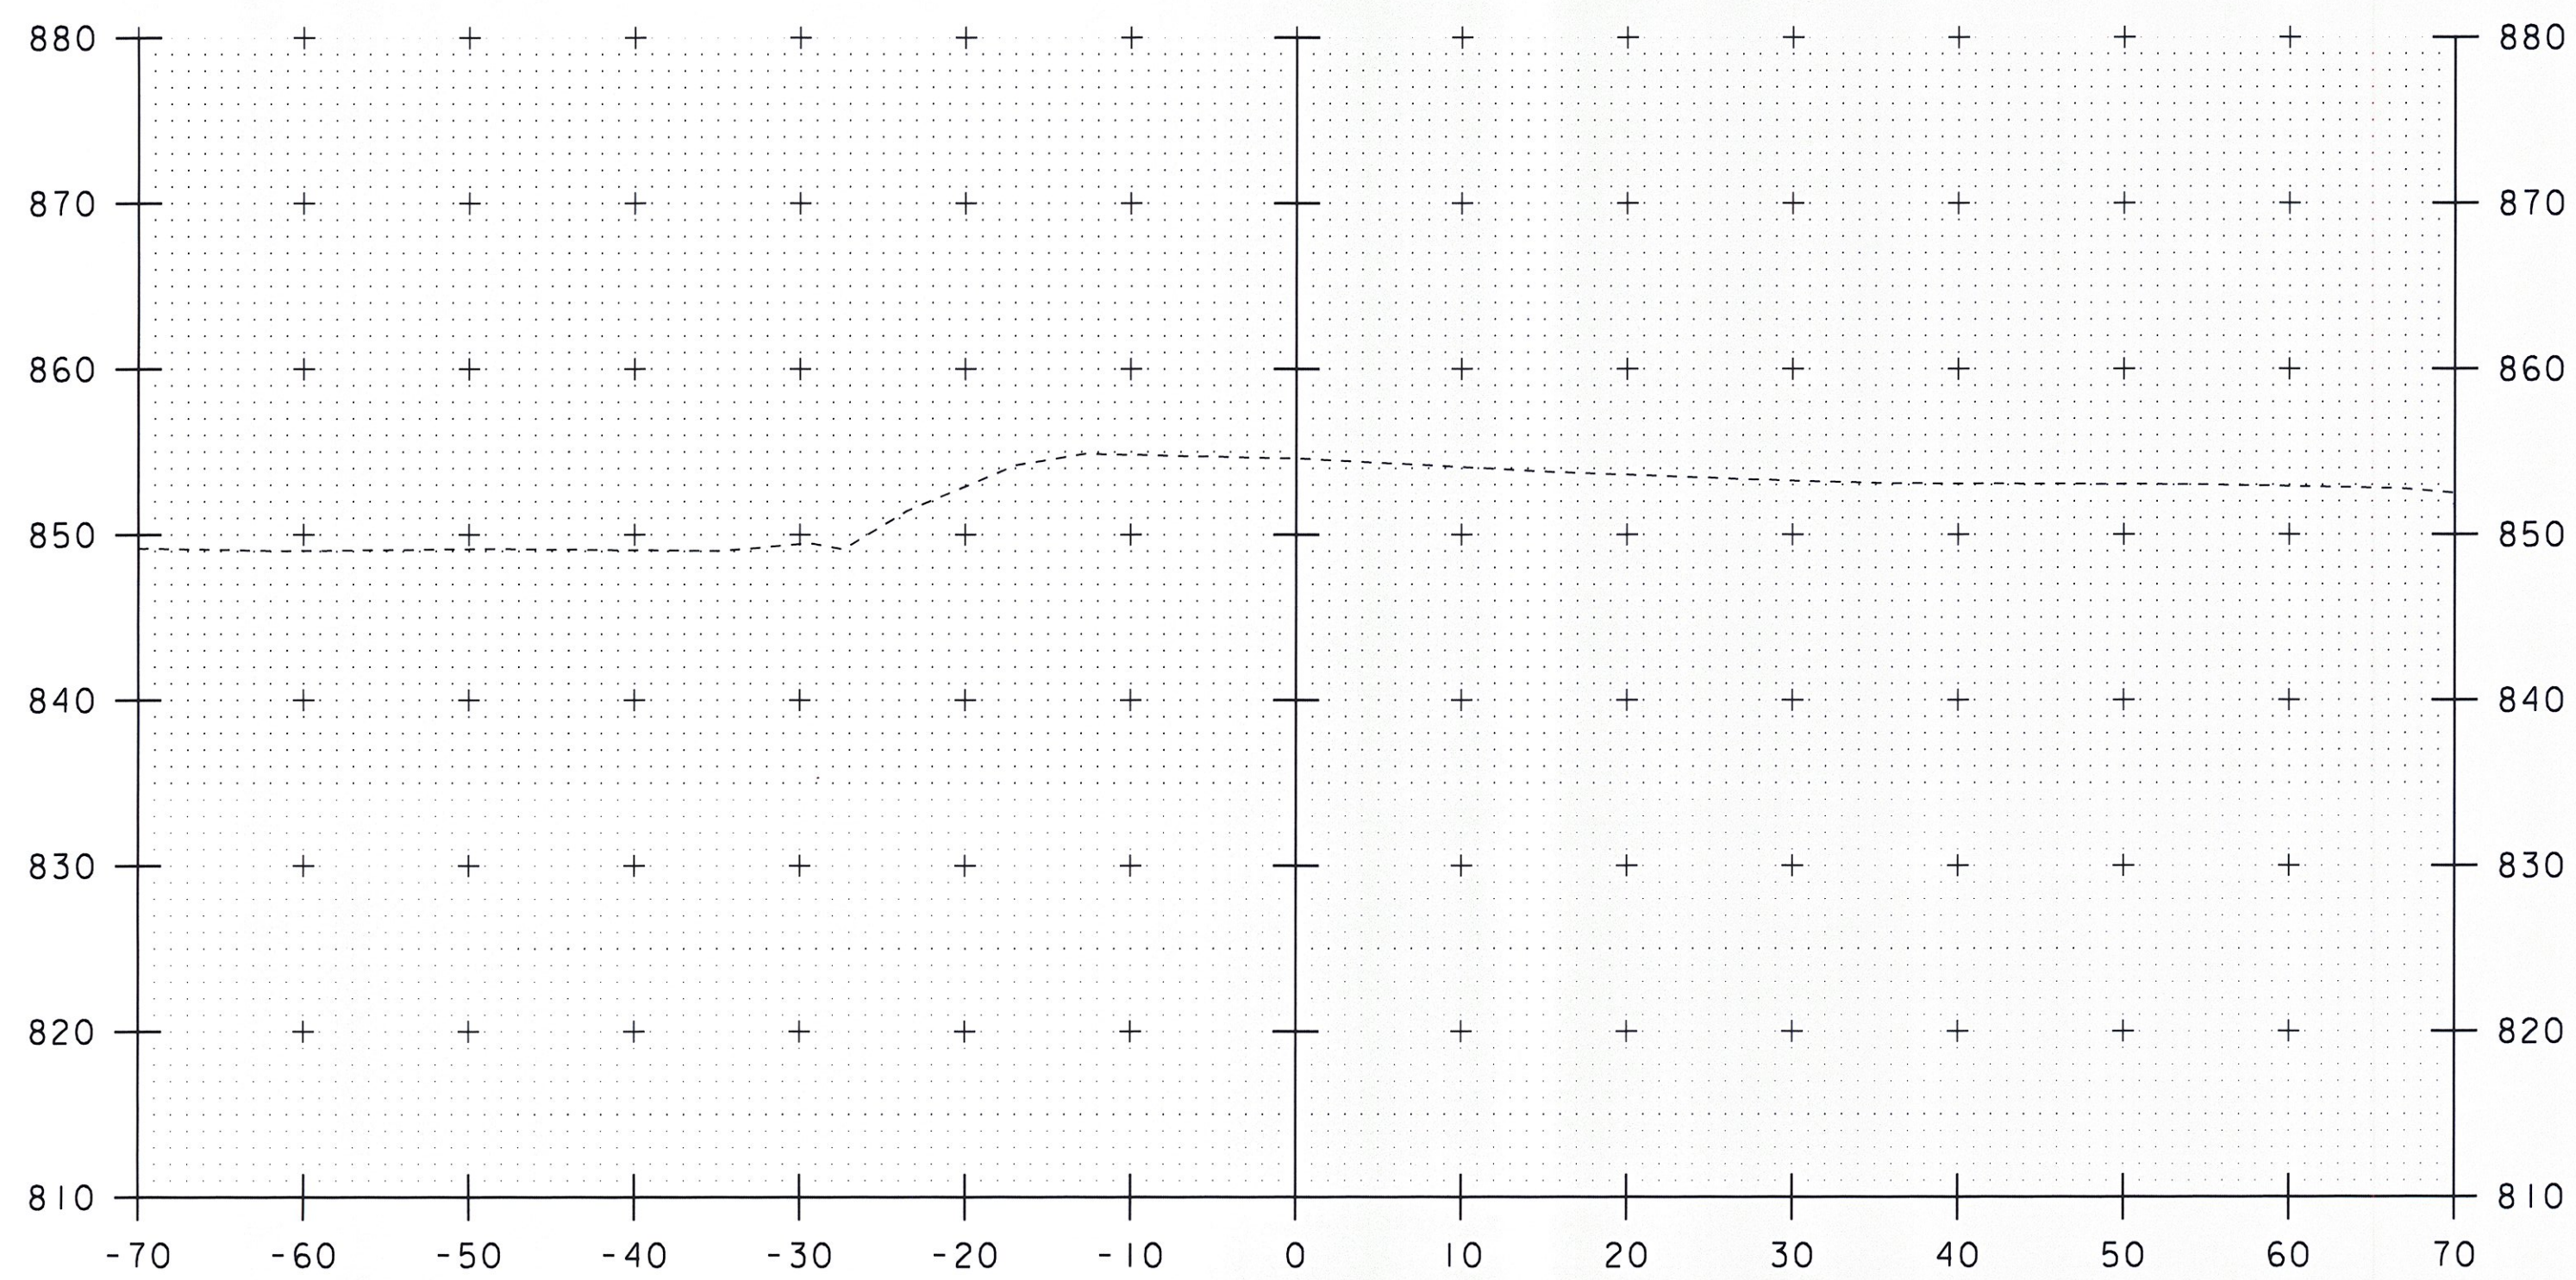


108+00

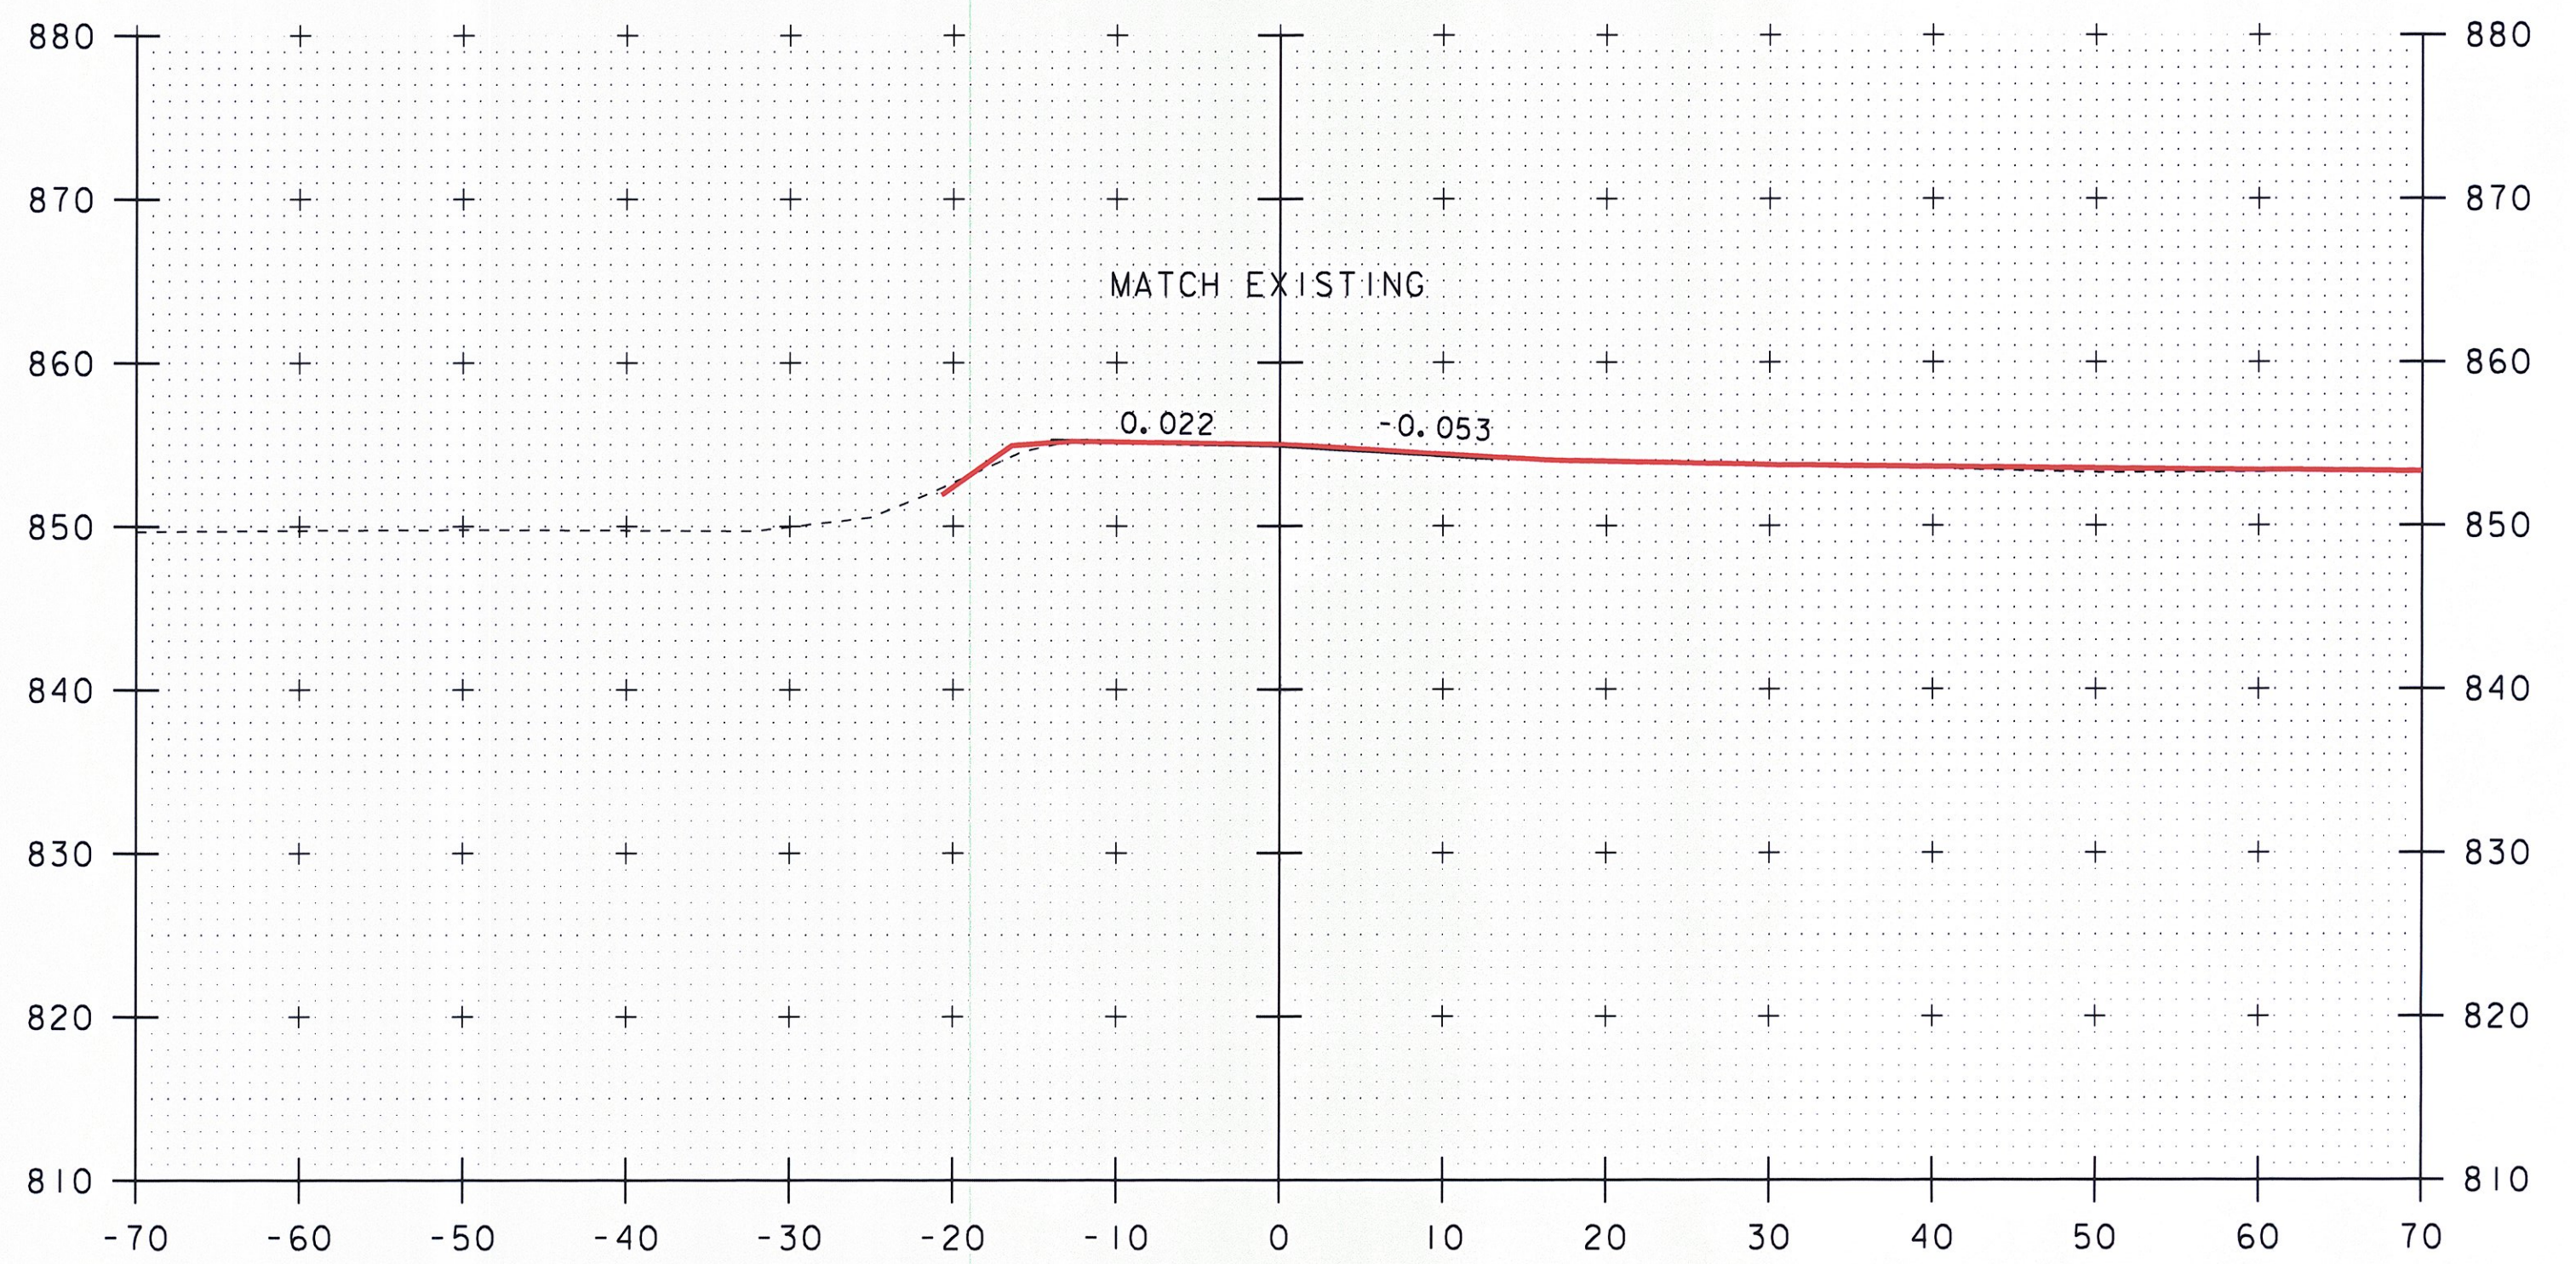

BEGIN APPROACH
108+50

SCALE 1" = 10'-0"

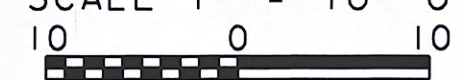

STA. 108+00 TO STA. 108+75

PROJECT NAME: BRIDGEWATER	PLOT DATE: 08-NOV-2012 05:4
PROJECT NUMBER: BRS 0149(4)	DRAWN BY: J. SALVATORI
FILE NAME: s86e062xs.dgn	CHECKED BY: T. FILLBACH
PROJECT LEADER: K. HIGGINS	SHEET 1 OF 10
DESIGNED BY: T. FILLBACH	
MAINLINE SECTIONS #1	