




109+25

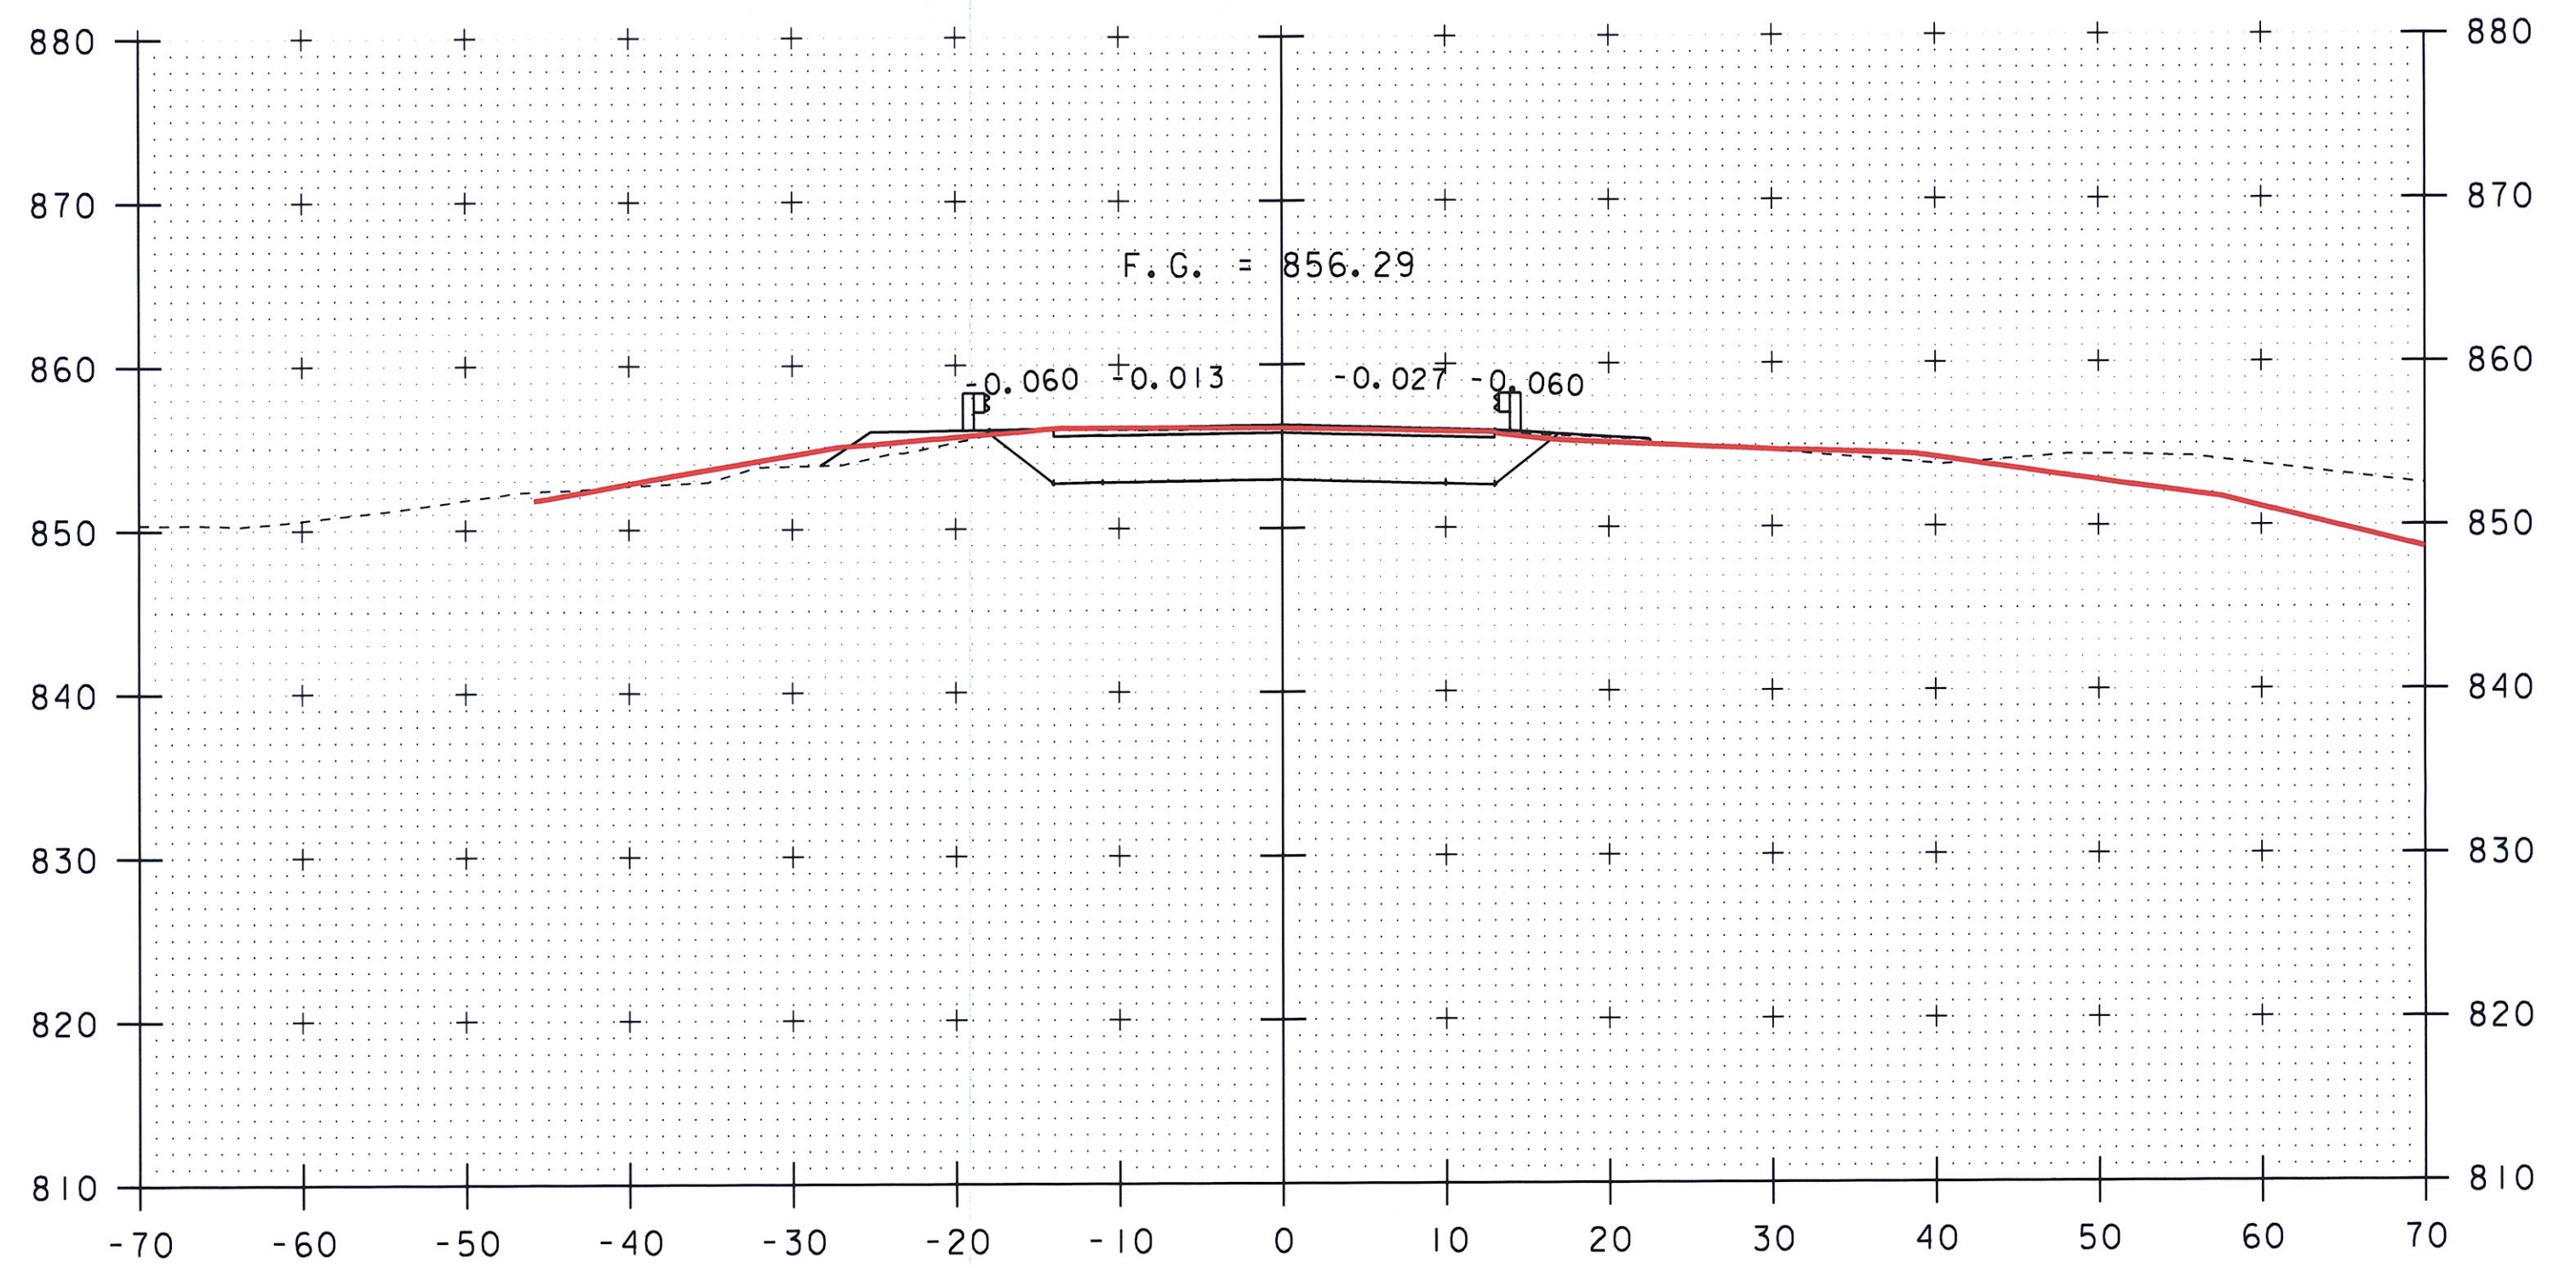

109+75

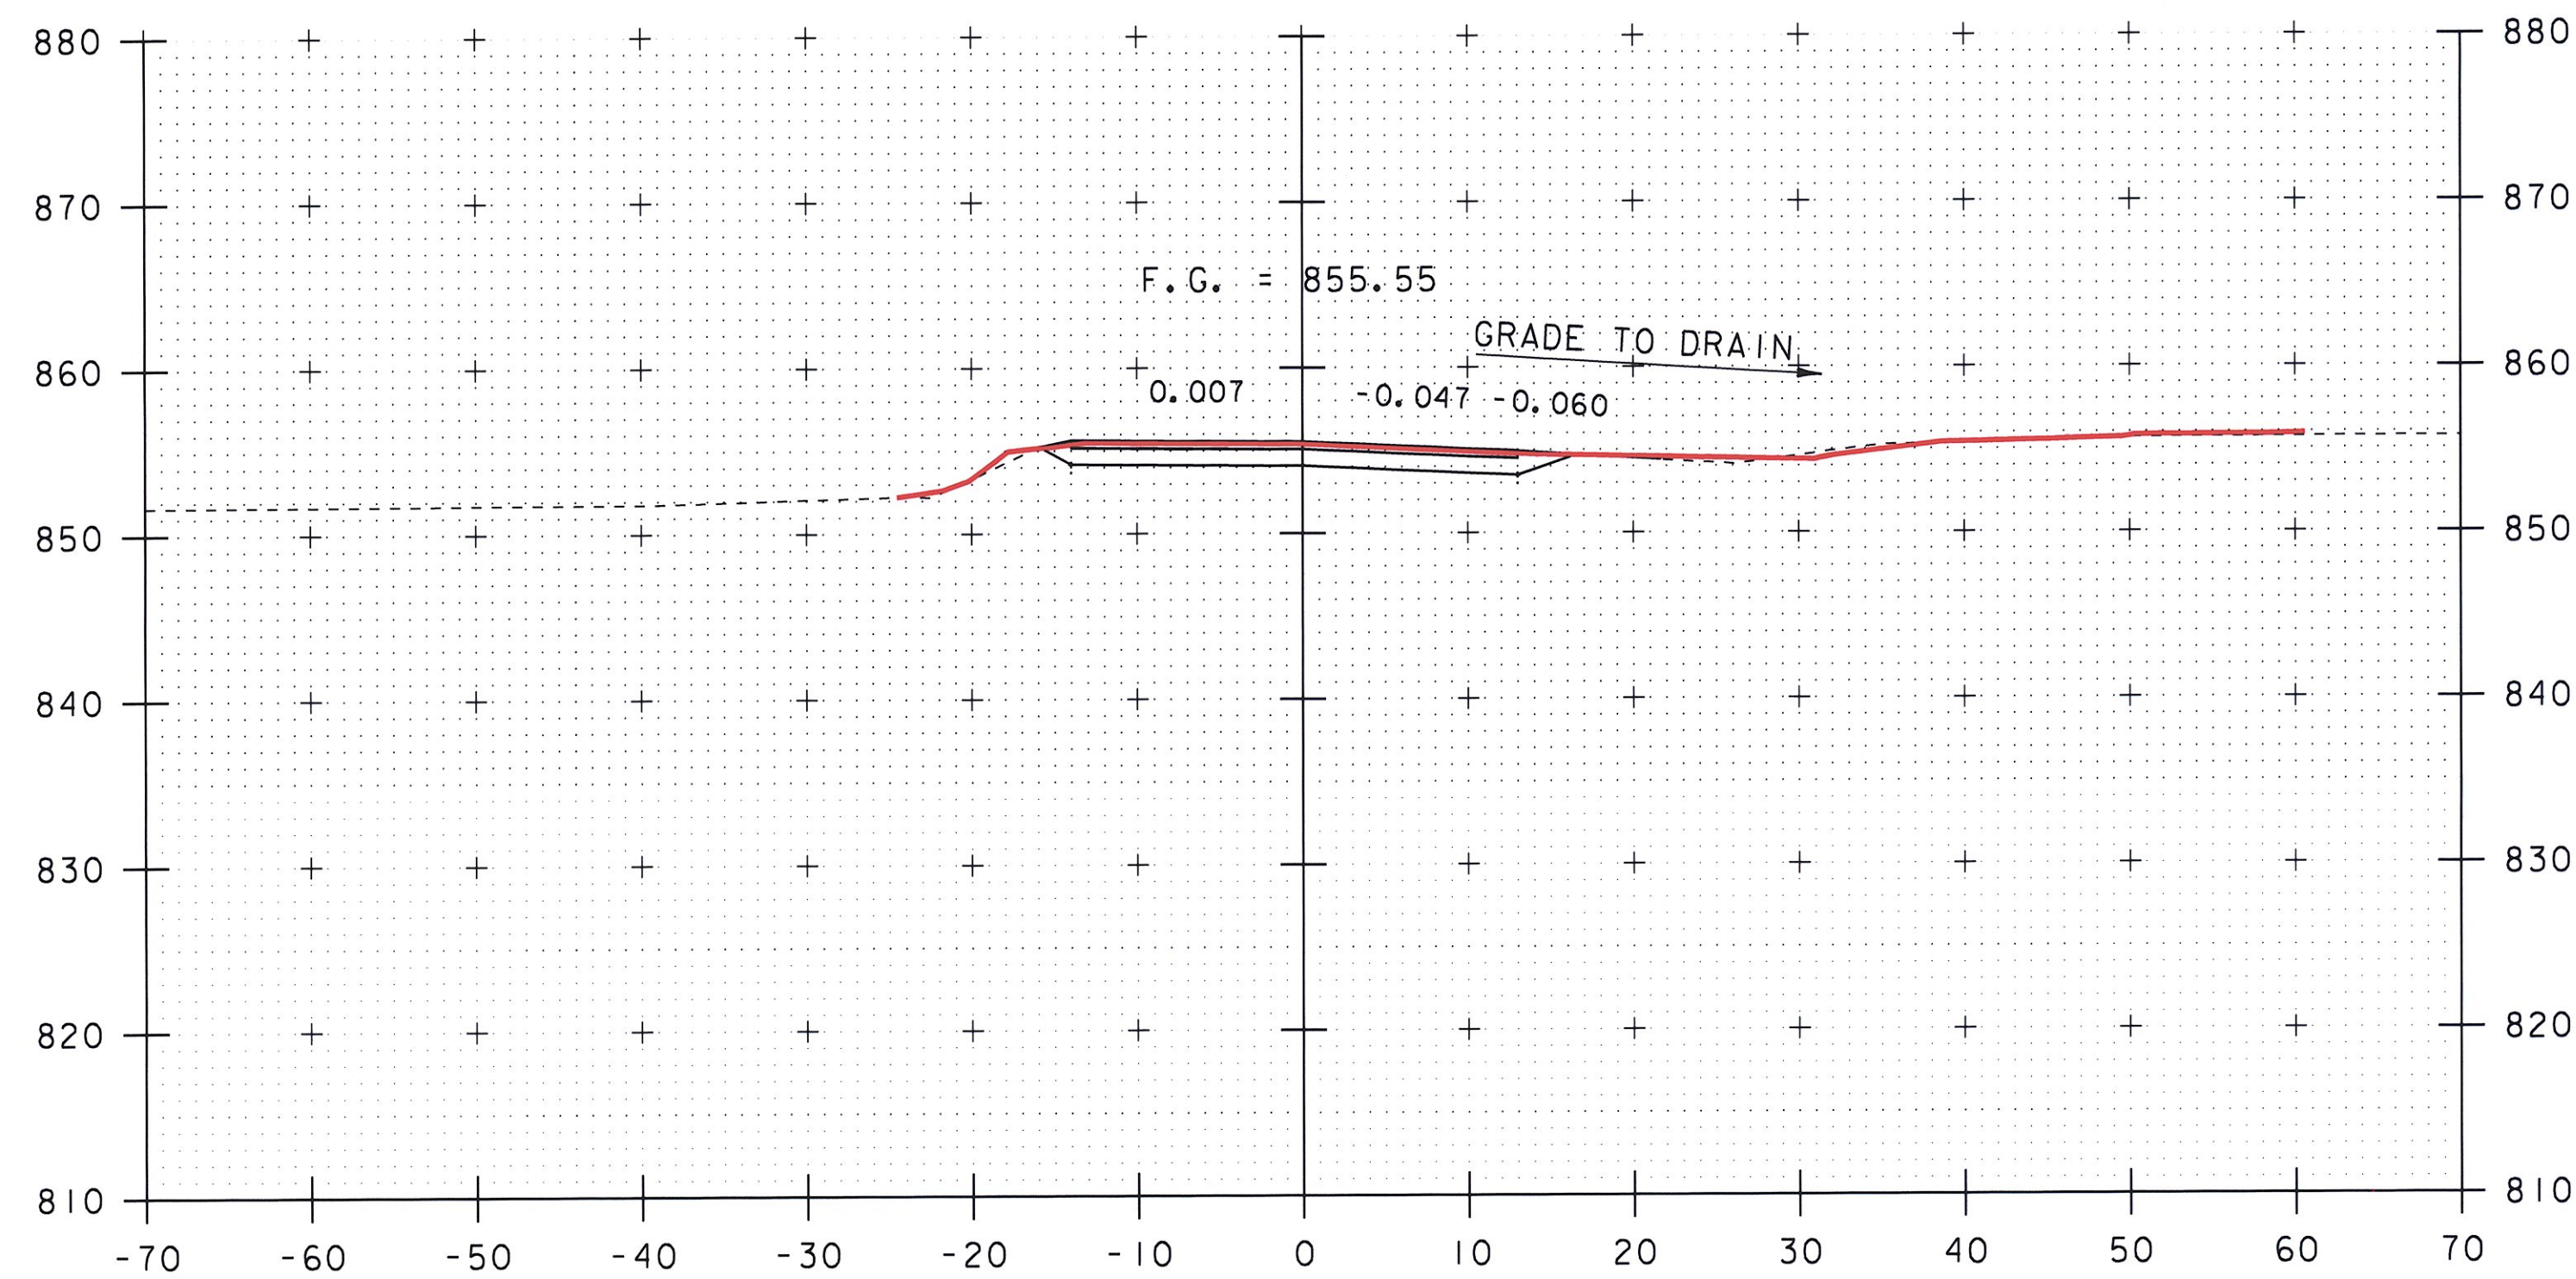

109+00

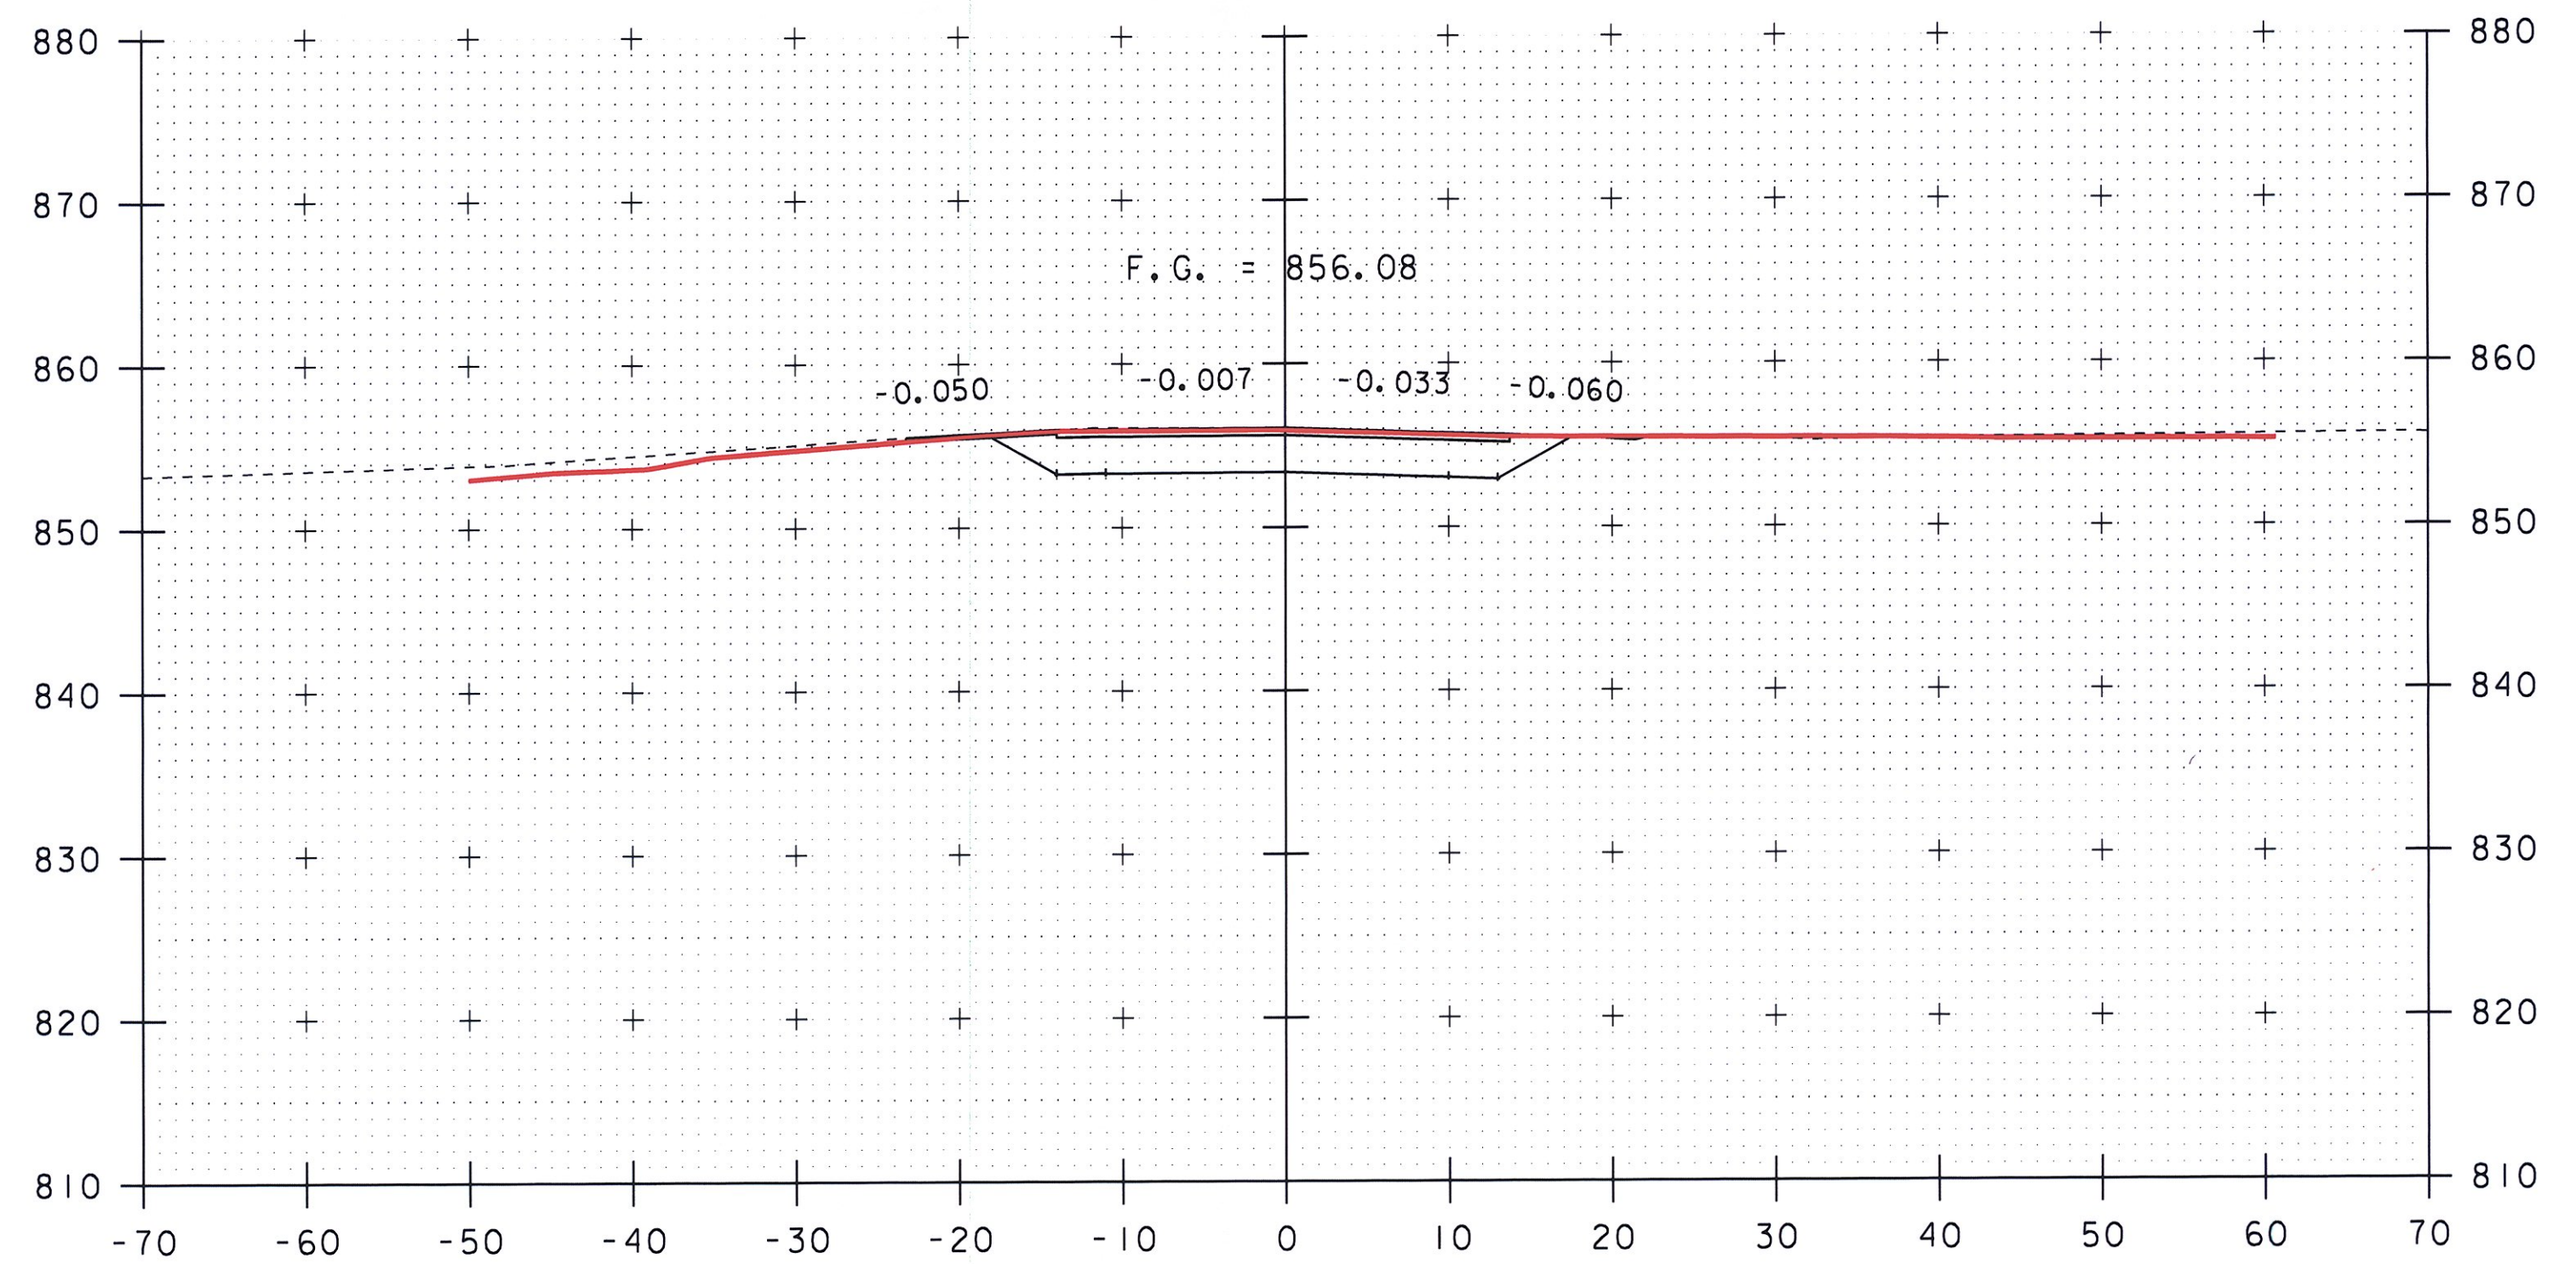

BEGIN PROJECT
109+50

SCALE 1" = 10'-0"
10 0 10

STA. 109+00 TO STA. 109+75

PROJECT NAME: BRIDGEWATER	PLOT DATE: 08-NOV-2012 07:10
PROJECT NUMBER: BRS 0149(4)	DRAWN BY: J. SALVATORI
FILE NAME: s86e062xs.dgn	CHECKED BY: T. FILLBACH
PROJECT LEADER: K. HIGGINS	SHEET 2 OF 10
DESIGNED BY: T. FILLBACH	
MAINLINE SECTIONS #2	