




111+00

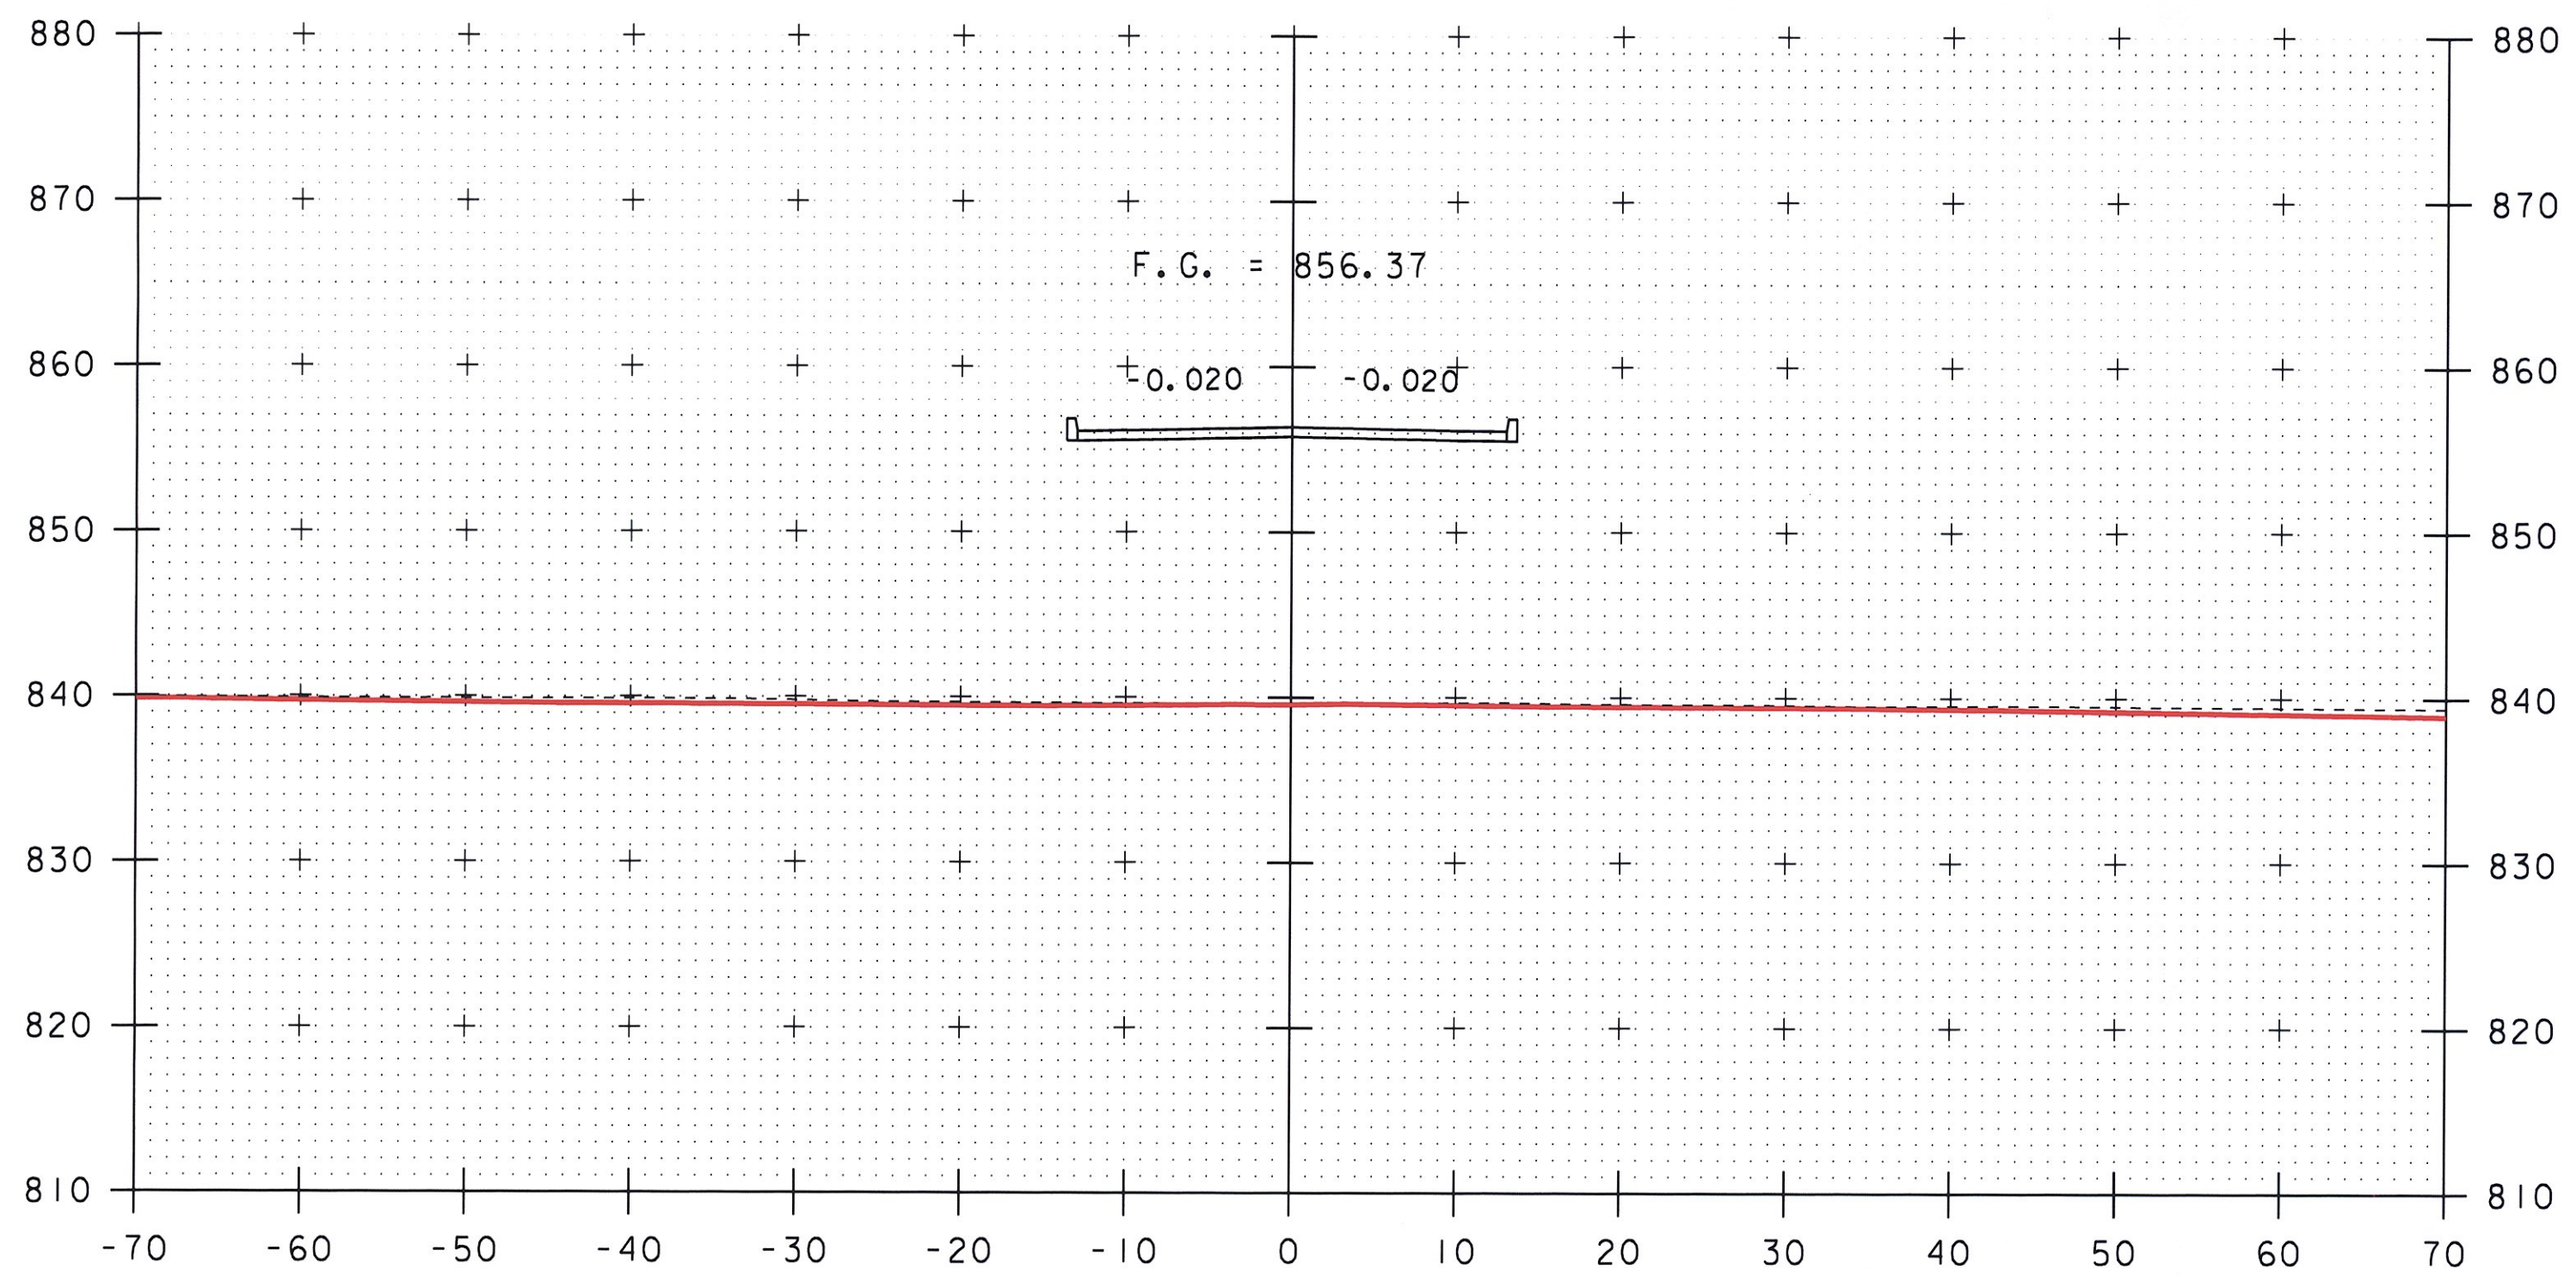


110+75

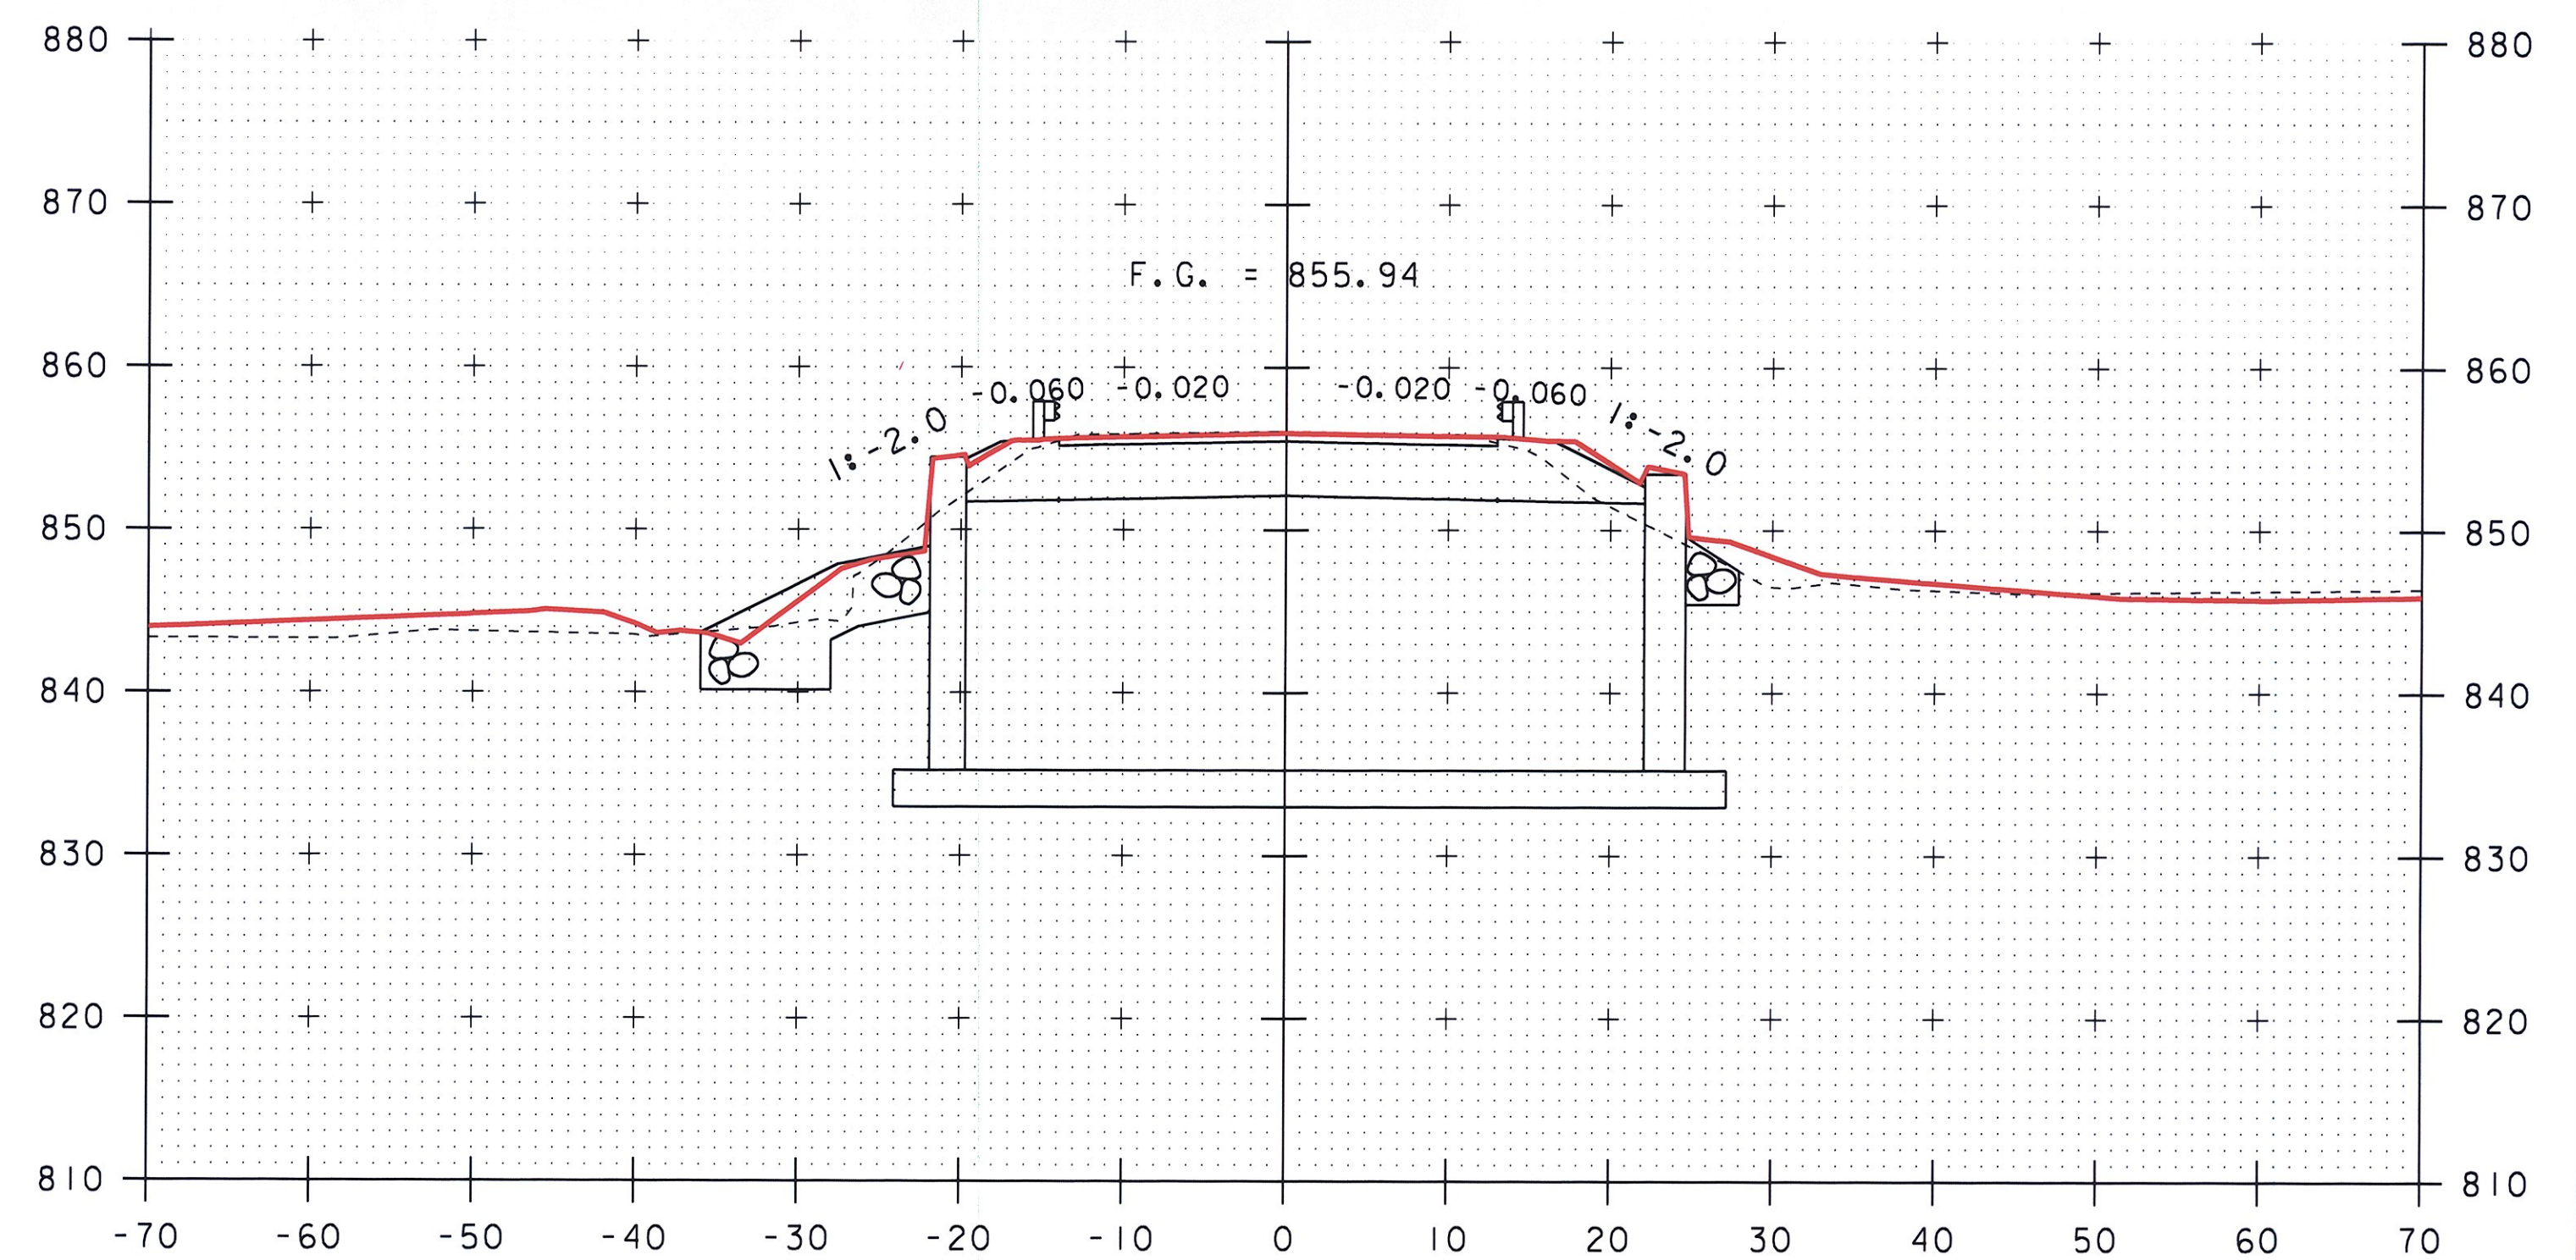

111+25

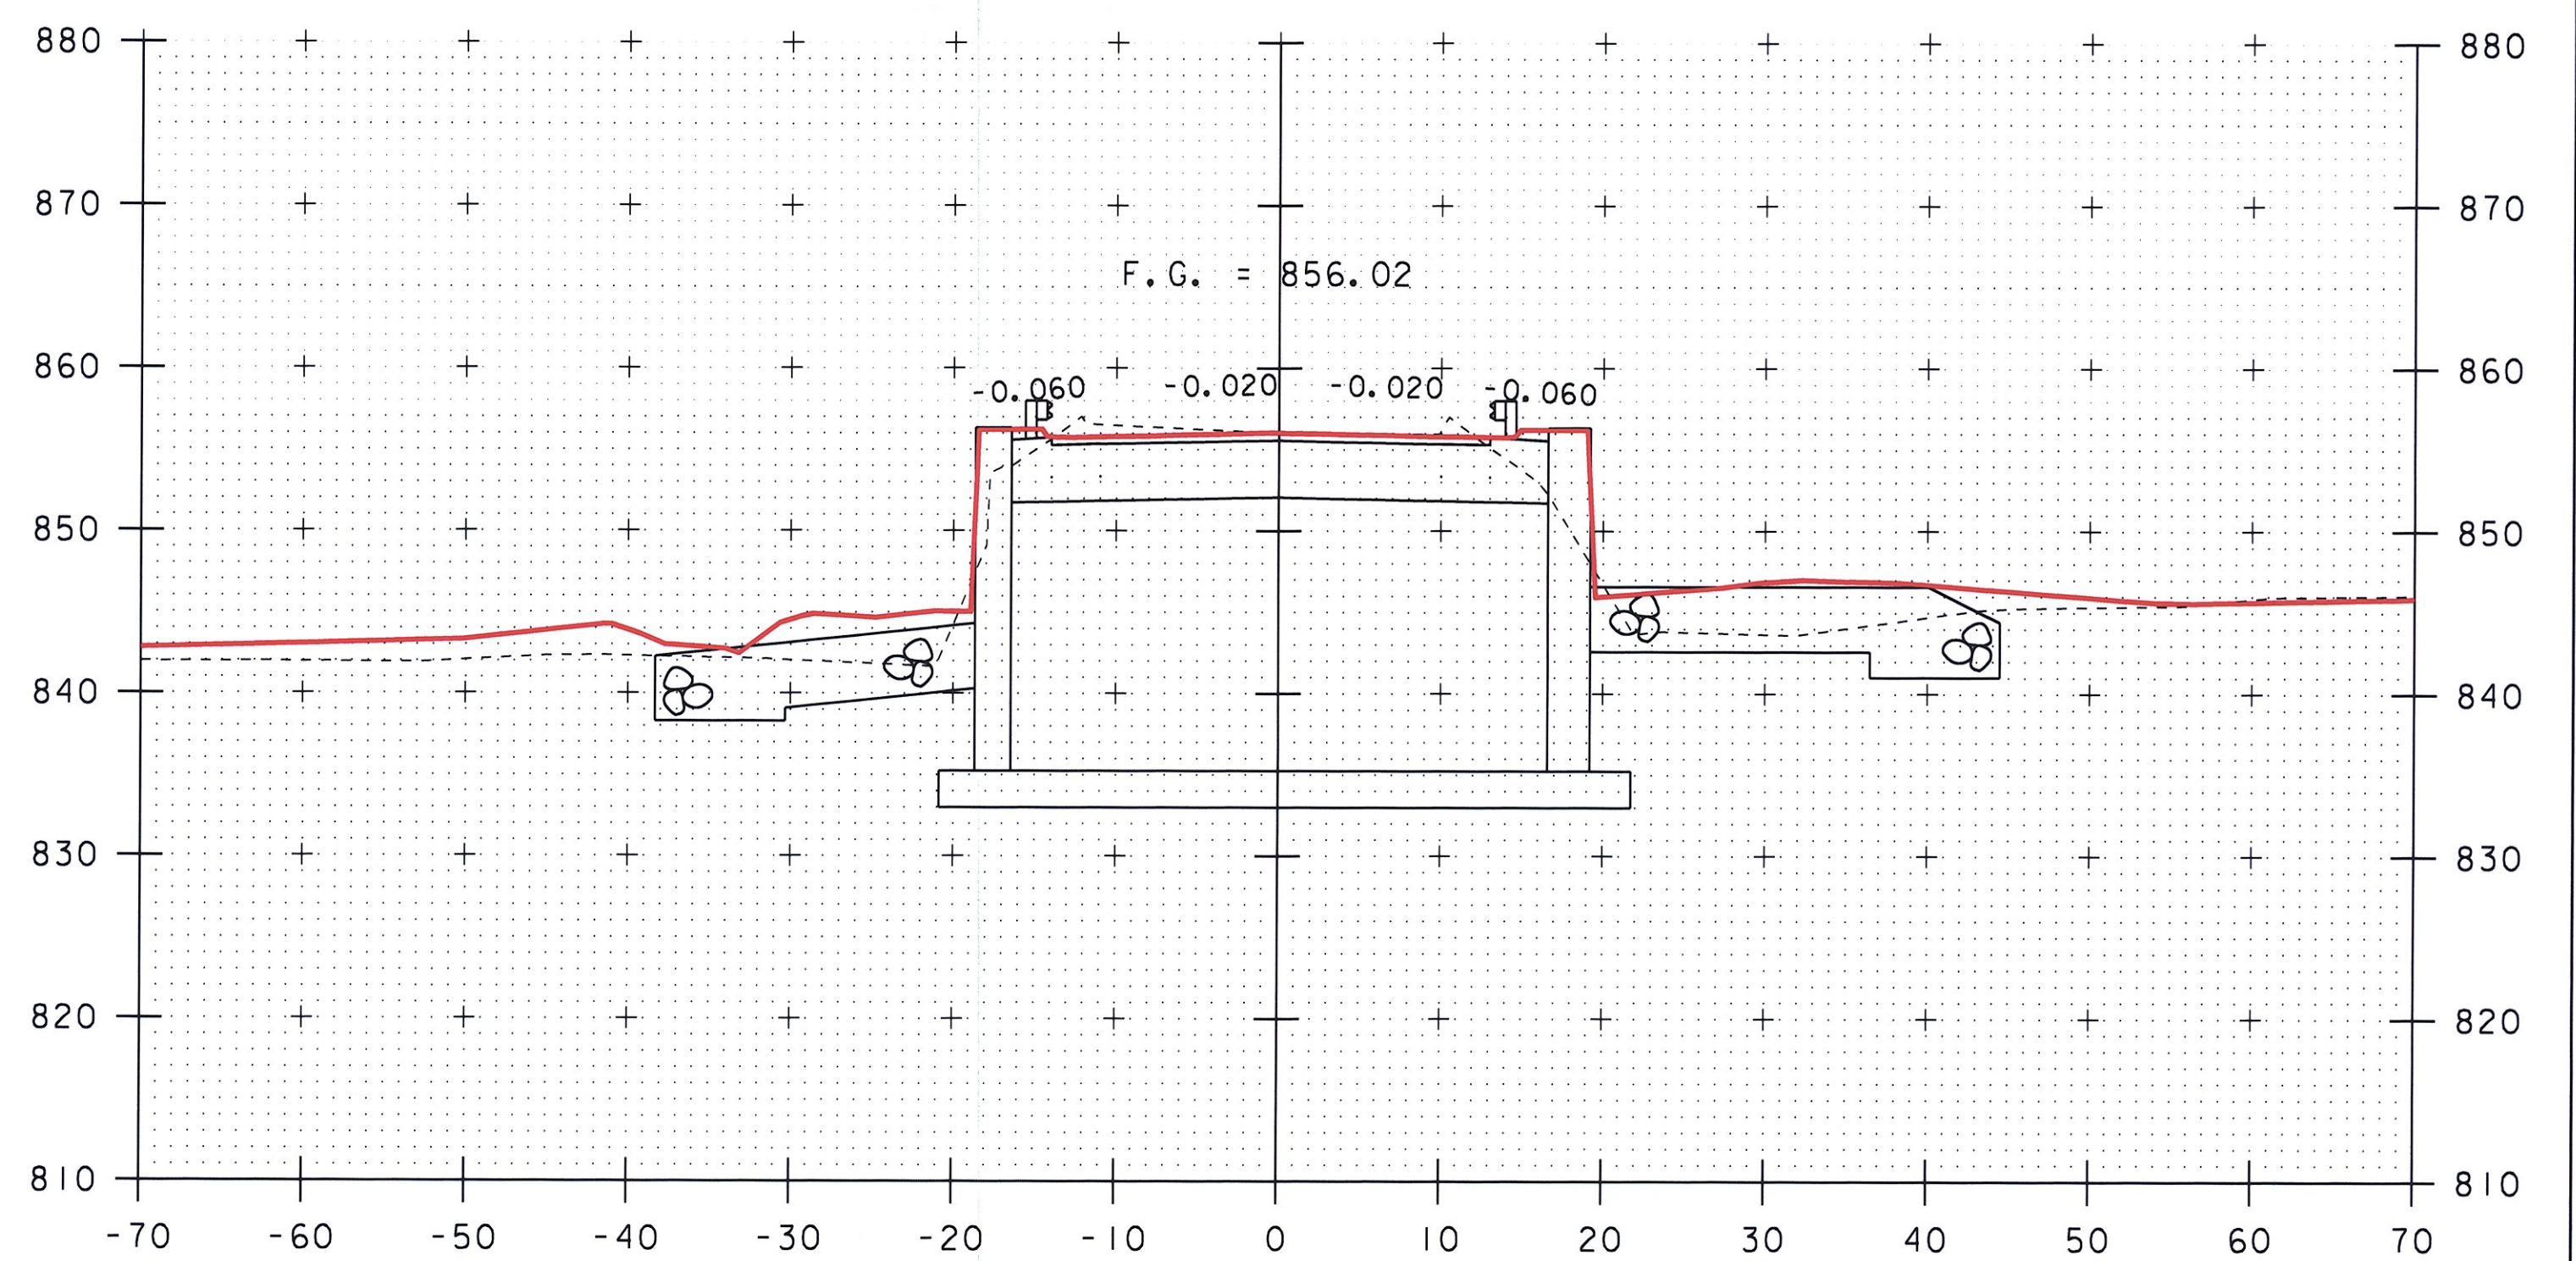

END BRIDGE  
111+18.04

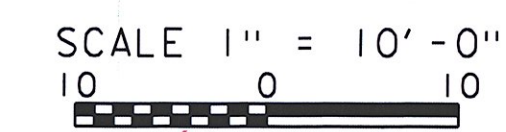

STA. 110+75 TO STA. 111+25

PROJECT NAME:	BRIDGEWATER	PLOT DATE:	08-NOV-2012 07:4
PROJECT NUMBER:	BRS 0149(4)	DRAWN BY:	J. SALVATORI
FILE NAME:	s86e062xs.dgn	CHECKED BY:	T. FILLBACH
PROJECT LEADER:	K. HIGGINS	MAINLINE SECTIONS #4	SHEET 4 OF 10
DESIGNED BY:	T. FILLBACH		