




111+75

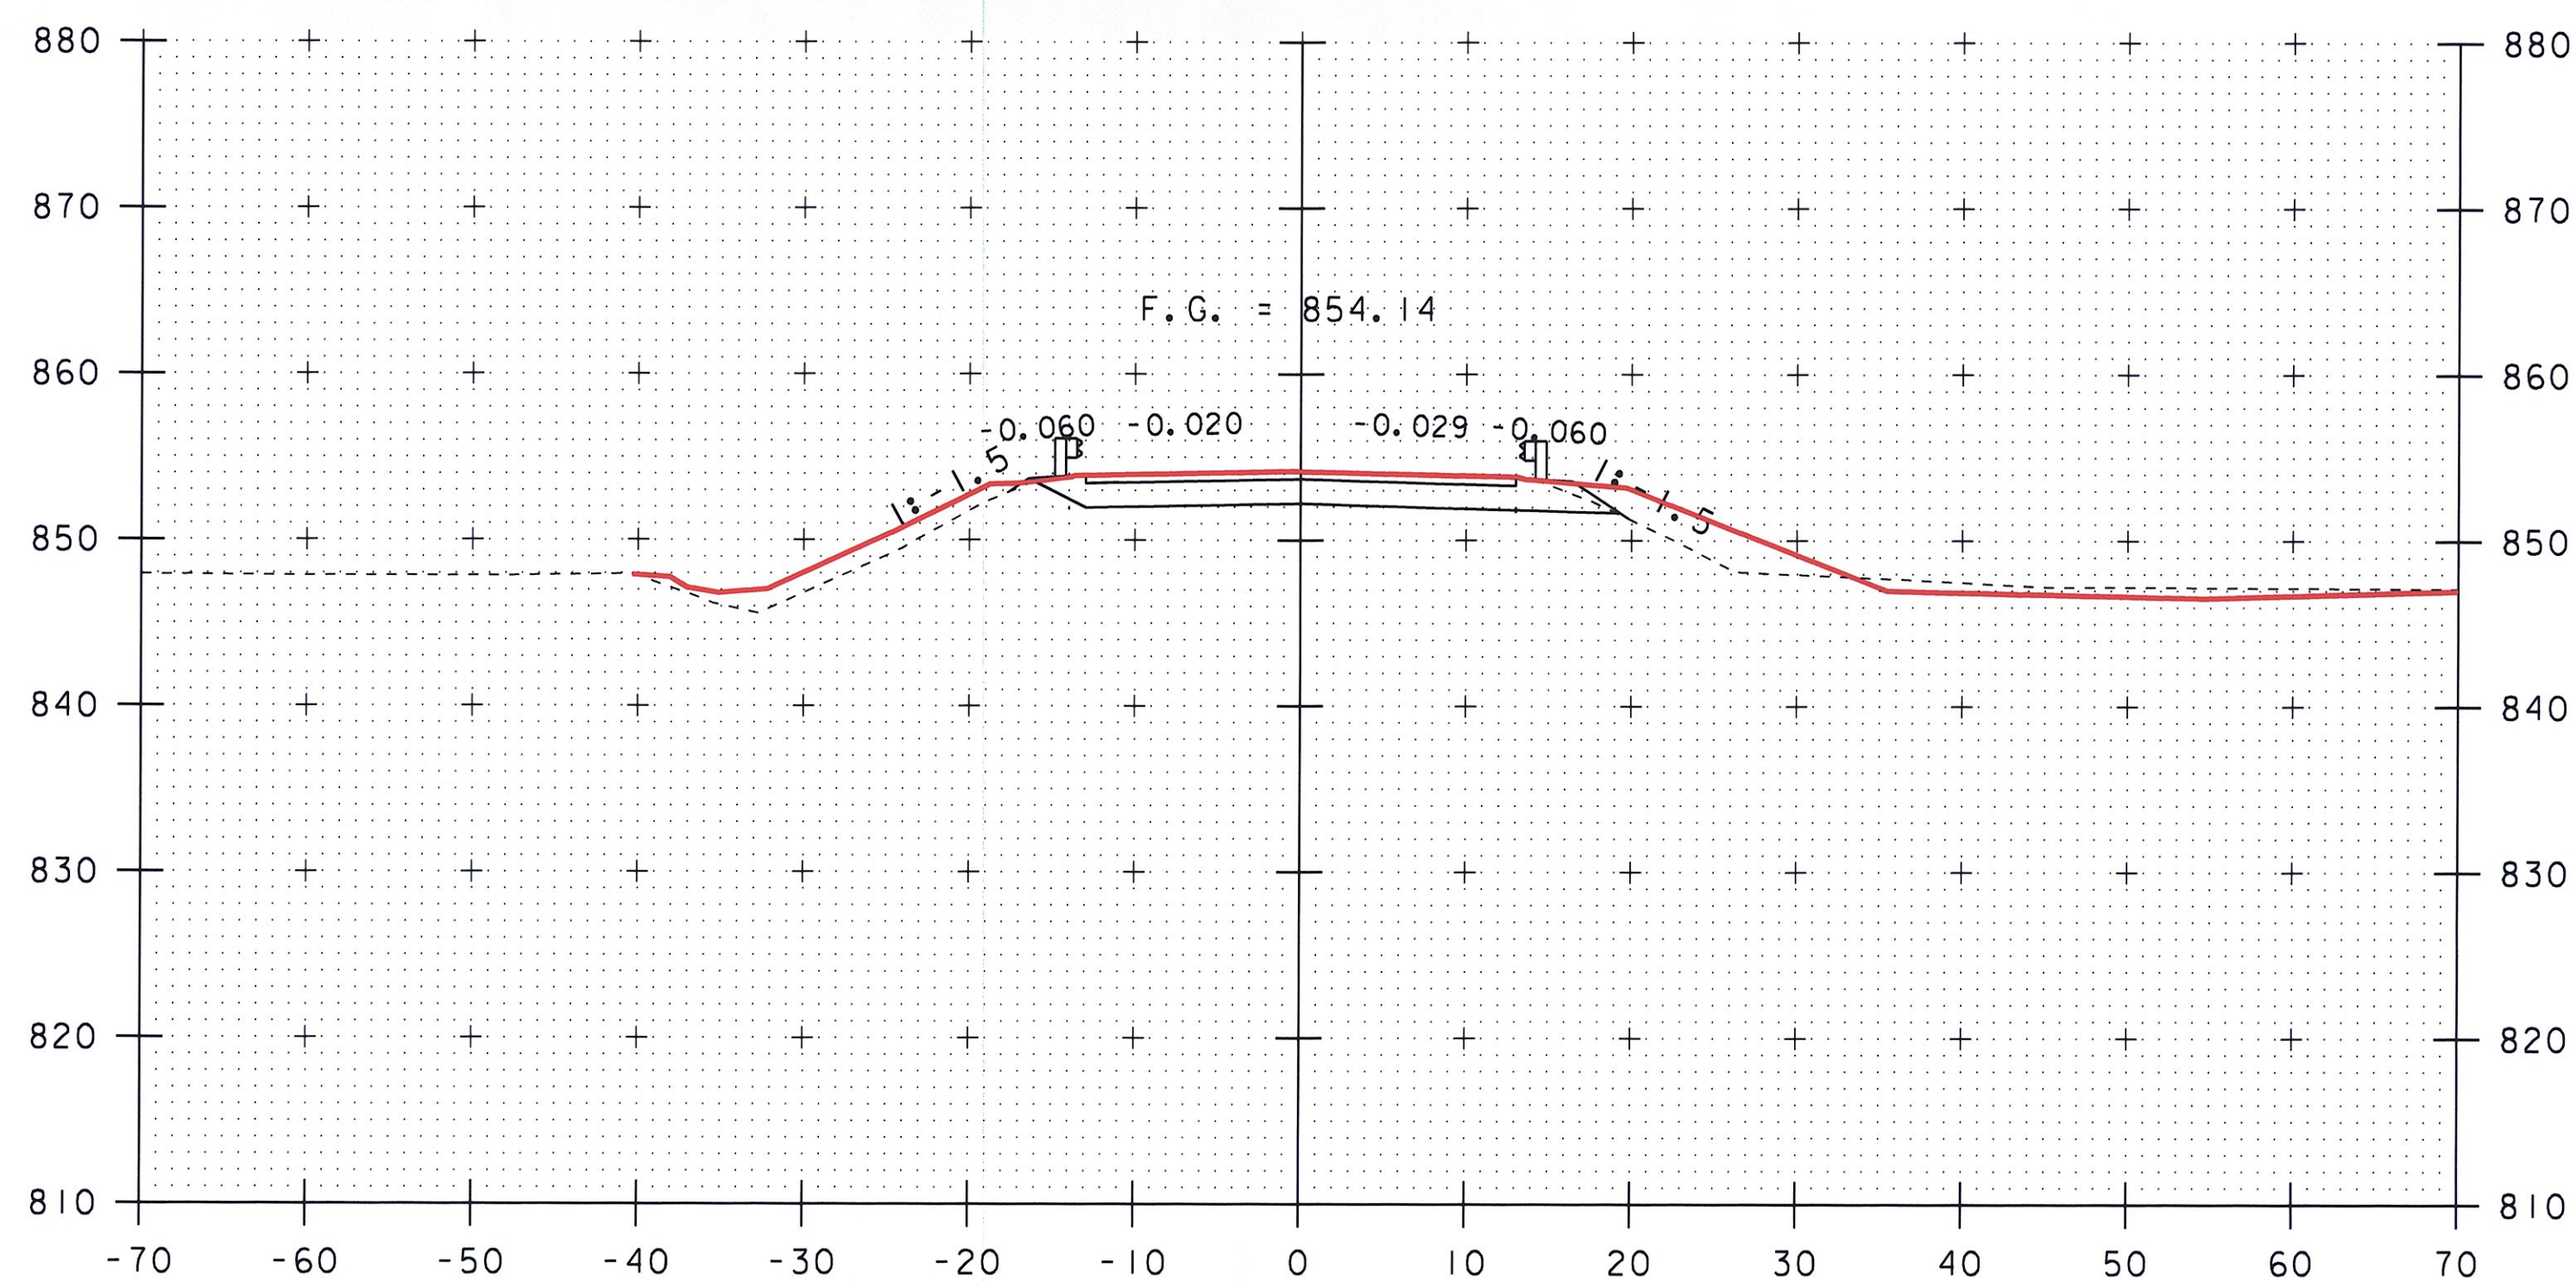

112+25

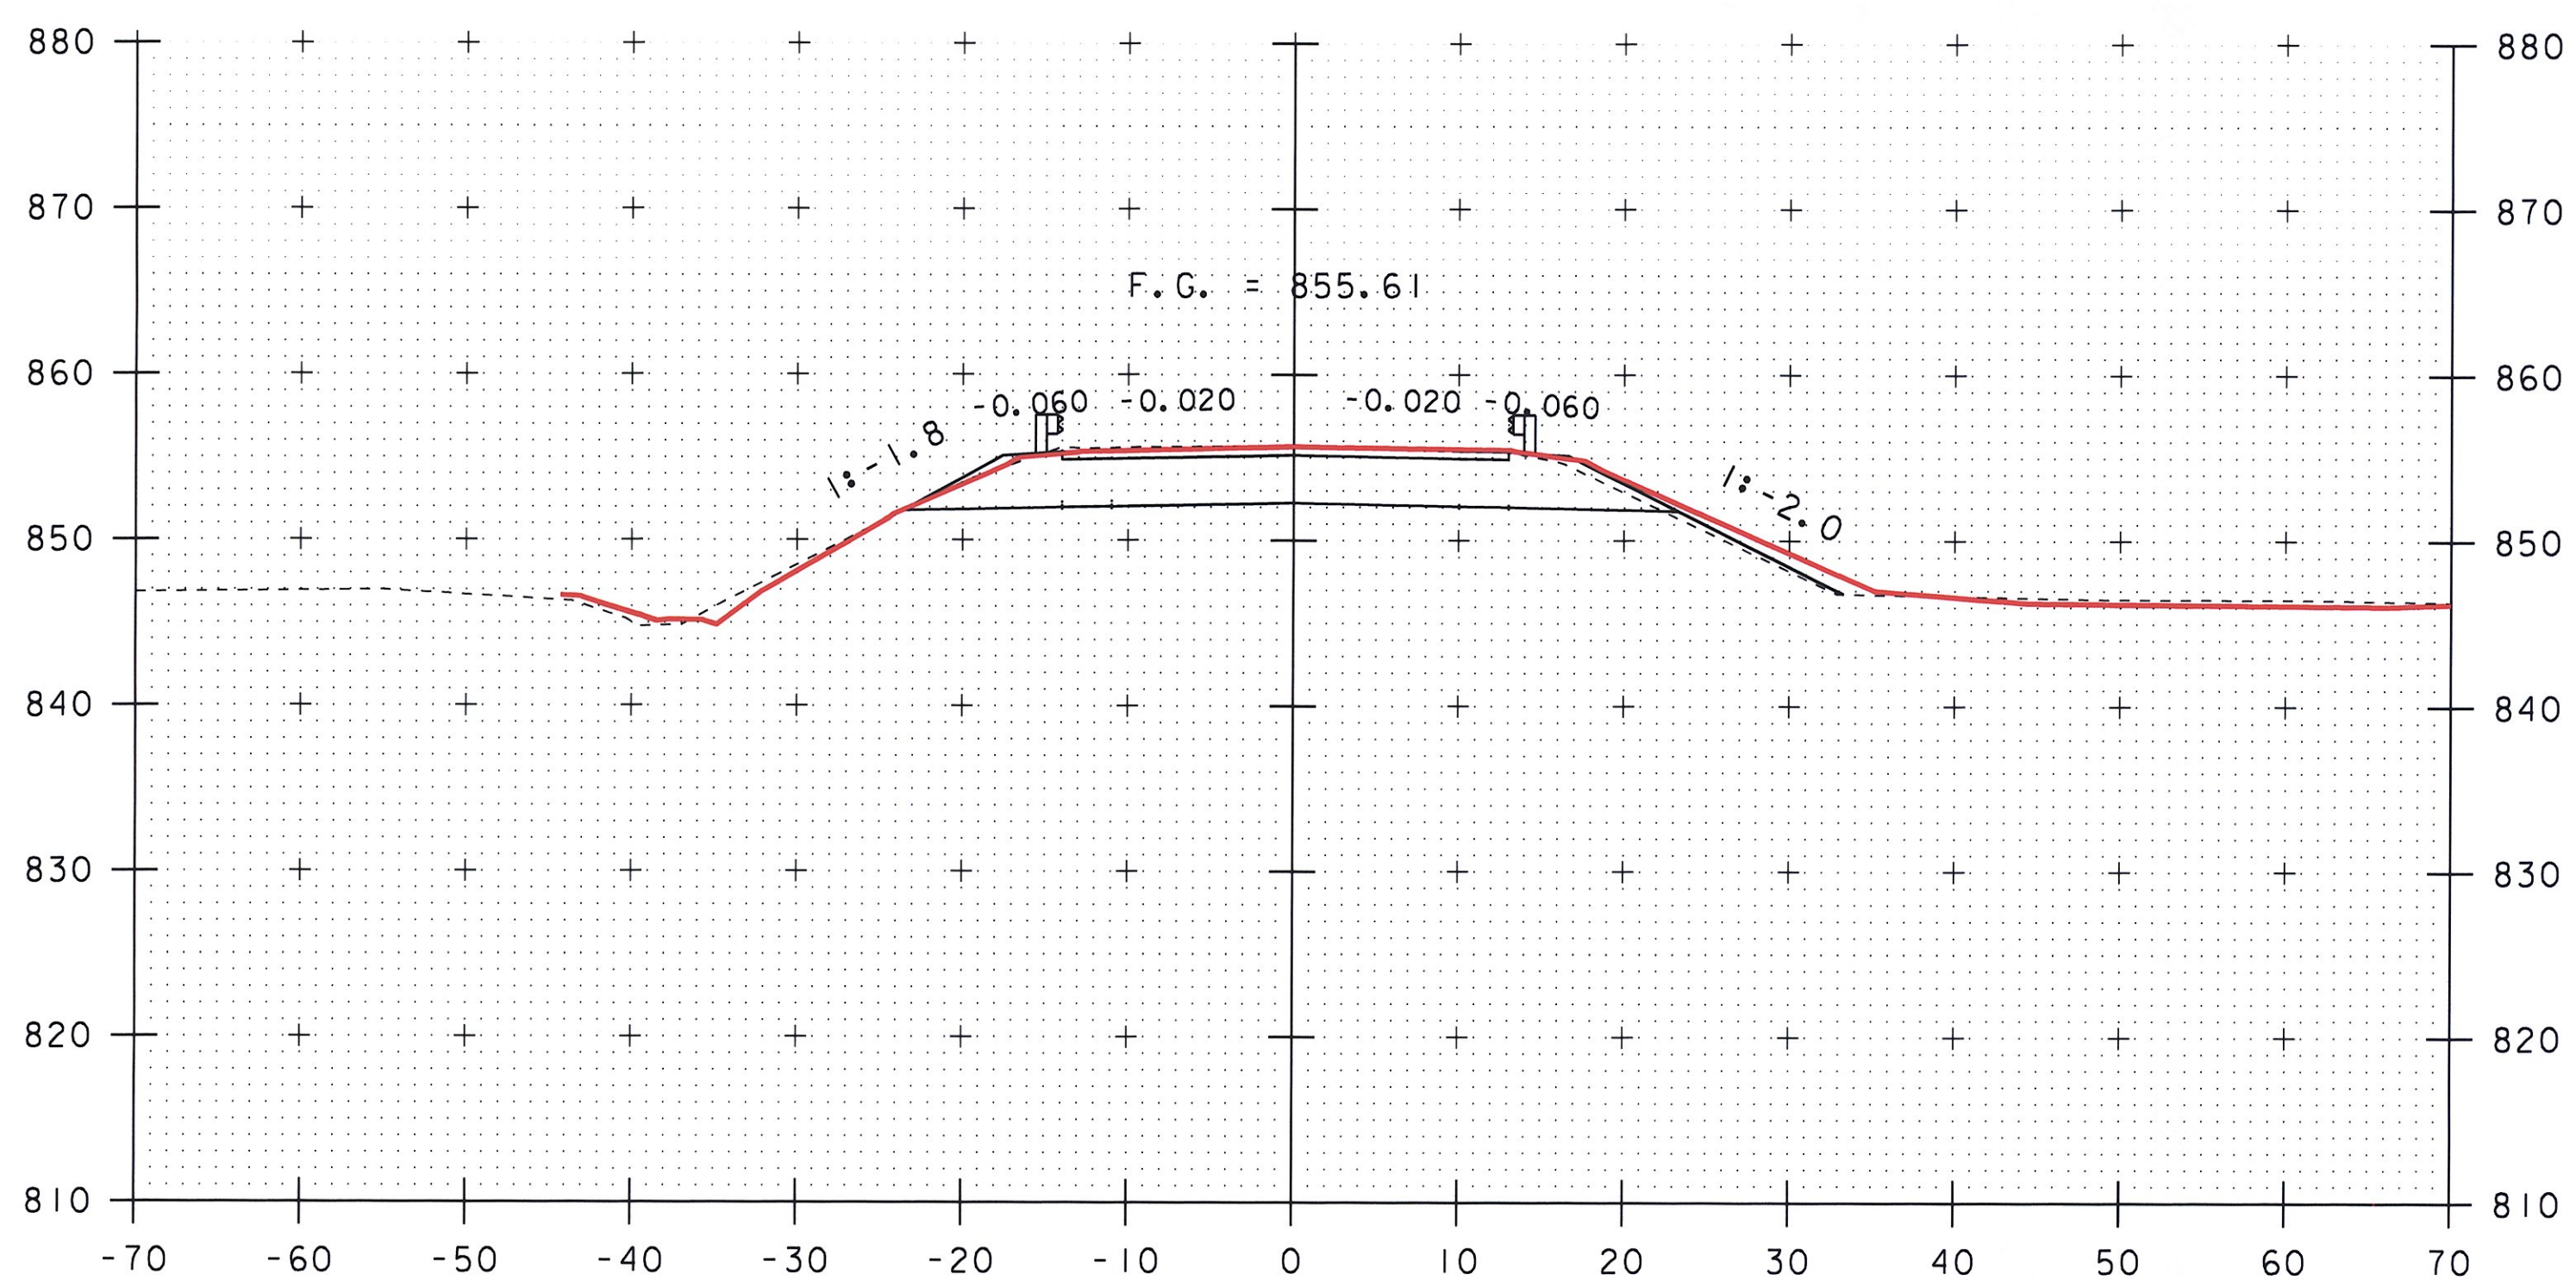

111+50

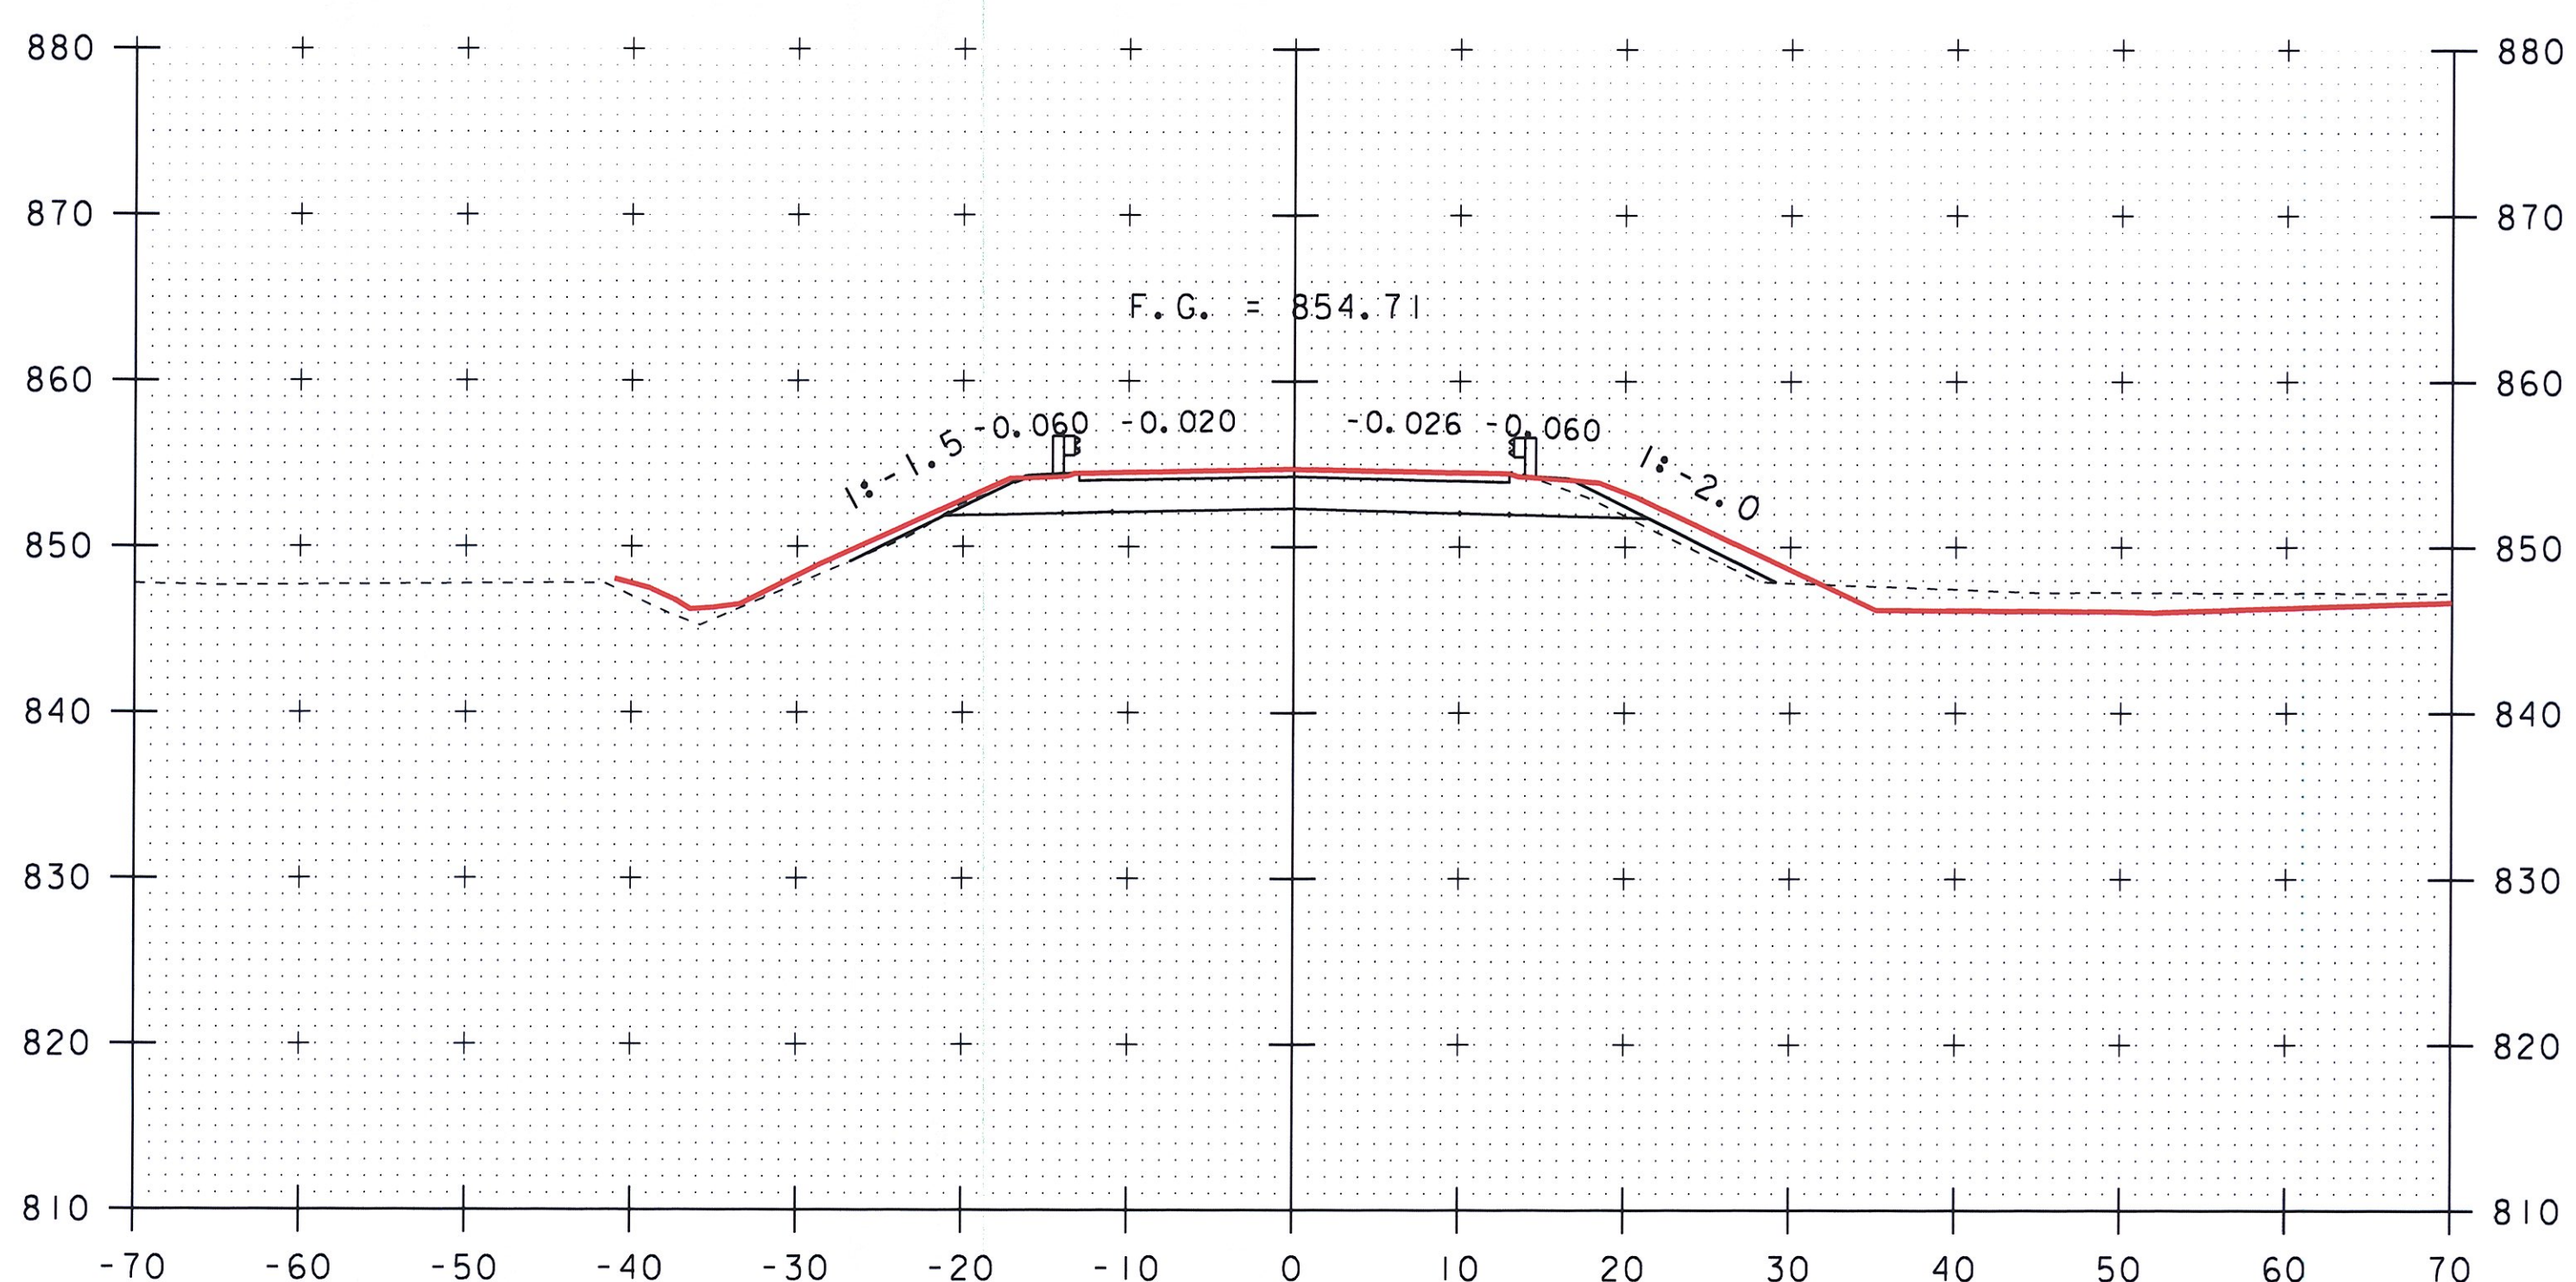

END PROJECT  
112+00

SCALE 1" = 10' - 0"  
10 0 10

STA. 111+50 TO STA. 112+25

PROJECT NAME: BRIDGEWATER	PLOT DATE: 08-NOV-2012 07:41
PROJECT NUMBER: BRS 0149(4)	DRAWN BY: J. SALVATORI
FILE NAME: s86e062xs.dgn	CHECKED BY: T. FILLBACH
PROJECT LEADER: K. HIGGINS	SHEET 5 OF 10
DESIGNED BY: T. FILLBACH	
MAINLINE SECTIONS #5	