




112+75

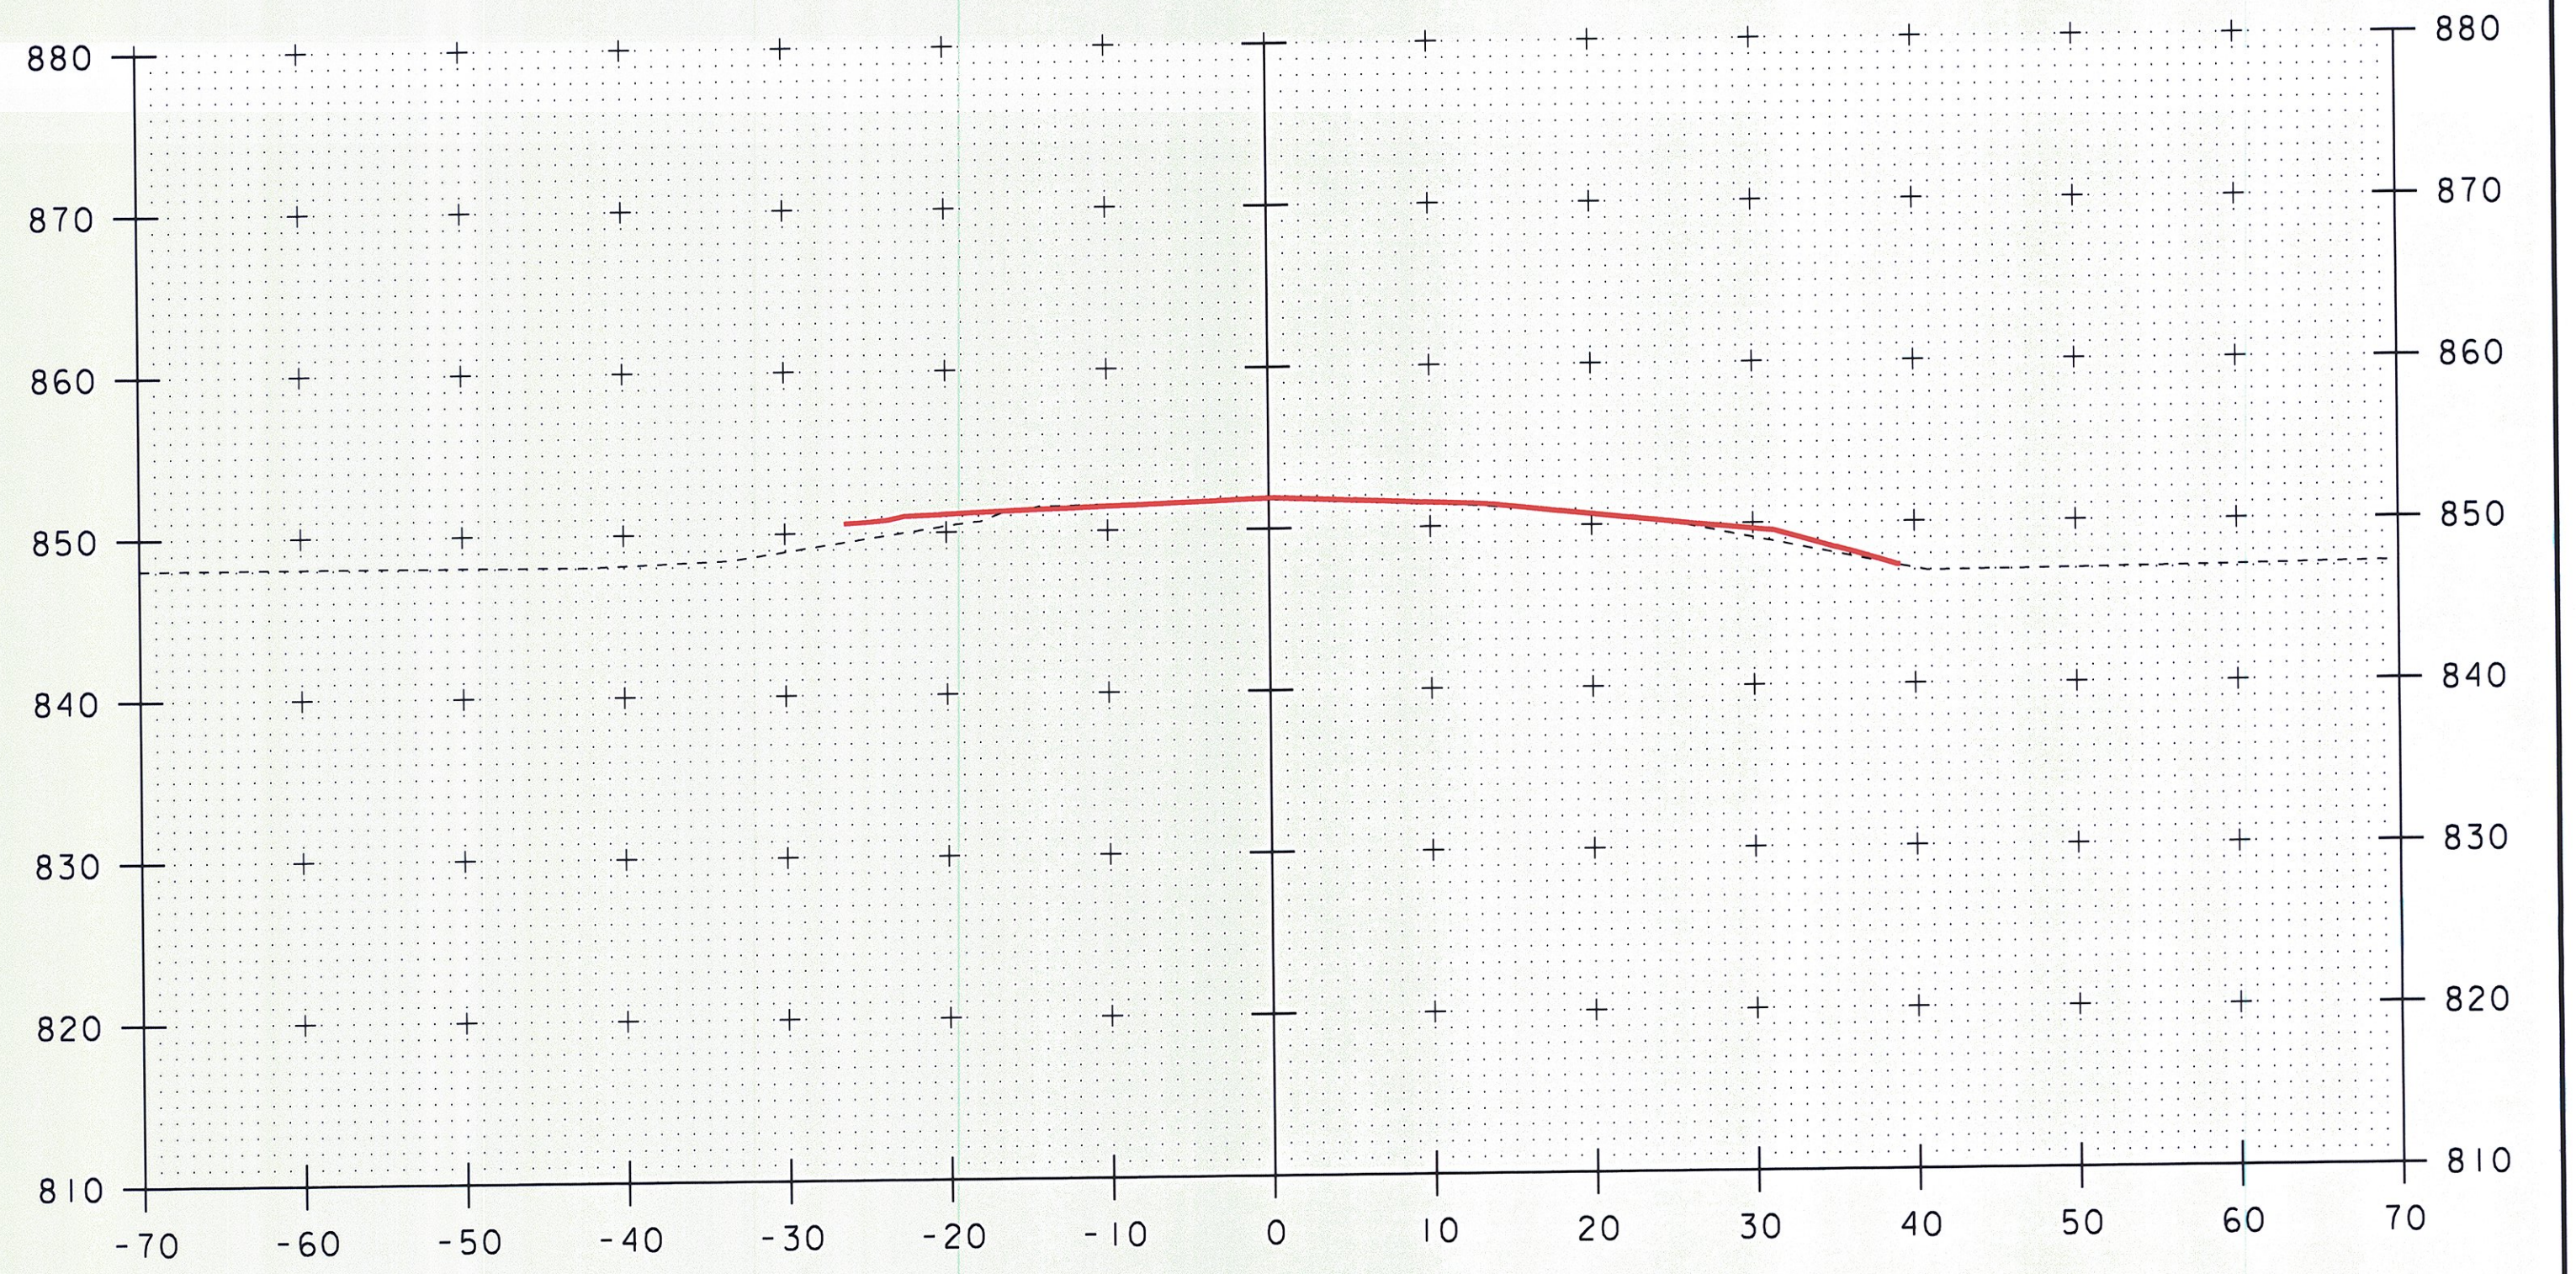


113+25

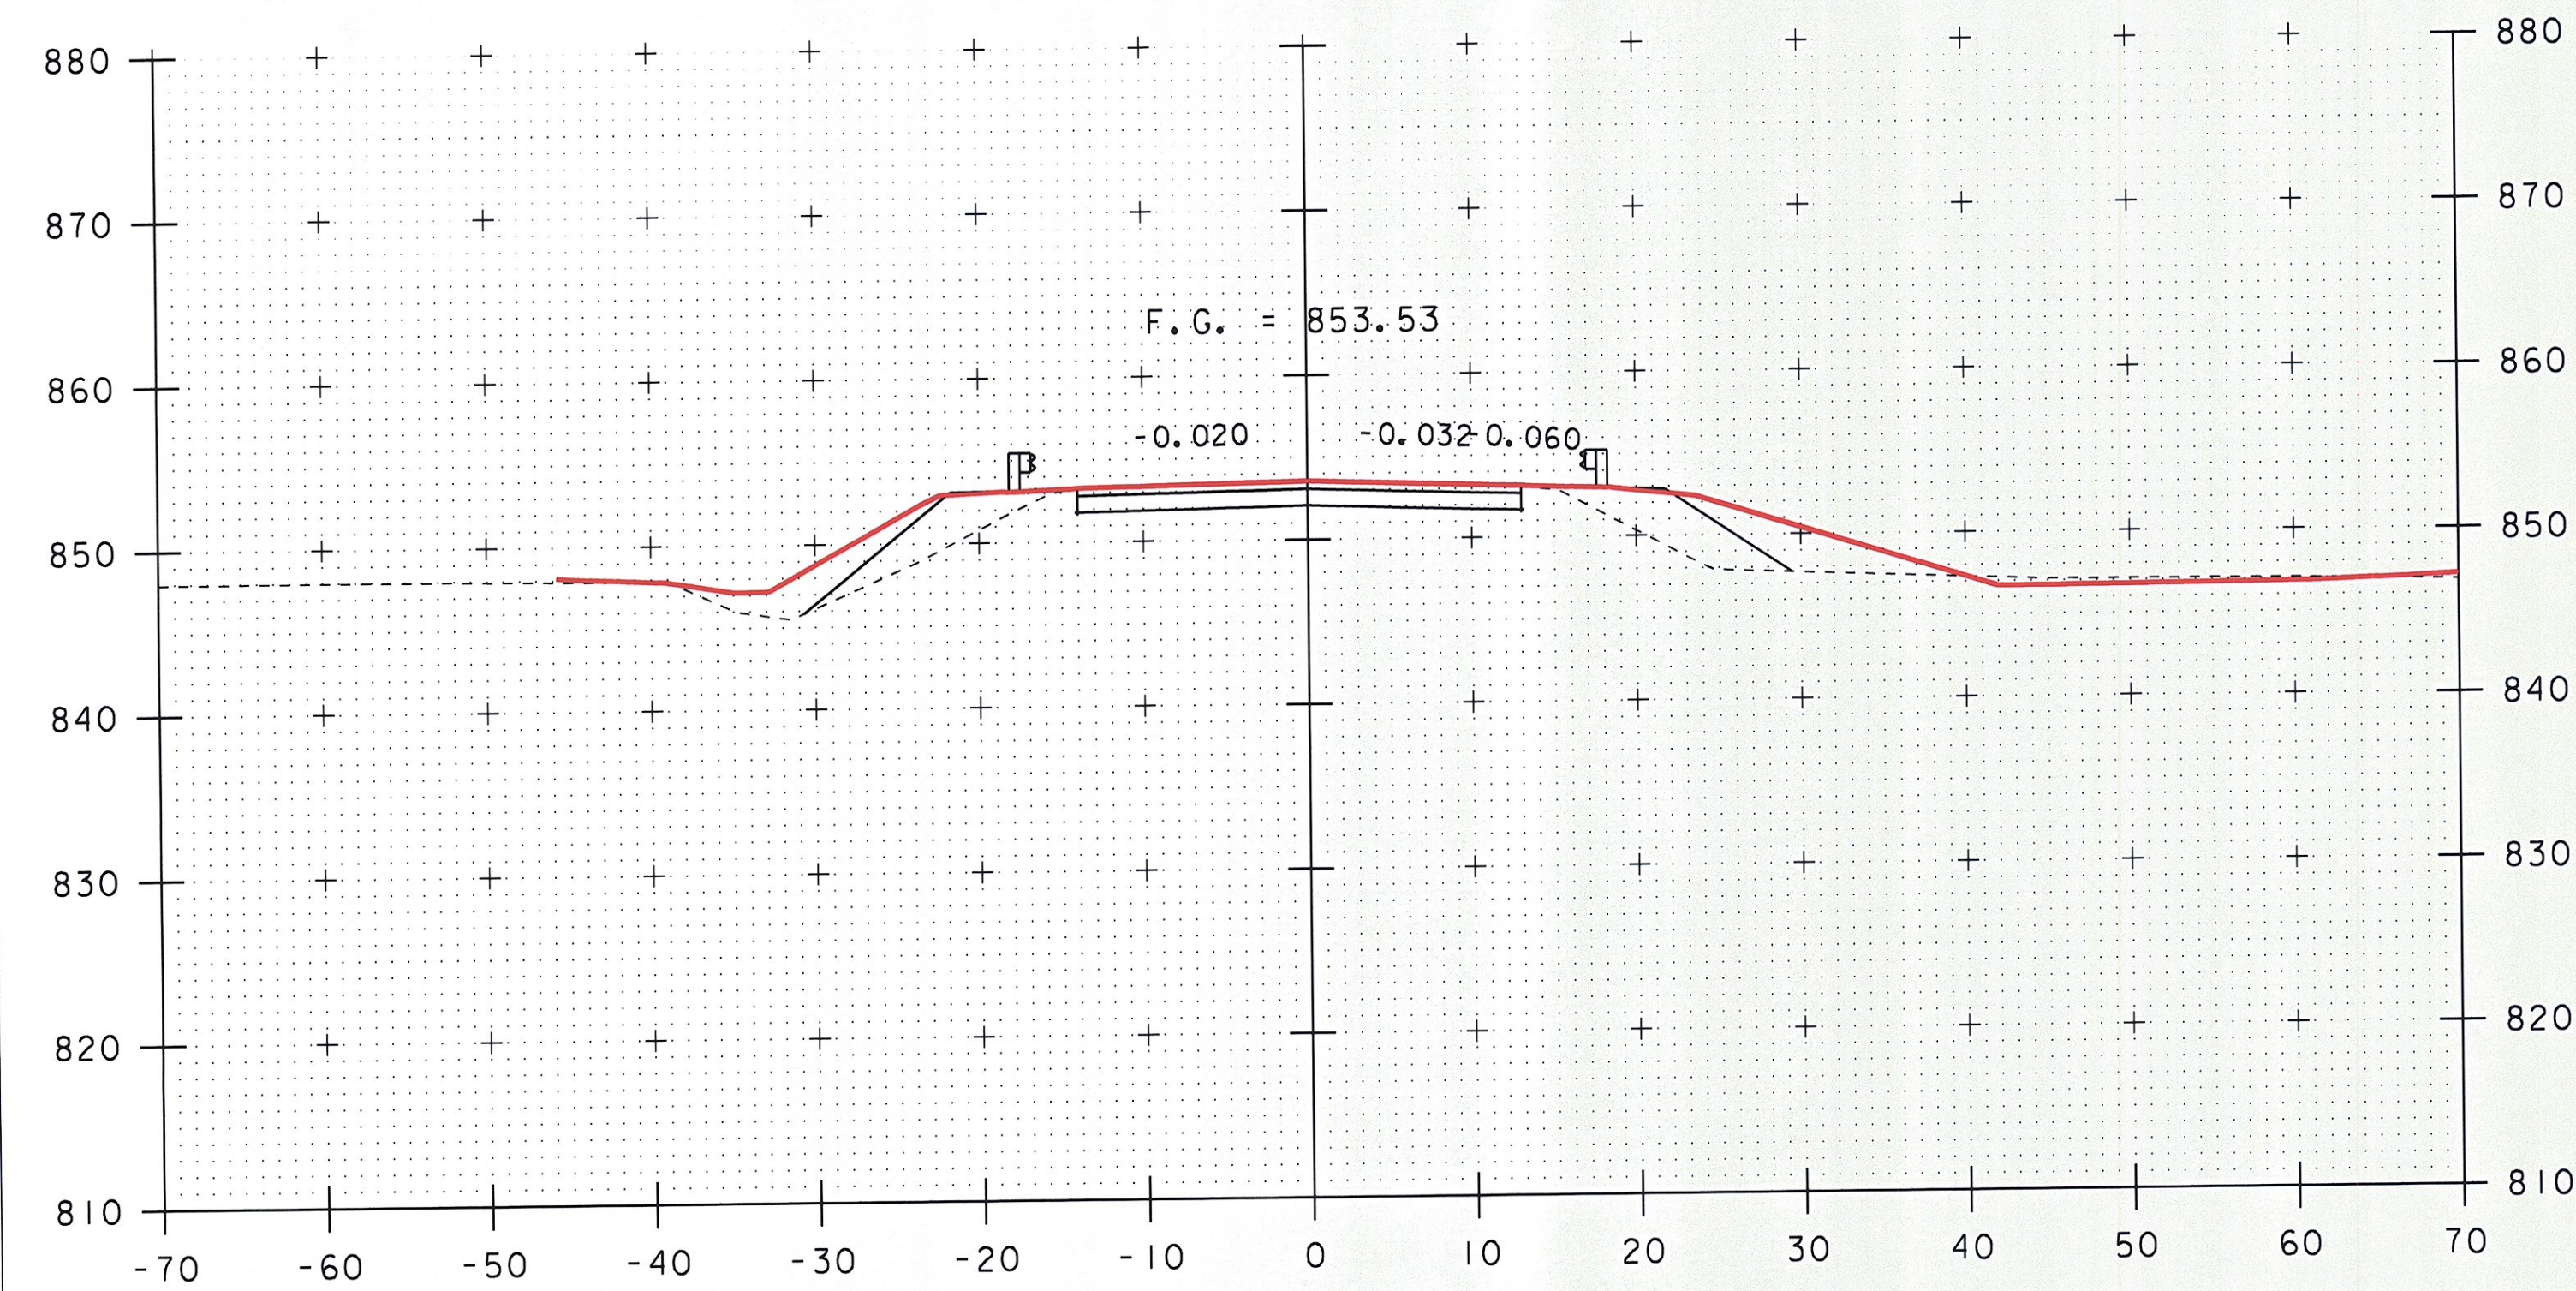

112+50

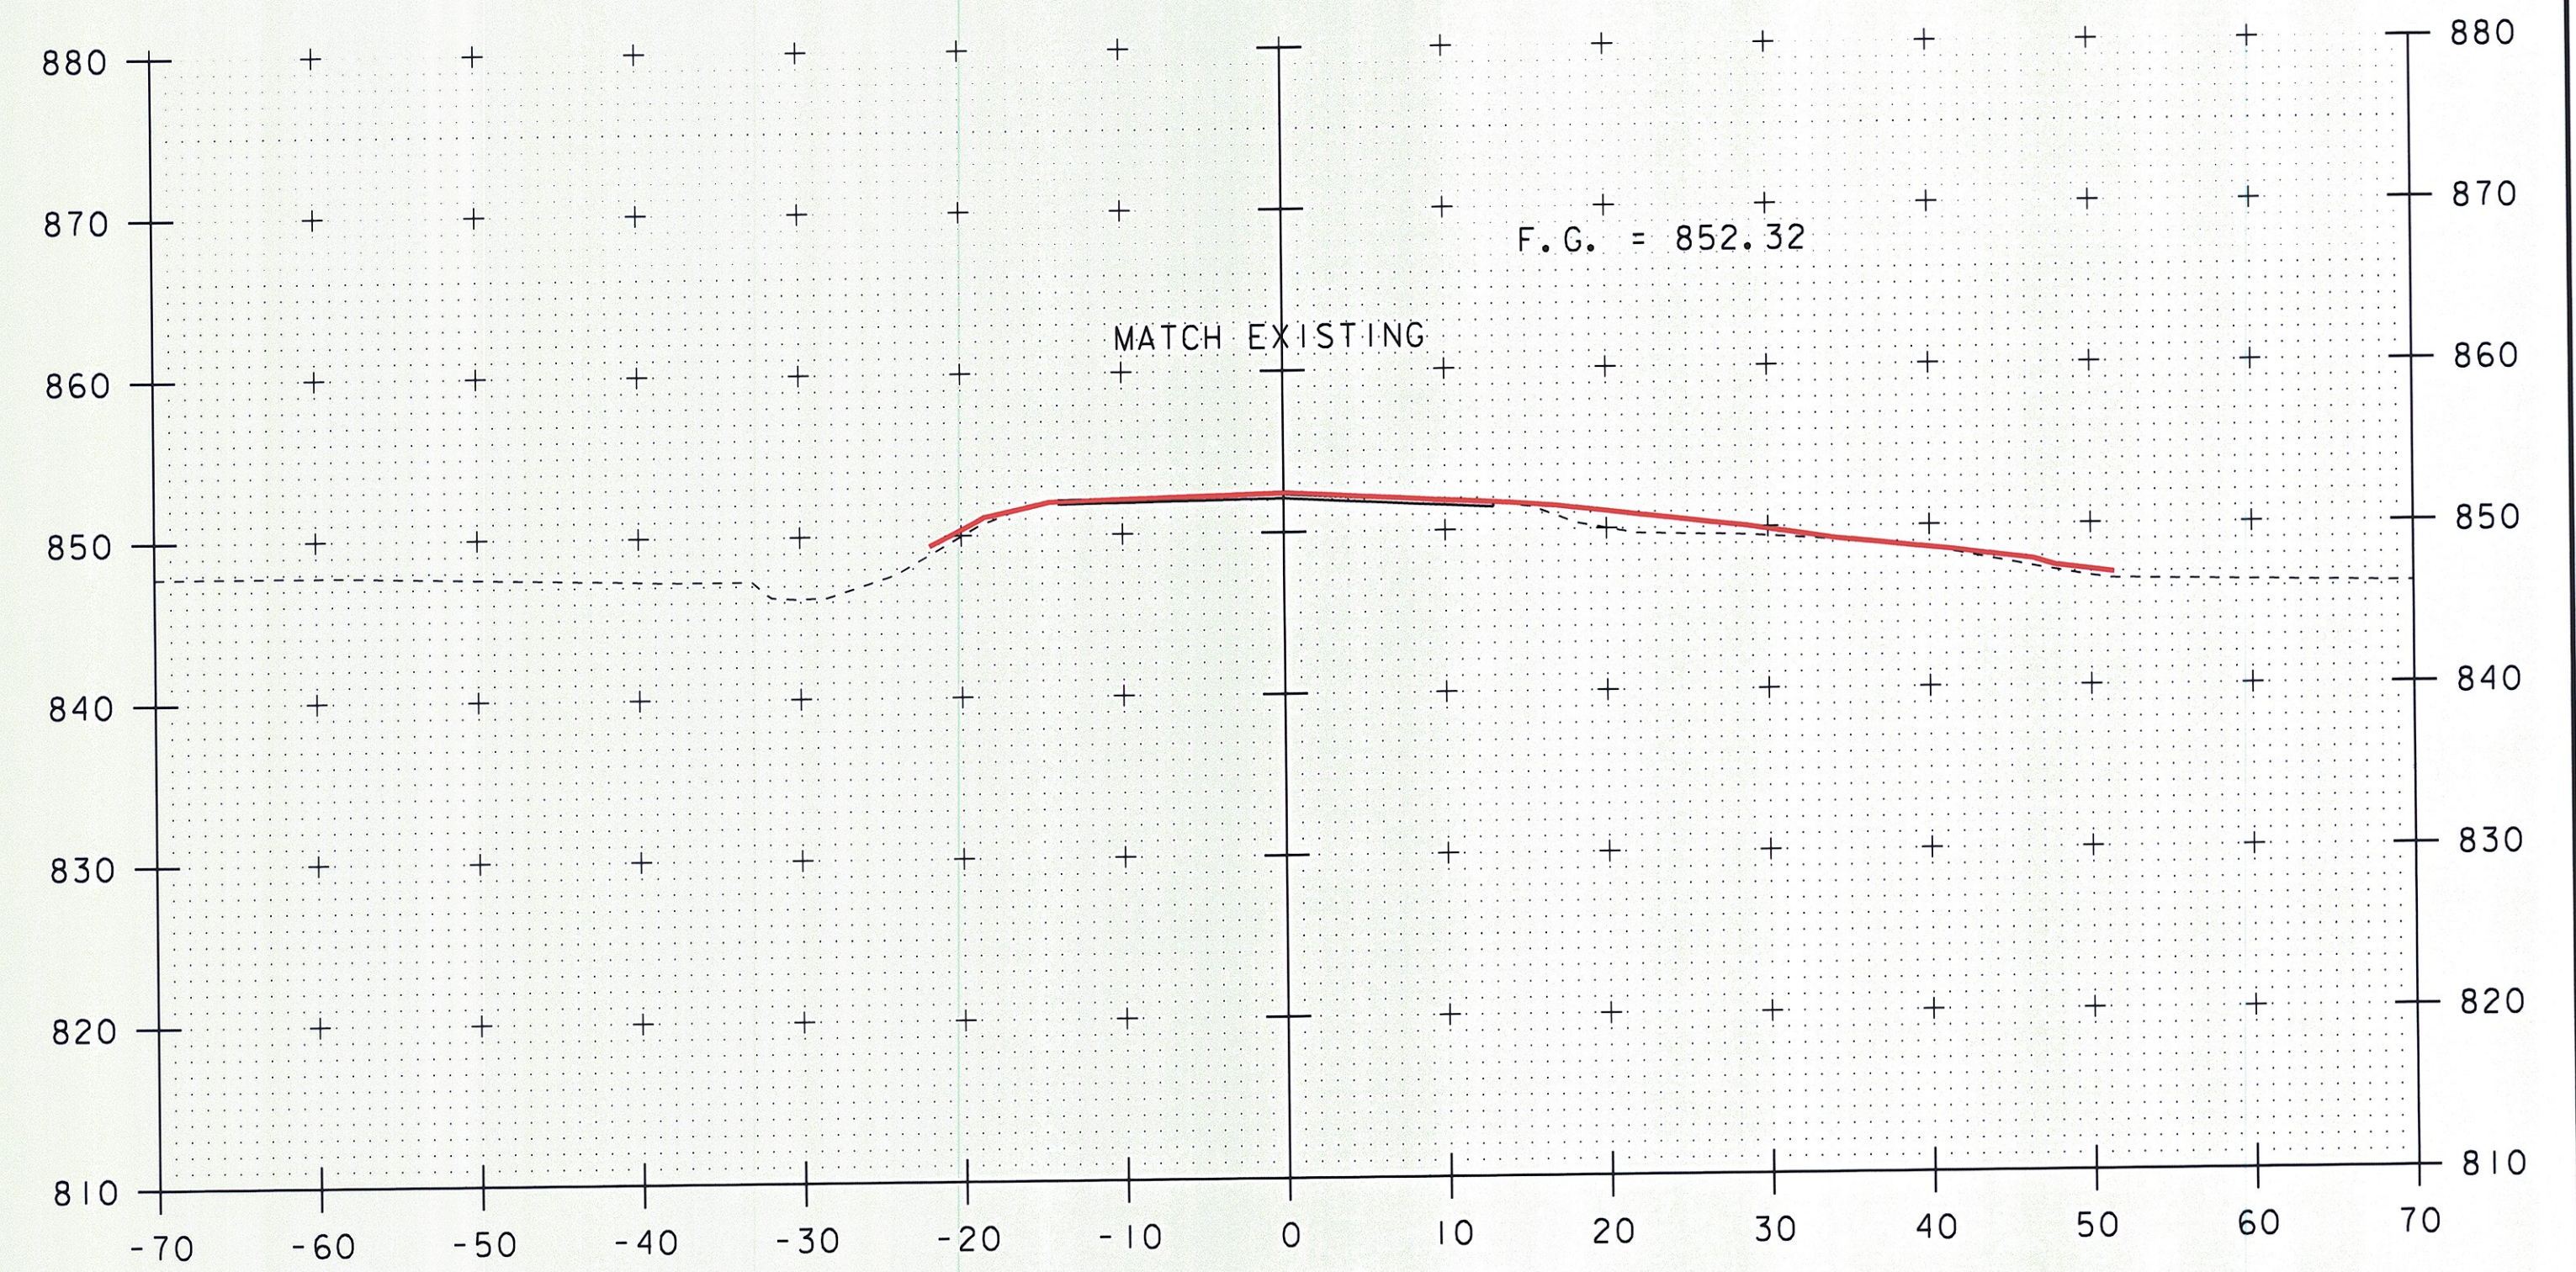

END APPROACH  
113+00

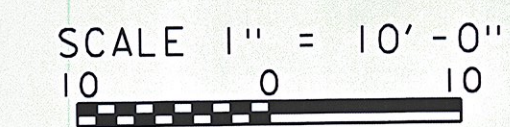

STA. 112+50 TO STA. 113+25

PROJECT NAME: BRIDGEWATER  
PROJECT NUMBER: BRS 0149(4)

FILE NAME: s86e062xs.dgn  
PROJECT LEADER: K. HIGGINS  
DESIGNED BY: T. FILLBACH  
MAINLINE SECTIONS #6

PLOT DATE: 08-NOV-2012 07:  
DRAWN BY: J. SALVATORI  
CHECKED BY: T. FILLBACH  
SHEET 6 OF 10