
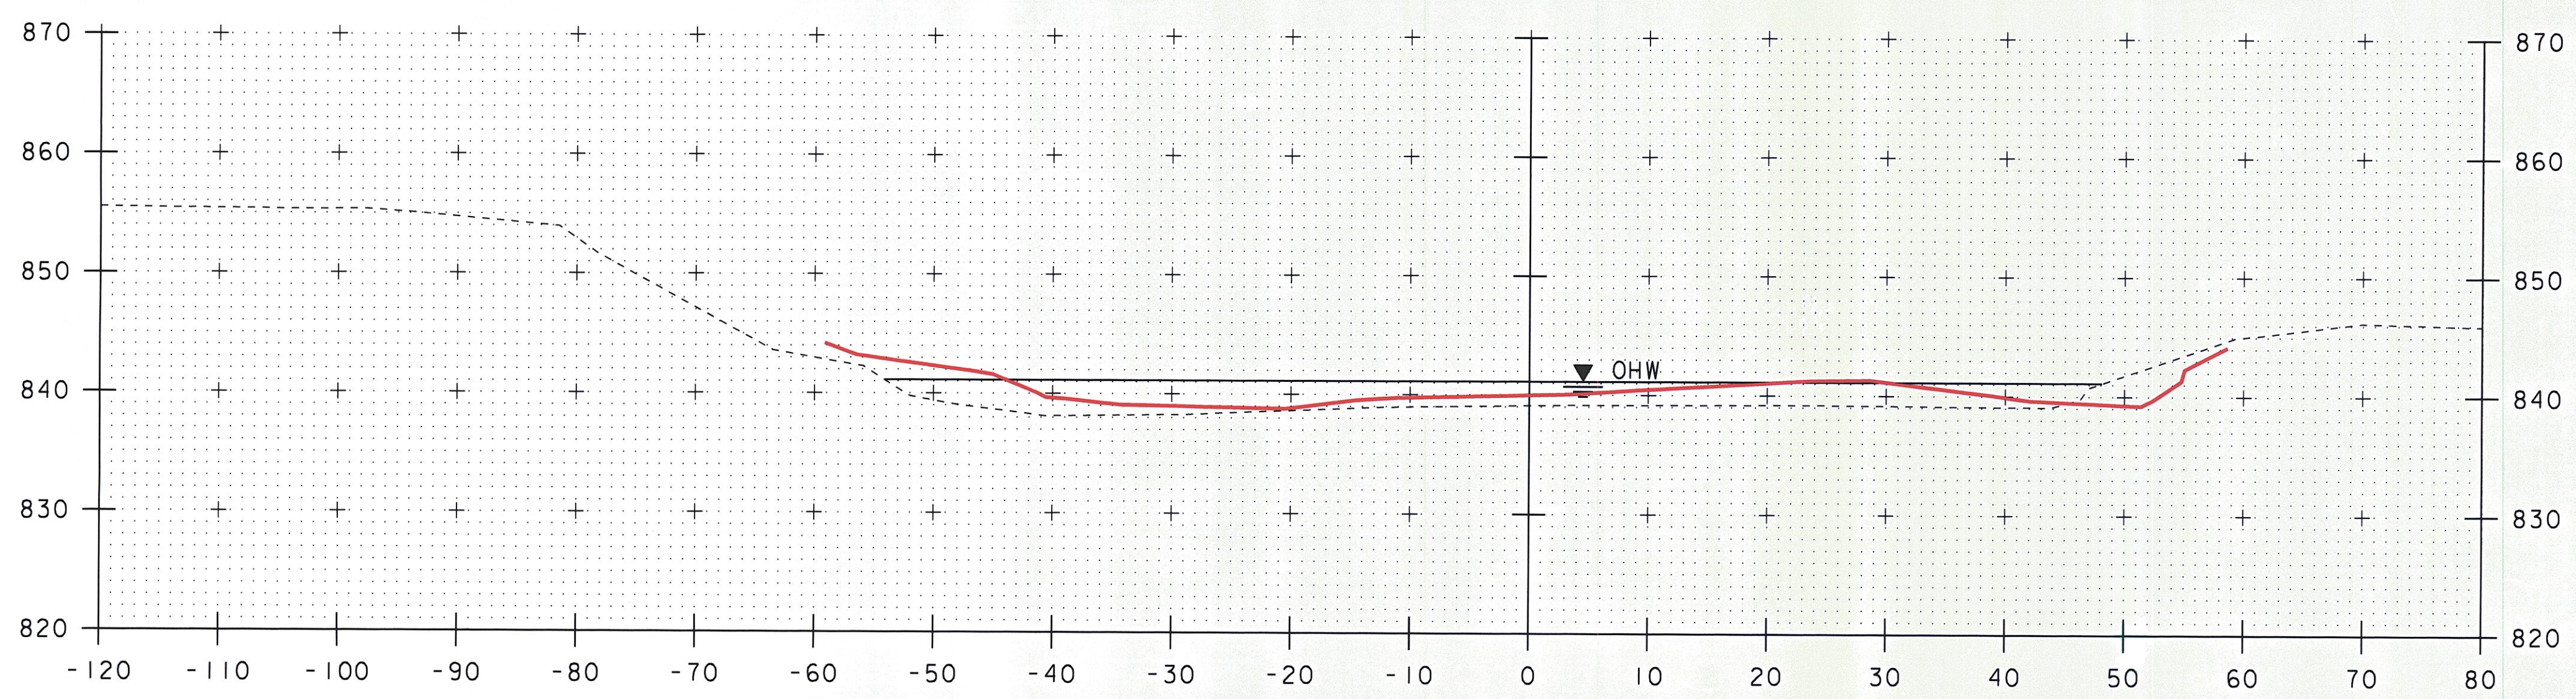


3+25

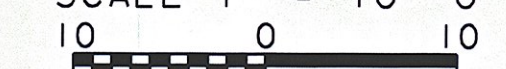

3+00

SCALE 1" = 10'-0"  


STA. 3+00 TO STA. 3+25

PROJECT NAME: BRIDGEWATER	PLOT DATE: 08-NOV-2012 07:4
PROJECT NUMBER: BRS 0149(4)	DRAWN BY: J. SALVATORI
FILE NAME: s86e062xs.dgn	CHECKED BY: T. FILLBACH
PROJECT LEADER: K. HIGGINS	SHEET 7 OF 10
DESIGNED BY: T. FILLBACH	
CHANNEL SECTIONS #1	