



3+75

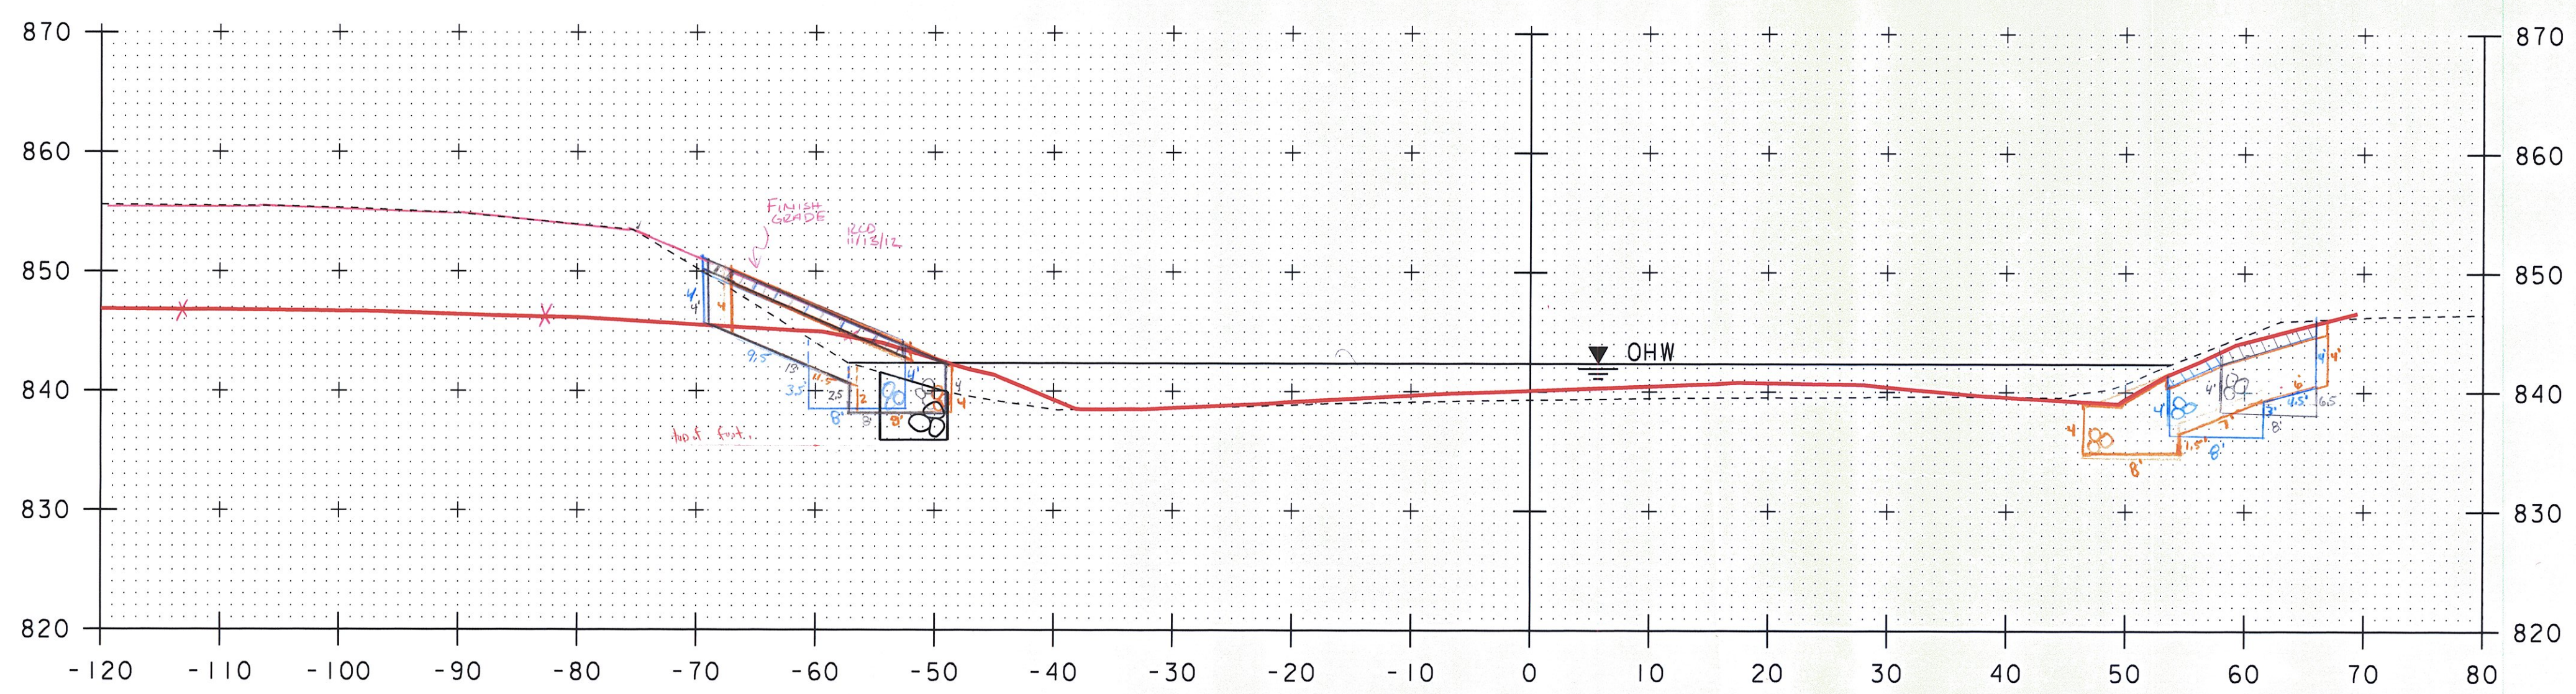

3+50

78.5  
 3+82 LT  
 STOP GRUBBING MATERIAL  
 3+78.5 LT  
 3+80 RT  
 3+89 RT  
 3+90 RT  
 STOP GRUBBING MATERIAL  
 3+76 RT CONCRETE EXCAVATION fore. Limits ✓  
 3+76 LT CONCRETE EXCAVATION fore. Limits ✓  
 RCD 12/10/12  
 1/10/13

3+47 LT ✓  
 BEGIN UNCLASSIFIED CHANNEL EXCAVATION,  
 STONE FILL, TYPE IV  
 GEOTEXTILE UNDER STONE FILL  
 GRUBBING MATERIAL  
 3+54 RT ✓  
 BEGIN UNCLASSIFIED CHANNEL EXCAVATION,  
 STONE FILL, TYPE IV  
 GEOTEXTILE UNDER STONE FILL  
 GRUBBING MATERIAL  
 3+50 RT  
 3+53 RT  
 3+64 RT & LT  
 3+68 LT  
 3+48 LT  
 3+47 LT  
 RCD 12/10/12  
 1/10/13

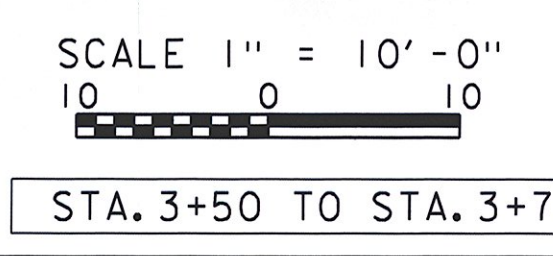

STA. 3+50 TO STA. 3+75

PROJECT NAME:	BRIDGEWATER	PLOT DATE:	08-NOV-2012 08:24
PROJECT NUMBER:	BRS 0149(4)	DRAWN BY:	J. SALVATORI
FILE NAME:	s86e062xs.dgn	CHECKED BY:	T. FILLBACH
PROJECT LEADER:	K. HIGGINS	SHEET	8 OF 10
DESIGNED BY:	T. FILLBACH		
CHANNEL SECTIONS #2			