



4+25

43
 4+29 RT
 STOP UNCLASSIFIED CHANNEL EXCAVATION,
 STONE FILL, TYPE IV
 GEOTEXTILE UNDER STONE FILL
 GRUBBING MATERIAL
 29
 4+40 LT
 STOP UNCLASSIFIED CHANNEL EXCAVATION,
 STONE FILL, TYPE IV
 GEOTEXTILE UNDER STONE FILL
 GRUBBING MATERIAL
 4+22 LT
 4+29 LT
 RCD ✓MSD
 12/12/12 ✓3/13

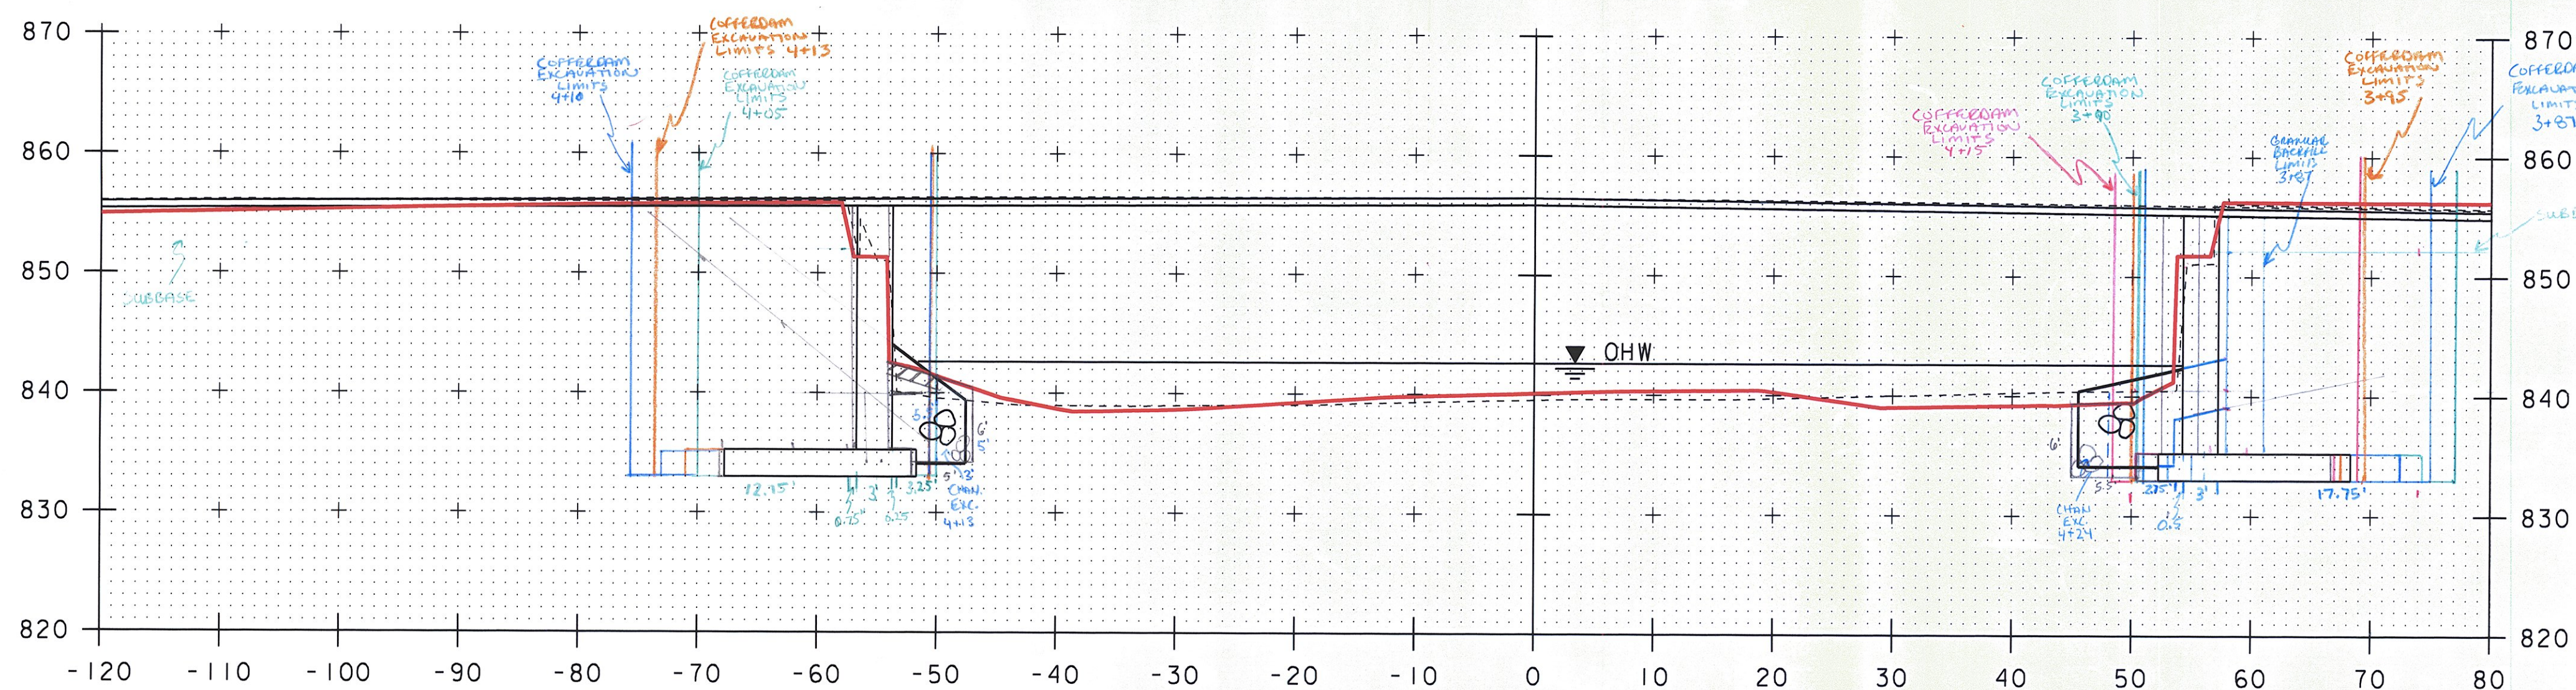

4+00

3+90 RT
 STOP GRUBBING MATERIAL
 11.5
 4+10 LT
 RESUME GRUBBING MATERIAL
 21
 4+18 RT
 RESUME GRUBBING MATERIAL
 NO GRUBBING MATERIAL
 BENEATH NEW BRIDGE
 4+11.5 LT
 4+21 RT
 RCD ✓MSD
 12/12/12 ✓3/13

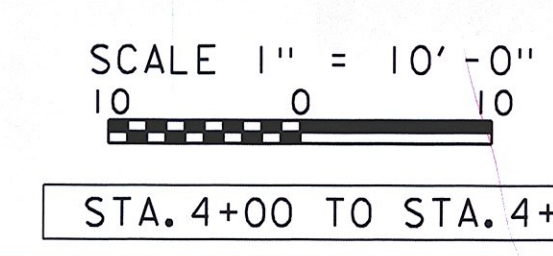

STA. 4+00 TO STA. 4+25

PROJECT NAME:	BRIDGEWATER	PLOT DATE:	08-NOV-2012 08:1
PROJECT NUMBER:	BRS 0149(4)	DRAWN BY:	J. SALVATORI
FILE NAME:	s86e062xs.dgn	CHECKED BY:	T. FILLBACH
PROJECT LEADER:	K. HIGGINS	SHEET	9 OF 10
DESIGNED BY:	T. FILLBACH		
CHANNEL SECTIONS #3			