



4+75

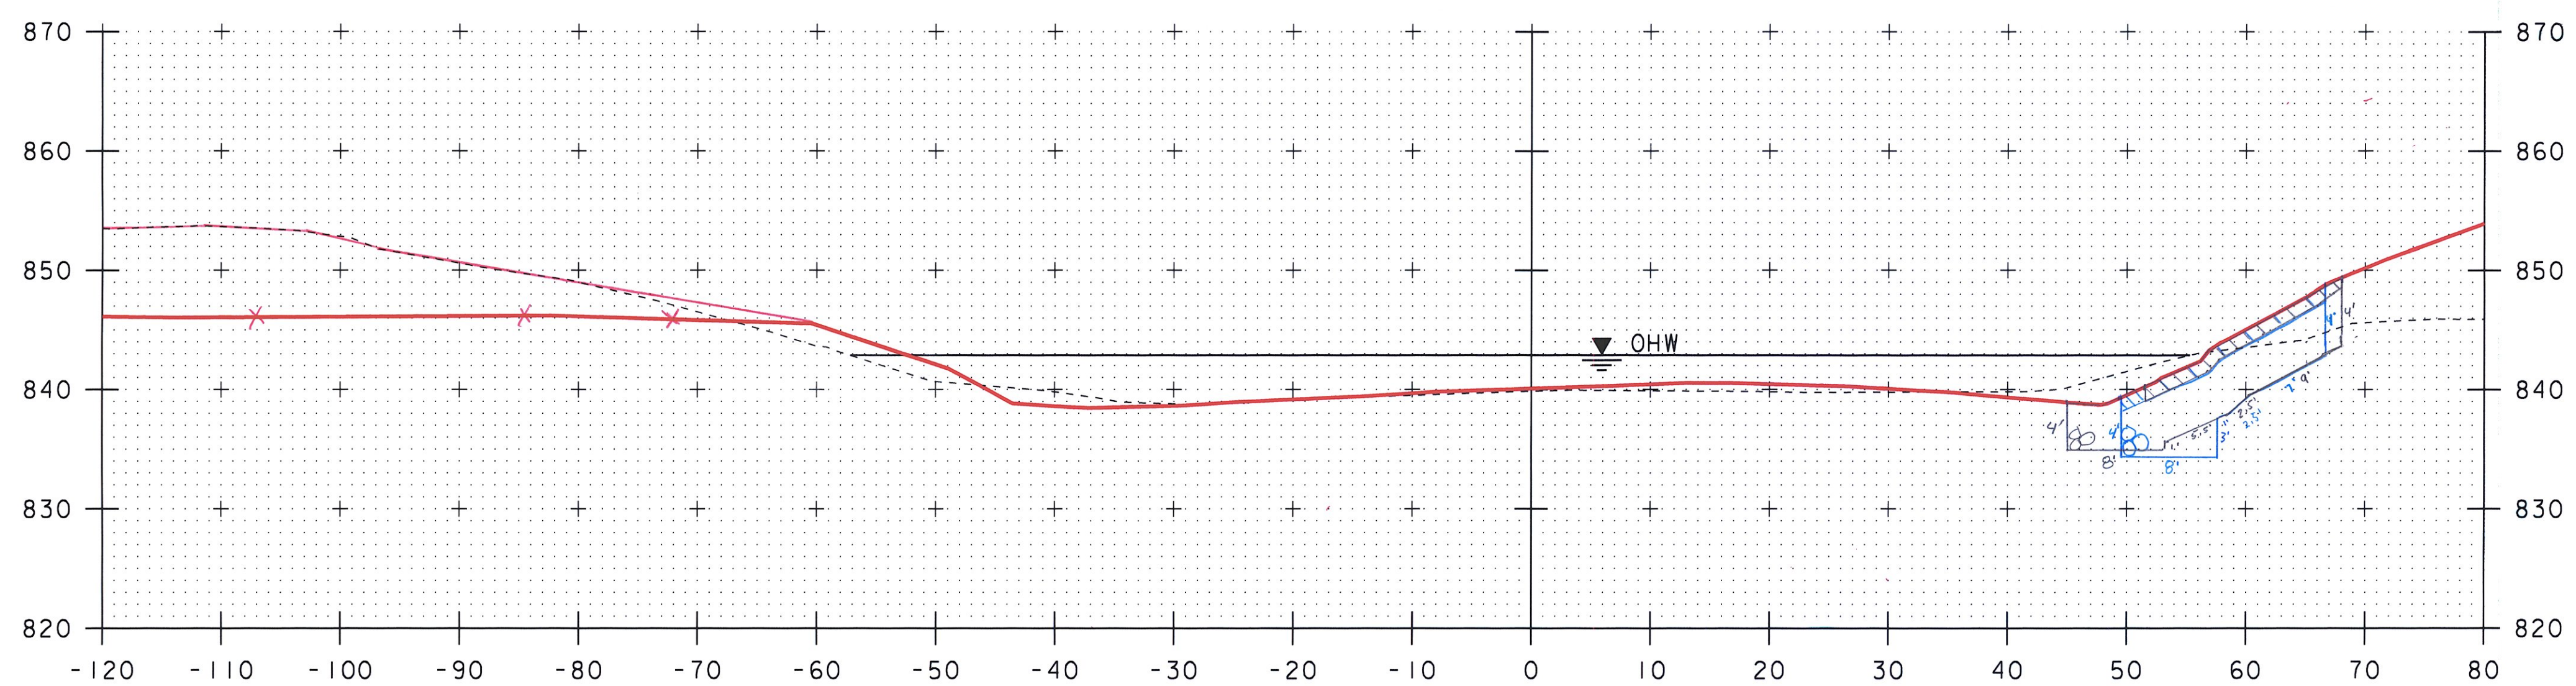

4+50

4+30 RT } MATCH  
 4+35 RT }  
 4+43 RT }  
 RCD  
 12/13/12  
 NAD  
 1/3/13

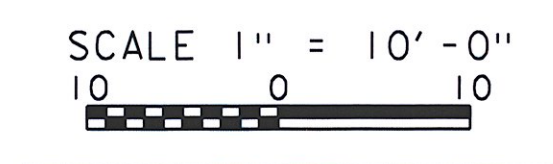

STA. 4+50 TO STA. 4+75

PROJECT NAME: BRIDGEWATER	PLOT DATE: 08-NOV-2012 08:5
PROJECT NUMBER: BRS 0149(4)	DRAWN BY: J. SALVATORI
FILE NAME: s86e062xs.dgn	DESIGNED BY: T. FILLBACH
CHANNEL SECTIONS #4	CHECKED BY: T. FILLBACH
	SHEET 10 OF 10