


STATE OF VERMONT AGENCY OF TRANSPORTATION



PROPOSED IMPROVEMENT

TOWN OF FAIRFAX COUNTY OF FRANKLIN VT. RTE. 104 MINOR ARTERIAL BRIDGE NO. 10


SEE SHEET 2 FOR INDEX OF SHEETS

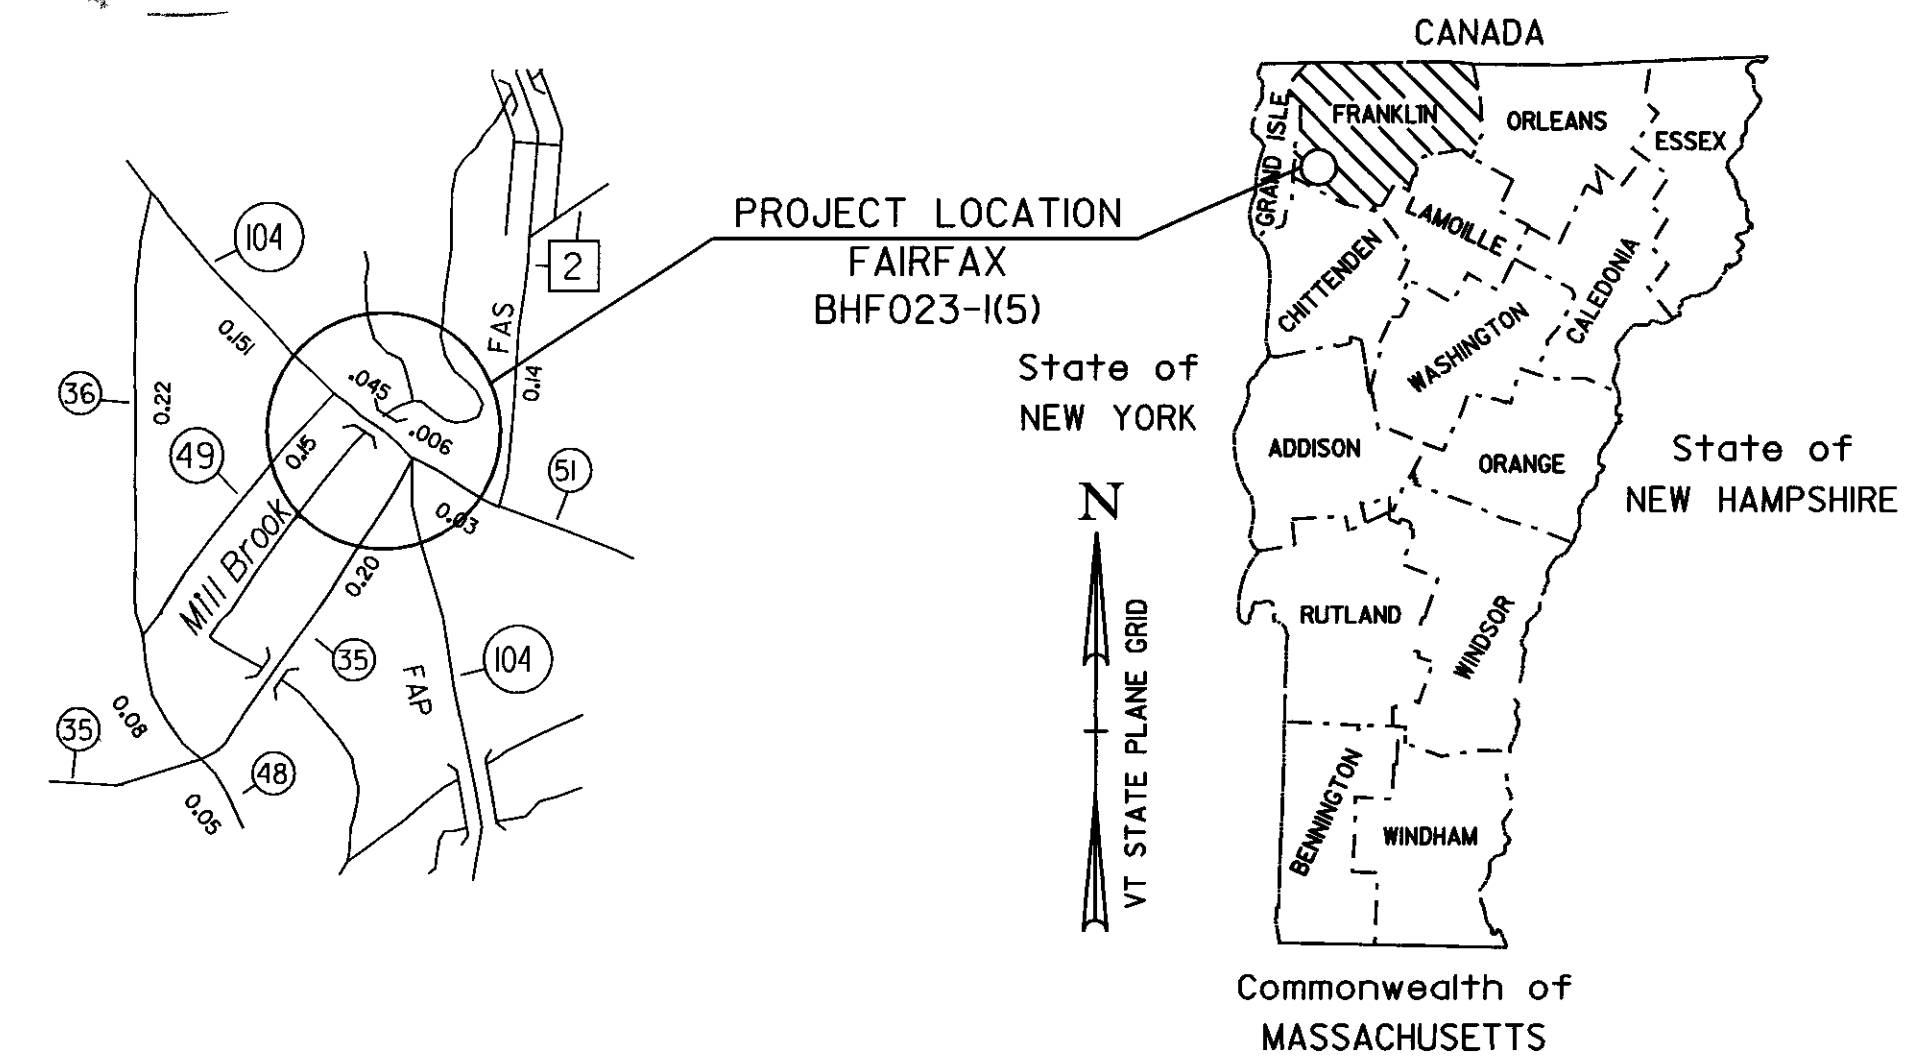

PROJECT LOCATION : BEGINNING ON VT. 104 APPROXIMATELY 0.80 MILES NORTHWESTERLY OF THE INTERSECTION OF VT 104 AND VT 128 AND EXTENDING SOUTH EASTERLY 0.038 MILES.

PROJECT DESCRIPTION : THE REHABILITATION OF EXISTING BRIDGE #10 OVER THE MILL BROOK TO INCLUDE THE SUPERSTRUCTURE ALONG WITH RELATED SUBSTRUCTURE REPAIR AND APPROACH ROADWAY WORK.

LENGTH OF STRUCTURE : 33.83 FEET
LENGTH OF ROADWAY : 166.17 FEET
LENGTH OF PROJECT : 200.00 FEET

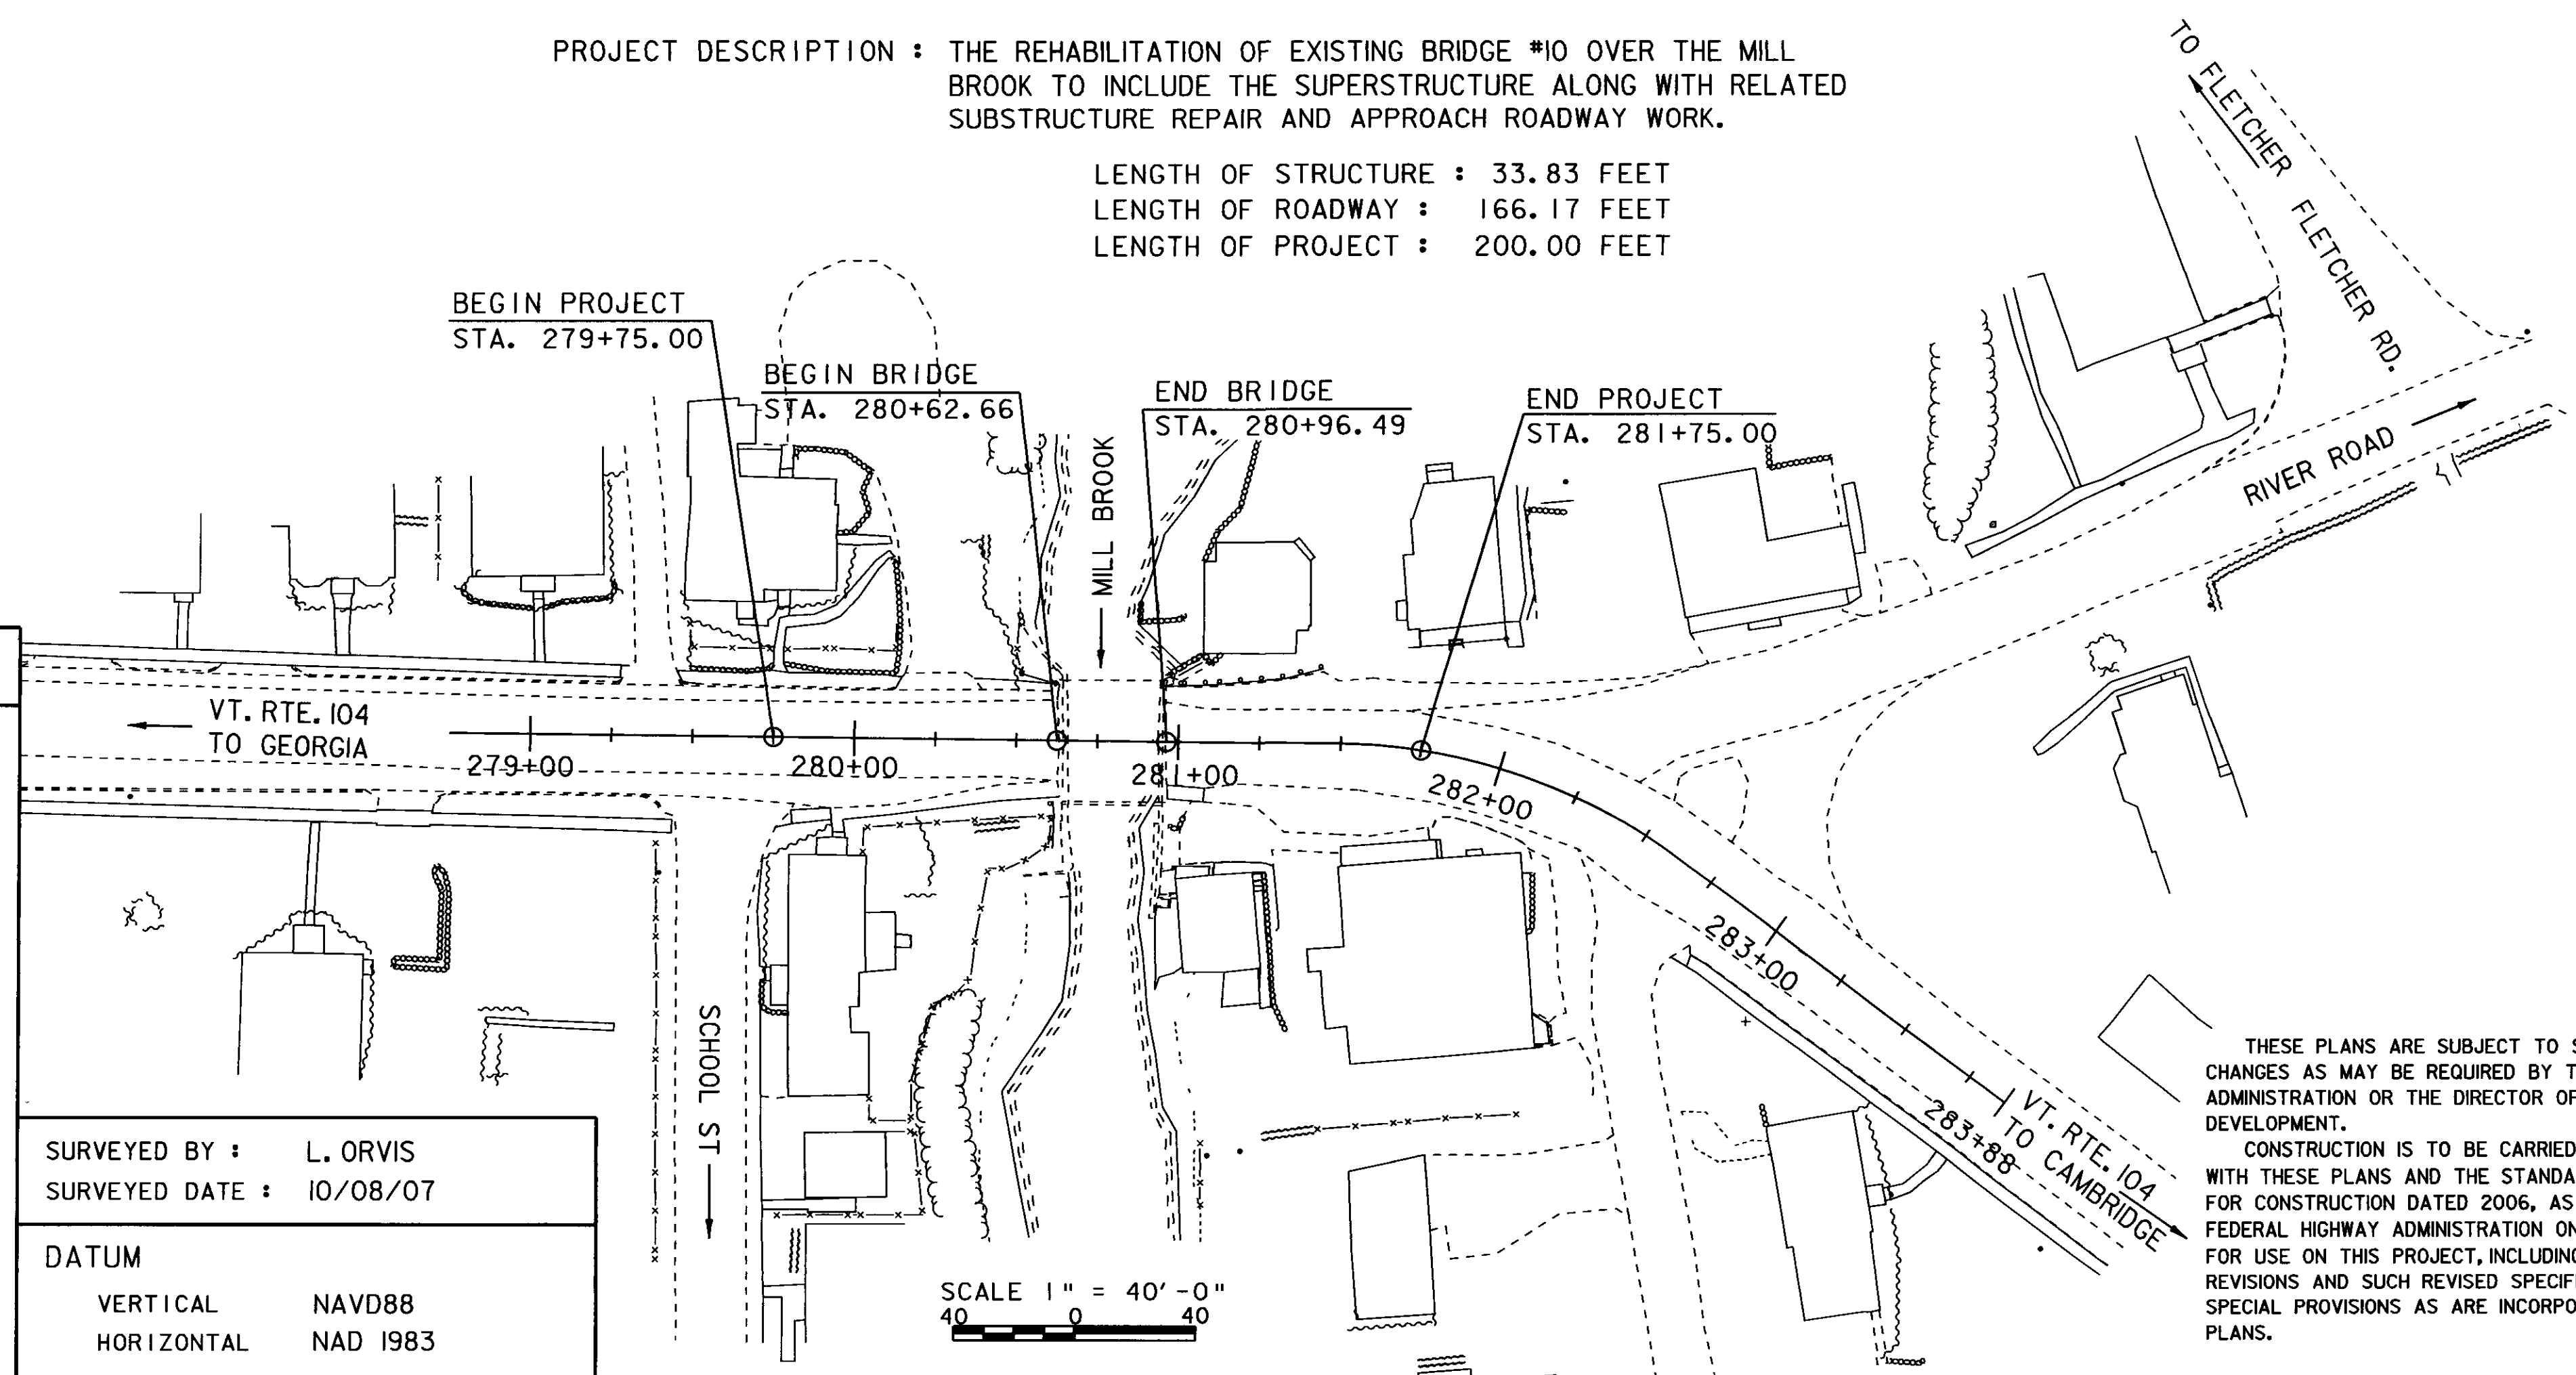


CONVENTIONAL SYMBOLS

COUNTY LINE	
TOWN LINE	
LIMITS OF ACCESS	
POINT OF ACCESS	
FENCE LINE	
STONE WALL	
TRAVELED WAY	
GUARD RAIL	
RAILROAD	
SURVEY LINE	
CULVERT	
POWER POLE	
TELEPHONE POLE	
TREES	
CONTROL OF ACCESS	
PROPERTY LINE	
R.O.W. TAKING LINE	
SLOPE RIGHTS	
TOP OF CUT	
TOE OF SLOPE	

SURVEYED BY : L. ORVIS
SURVEYED DATE : 10/08/07

DATUM
VERTICAL NAVD88
HORIZONTAL NAD 1983

SCALE 1" = 40'-0"
40 0 40

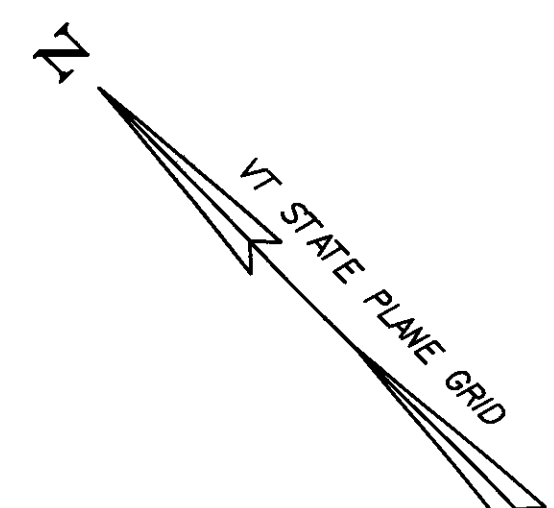

RECORD PLANS

CONTRACTOR	BLOW & COTE INC - MORRISVILLE, VT
RESIDENT ENGINEER	GREG WILCOX
CONSTRUCTION BEGAN	OCTOBER 5, 2009
CONSTRUCTION COMPLETE	SEPTEMBER 10, 2010
RECORD PLANS BY	GREG WILCOX & M. BIRCHARD
I HEREBY CERTIFY THAT ALL THE CONSTRUCTION REQUIRED BY THIS SET OF DRAWINGS HAS BEEN ACCOMPLISHED AS INDICATED HEREIN	
BY	RESIDENT ENGINEER
DATE	3/3/2011
NOTE Any further information concerning final quantities, amounts or other details relative to this project may be found at Central Files in the electronic archives	

THESE PLANS ARE SUBJECT TO SUCH ENGINEERING CHANGES AS MAY BE REQUIRED BY THE FEDERAL HIGHWAY ADMINISTRATION OR THE DIRECTOR OF PROGRAM DEVELOPMENT.

CONSTRUCTION IS TO BE CARRIED ON IN ACCORDANCE WITH THESE PLANS AND THE STANDARD SPECIFICATIONS FOR CONSTRUCTION DATED 2006, AS APPROVED BY THE FEDERAL HIGHWAY ADMINISTRATION ON JUNE 15, 2006 FOR USE ON THIS PROJECT, INCLUDING ALL SUBSEQUENT REVISIONS AND SUCH REVISED SPECIFICATIONS AND SPECIAL PROVISIONS AS ARE INCORPORATED IN THESE PLANS.

DIRECTOR OF PROGRAM DEVELOPMENT		DATE 7-13-09
APPROVED		
PROJECT MANAGER :	C. CARLSON	
PROJECT NAME :	FAIRFAX	
PROJECT NUMBER :	BHF 023-1(5)	
SHEET 1 OF 61 SHEETS		