


VOIDED SLAB NO.	QUANTITY	(*X) DEPTH
UNIT 1	2	18"
UNIT 2	2	18"-19"
UNIT 3	2	19"-20"
UNIT 4	2	20"-21"
UNIT 5	1	21"

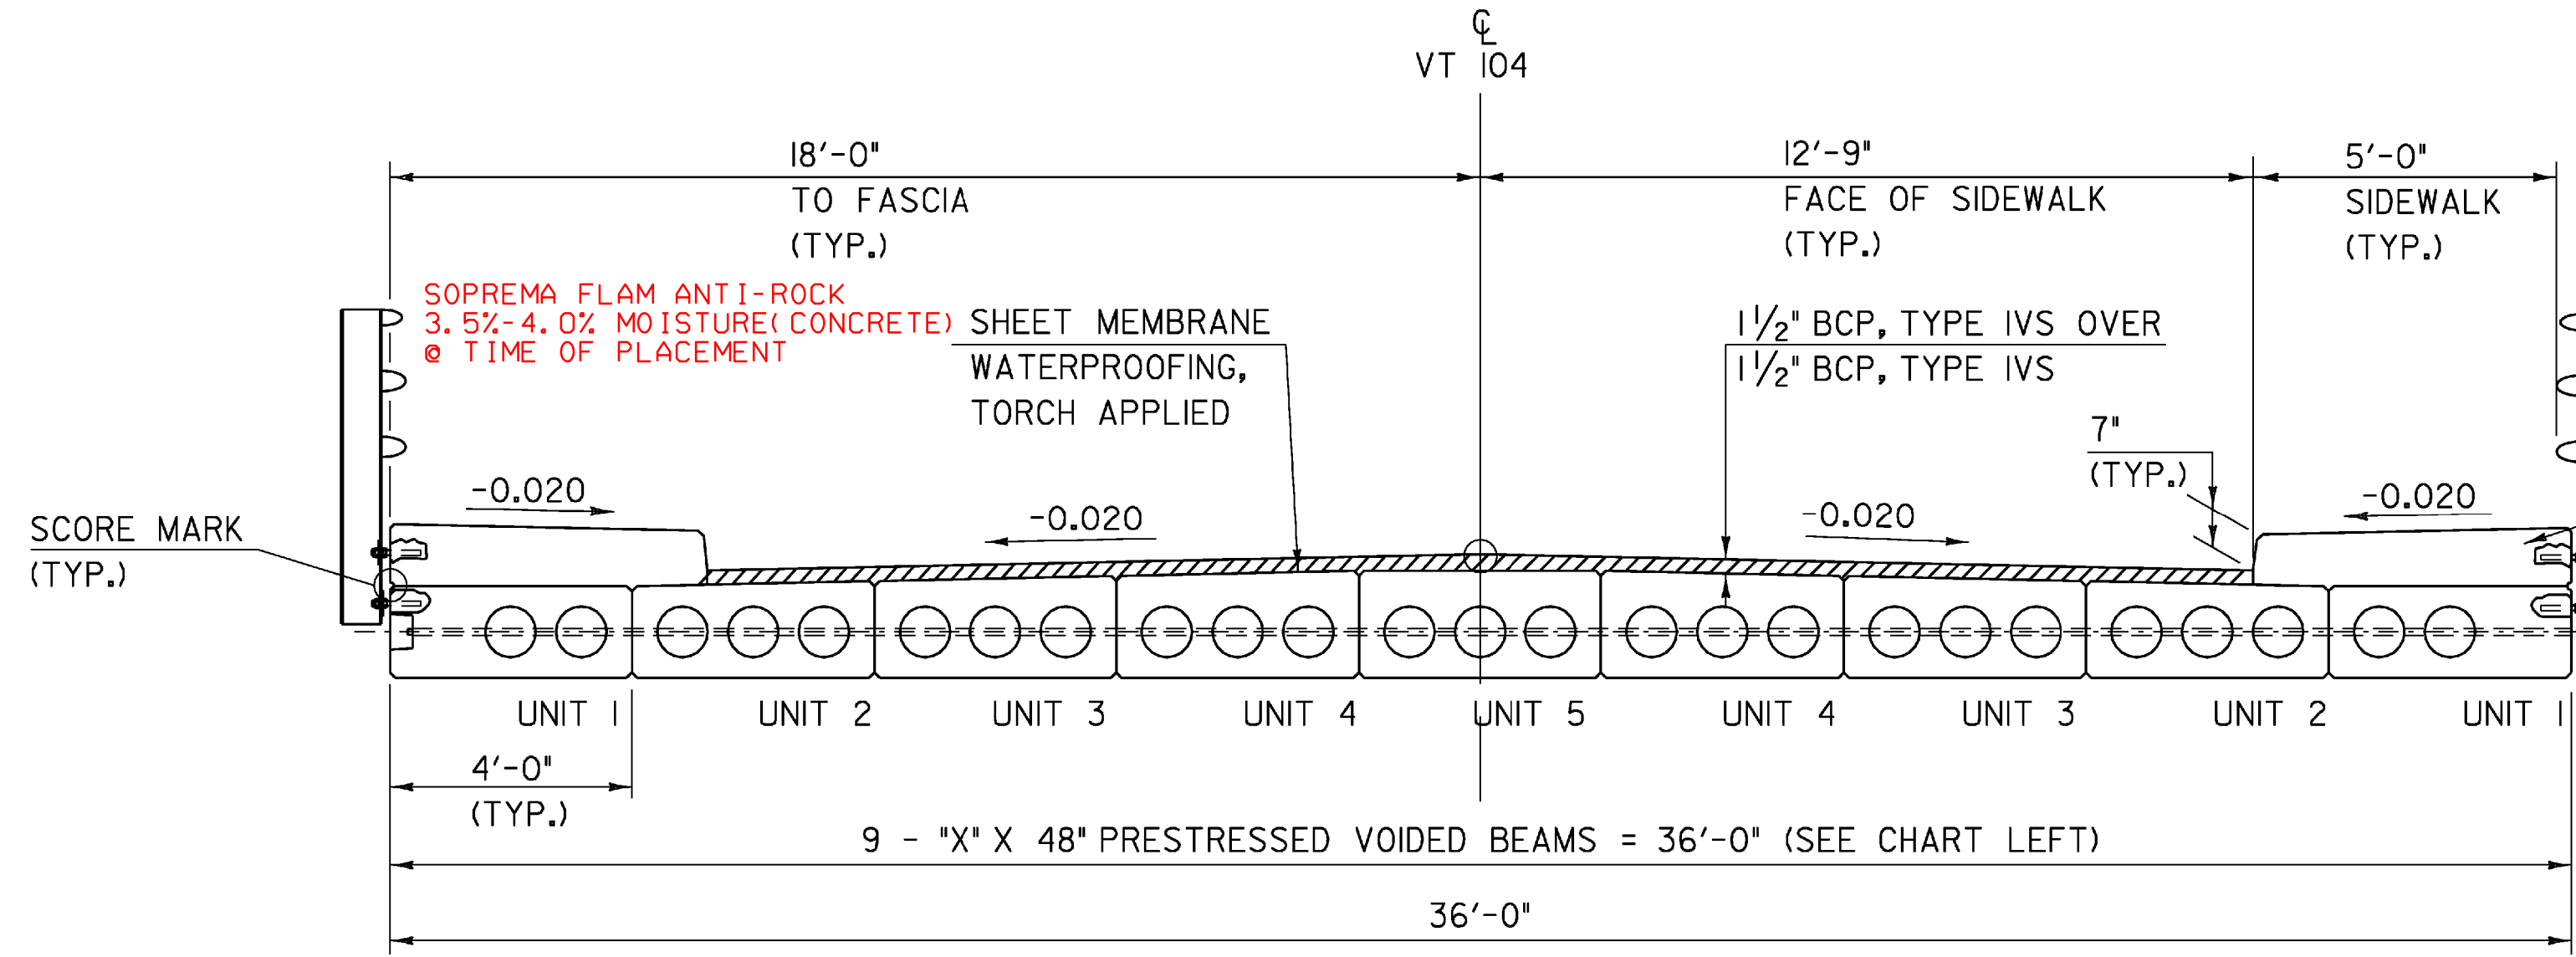

SPECIAL PROVISION (BRIDGE RAILING, ANODIZED ALUMINUM/PEDESTRIAN) (TYP.)


SPECIAL PROVISION (HIGH PERFORMANCE CONCRETE, CLASS A LOW CEMENT) (TYP.)

### BRIDGE TYPICAL

SCALE 3/8" = 1'-0"


\*BCP SHALL BE READ AS BITUMINOUS CONCRETE PAVEMENT AND SHALL BE PAID FOR UNDER PAY ITEM 900.680 "SPECIAL PROVISION (BITUMINOUS CONCRETE PAVEMENT, SMALL QUANTITY)".

MATERIAL ITEM	TOLERANCE
PAVEMENT	+/- 1/4" TOTAL THICKNESS
BASE COURSE	+/- 1/2"
SUBBASE	+/- 1"
SAND BORROW	+/- 1"

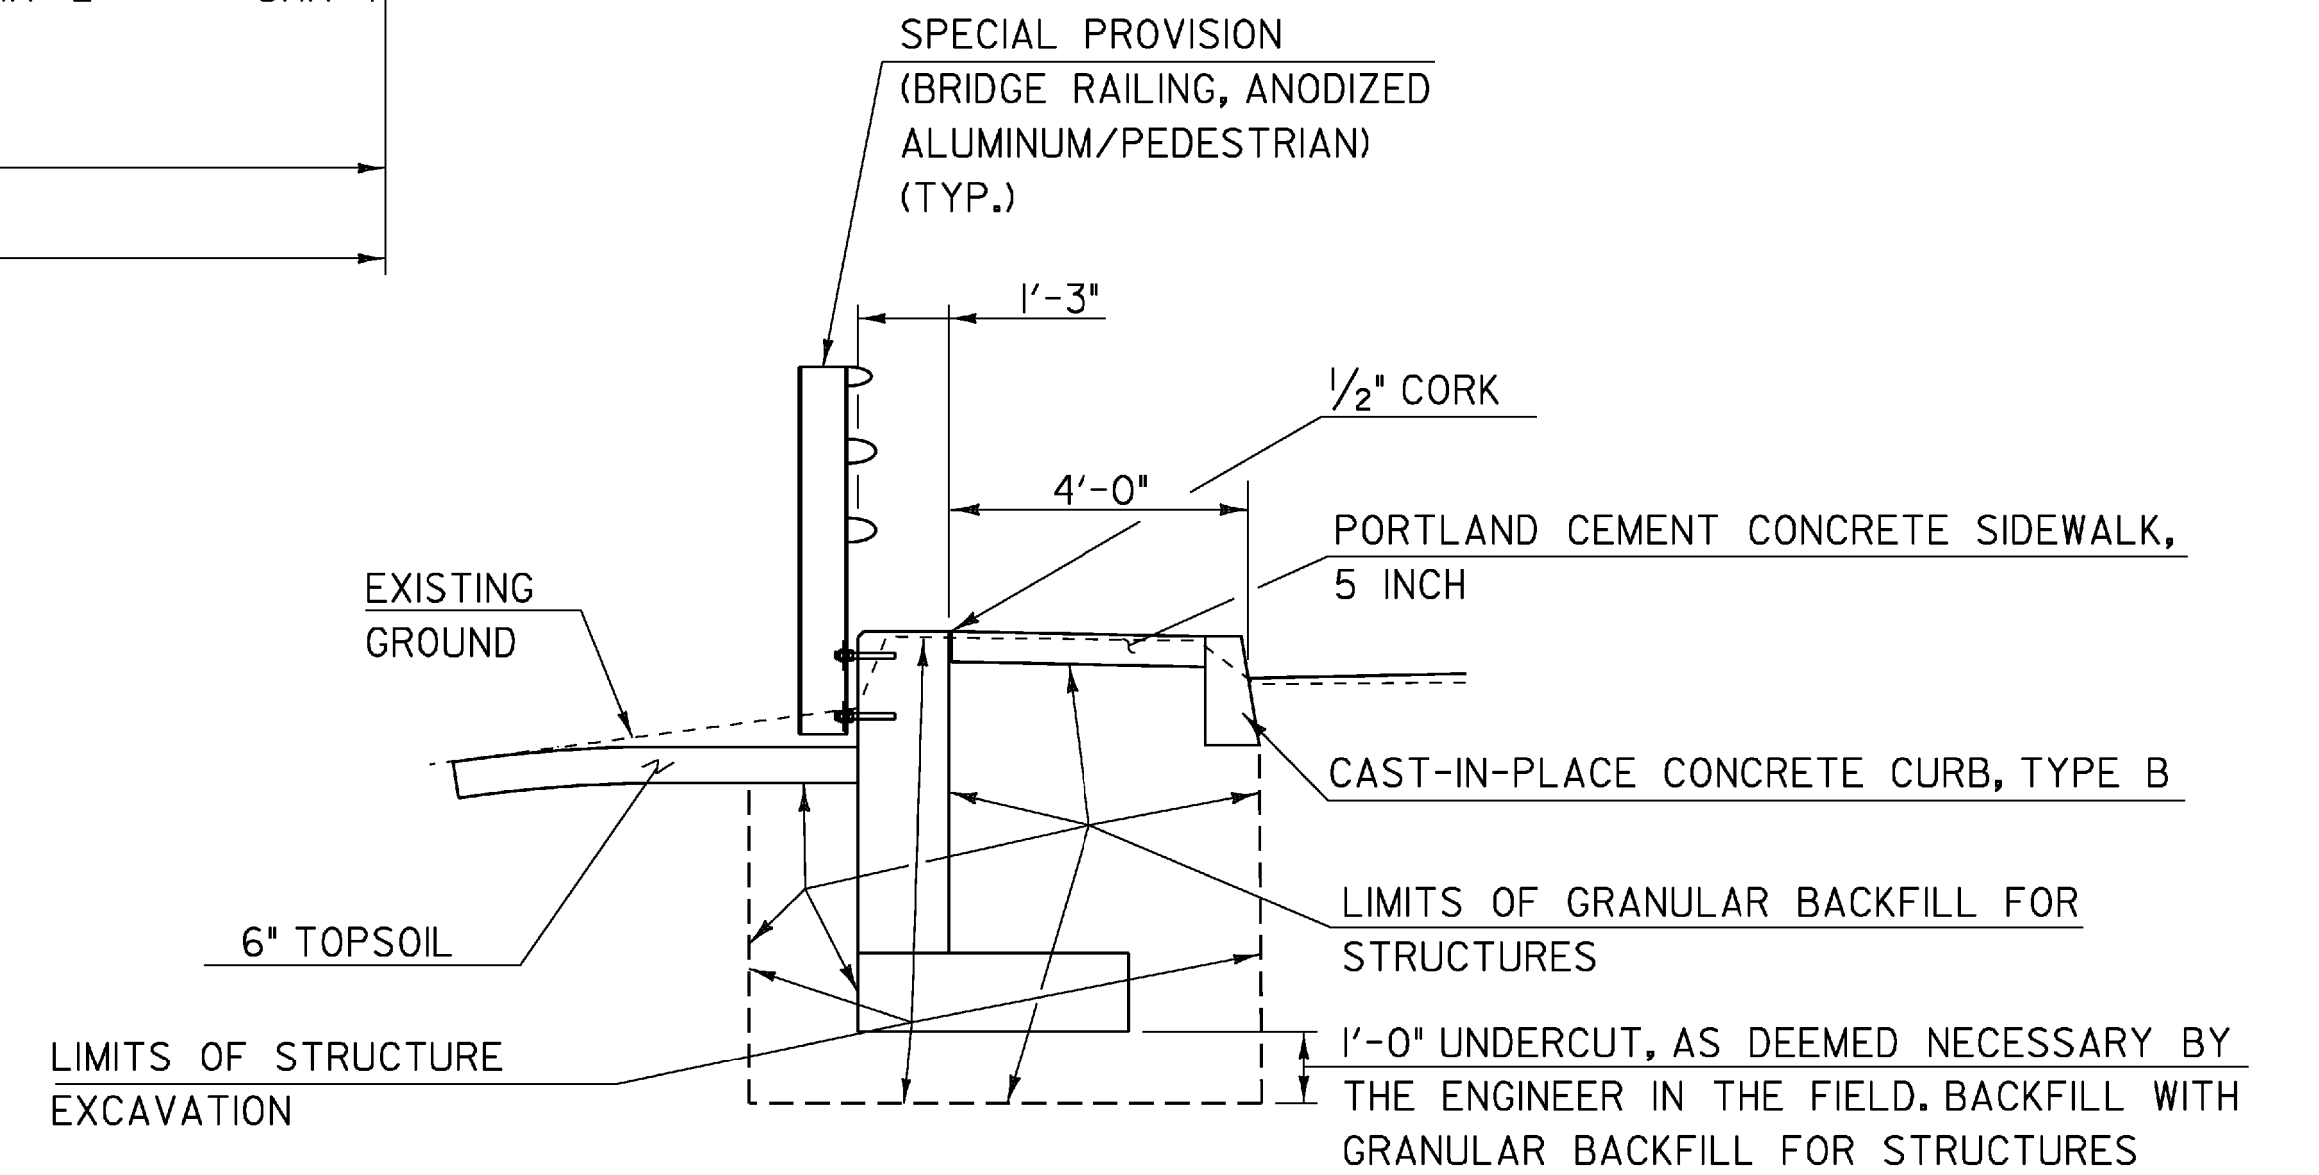

### WALL TYPICAL

STA. 280+96.49 LT - STA. 281+31.5 LT

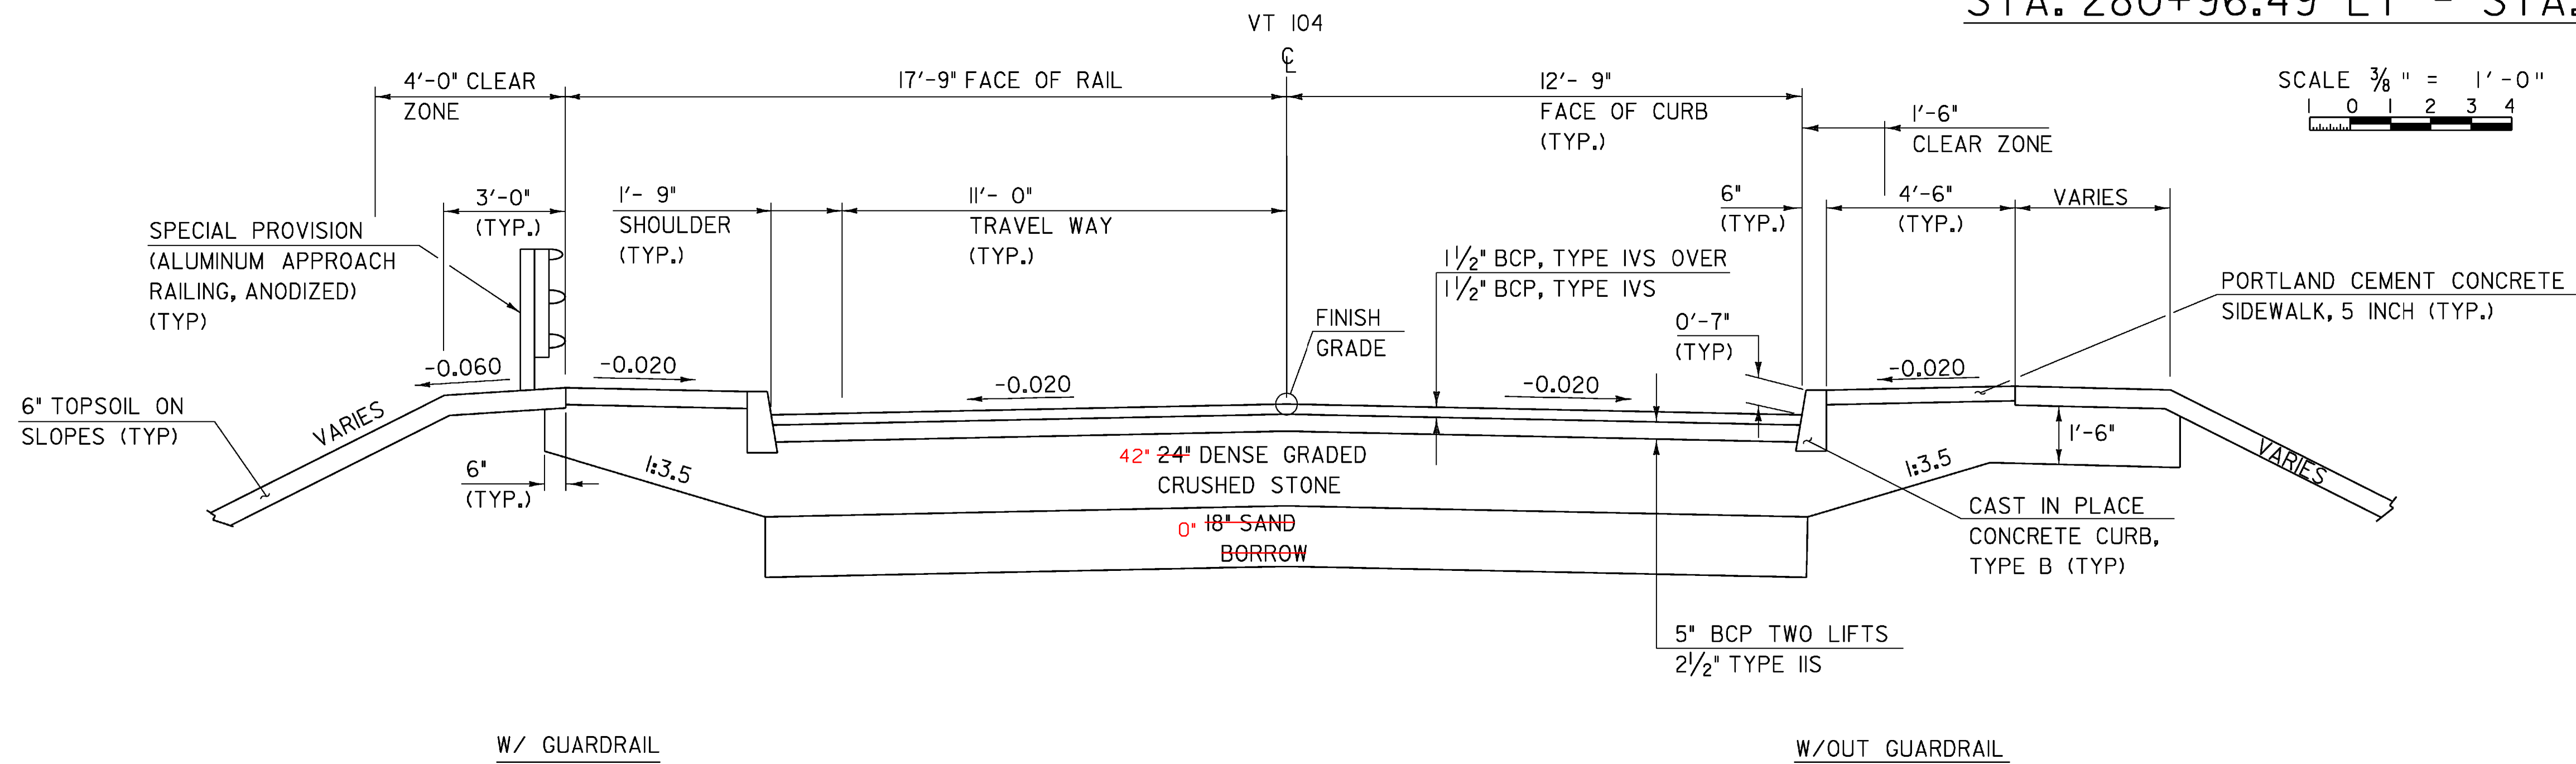

SCALE 3/8" = 1'-0"

### ROADWAY TYPICAL

SCALE 3/8" = 1'-0"

PROJECT NAME: FAIRFAX	PLOT DATE: 13-JUL-2009
PROJECT NUMBER: BHF 023-(K5)	DRAWN BY: STR3
FILE NAME: 86e064/str/se064+typ.dgn	CHECKED BY: C. CARLSON
DESIGNED BY: C. CARLSON	TYPICAL SHEET
	SHEET 9 OF 61