



VT104

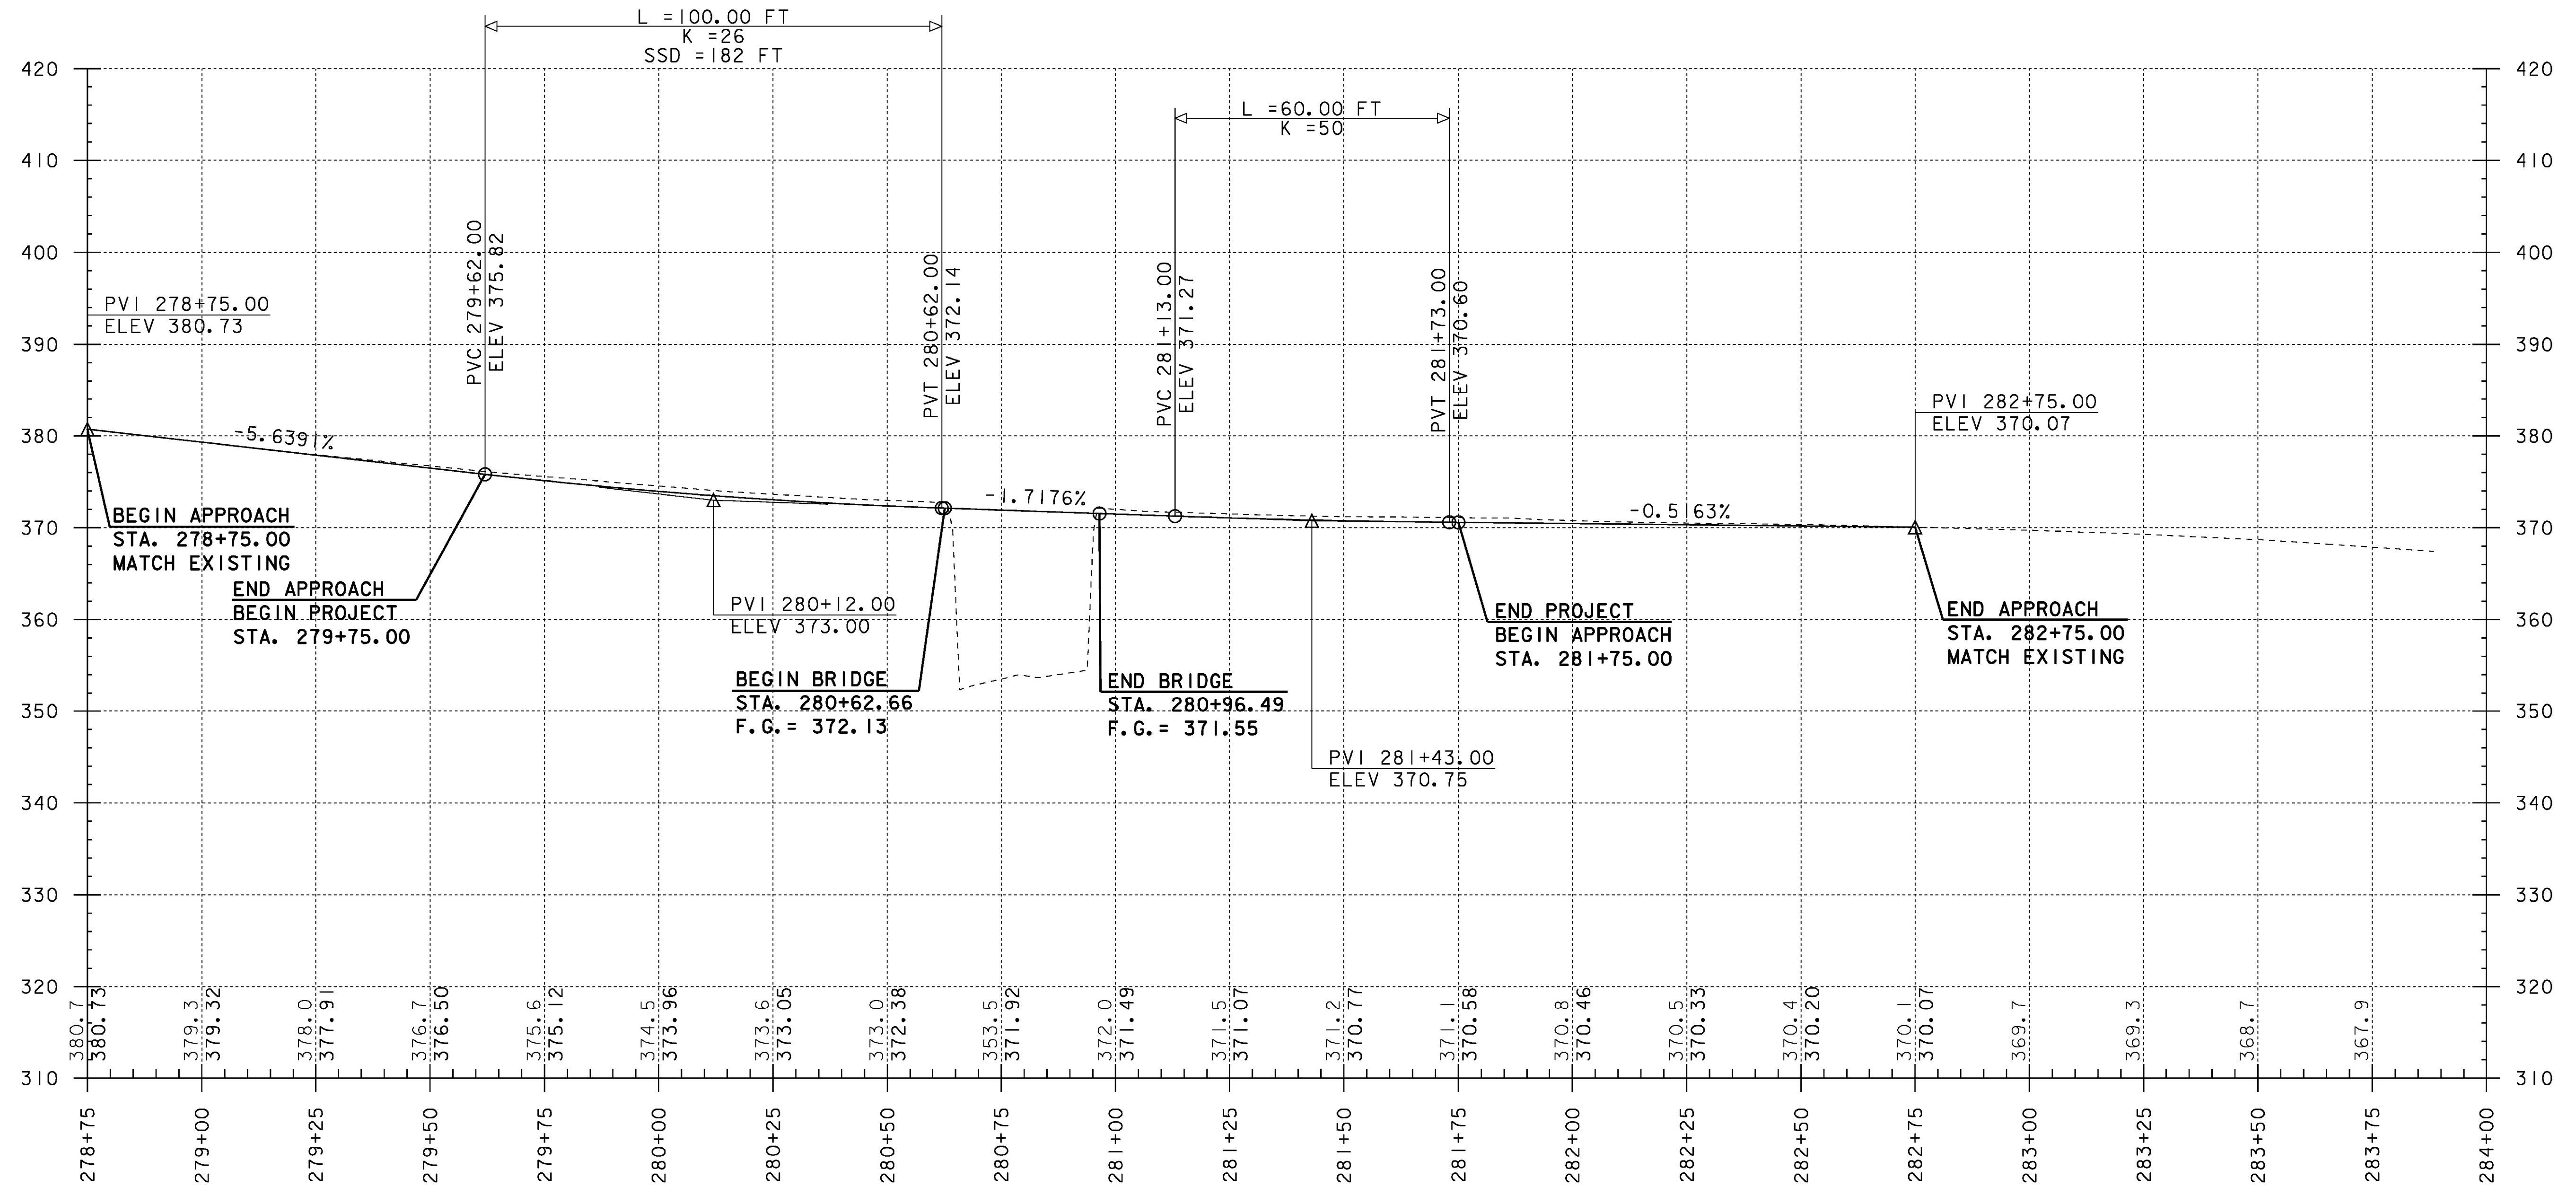

*FINAL ELEVATIONS OBTAINED WITH 3D SURVEY (LARRY ORVIS) *
ON FILE ON VTRANS SERVER

GRADES SHOWN TO THE NEAREST TENTH ARE
OLD GROUND ALONG THE PROPOSED ALIGNMENT.
GRADES SHOWN TO THE NEAREST HUNDREDTH ARE
FINISHED GRADES ALONG THE PROPOSED ALIGNMENT.

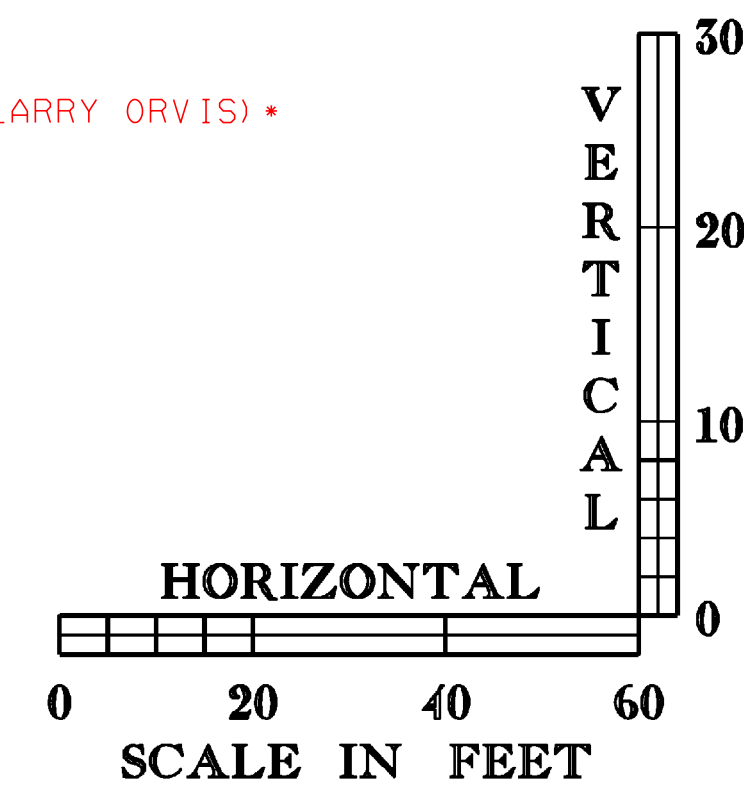

PROFILE SHEET

| | |
|-------------------------------------|------------------------|
| PROJECT NAME: FAIRFAX | PLOT DATE: 13-JUL-2009 |
| PROJECT NUMBER: BHF 023-(15) | DRAWN BY: L. BULLOCK |
| FILE NAME: /86e064/str/se064xs2.dgn | CHECKED BY: C. CARLSON |
| PROJECT LEADER: C. CARLSON | SHEET 13 OF 61 |
| DESIGNED BY: C. CARLSON | |
| se064pr1.l | |