
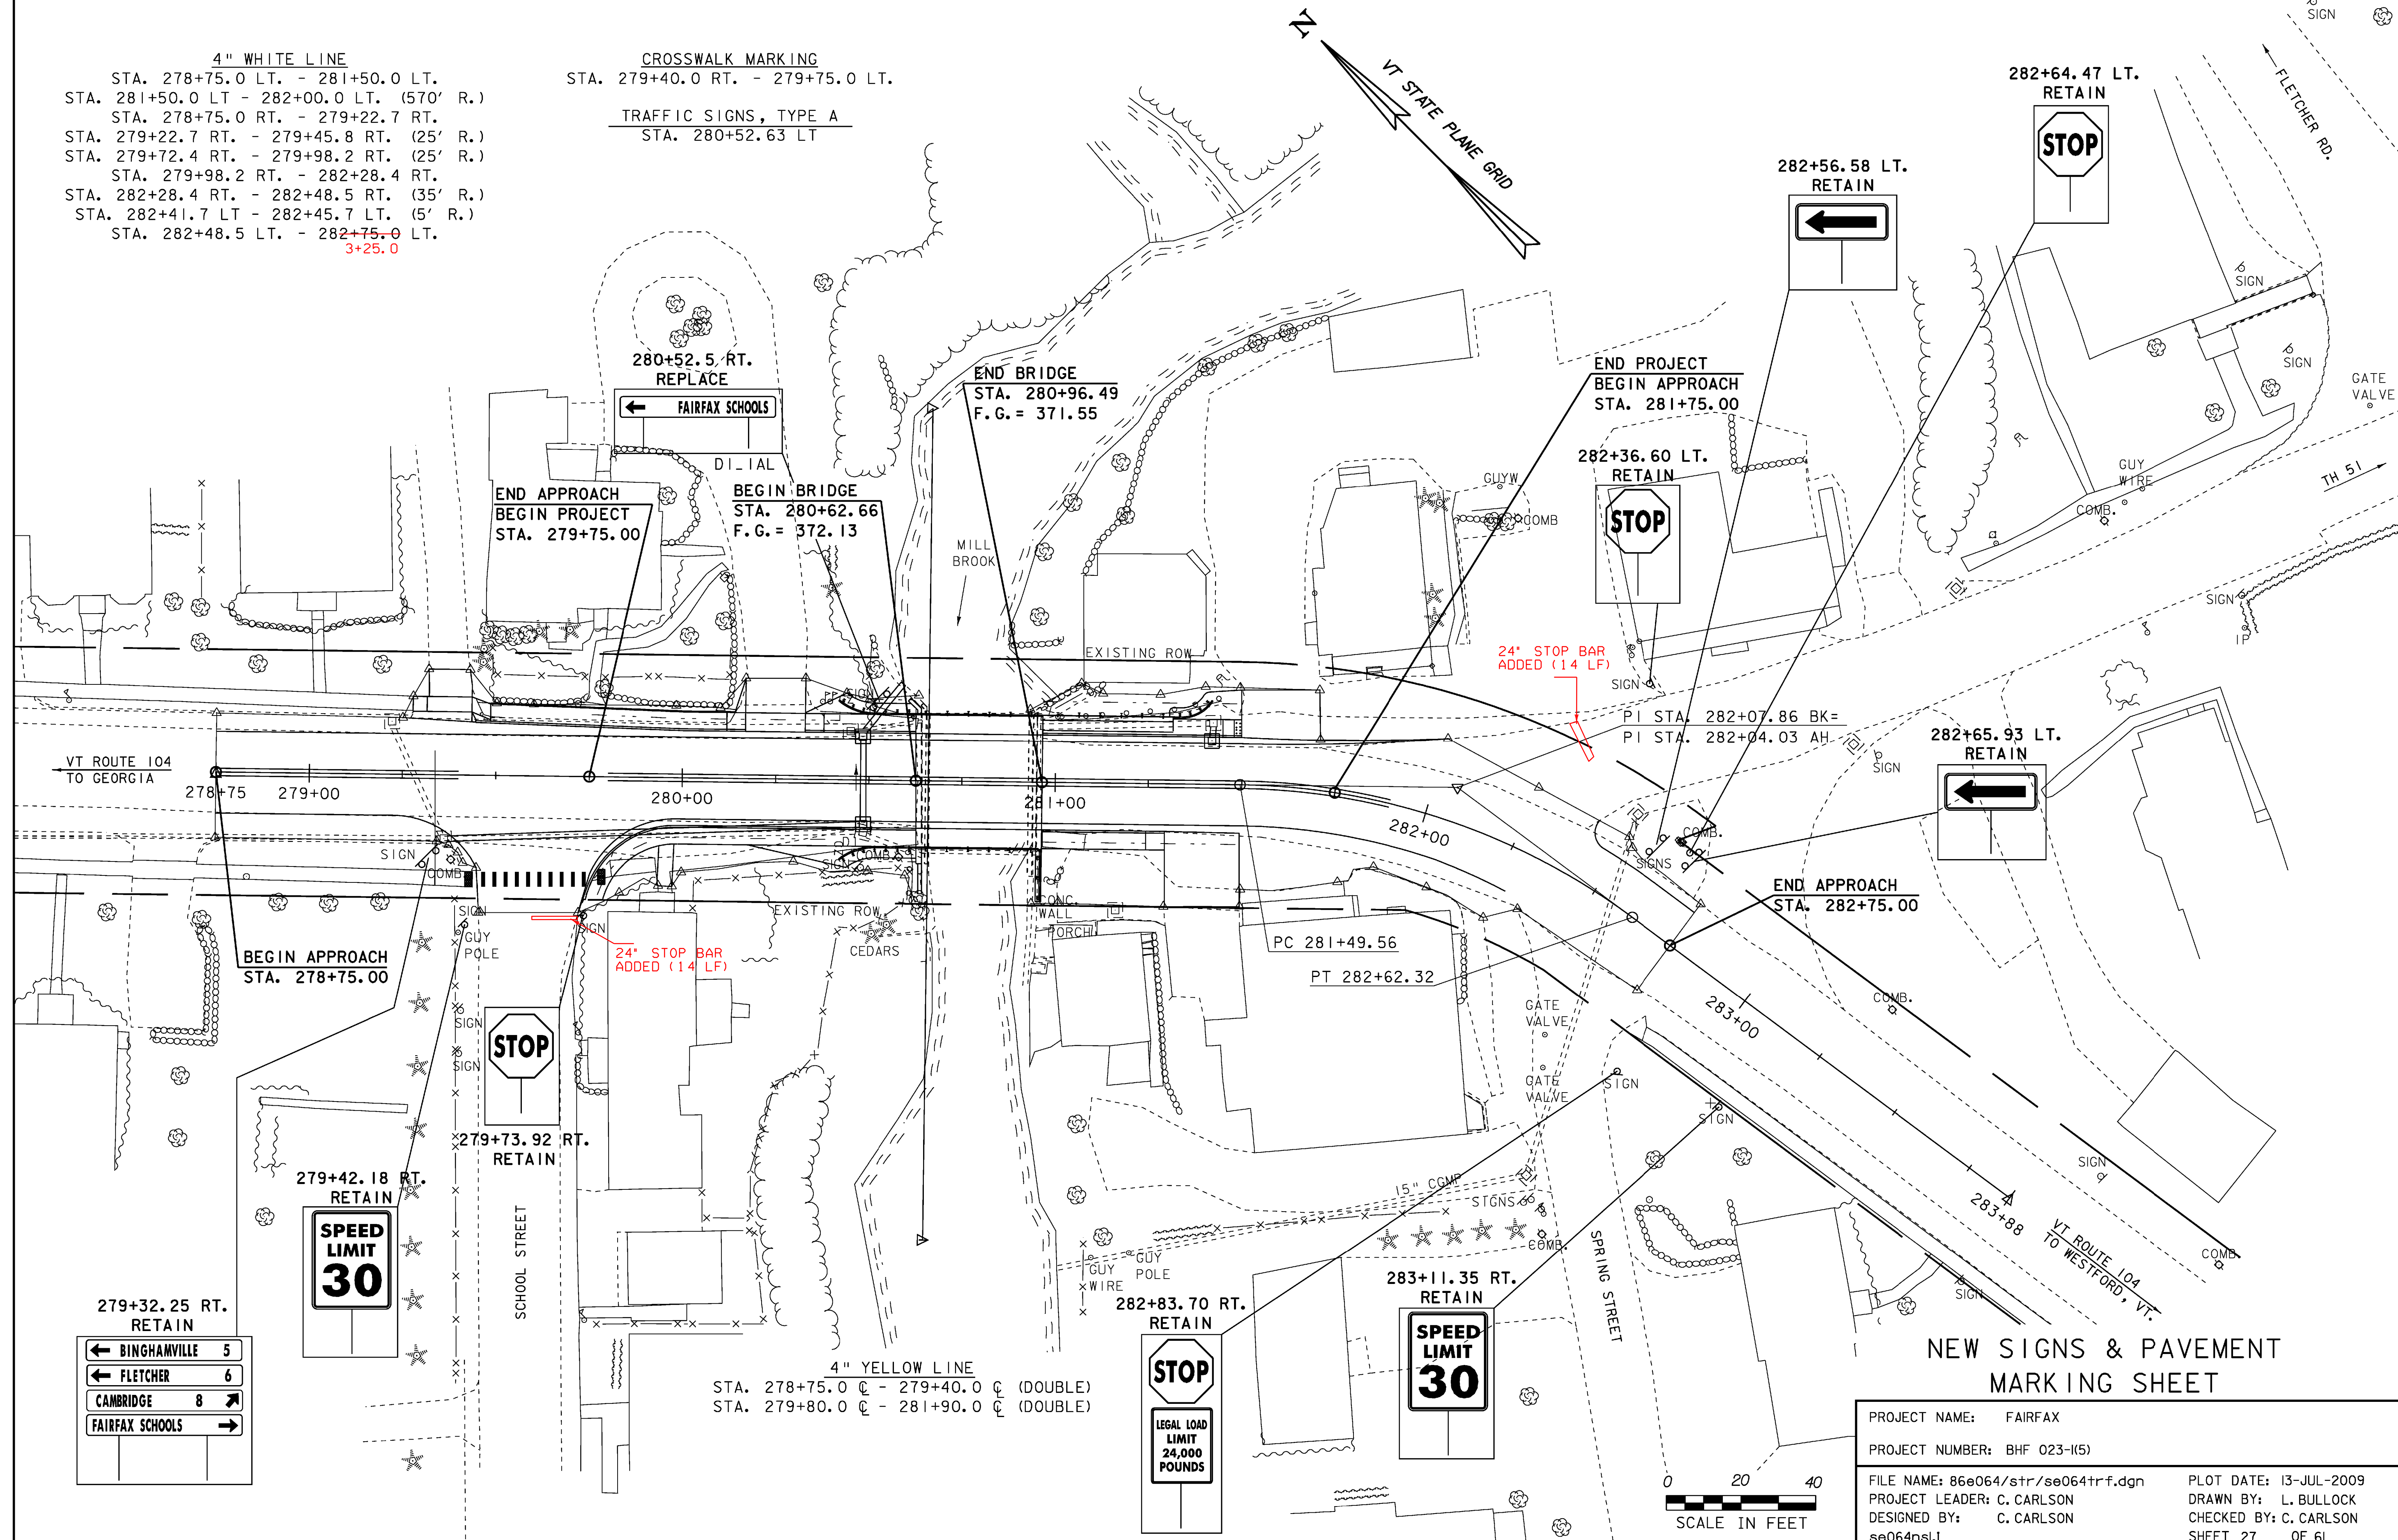


4" WHITE LINE
 STA. 278+75.0 LT. - 281+50.0 LT.
 STA. 281+50.0 LT. - 282+00.0 LT. (570' R.)
 STA. 278+75.0 RT. - 279+22.7 RT.
 STA. 279+22.7 RT. - 279+45.8 RT. (25' R.)
 STA. 279+72.4 RT. - 279+98.2 RT. (25' R.)
 STA. 279+98.2 RT. - 282+28.4 RT.
 STA. 282+28.4 RT. - 282+48.5 RT. (35' R.)
 STA. 282+41.7 LT. - 282+45.7 LT. (5' R.)
 STA. 282+48.5 LT. - 282+75.0 LT.
 3+25.0

CROSSWALK MARKING
 STA. 279+40.0 RT. - 279+75.0 LT.
 TRAFFIC SIGNS, TYPE A
 STA. 280+52.63 LT

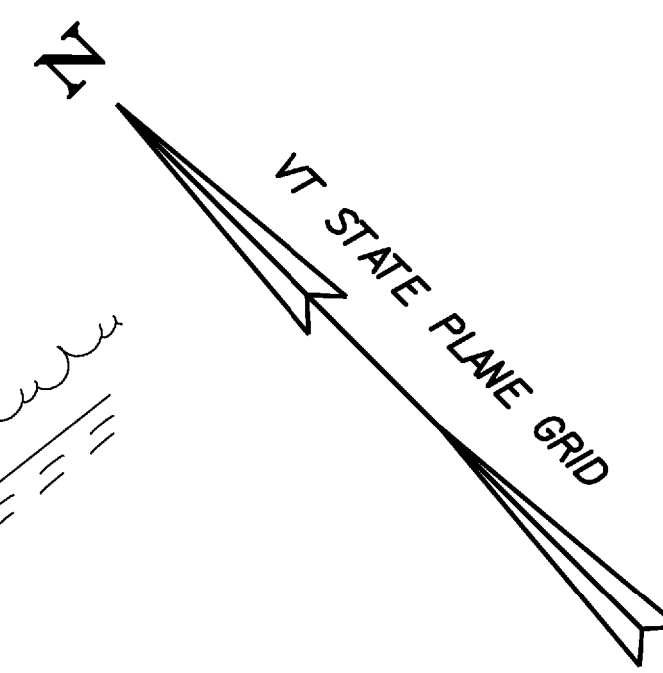

279+32.25 RT. RETAIN

← BINGHAMVILLE	5
← FLETCHER	6
CAMBRIDGE	8 →
FAIRFAX SCHOOLS	→

279+42.18 RT. RETAIN

SPEED LIMIT 30

279+73.92 RT. RETAIN

STOP

280+52.5 RT. REPLACE

← FAIRFAX SCHOOLS

BEGIN BRIDGE
 STA. 280+62.66
 F.G. = 372.13

END BRIDGE
 STA. 280+96.49
 F.G. = 371.55

282+36.60 LT. RETAIN

STOP

282+56.58 LT. RETAIN

←

282+64.47 LT. RETAIN

STOP

282+65.93 LT. RETAIN

←

282+83.70 RT. RETAIN

STOP

LEGAL LOAD LIMIT
24,000 POUNDS

283+11.35 RT. RETAIN

SPEED LIMIT 30

4" YELLOW LINE
 STA. 278+75.0 @ - 279+40.0 @ (DOUBLE)
 STA. 279+80.0 @ - 281+90.0 @ (DOUBLE)



NEW SIGNS & PAVEMENT MARKING SHEET

PROJECT NAME: FAIRFAX	PLOT DATE: 13-JUL-2009
PROJECT NUMBER: BHF 023-I(5)	DRAWN BY: L. BULLOCK
FILE NAME: 86e064/str/se064trf.dgn	CHECKED BY: C. CARLSON
PROJECT LEADER: C. CARLSON	SHEET 27 OF 61
DESIGNED BY: C. CARLSON	
se064nsl	