

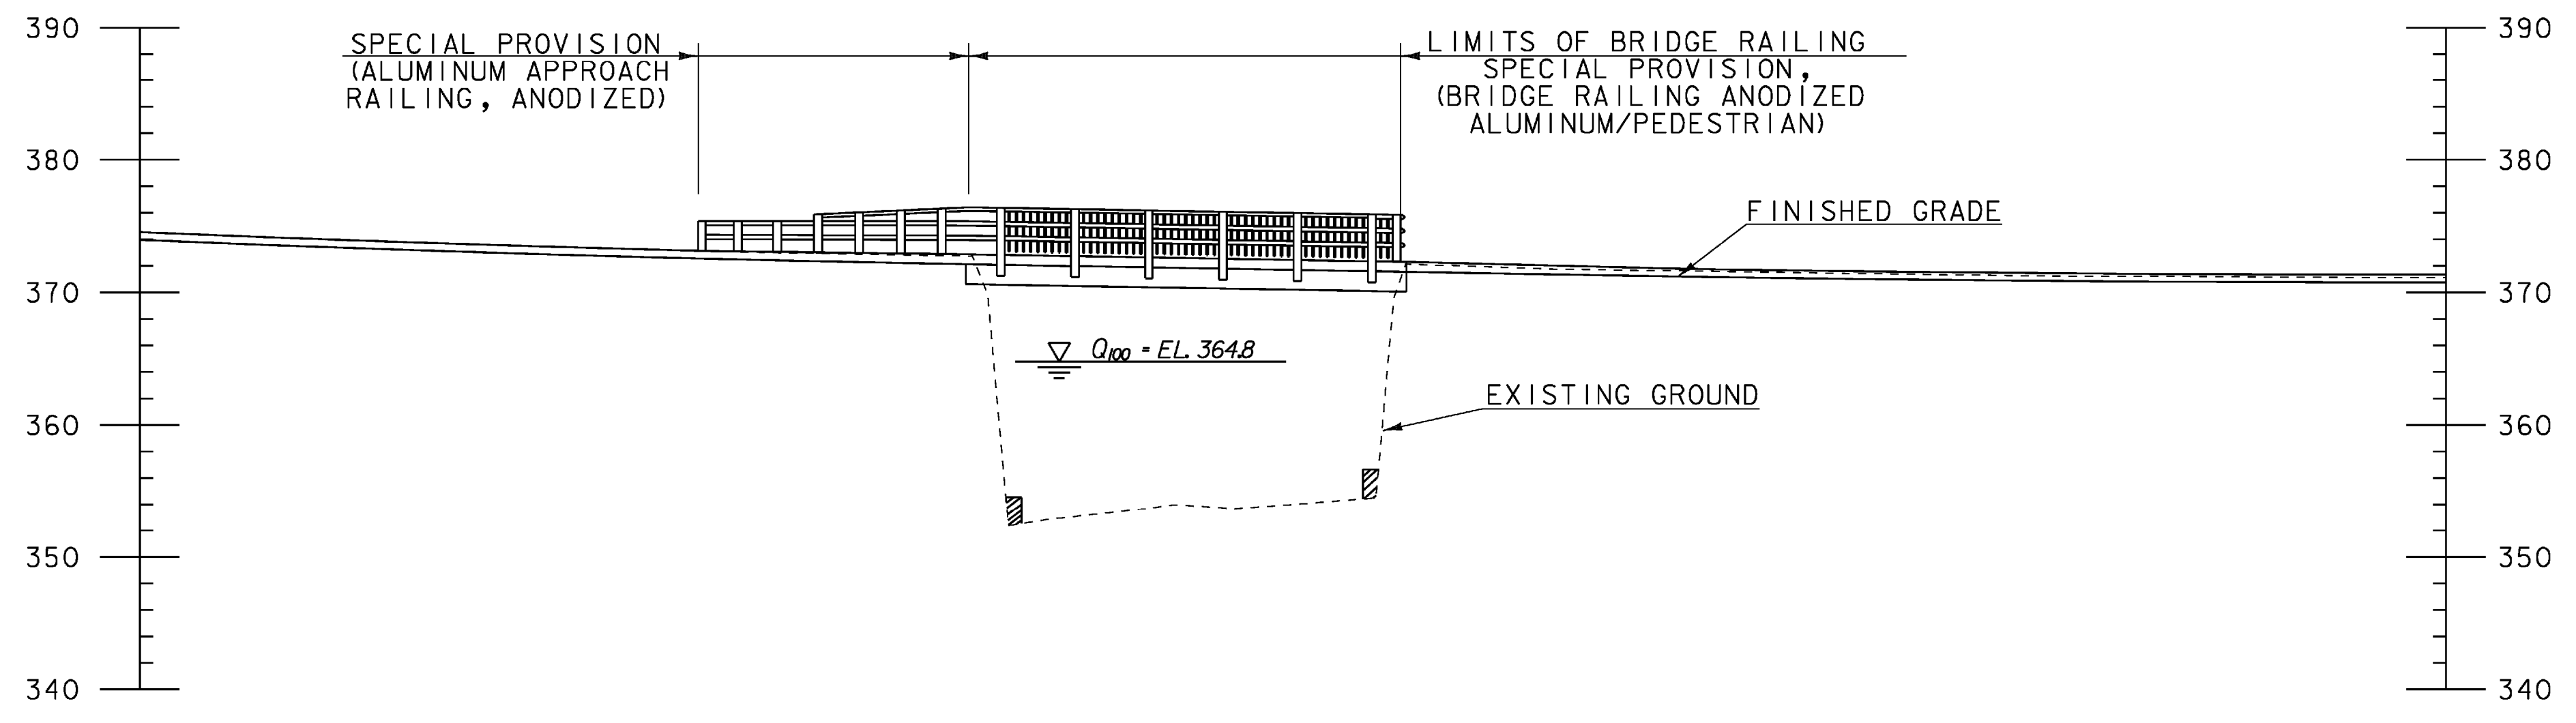


**PLAN**

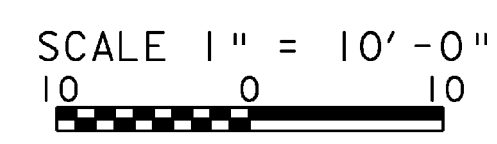

**ELEVATION**

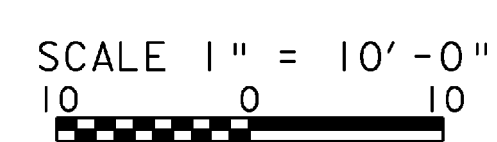

**PLAN AND ELEVATION**

PROJECT NAME: FAIRFAX	PLOT DATE: 20-JUL-2009
PROJECT NUMBER: BHF 023-(15)	DRAWN BY: L. BULLOCK
FILE NAME: 86e064/str/se064pe.dgn	CHECKED BY: C. CARLSON
PROJECT LEADER: C. CARLSON	SHEET 34 OF 61
DESIGNED BY: C. CARLSON	
se064pe.l	