



ABUTMENT 2 PLAN

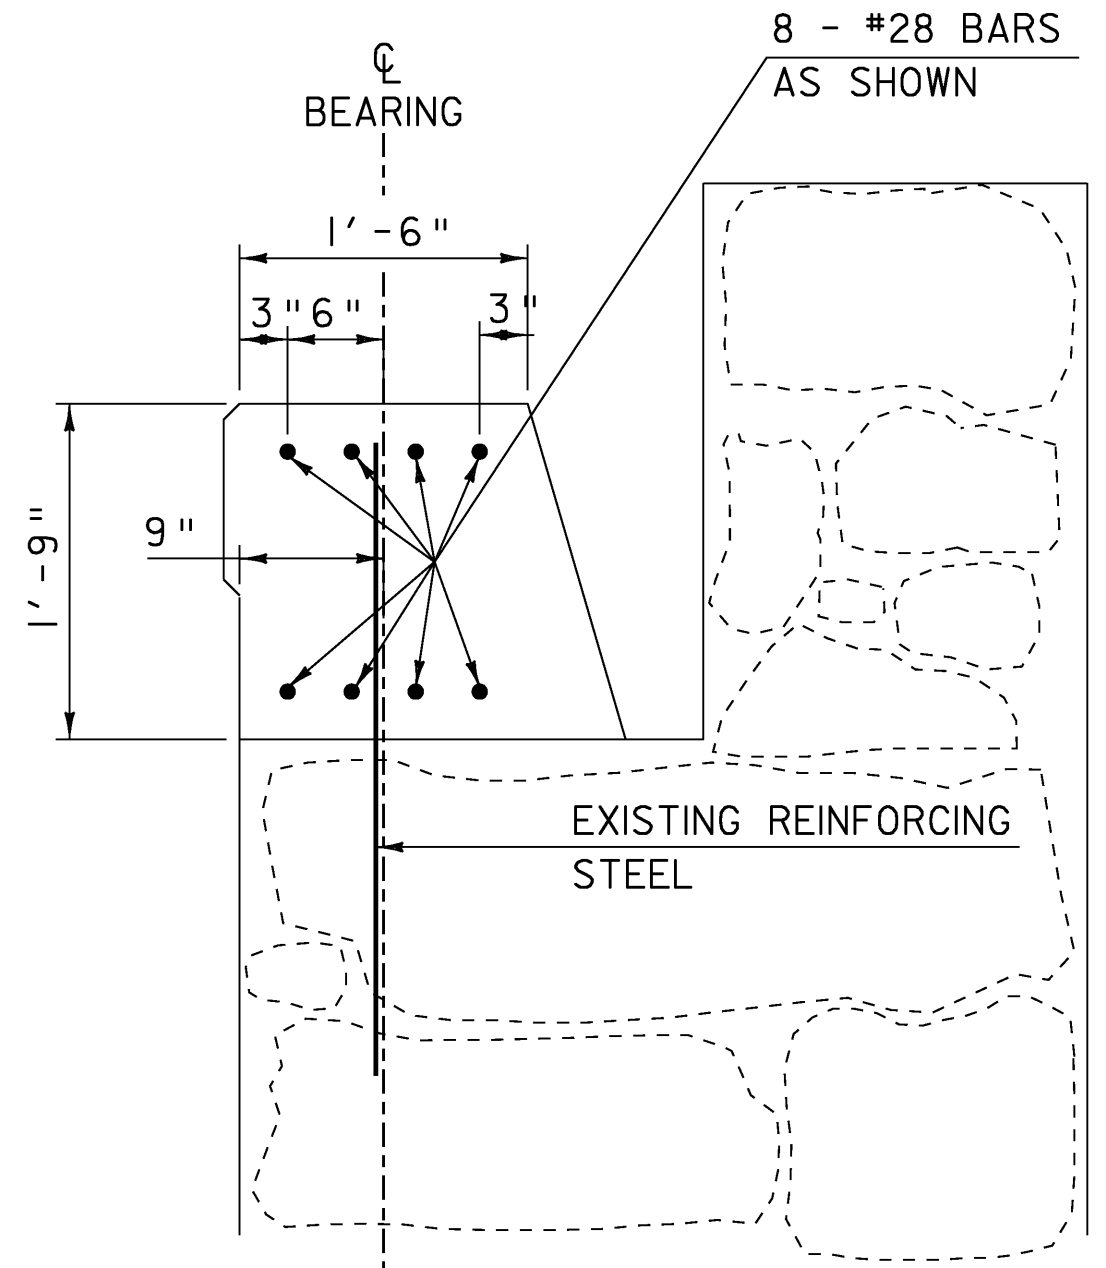

ABUTMENT 2 TYPICAL

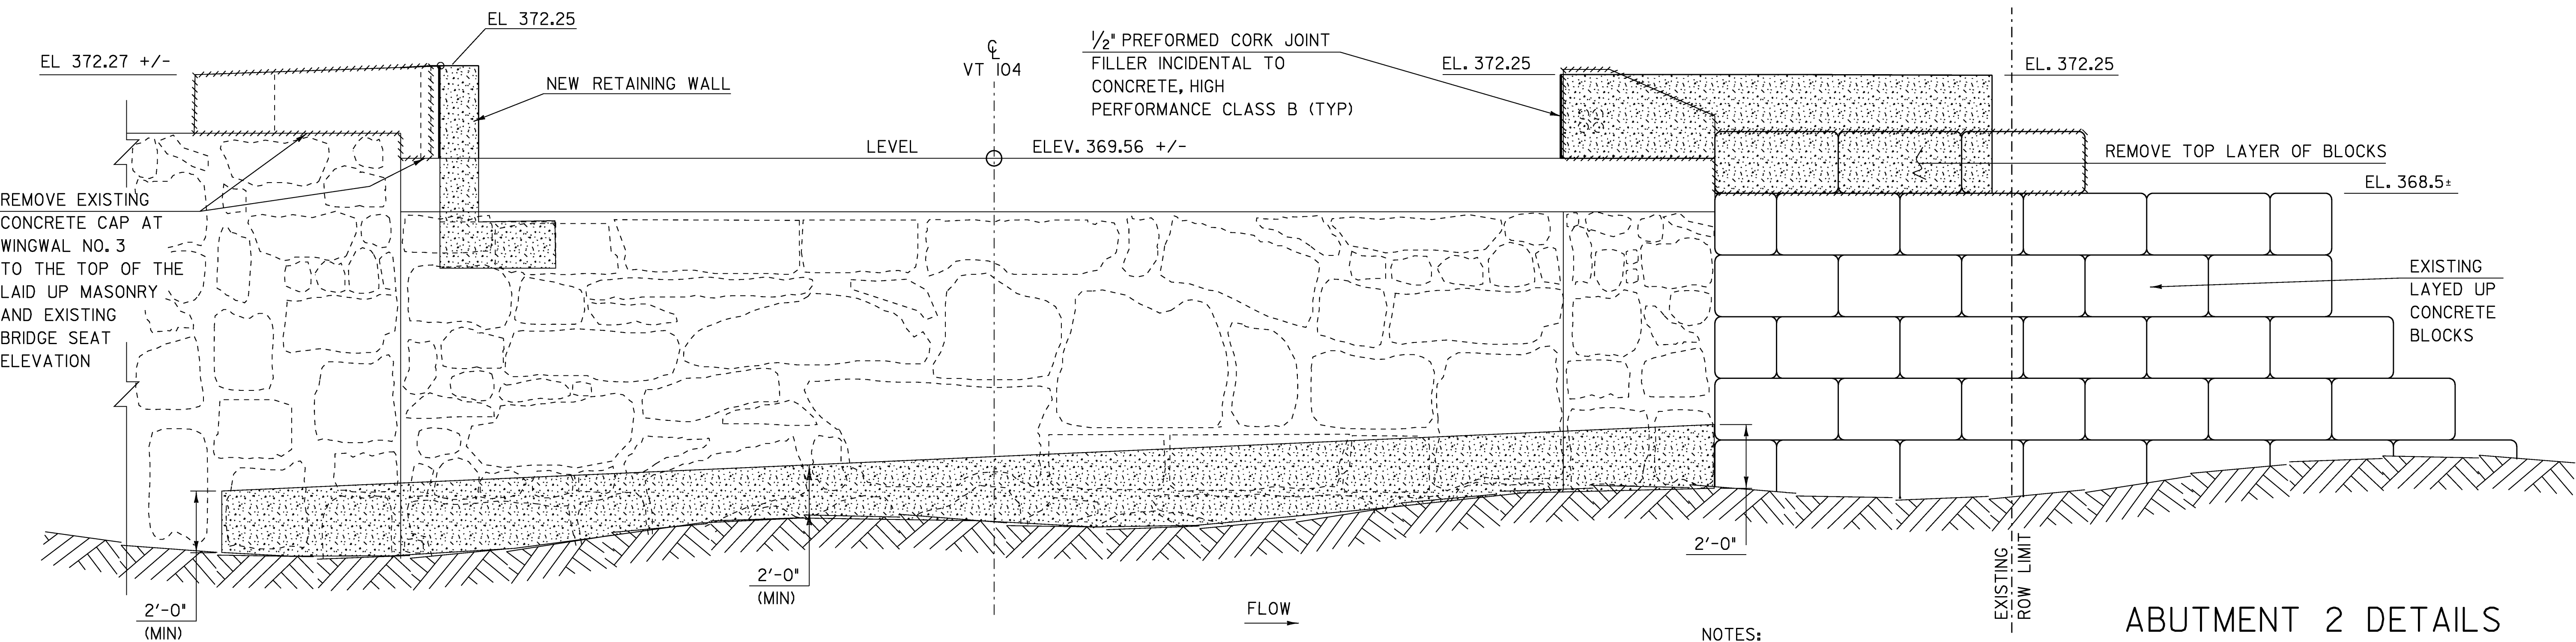

ABUTMENT 2 ELEVATION

- NOTES:**
- NEW CONCRETE
 - REMOVAL OF CONCRETE OR MASONRY
 - SEE SHEET 43 FOR WINGWALL DETAILS

PROJECT NAME:	FAIRFAX	FILE NAME:	s86e064sub.dgn	PLOT DATE:	20-JUL-2009
PROJECT NUMBER:	BHF 023-I(5)	PROJECT LEADER:	C. CARLSON	DRAWN BY:	C. MOONEY
		DESIGNED BY:	C. CARLSON	CHECKED BY:	C. CARLSON
				SHEET	42 OF 61