



Fairfax BHF 023-1(5)
Record Plans

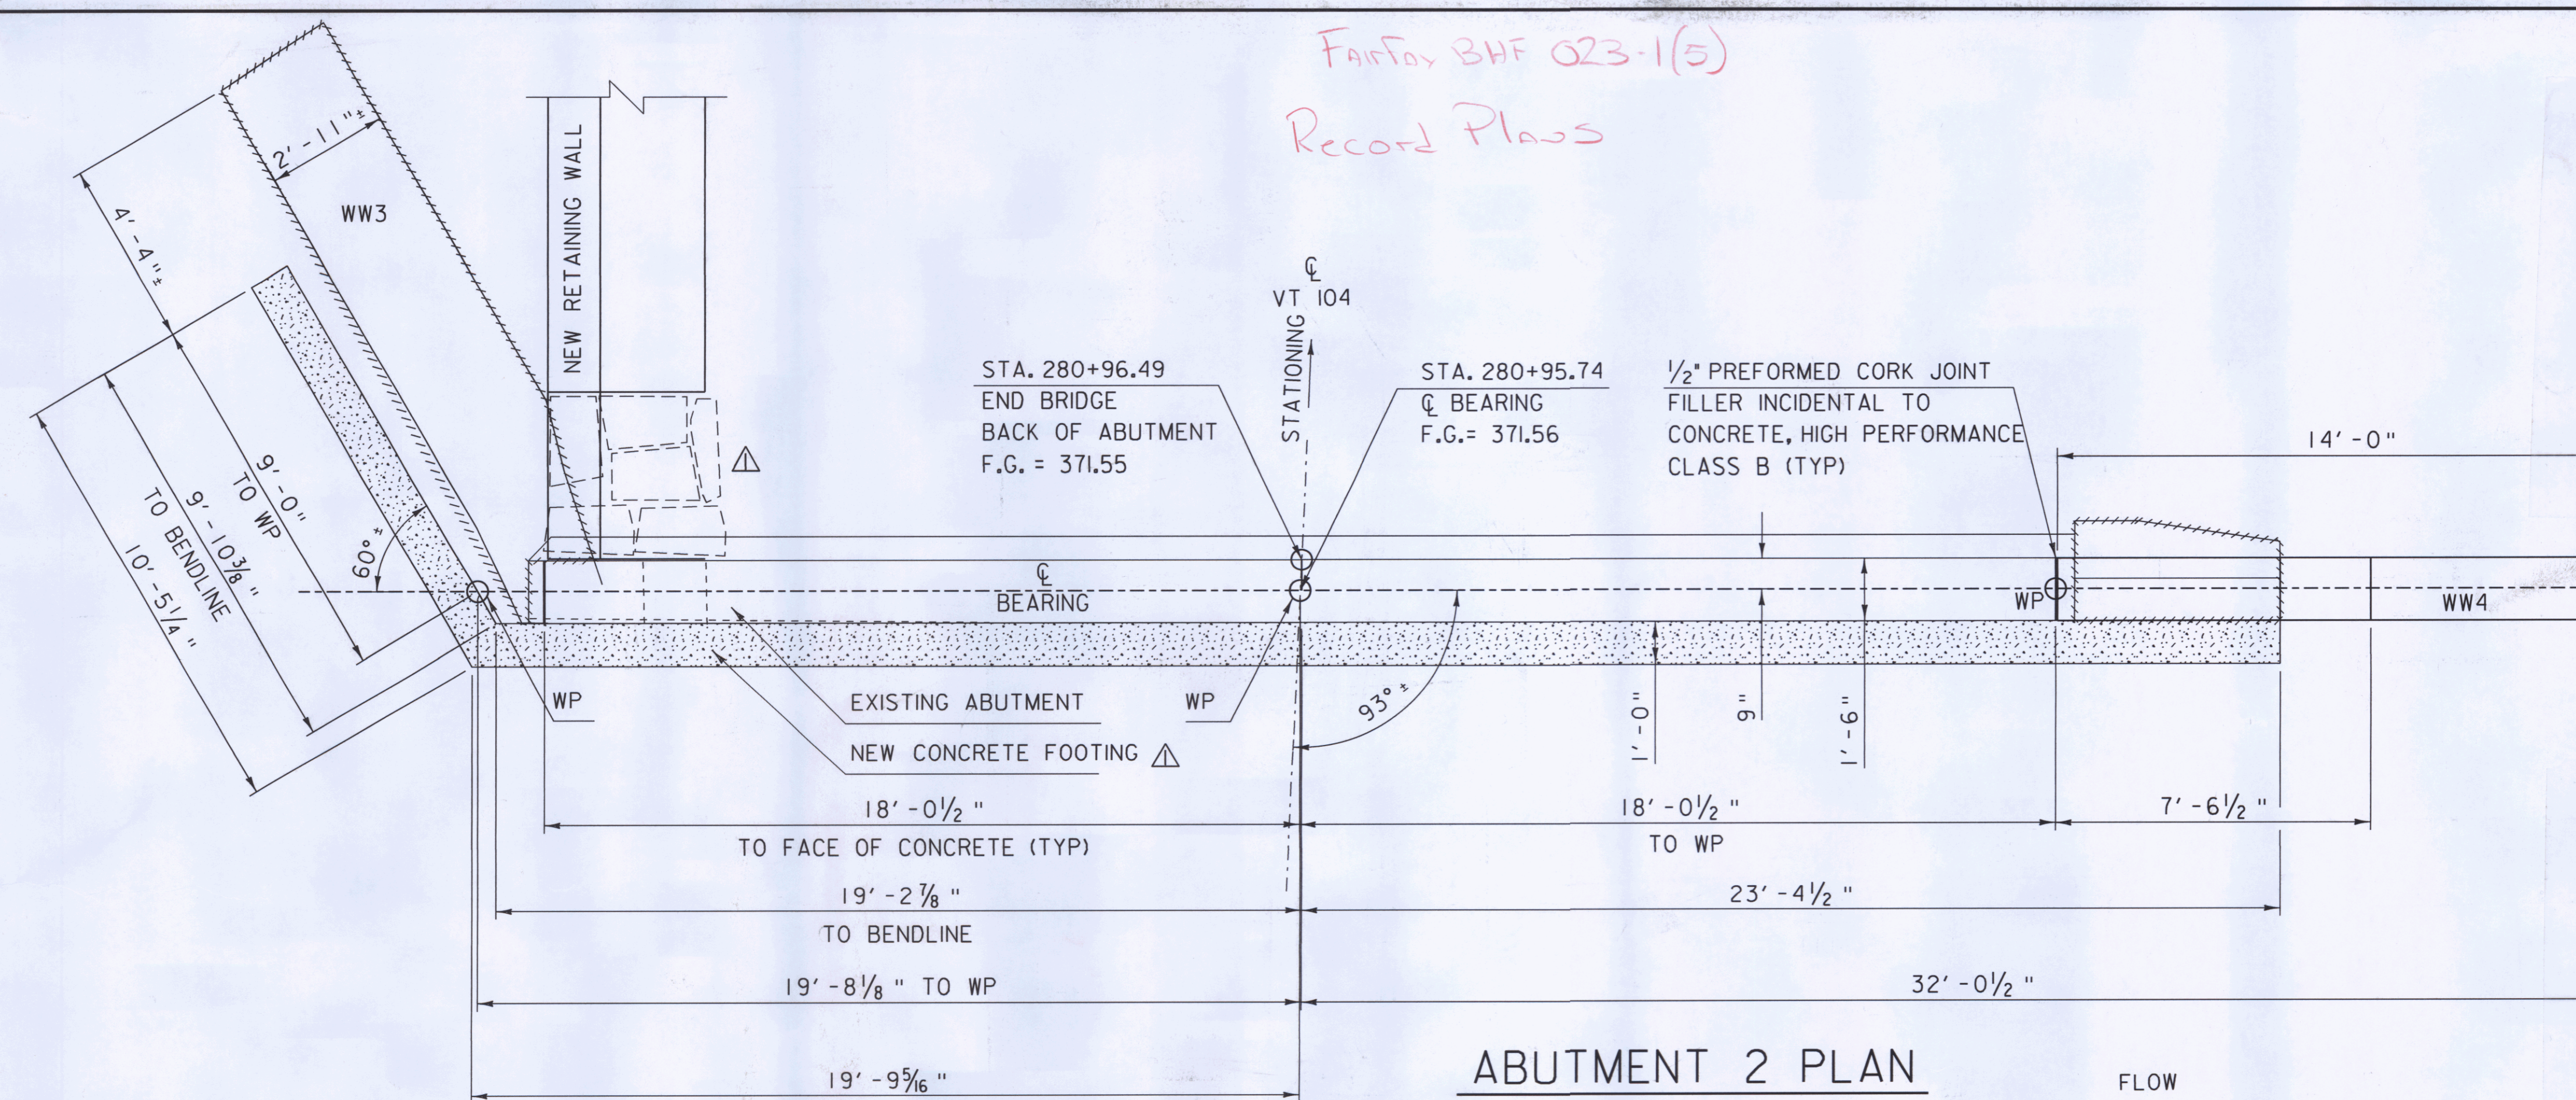

ABUTMENT 2 PLAN

SCALE 3/8" = 1'-0"
0 1 2 3 4

Additional Masonry Removal. HRC-B cap poured back as a keel part of base for 4' Chaw hole Face

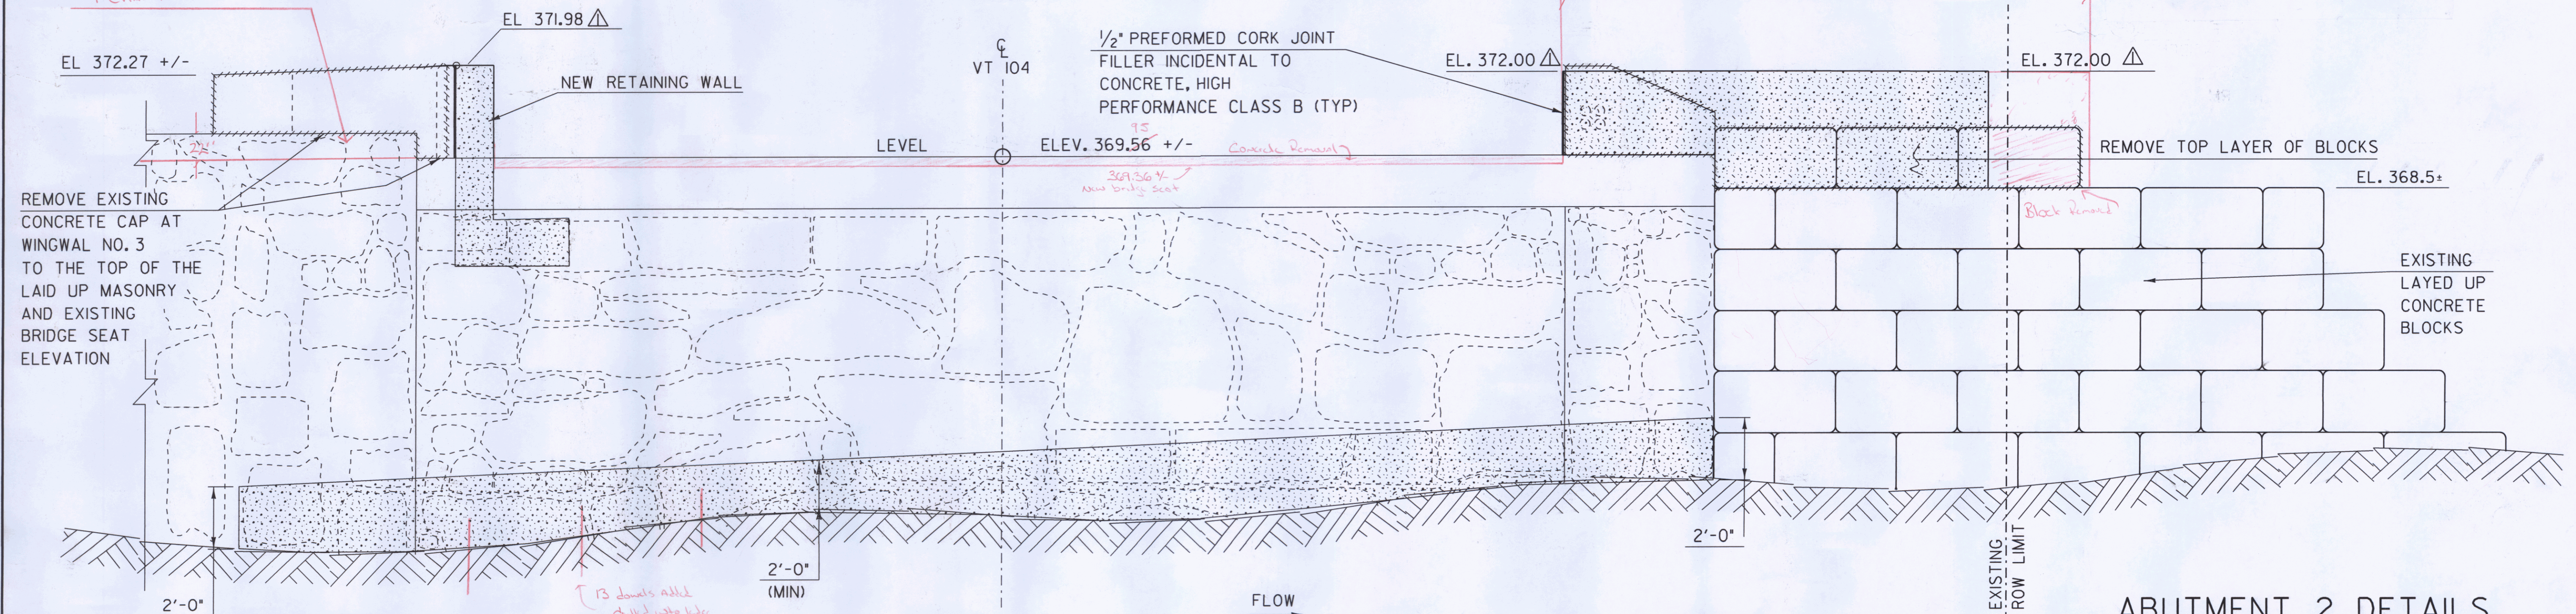

ABUTMENT 2 ELEVATION

SCALE 3/8" = 1'-0"
0 1 2 3 4

- NOTES:
- NEW CONCRETE
 - REMOVAL OF CONCRETE OR MASONRY
 - SEE SHEET 43 FOR WINGWALL DETAILS

REVISION NUMBER	DESCRIPTION	DATE
1	CHANGE DUE TO FIELD CONDITIONS	10/30/09

PROJECT NAME: FAIRFAX
PROJECT NUMBER: BHF 023-1(5)
FILE NAME: s86e064sub.dgn
PROJECT LEADER: C. CARLSON
DESIGNED BY: C. CARLSON
PLOT DATE: 05-NOV-2009
DRAWN BY: C. MOONEY
CHECKED BY: C. CARLSON
SHEET 42 OF 61