




282+00

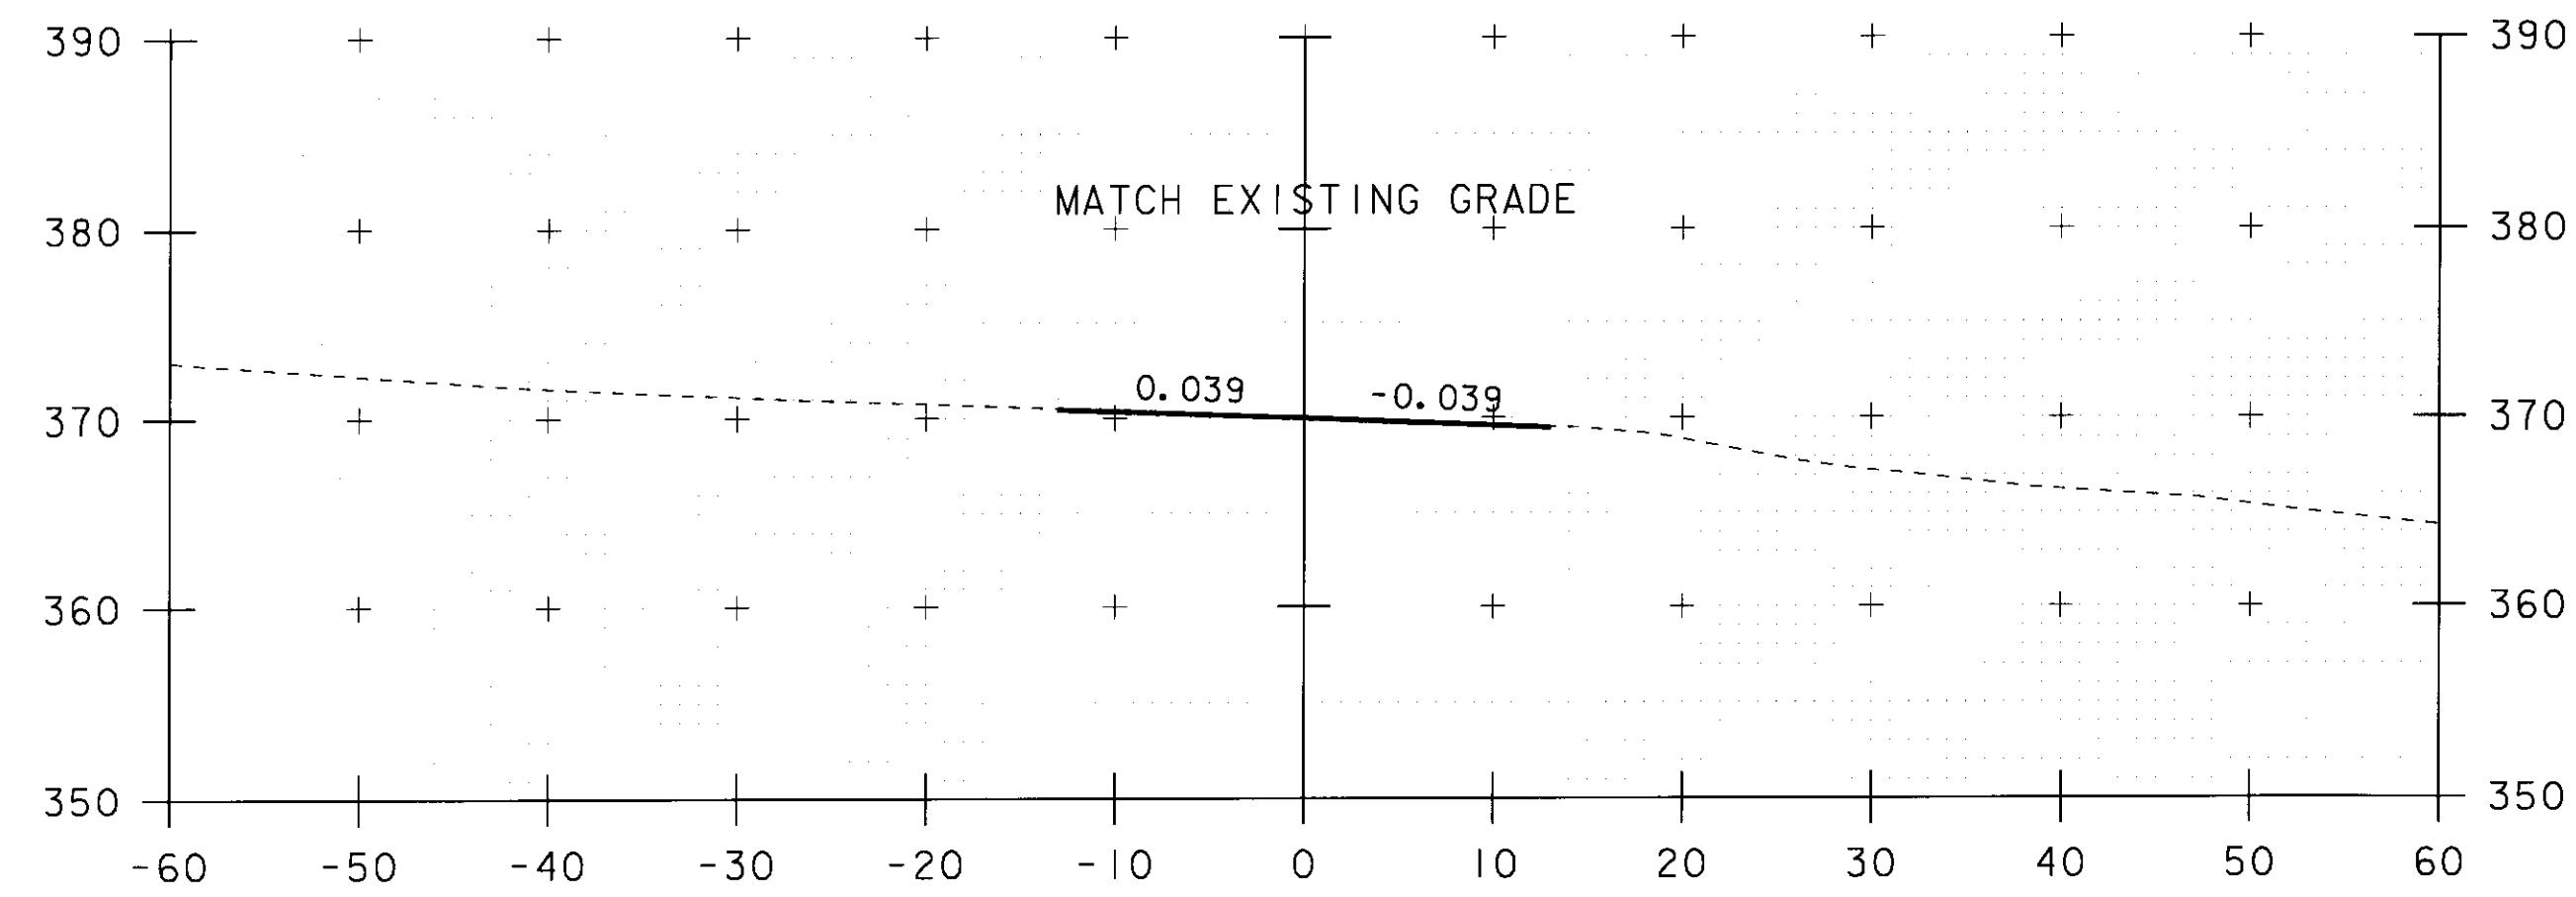


282+75
END APPROACH

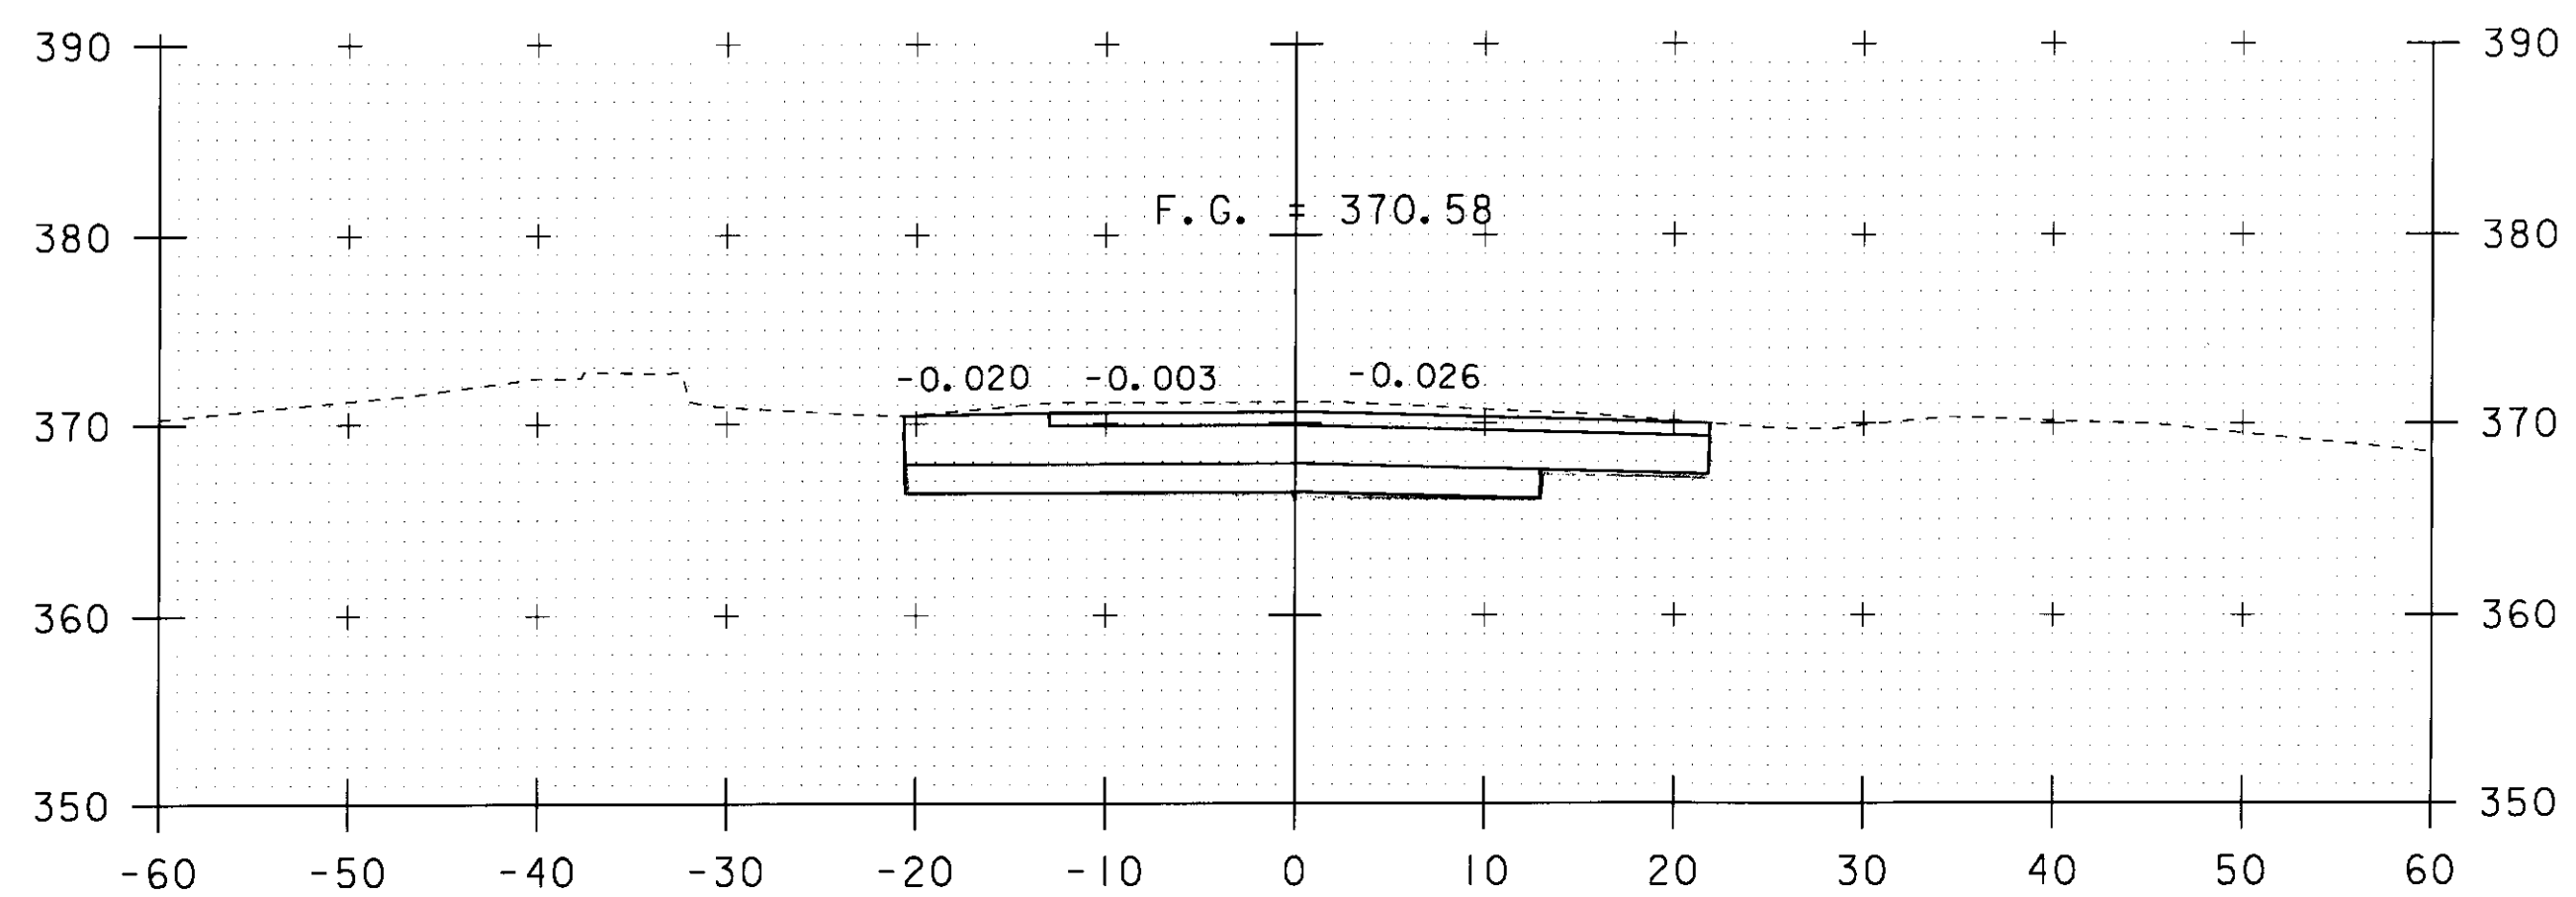


281+75
END PROJECT
BEGIN APPROACH

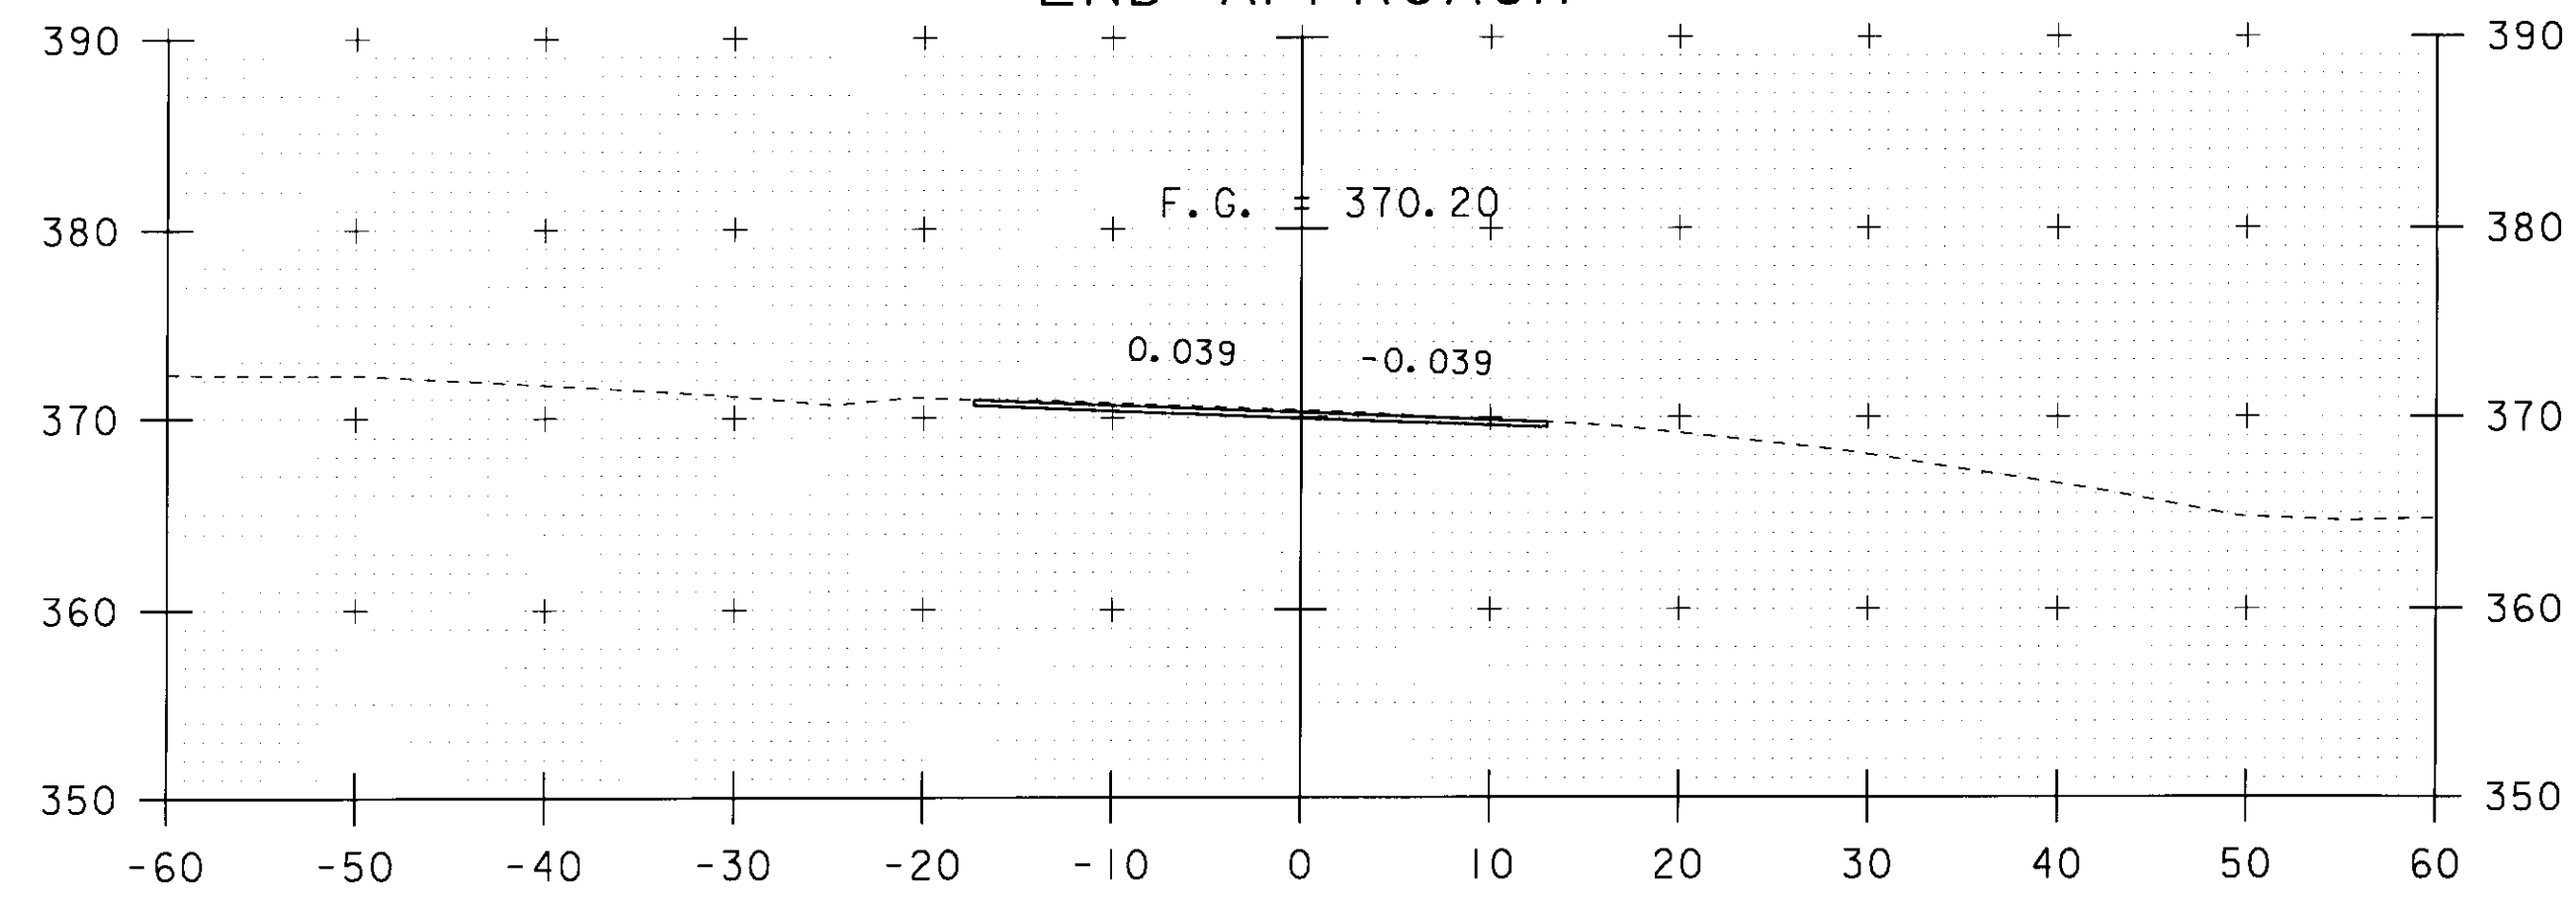

282+50

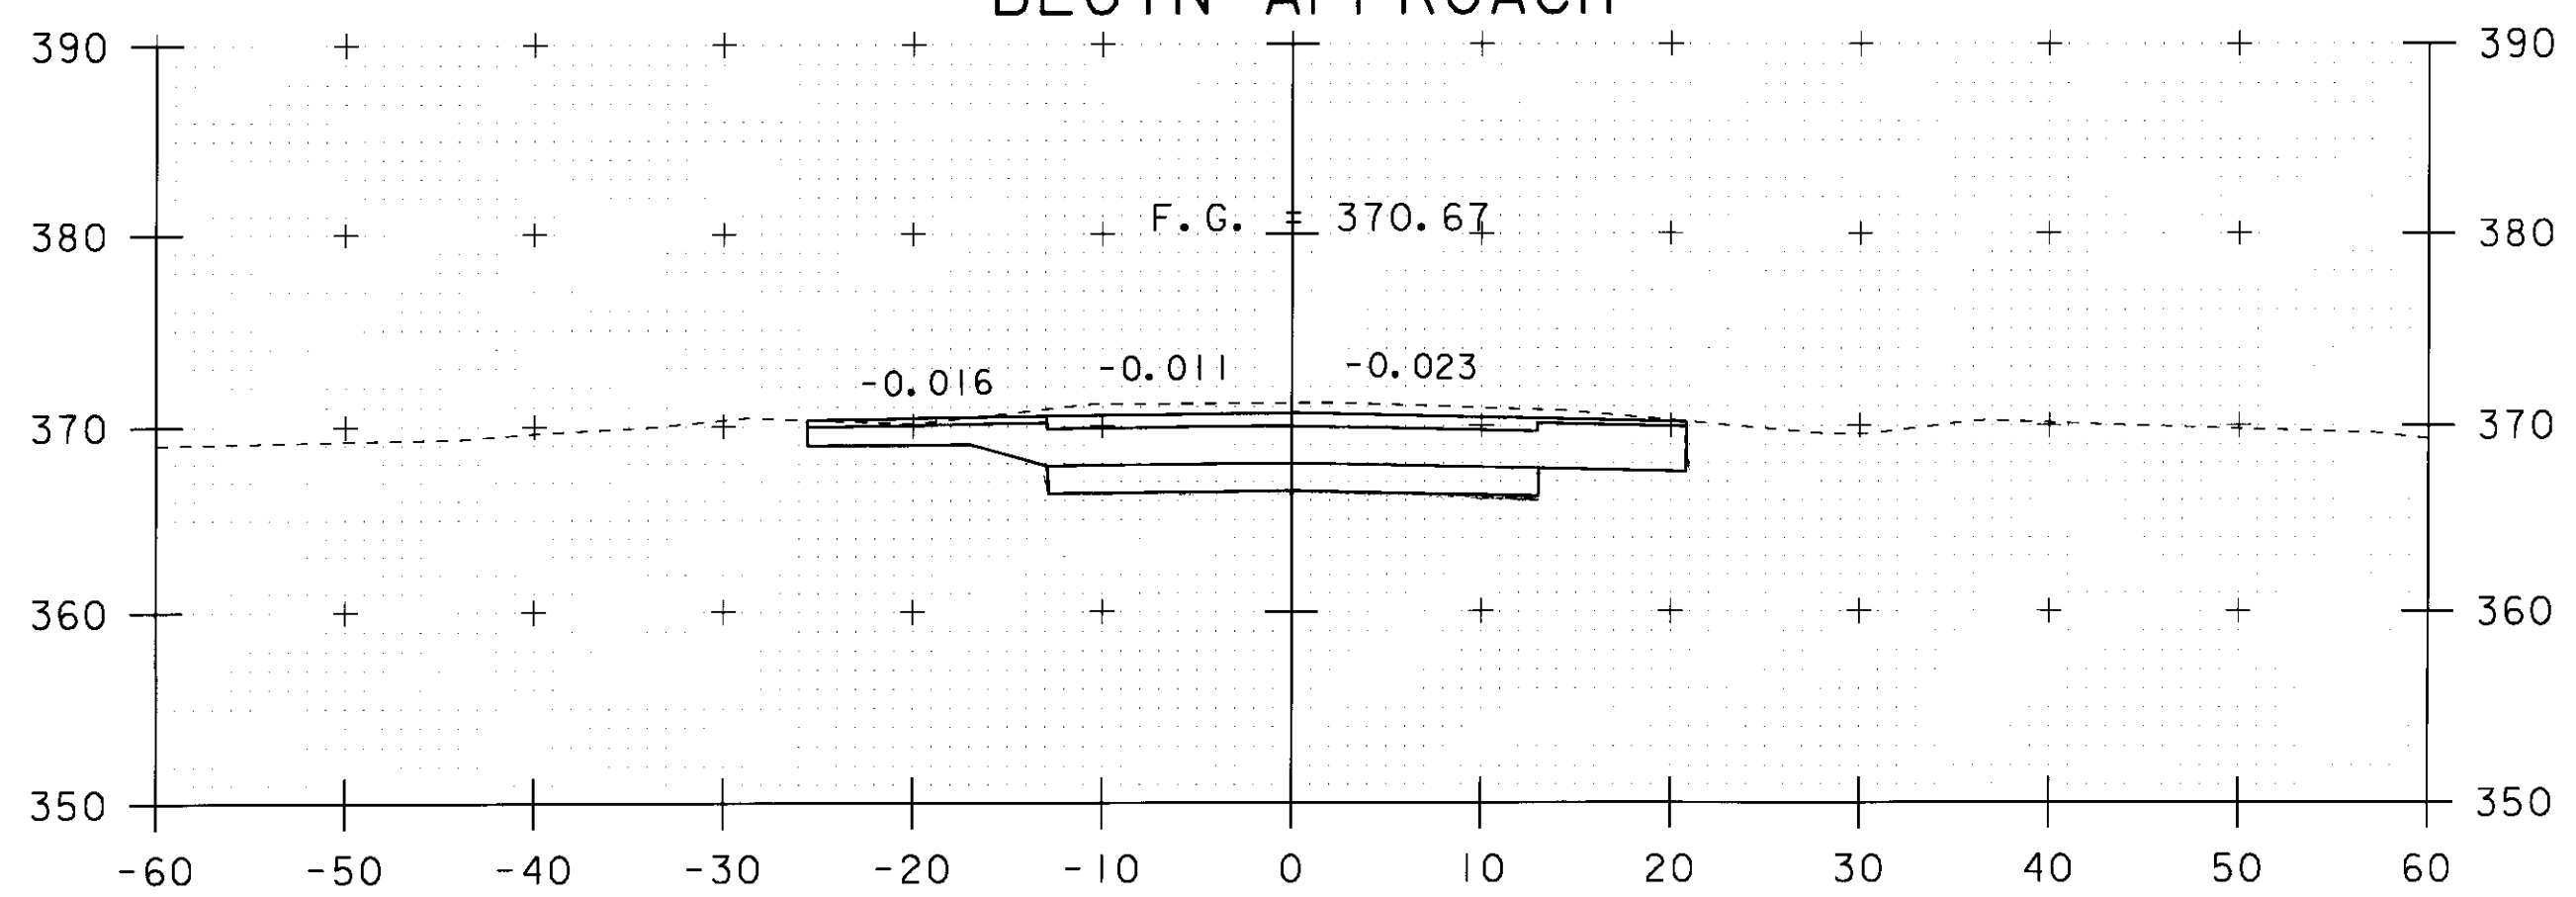


281+61

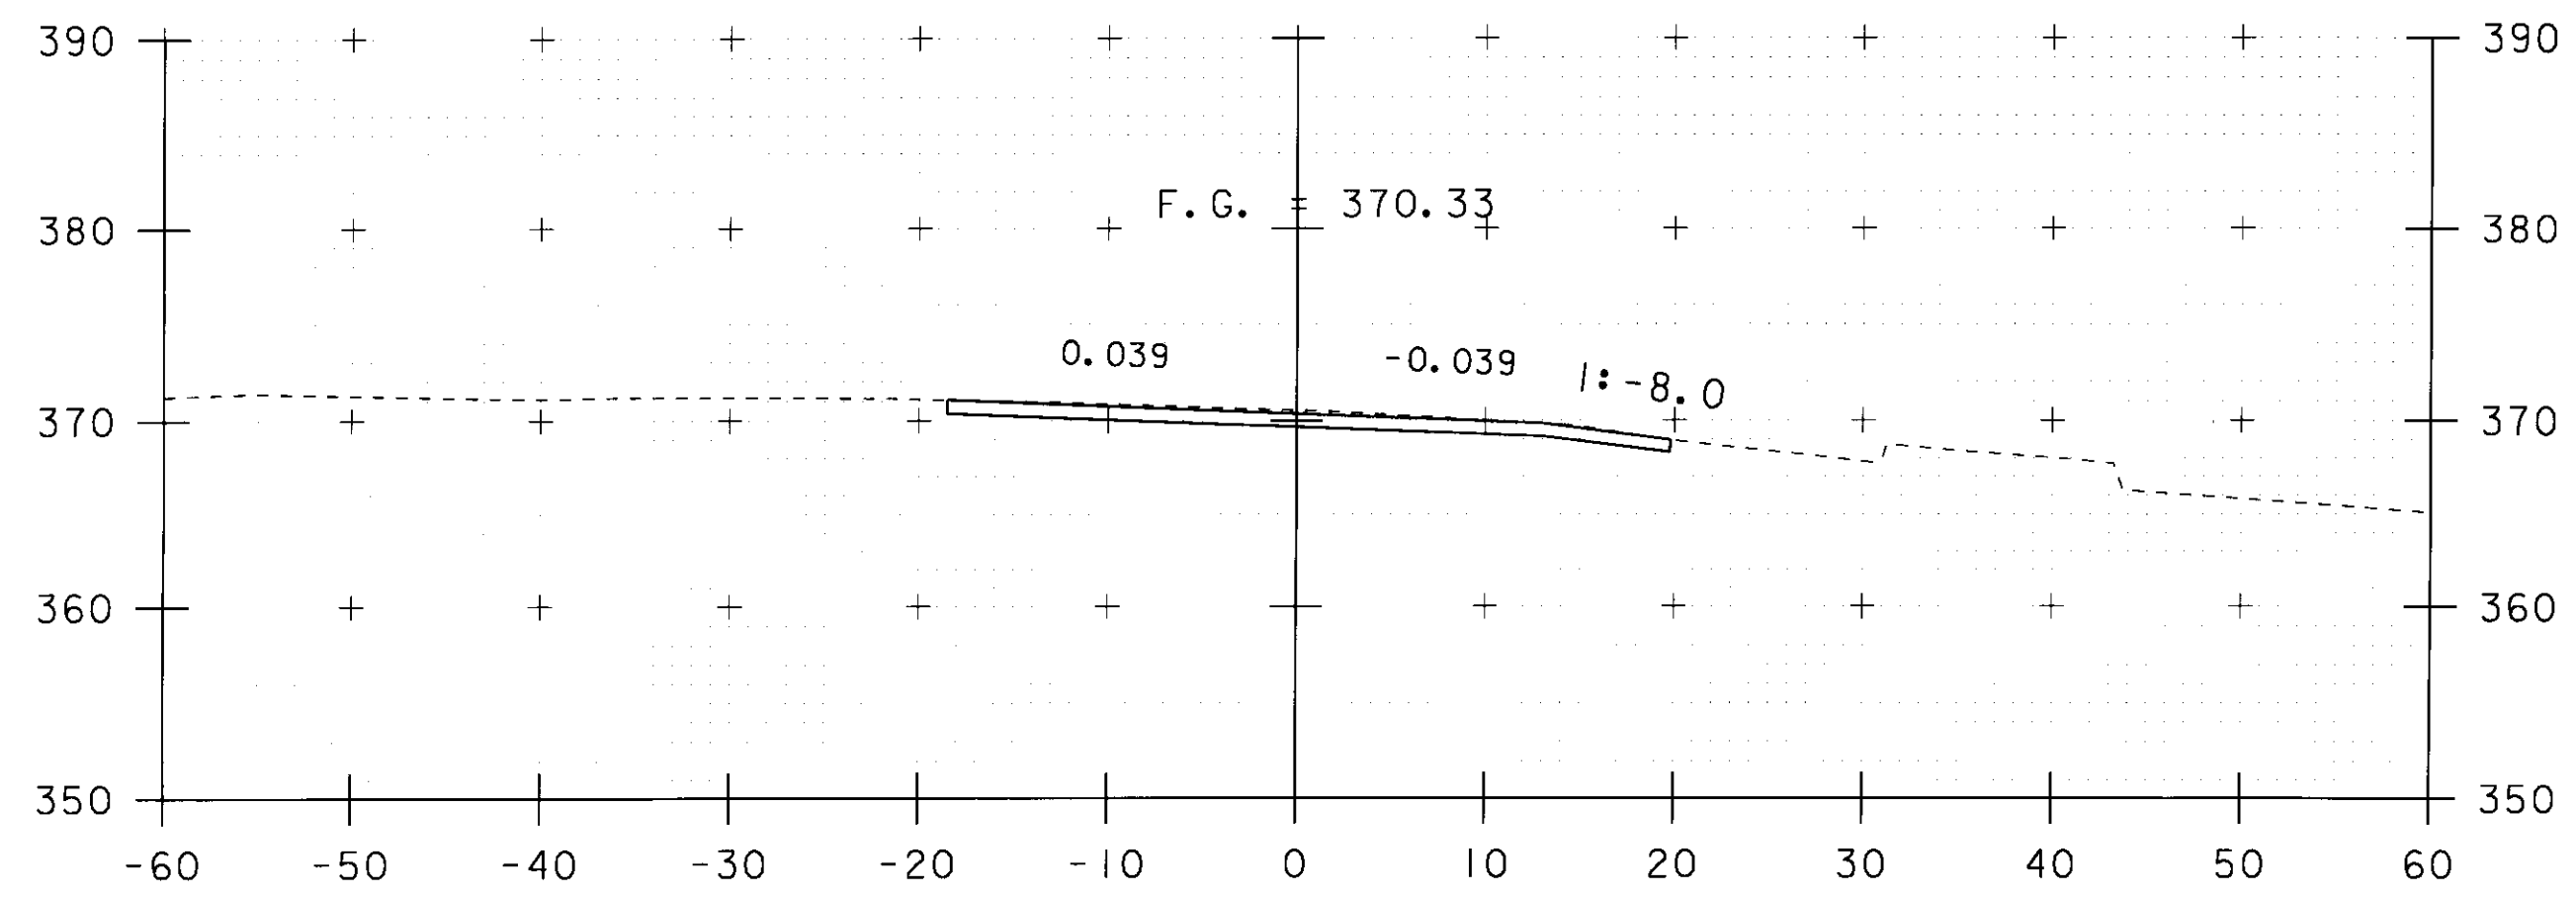

282+25

STA. 281+61.0 LT.
CONSTRUCT DRIVE

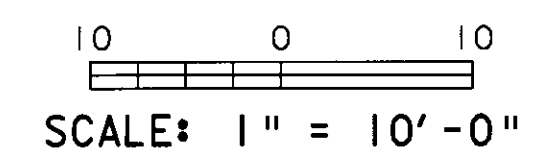

STA. 281+61 TO STA. 282+75

VT 104 SECTIONS - SHEET 6

PROJECT NAME: FAIRFAX	PLOT DATE: 13-JUL-2009
PROJECT NUMBER: BHF 023-(15)	DRAWN BY: L. BULLOCK
FILE NAME: 86e064/str/se064xs2.dgn	CHECKED BY: C. CARLSON
PROJECT LEADER: C. CARLSON	SHEET 51 OF 61
DESIGNED BY: C. CARLSON	
se064xs6.1	