




500+70

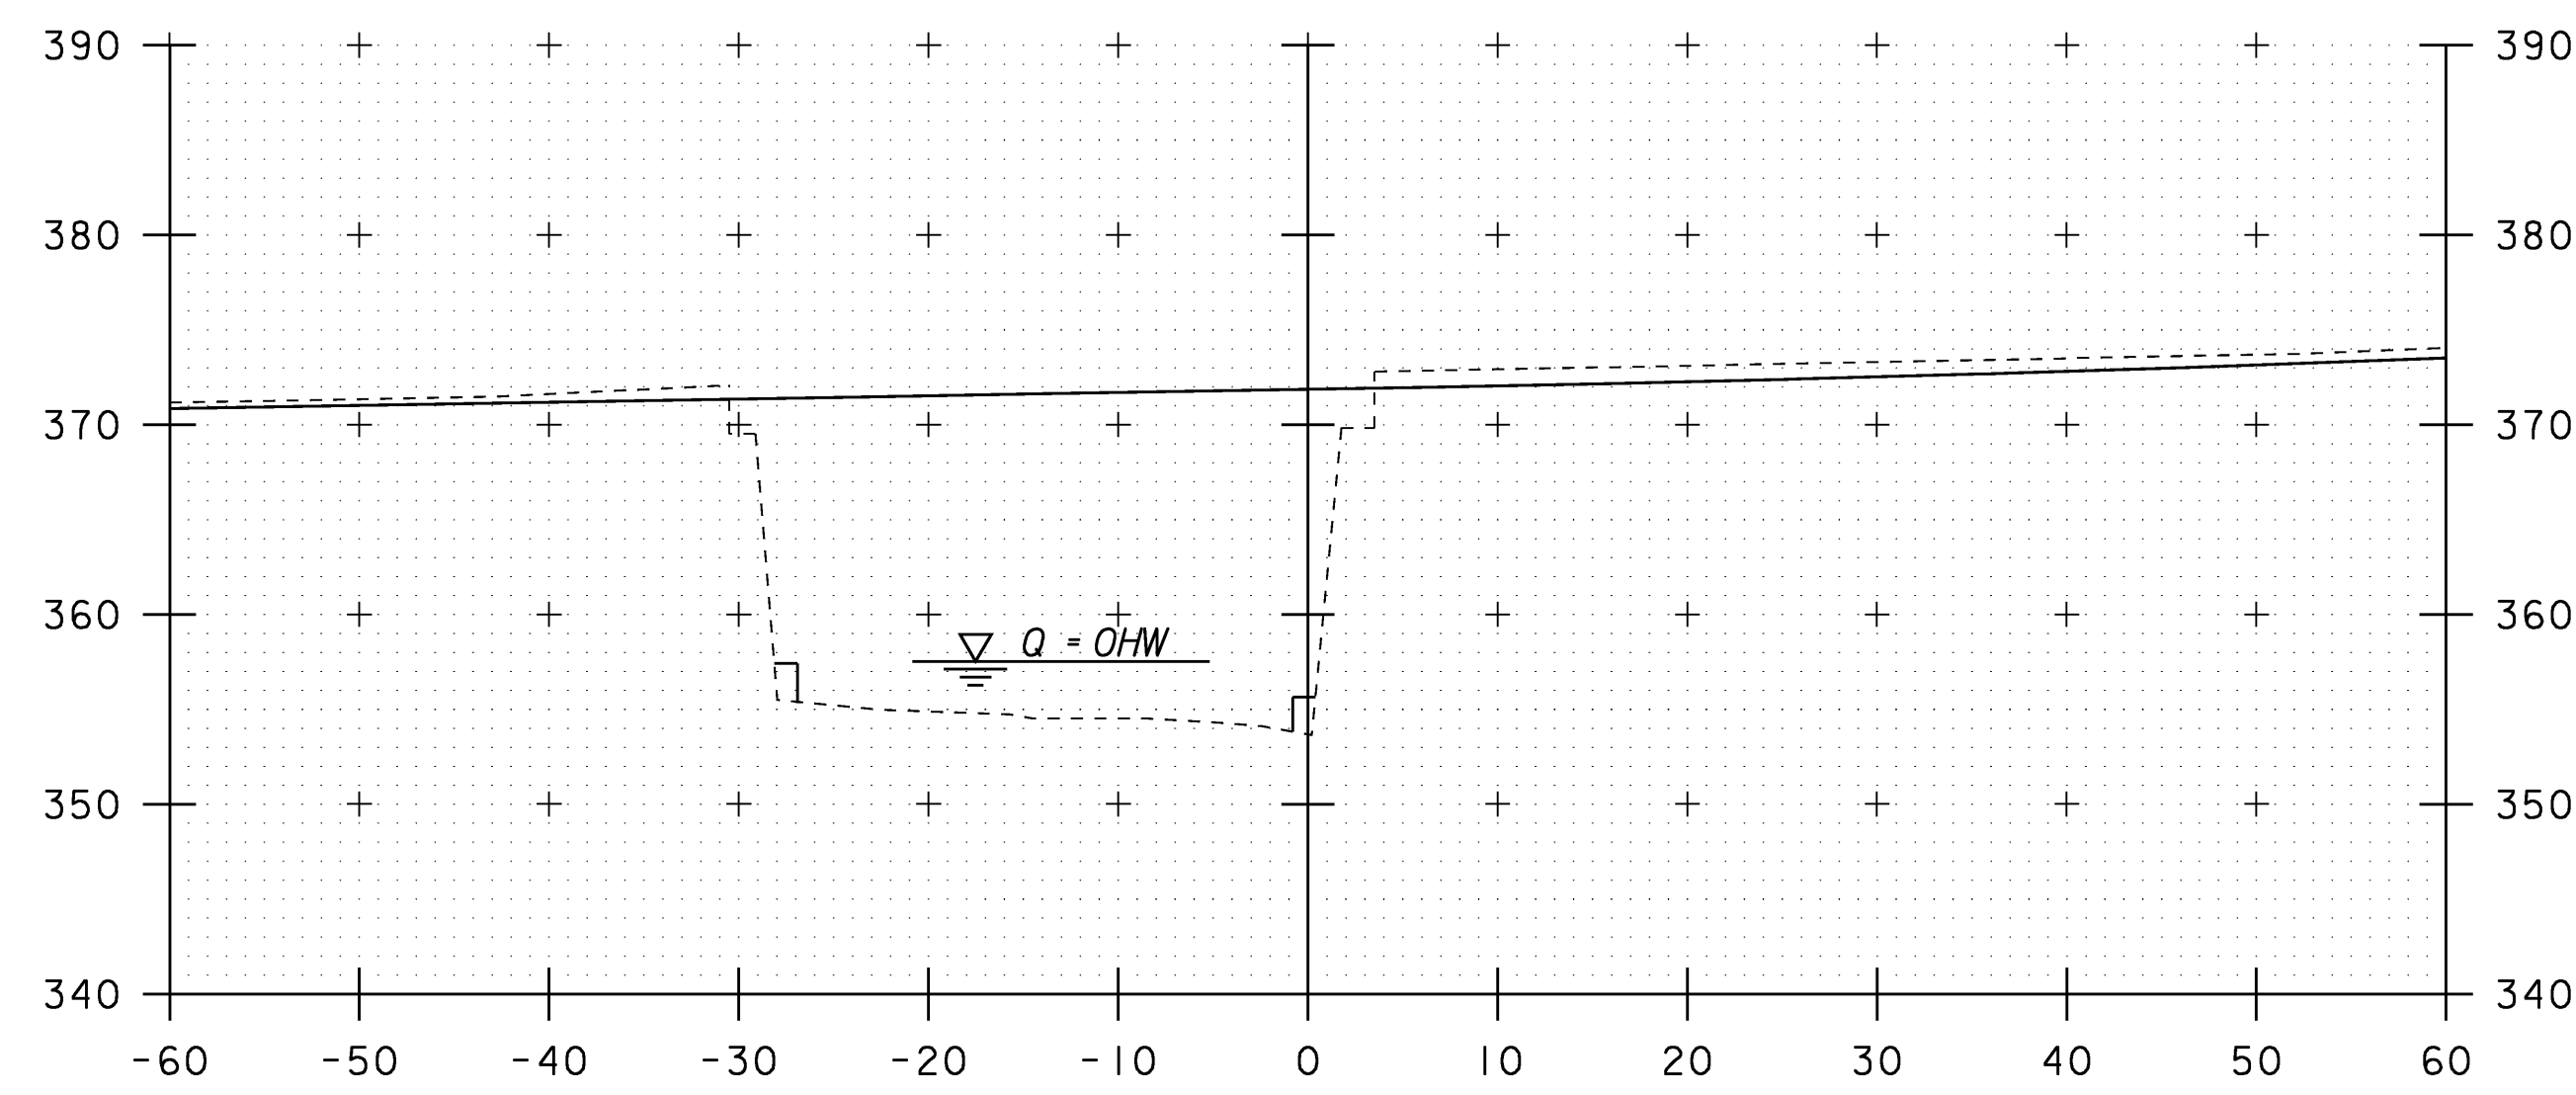

500+90

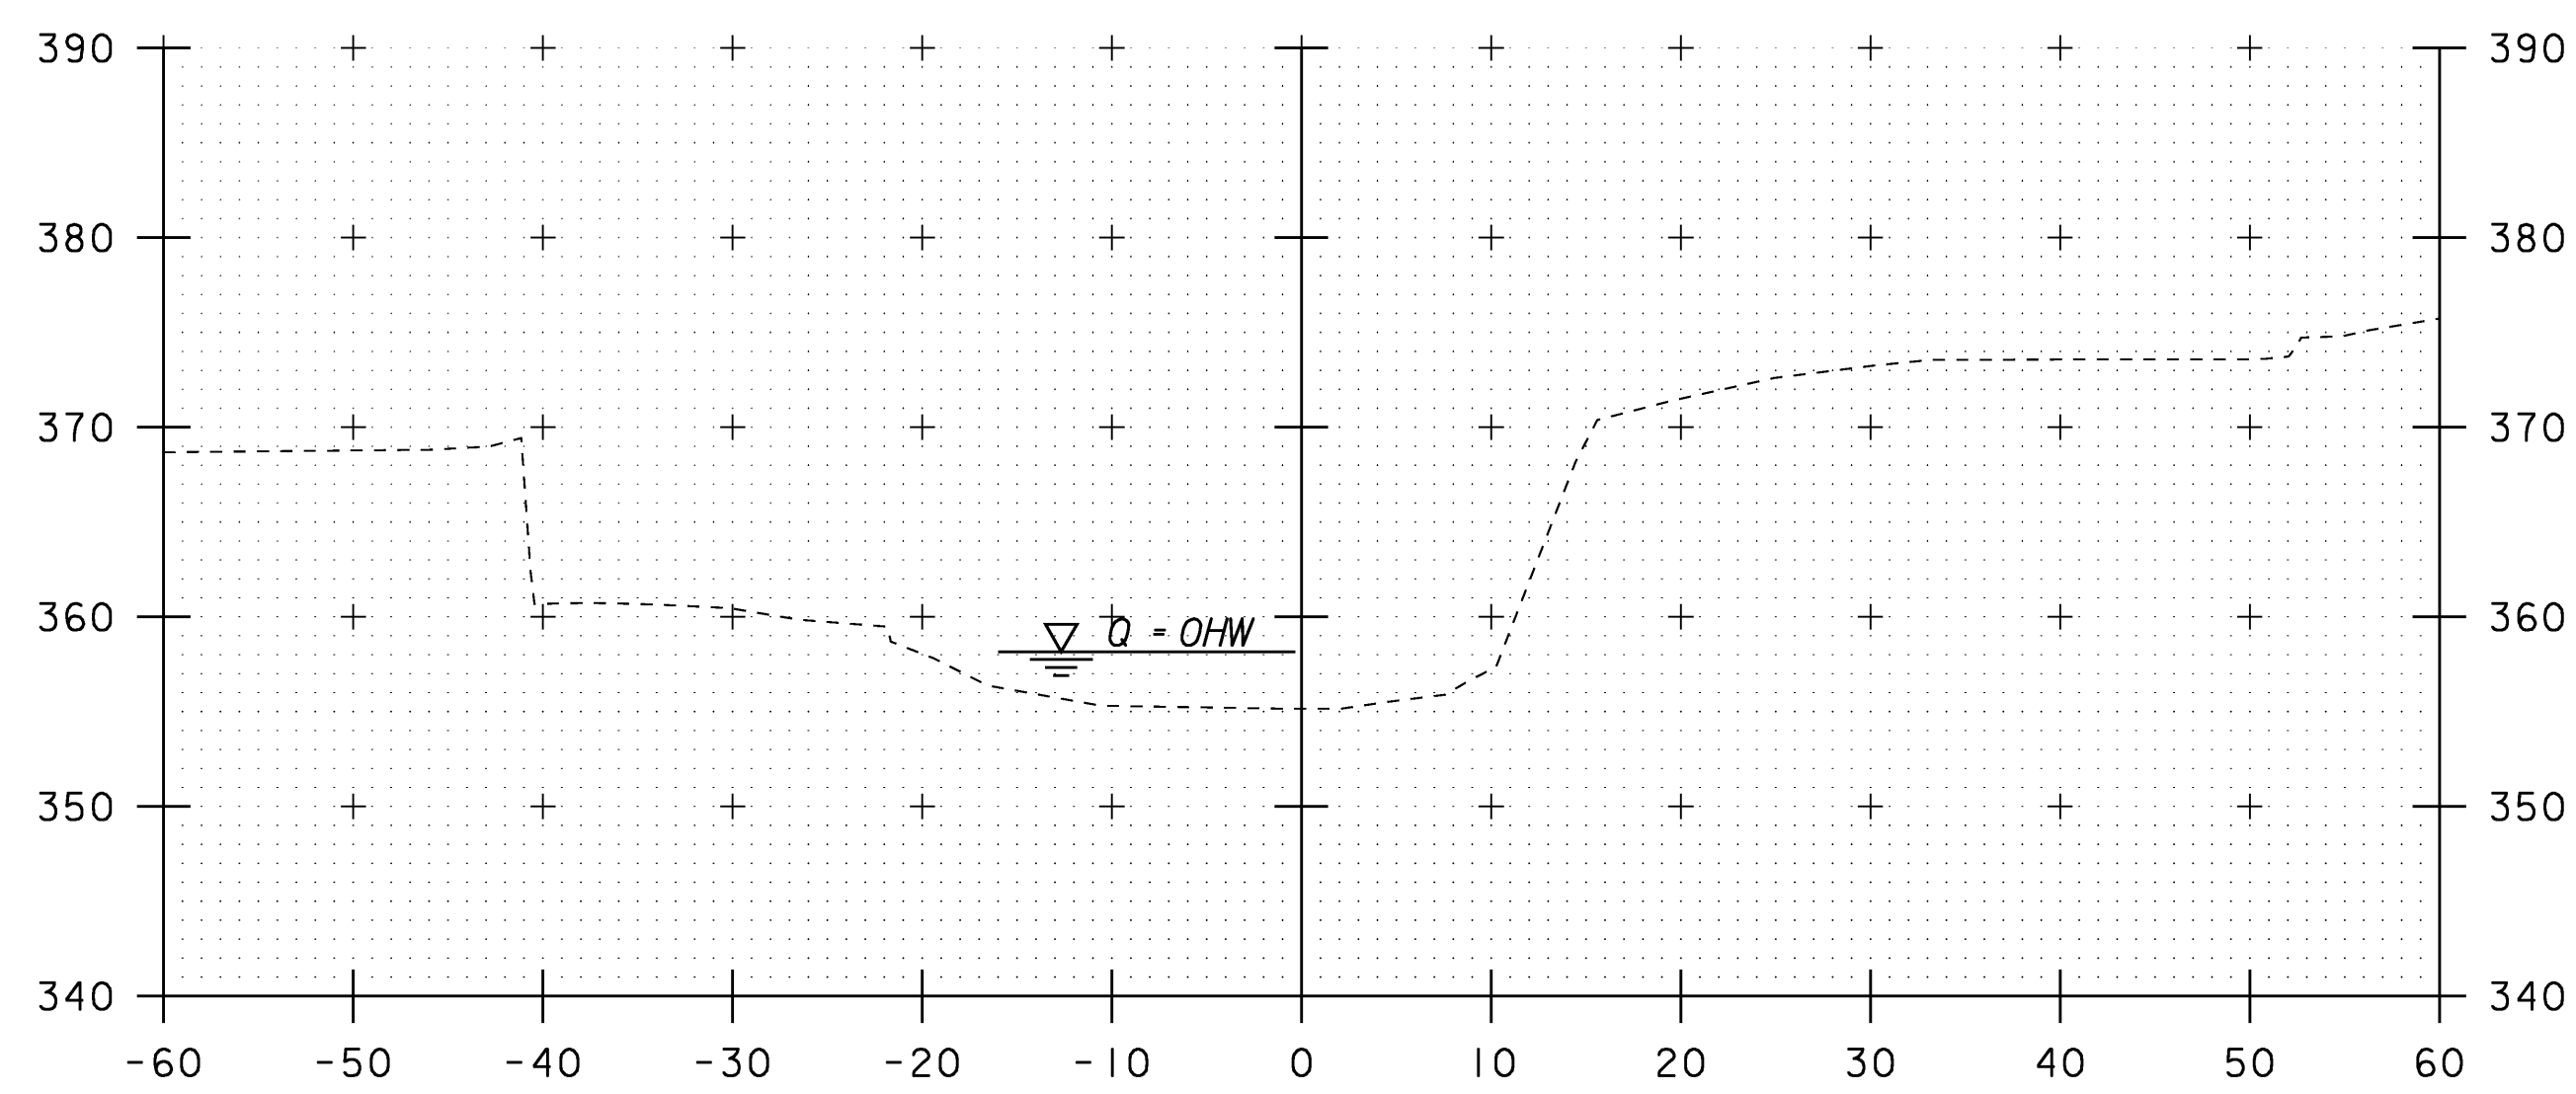


500+60

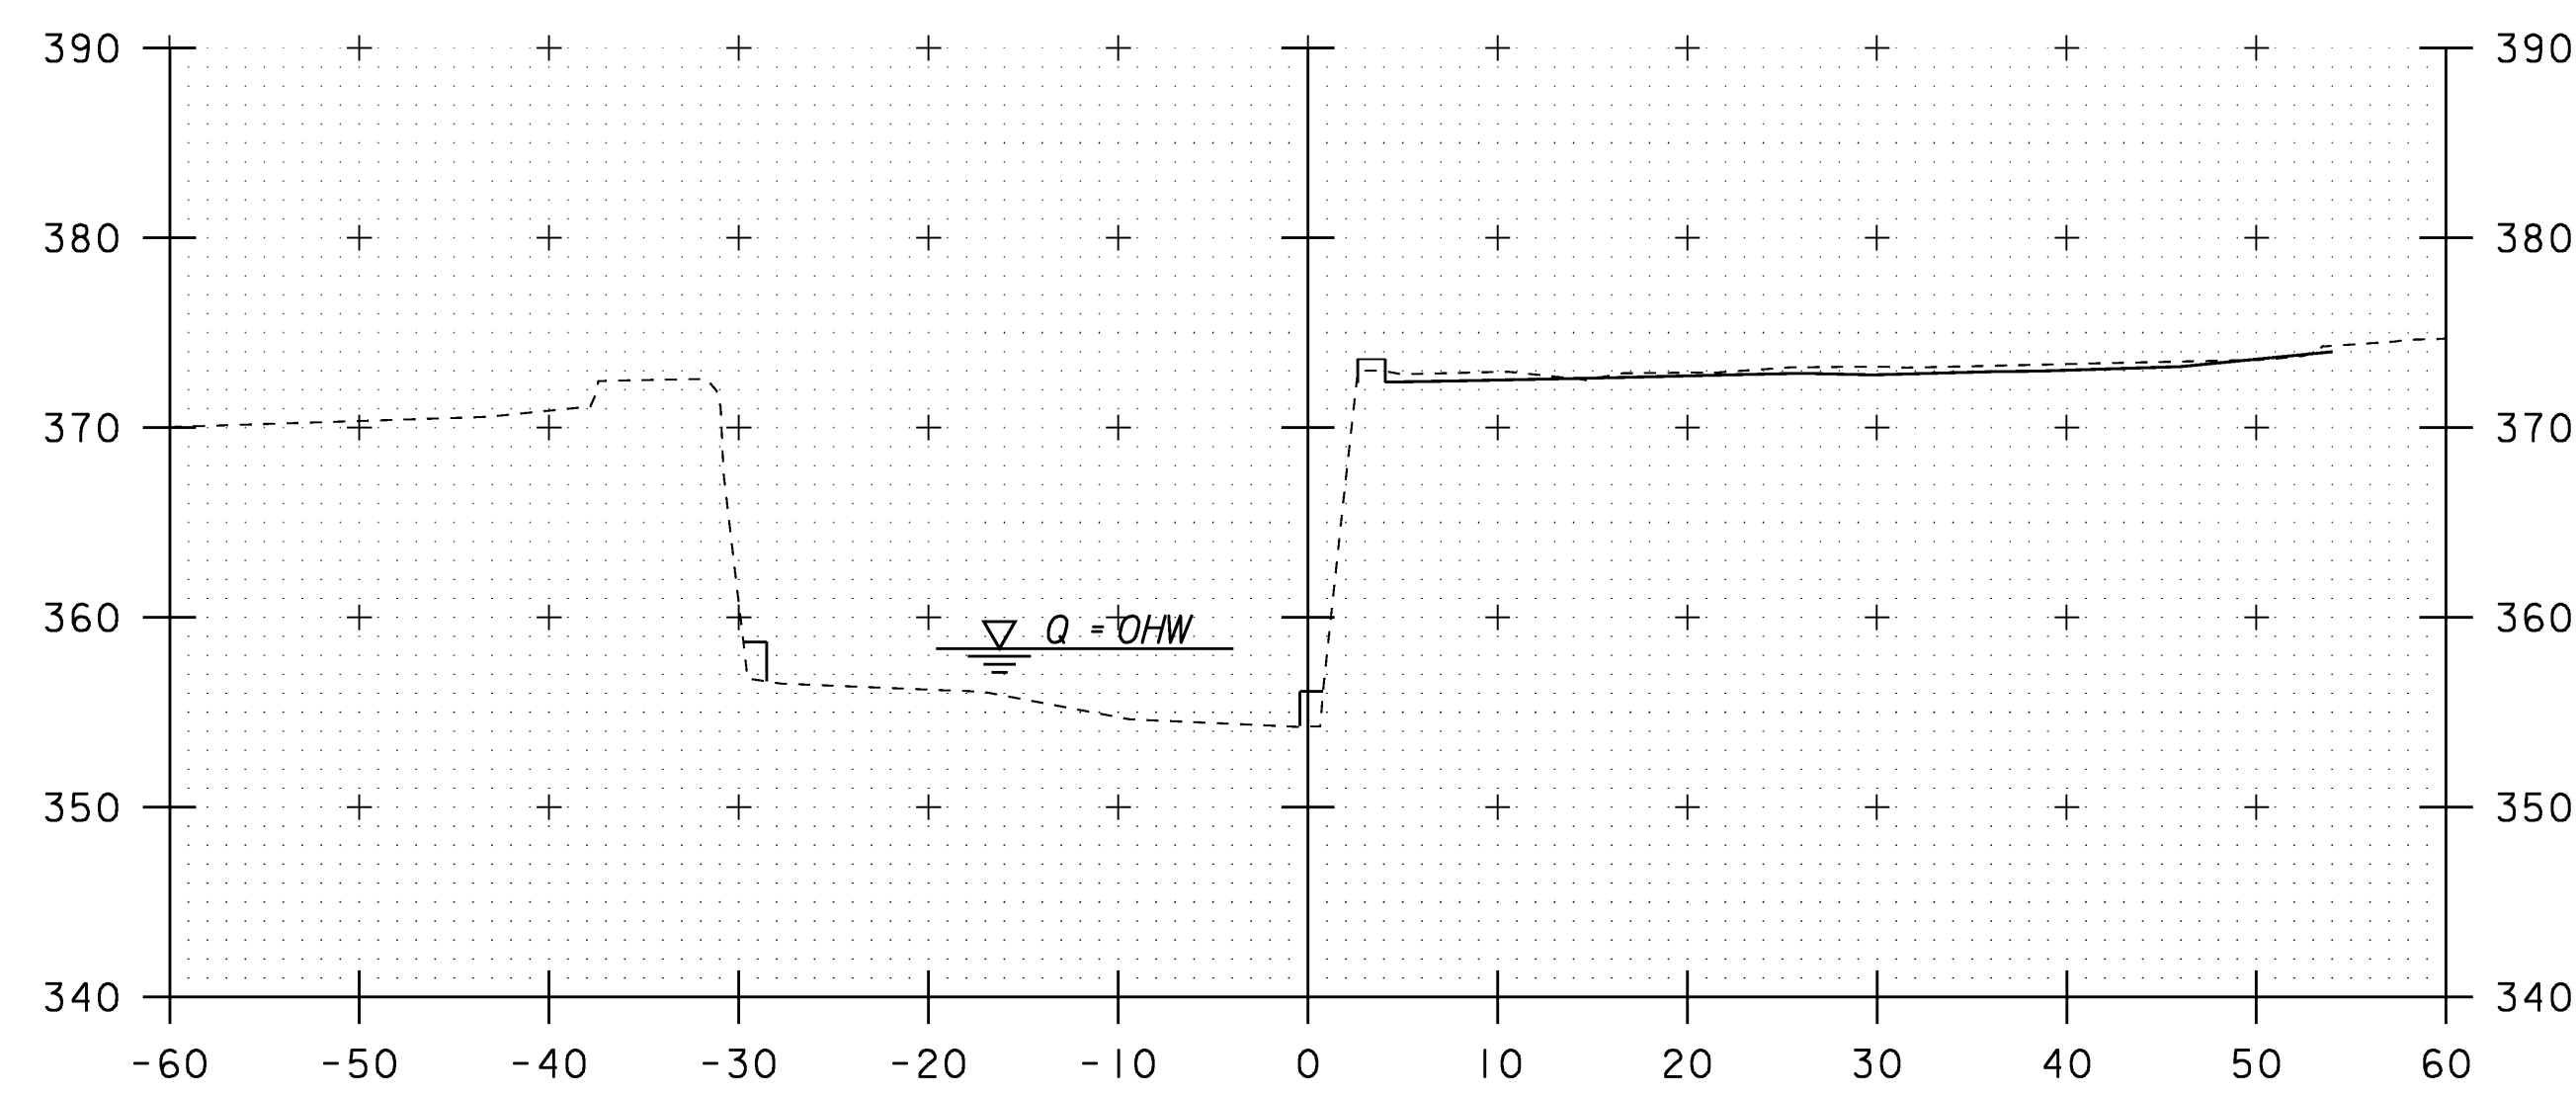

500+80

CHANNEL SECTIONS - SHEET 1

STA. 500+60 TO STA. 500+90

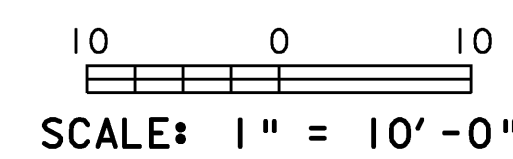

PROJECT NAME: FAIRFAX	PLOT DATE: 17-JUL-2009
PROJECT NUMBER: BHF 023-I(5)	DRAWN BY: L. BULLOCK
FILE NAME: 86e064/str/se064xs2.dgn	CHECKED BY: C. CARLSON
PROJECT LEADER: C. CARLSON	SHEET 52 OF 61
DESIGNED BY: C. CARLSON	
se064chl.l	