




501+10

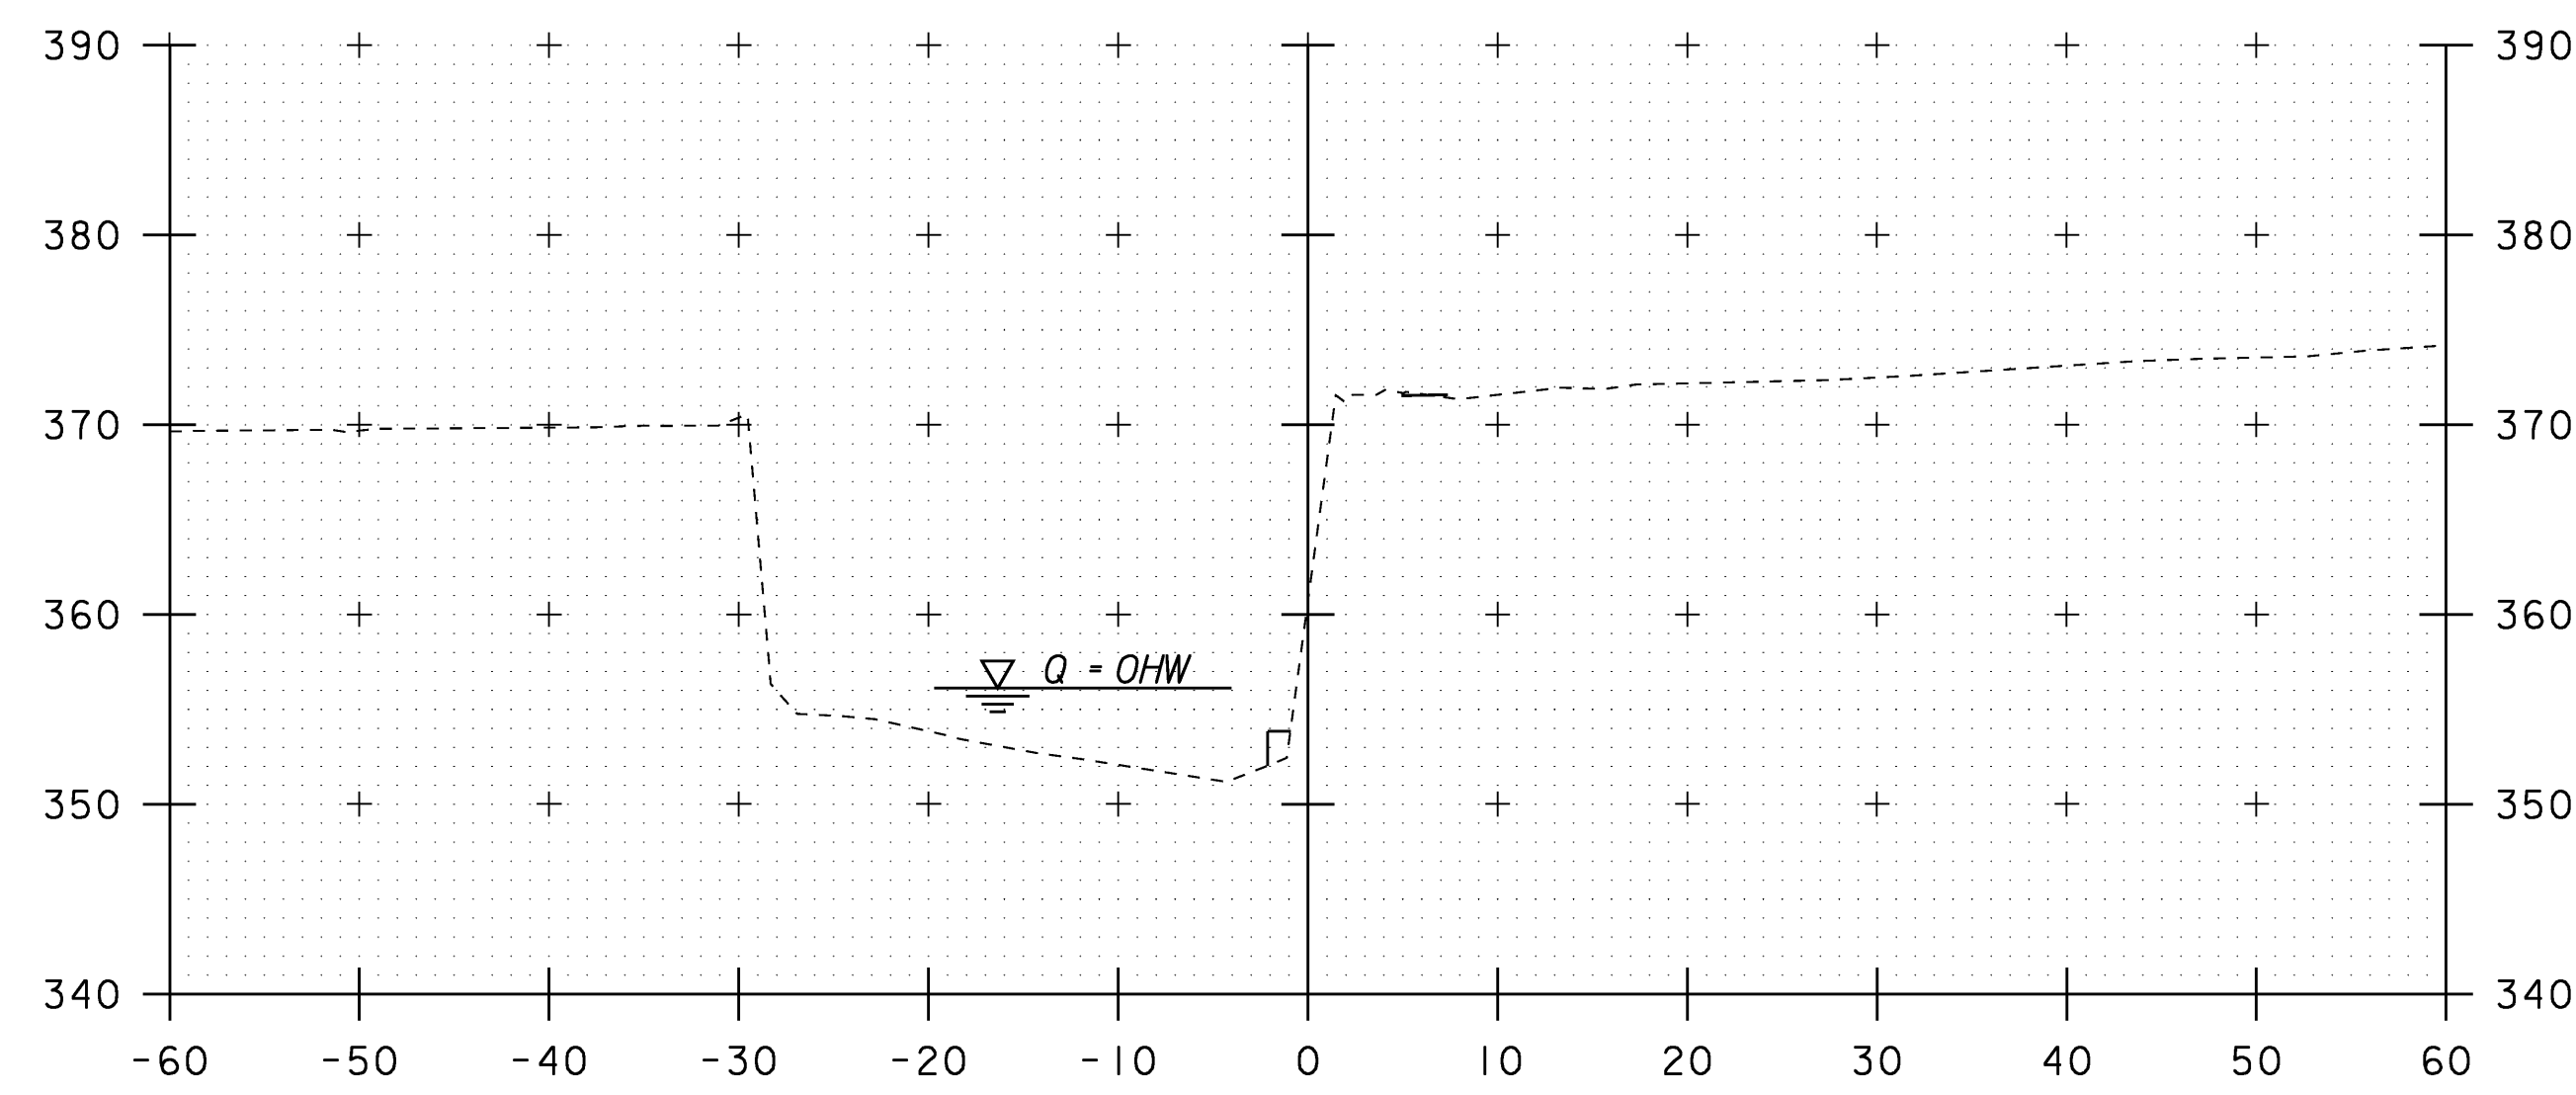

501+30

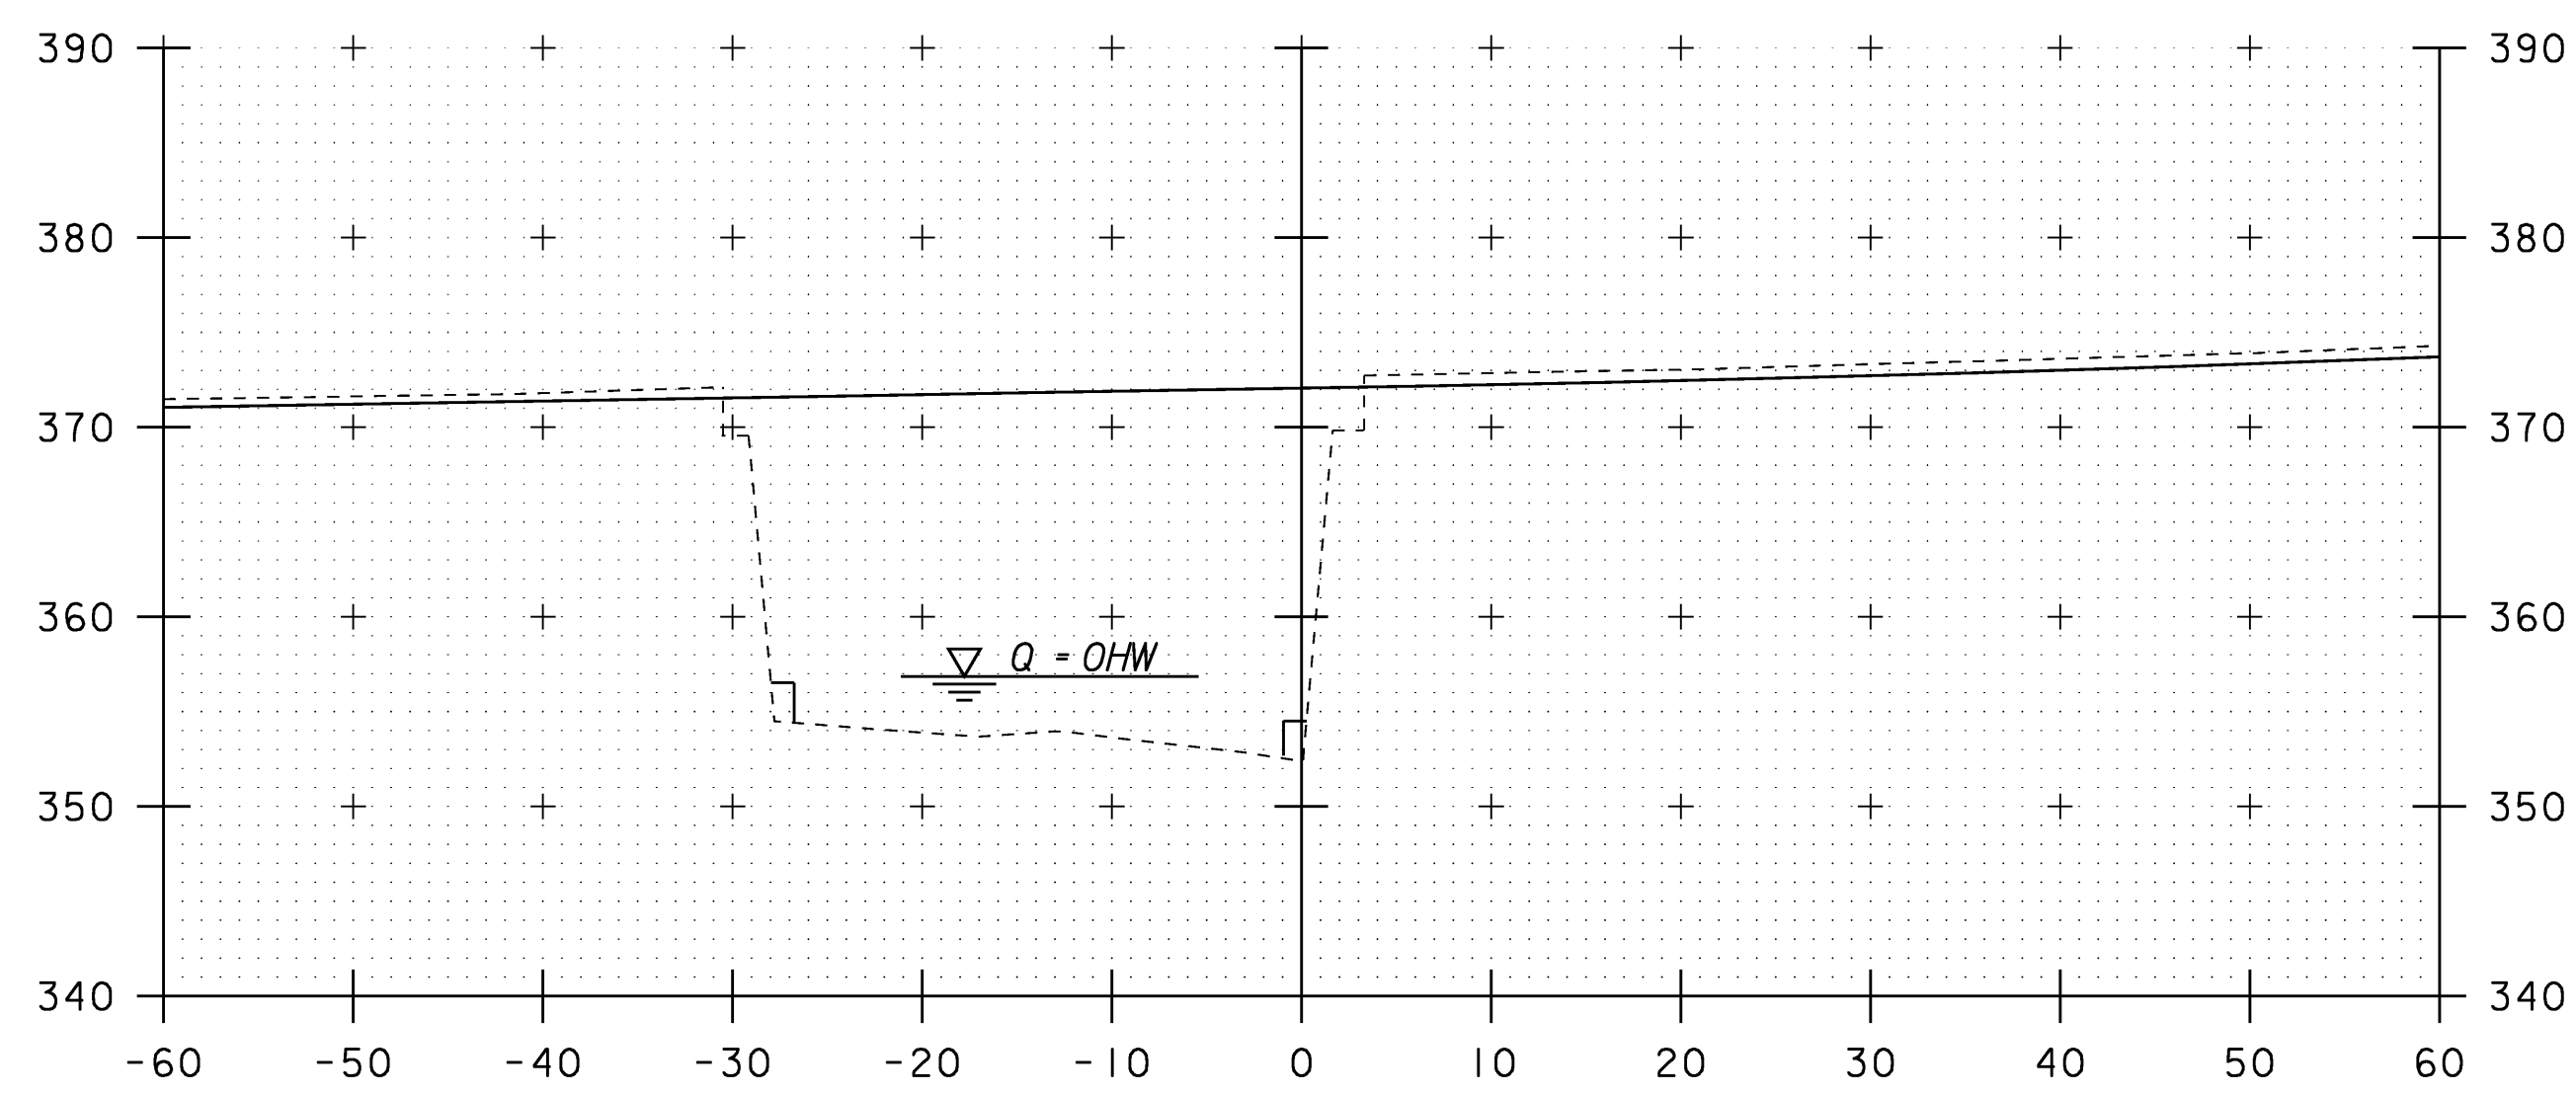


501+00

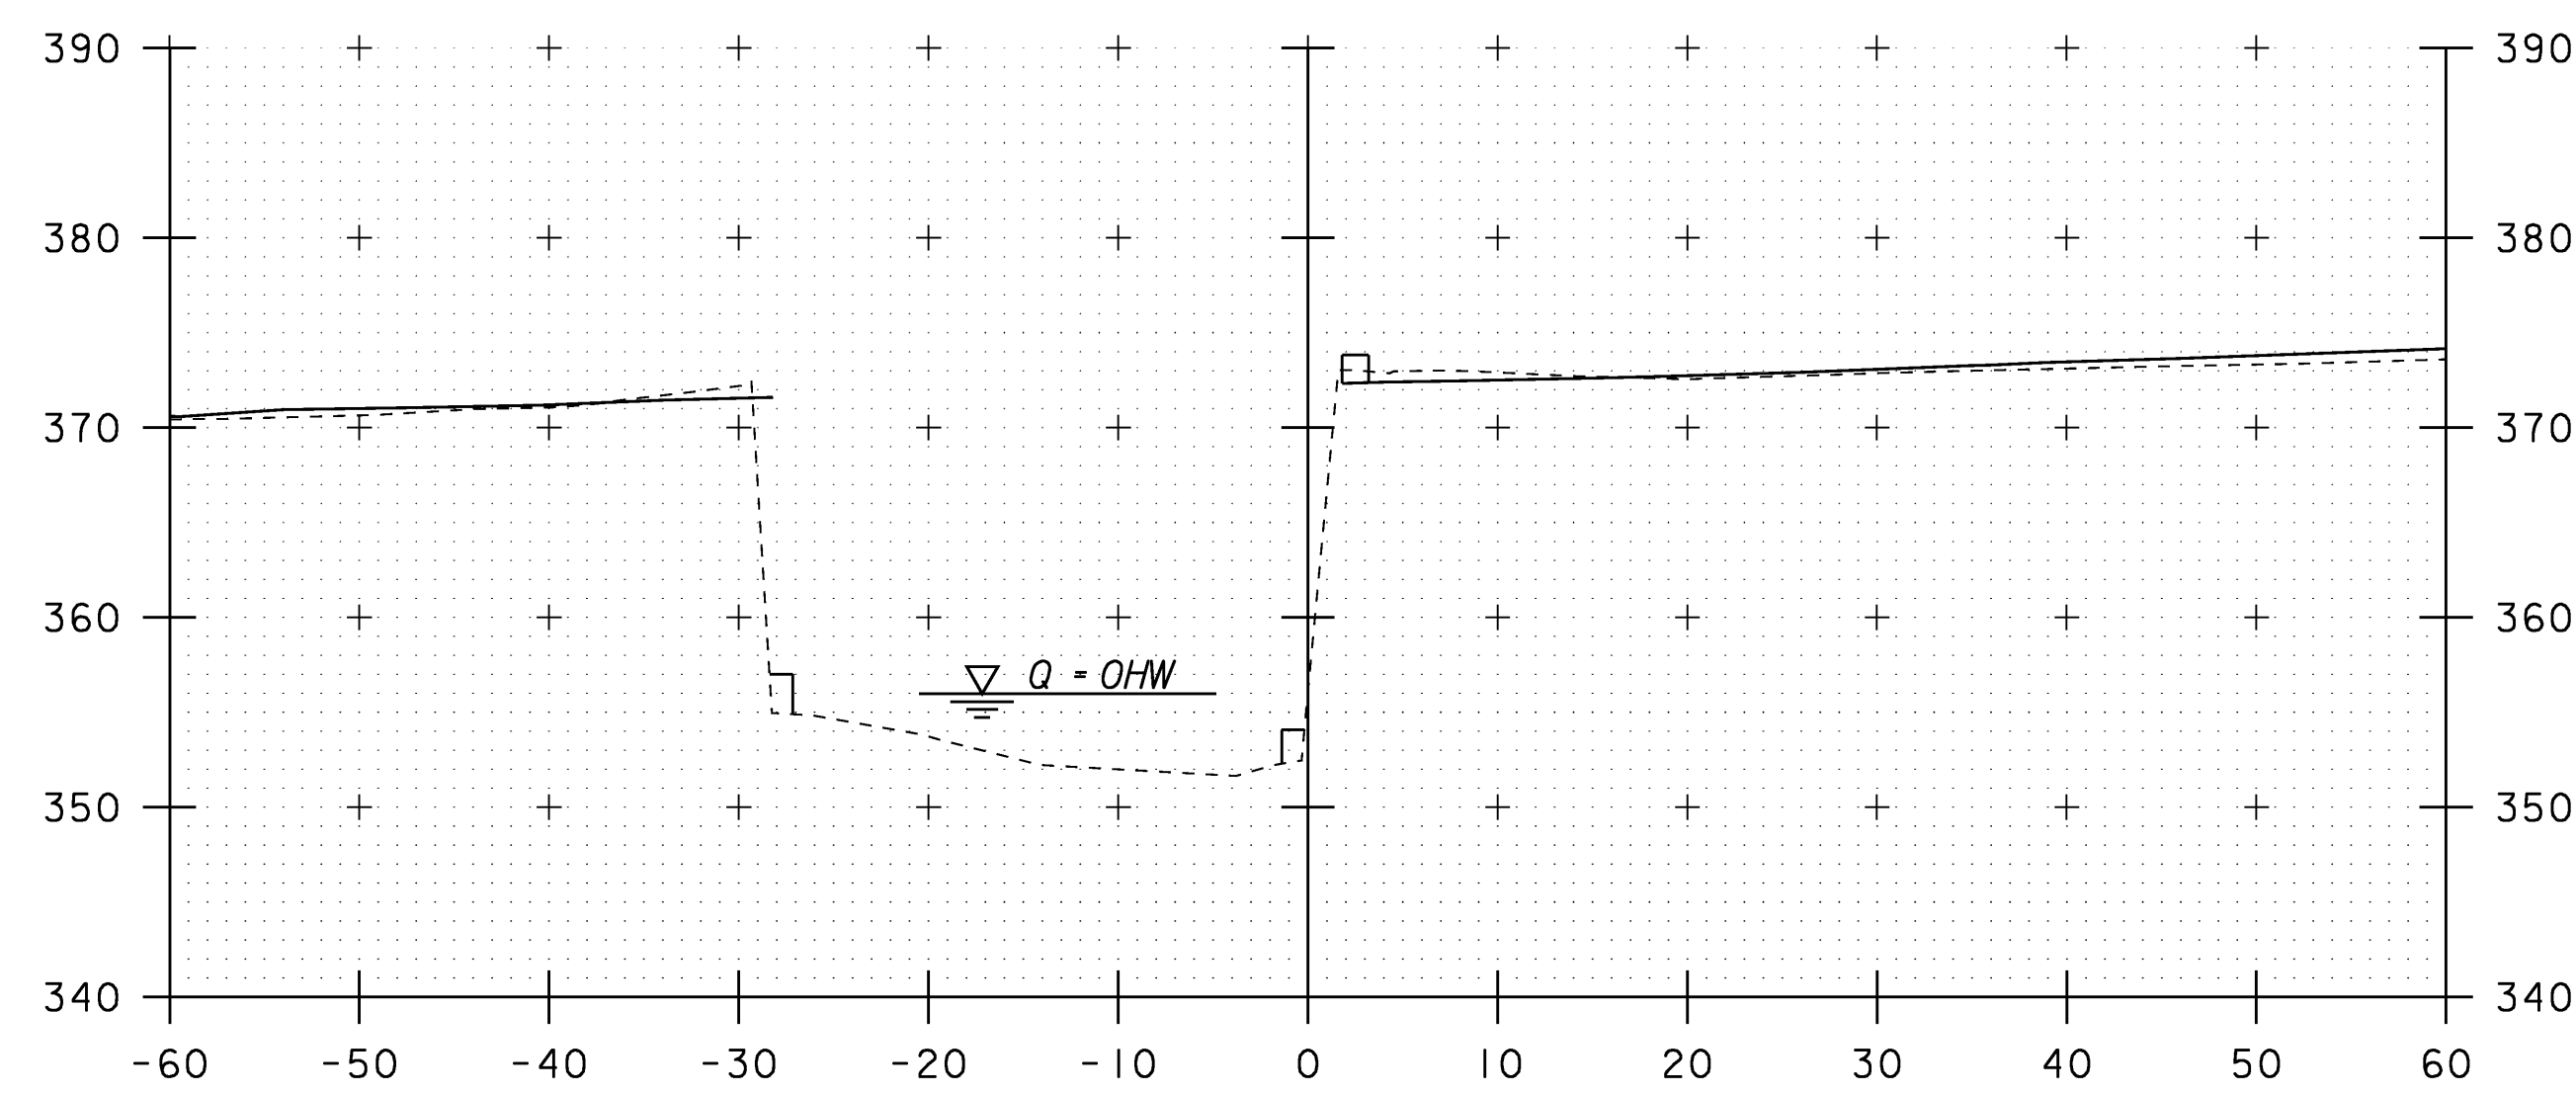

501+20

CHANNEL SECTIONS - SHEET 2

STA. 501+00 TO STA. 501+30

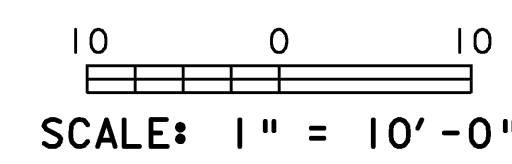

PROJECT NAME: FAIRFAX	PLOT DATE: 17-JUL-2009
PROJECT NUMBER: BHF 023-I(5)	DRAWN BY: L. BULLOCK
FILE NAME: 86e064/str/se064xs2.dgn	CHECKED BY: C. CARLSON
PROJECT LEADER: C. CARLSON	SHEET 53 OF 61
DESIGNED BY: C. CARLSON	
se064ch2.1	