

CONSTRUCT DRIVE
ML 205+71 LT. - 12' GRAVEL

COLD PLANING - BITUMINOUS CONCRETE
ML 206+50 - ML 207+00



UNDERDRAIN
ML 205+00 LT. - ML 205+50 LT.
NEW 6" UNDERDRAIN W/ FLUSHING
BASIN @ 205+50 LT.

BITUMINOUS CONCRETE SIDEWALK
ML 205+00 LT. - ML 205+87 LT.


RELOCATE MAILBOX, SINGLE SUPPORT
ML 205+53 LT.

CONSTRUCT SIDEWALK RAMP
ML 205+55 LT. - ML 205+63 LT. (TYPE 1)
ML 205+79 LT. - ML 205+87 LT. (TYPE 1)

CAS-IN-PLACE CONCRETE CURB, TYPE B
ML 205+00 LT. - ML 205+63 LT.

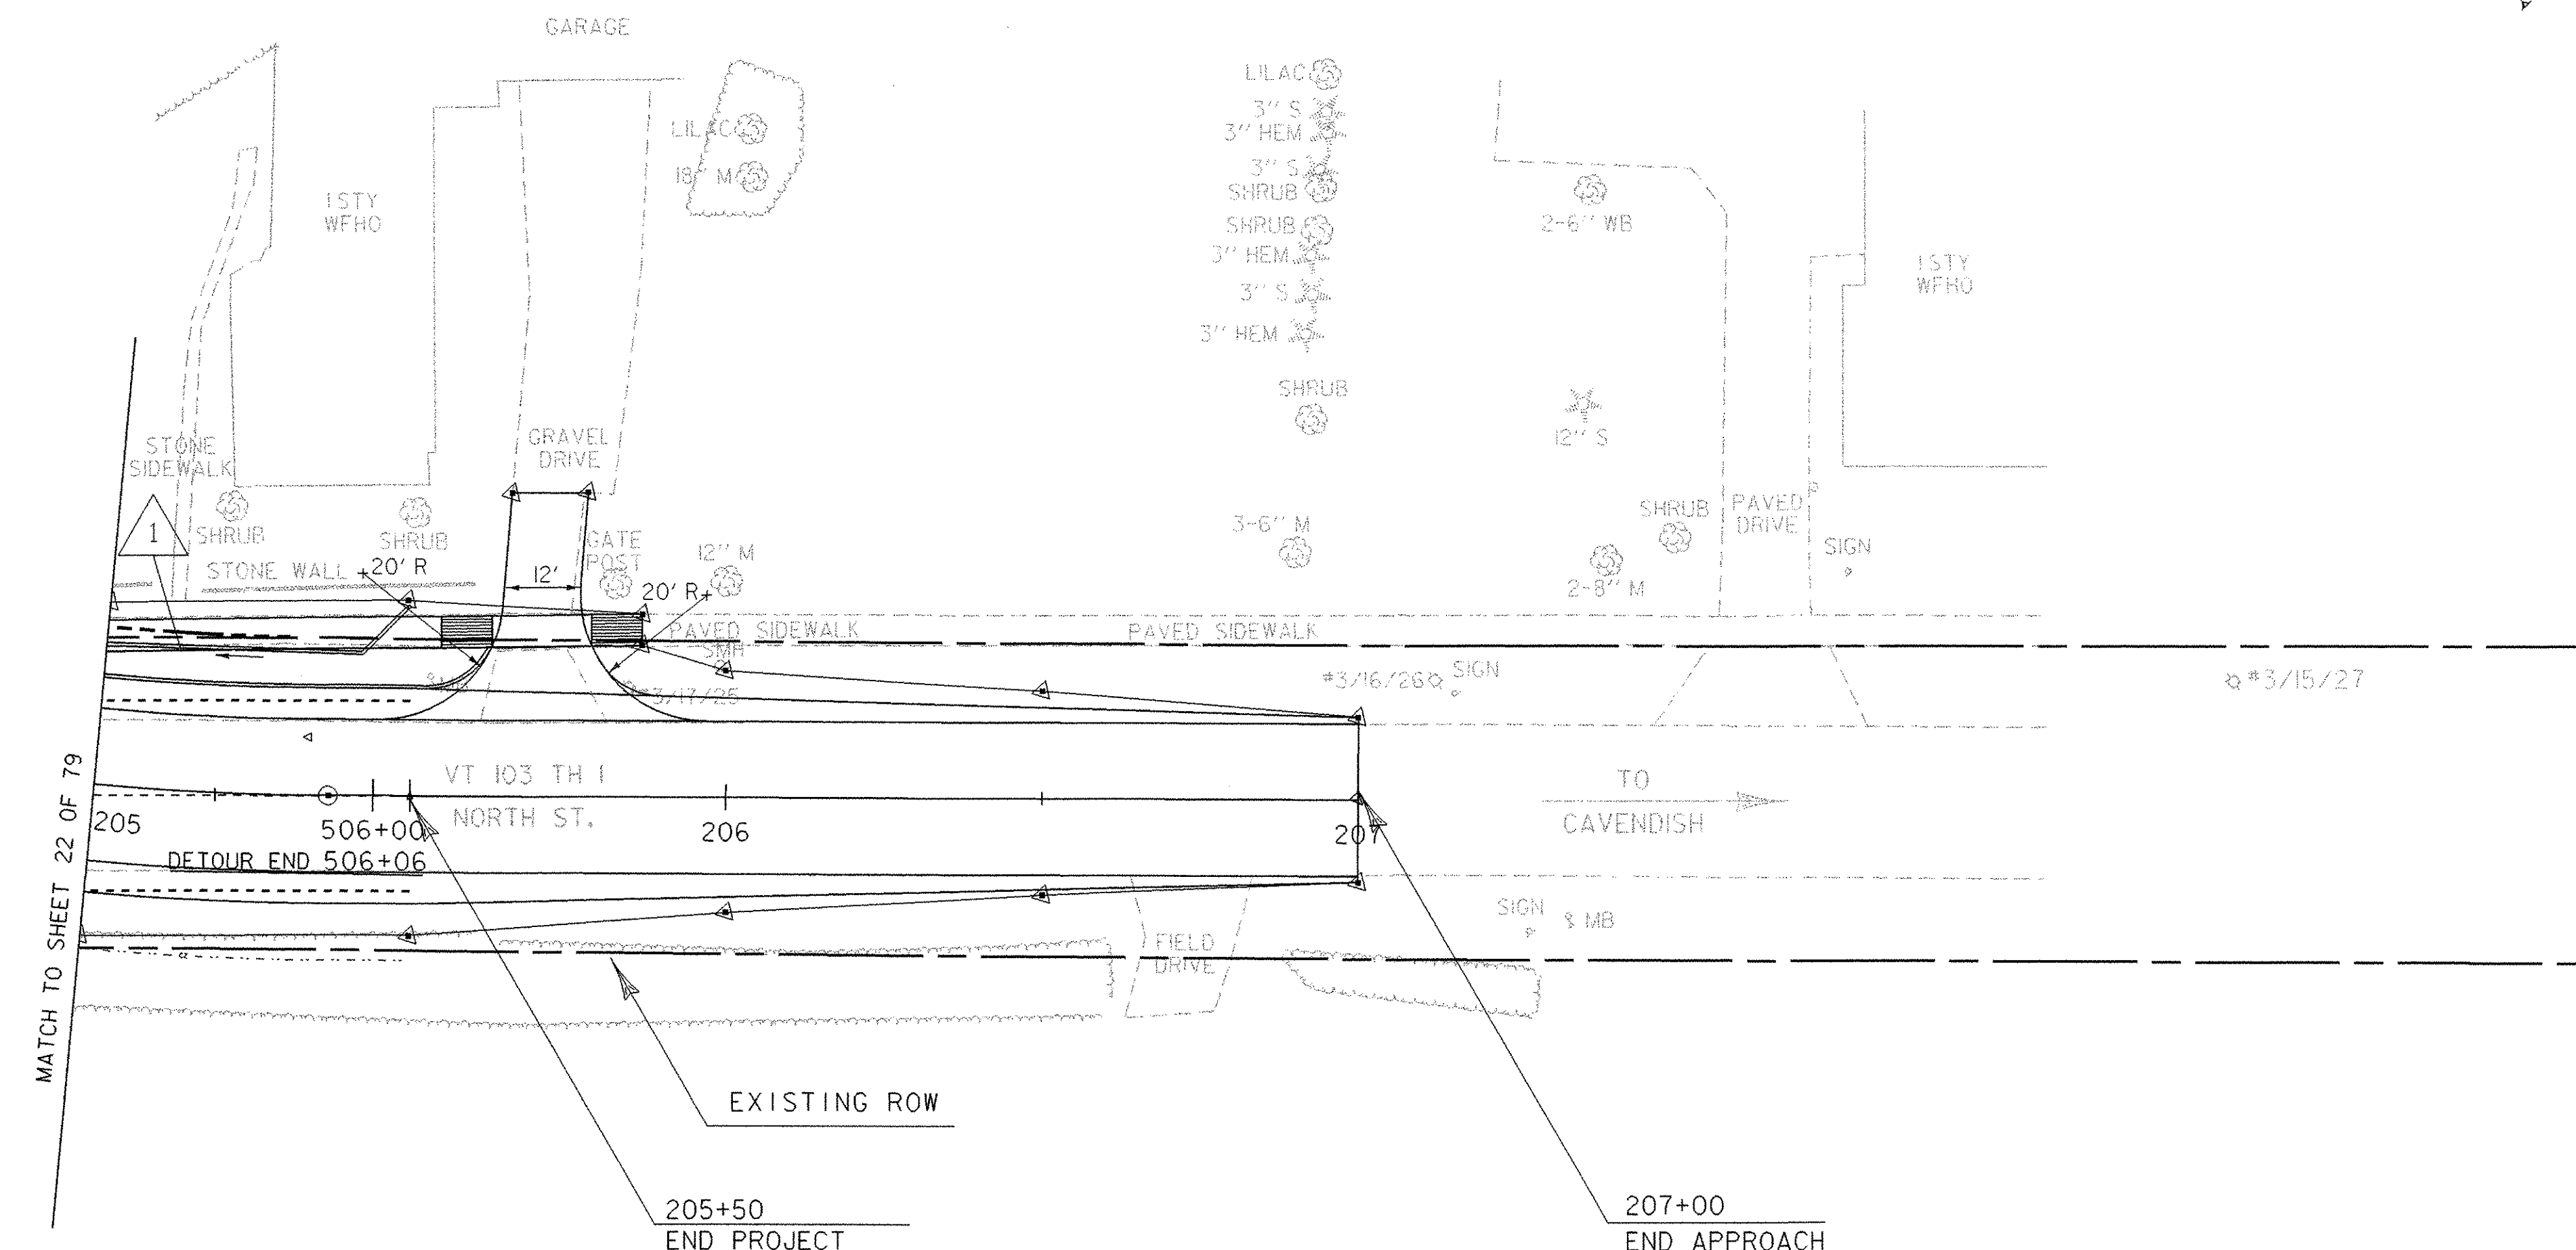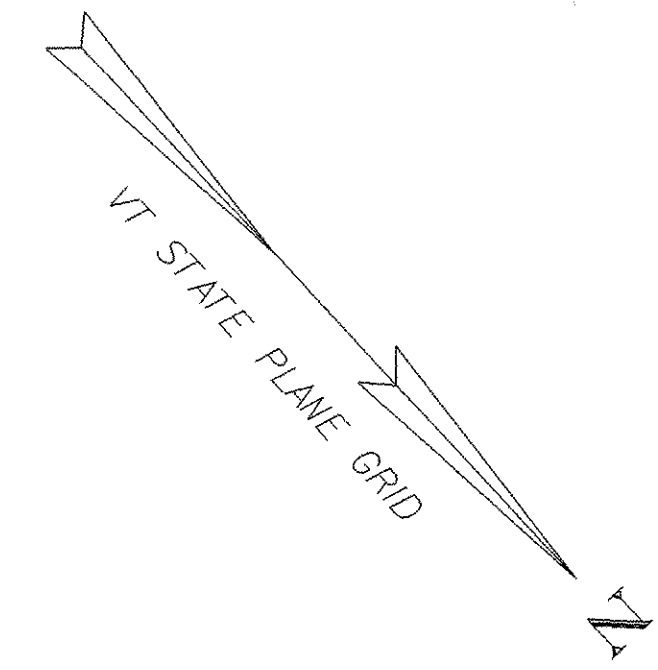

DATUM	
VERTICAL	NGVD 1929
HORIZONTAL	NAD 1927

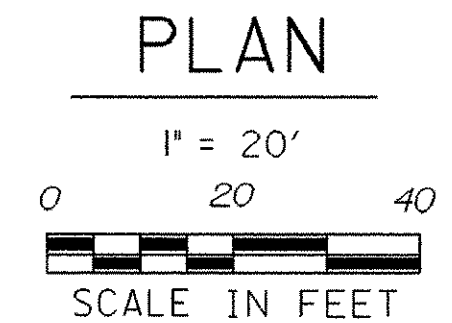

SURVEYED BY	SHERIDAN	DATE	08-90
DRAWN BY	L. BULLOCK	DATE	11-90
SQUAD LEADER	PORTALUPI		
DESIGN FILE NO.	M:\1549101\VA0T-Chester Curv		
IPARM NAME	zfi3413.1	DATE PLOTTED	28-MAY-2003
PROJ. NAME	CHESTER		
PROJ. NO.	BRF 025-I(35)		
SHEET	23	OF	79 SHEETS