


VT 103 PROFILE 2

1" = 10' V
1" = 20' H

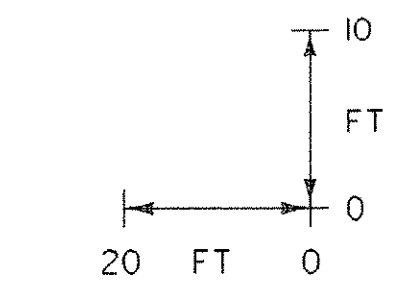

DATUM	
VERTICAL	NGVD 1929
HORIZONTAL	NAD 1928

PROJECT:	CHESTER	PROJECT NO.:	BRF 025-I(35)
DESIGN FILE NAME:	M:\1549101\VA01_Chester_Curv\HWY\DRAW\zfi34xs5.dgn	PLOT DATE:	28-MAY-2003
IPARM FILE NAME:	zfi34pf2.i	SURVEY DATE:	8/90
SURVEYED BY:	SHERIDAN	DRAWN BY:	T. LACKEY
SQUAD LEADER:	PORTALUPI	SHEET:	25 OF 79