


### TH 6 PROFILE I

1" = 10' V  
1" = 20' H

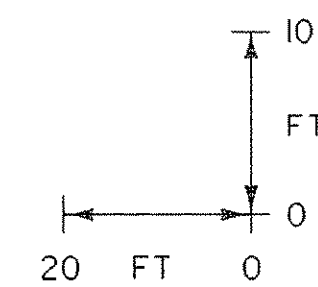

**DATUM**  
VERTICAL NGVD 1929  
HORIZONTAL NAD 1927

PROJECT:	CHESTER	PROJECT NO.:	BRF025-I(35)
DESIGN FILE NAME:	M:\87b134\Structures\zf134xs5.dgn	PLOT DATE:	28-MAY-2003
IPARM FILE NAME:	zf134pf3.1	SURVEY DATE:	8/90
SURVEYED BY:	SHERIDAN	DRAWN BY:	L. BULLOCK
SQUAD LEADER:	PORTALUPI	SHEET:	26 OF 76