



MAINLINE BANKING TRANSITION DIAGRAM

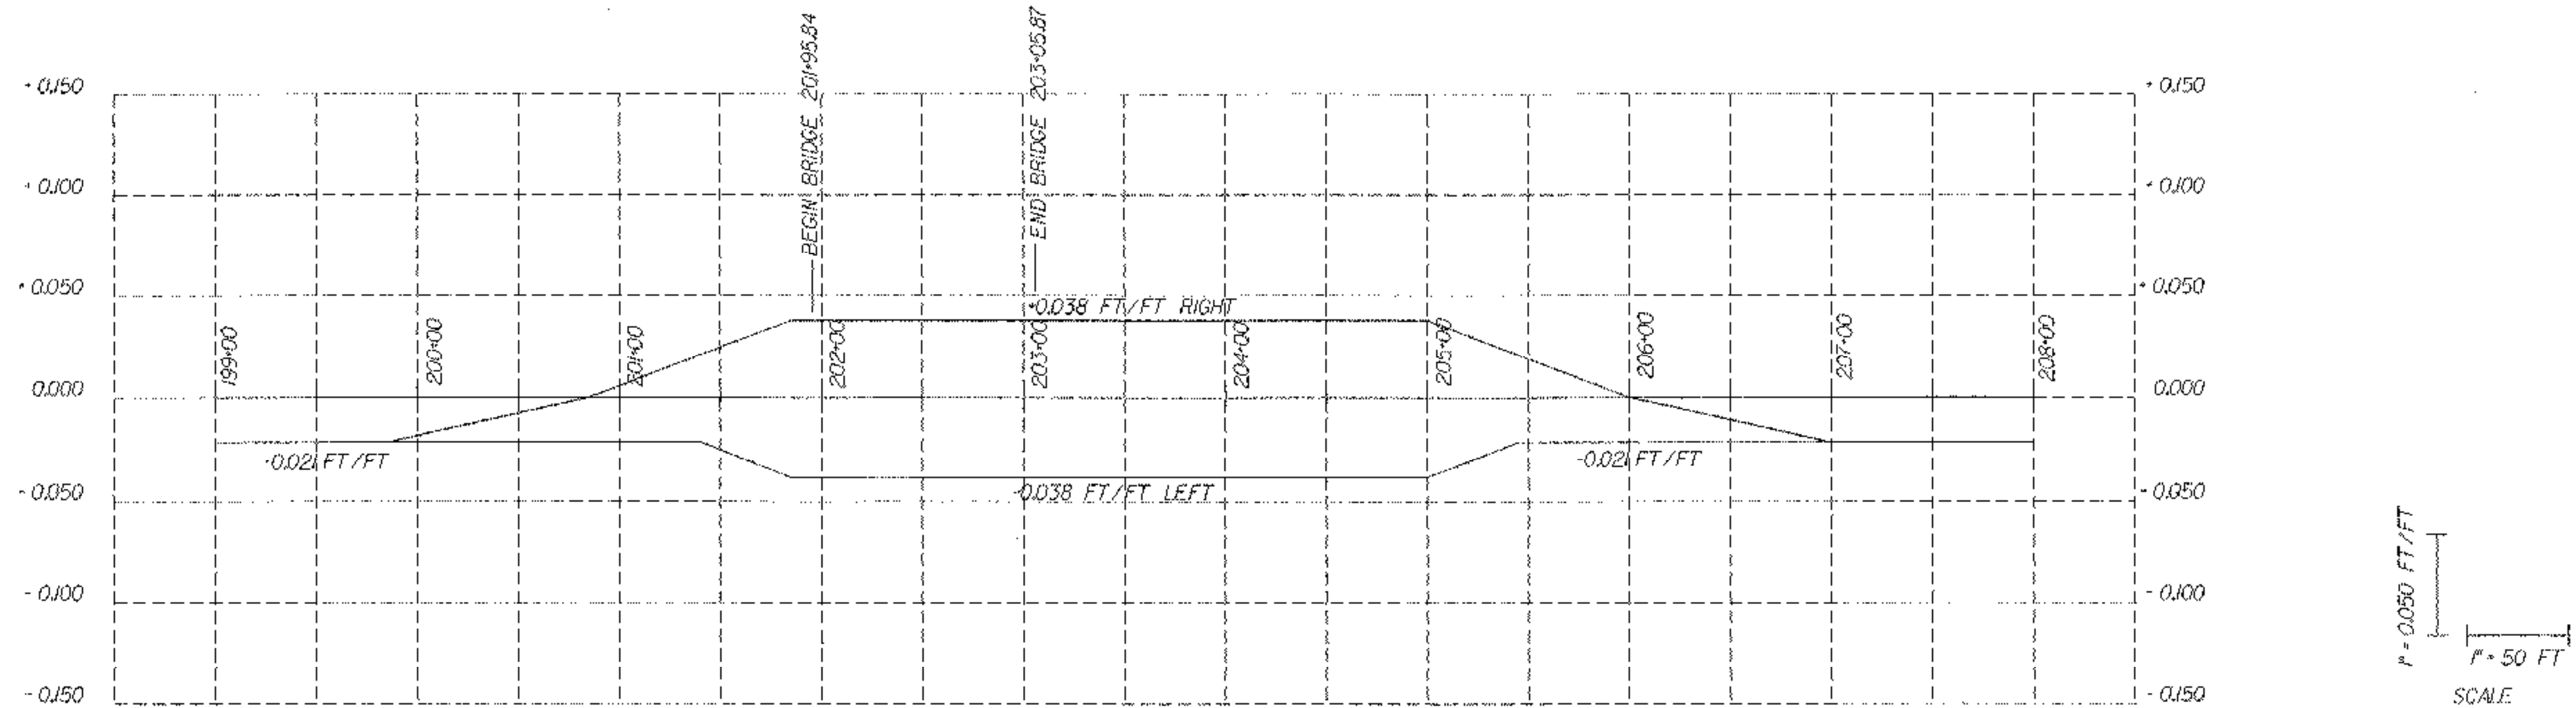

MAINLINE MATERIAL TRANSITION DIAGRAM

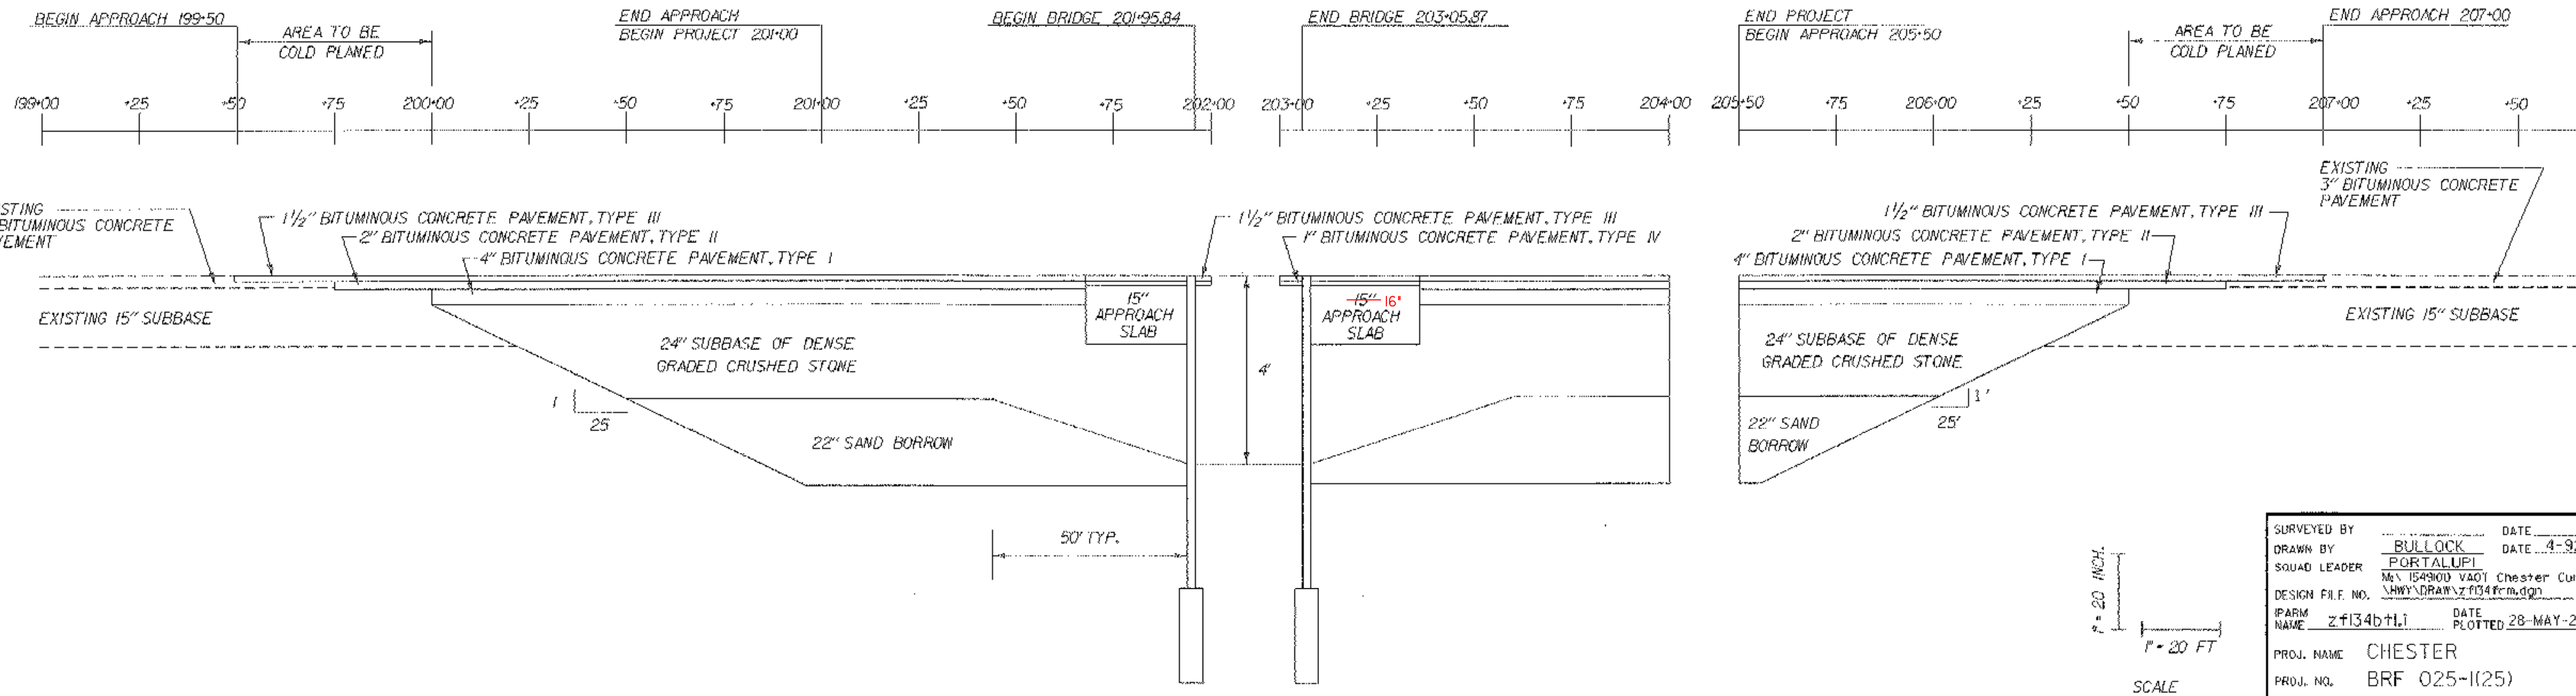

SURVEYED BY	BULLOCK	DATE	4-92
DRAWN BY	PORTALUPI	DATE	4-92
SQUAD LEADER	PORTALUPI		
DESIGN FILE NO.	MSV 154900 V401 Chester Curv \\HWY\DRAW\27034\cm.dgn		
IPARM	z:f134b+li	DATE	28-MAY-2003
NAME	z:f134b+li	DATE	28-MAY-2003
PROJ. NAME	CHESTER		
PROJ. NO.	BRF 025-1(25)		
SHEET	27	OF	79 SHEETS