

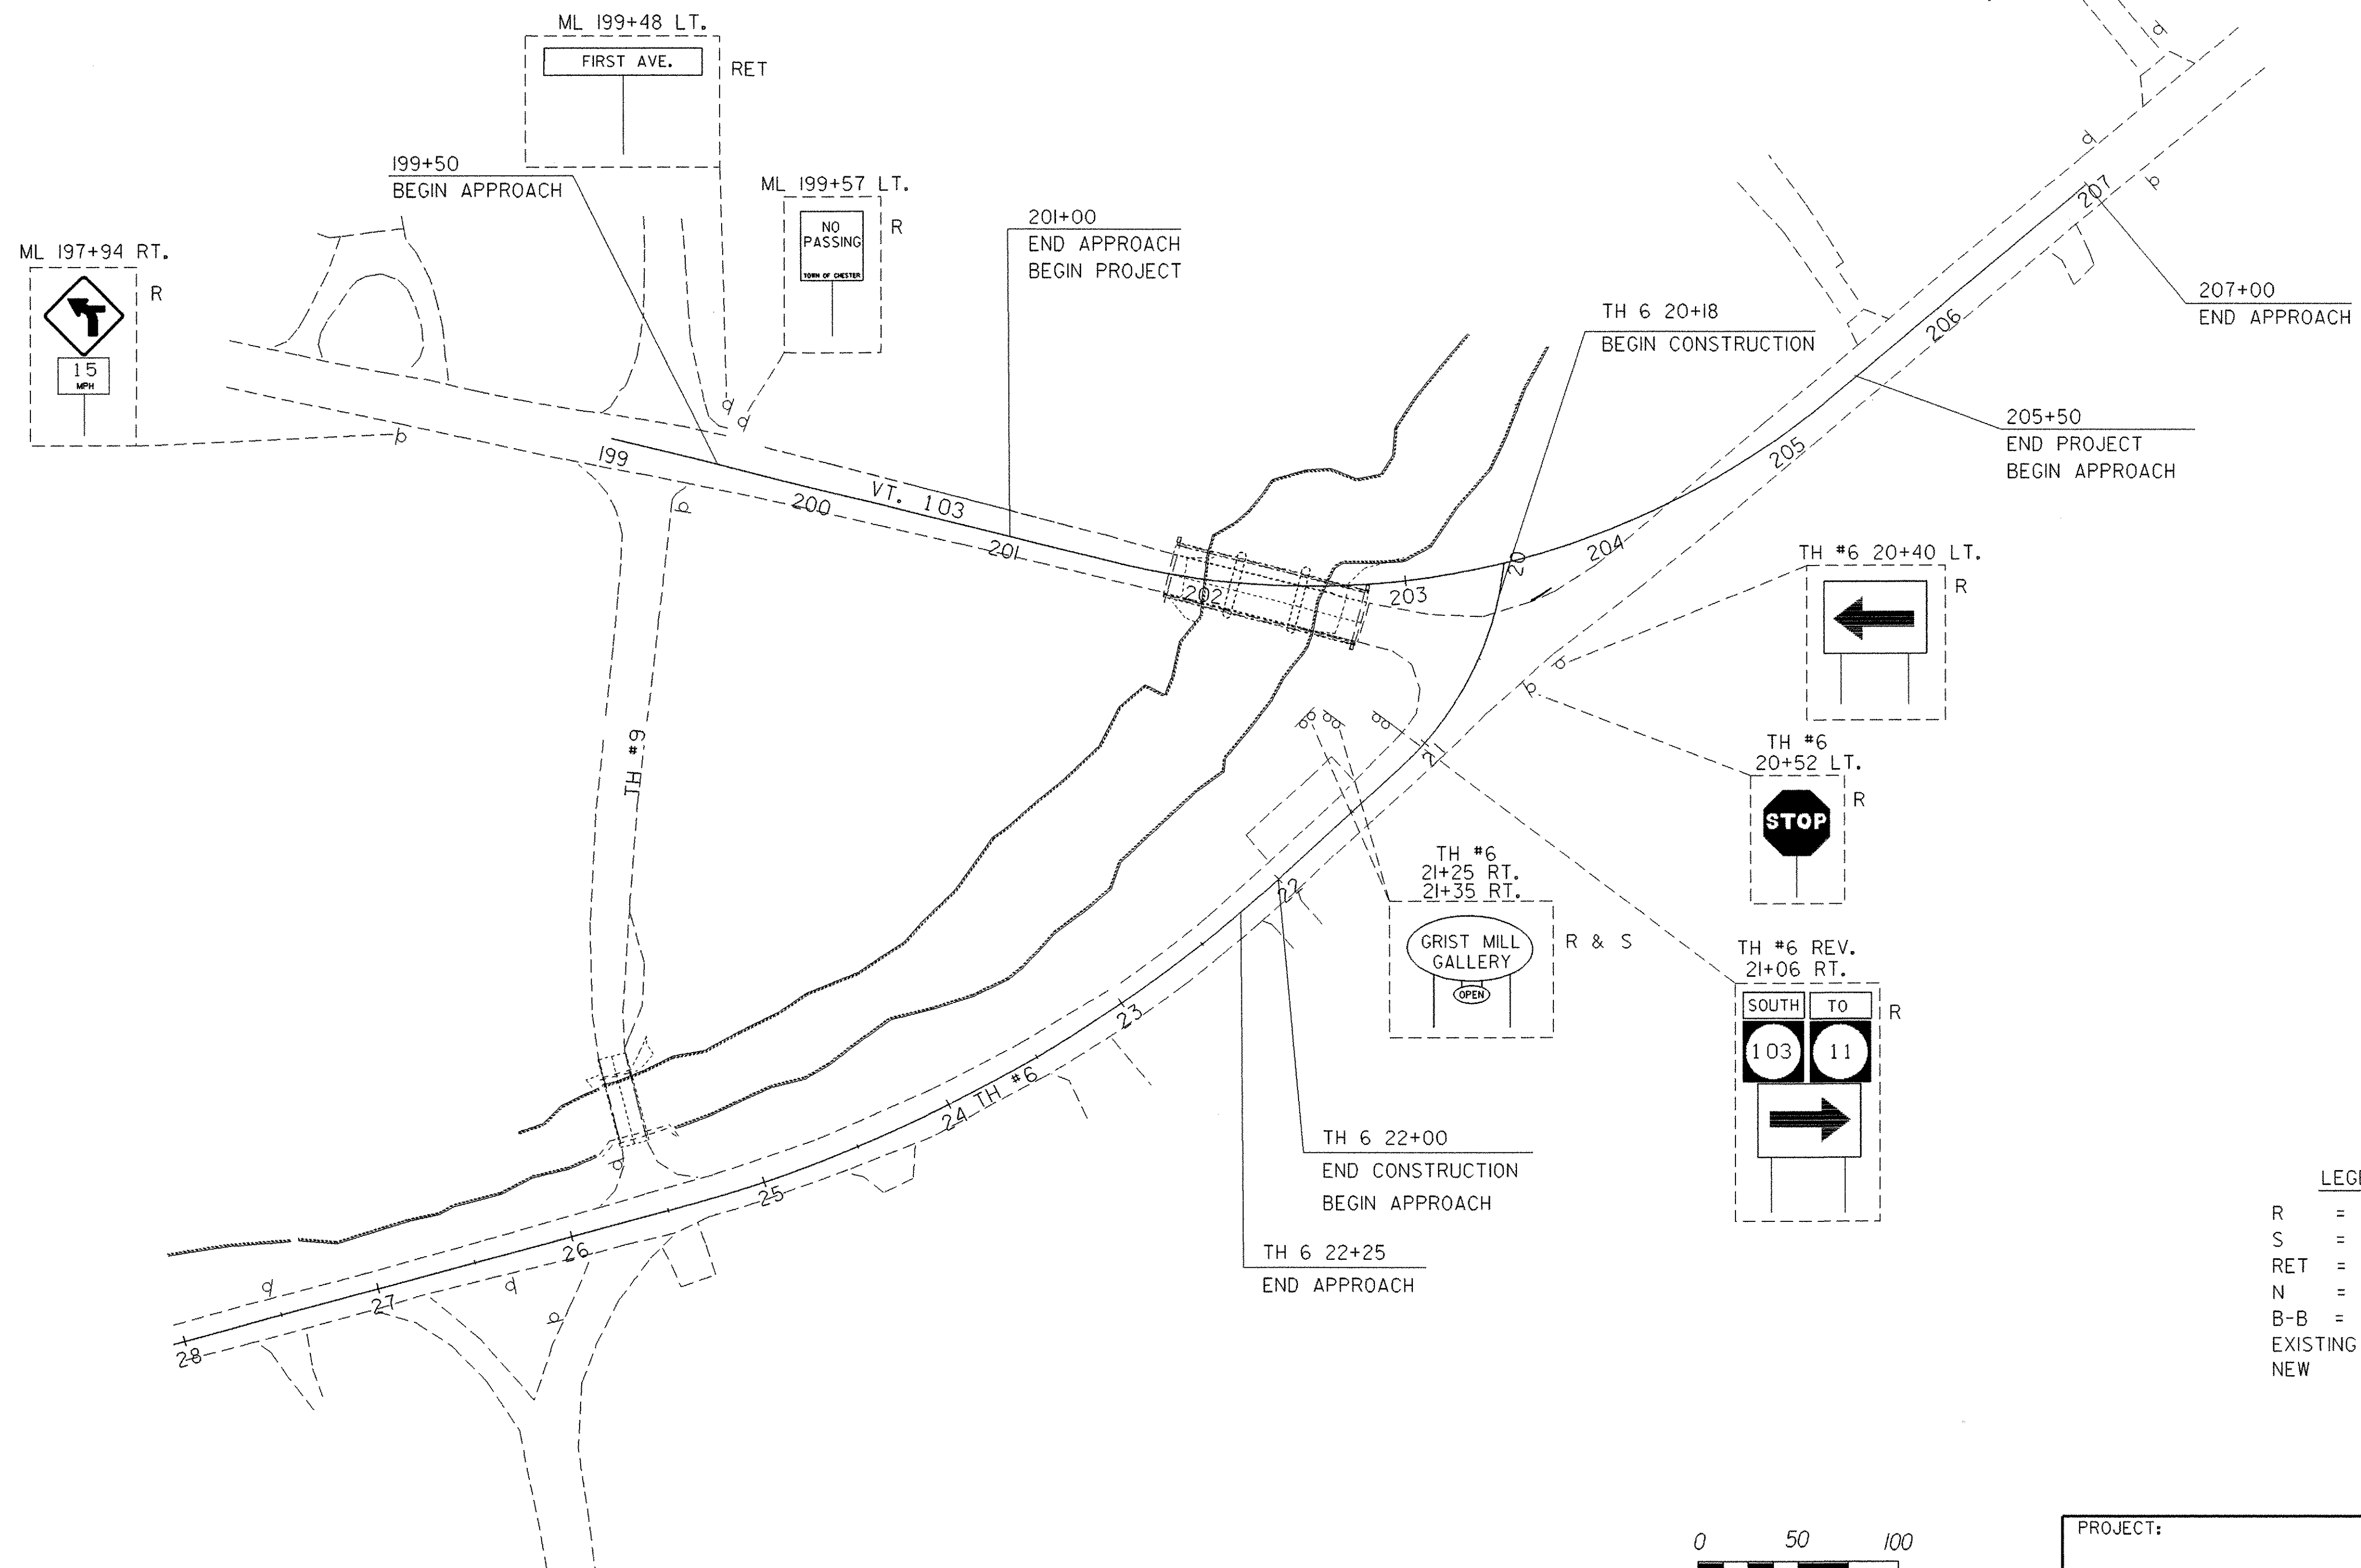


EXISTING TRAFFIC SIGNS

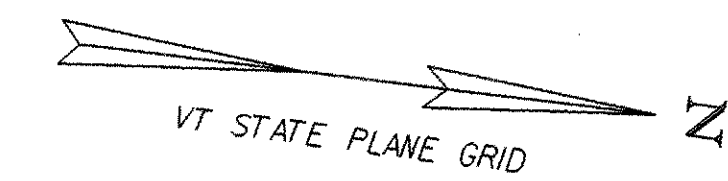

LEGEND

- R = REMOVE
- S = SALVAGE
- RET = RETAIN
- N = NEW
- B-B = BACK TO BACK
- EXISTING - - - - -
- NEW - - - - -

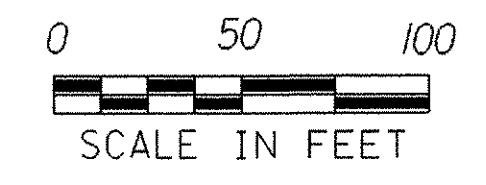

PROJECT:	PROJECT NO.:
DESIGN FILE NAME:	PLOT DATE: 28-MAY-2003
IPARM FILE NAME: zfi34+cl.i	SURVEY DATE:
SURVEYED BY:	DRAWN BY:
SQUAD LEADER:	SHEET: 31 OF 79
TRAFFIC CONTROL SHEET I	