



UTILITY PLAN

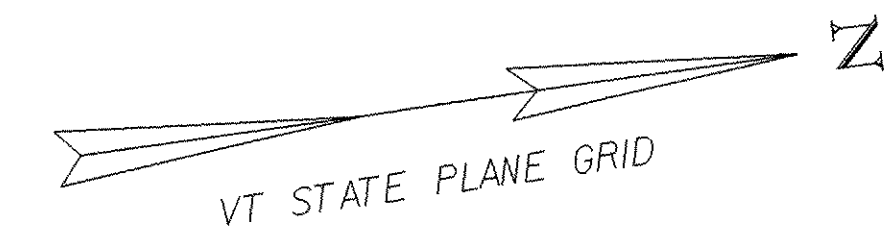


BM #1
RAILROAD SPIKE IN POLE
ELEV 591.26'

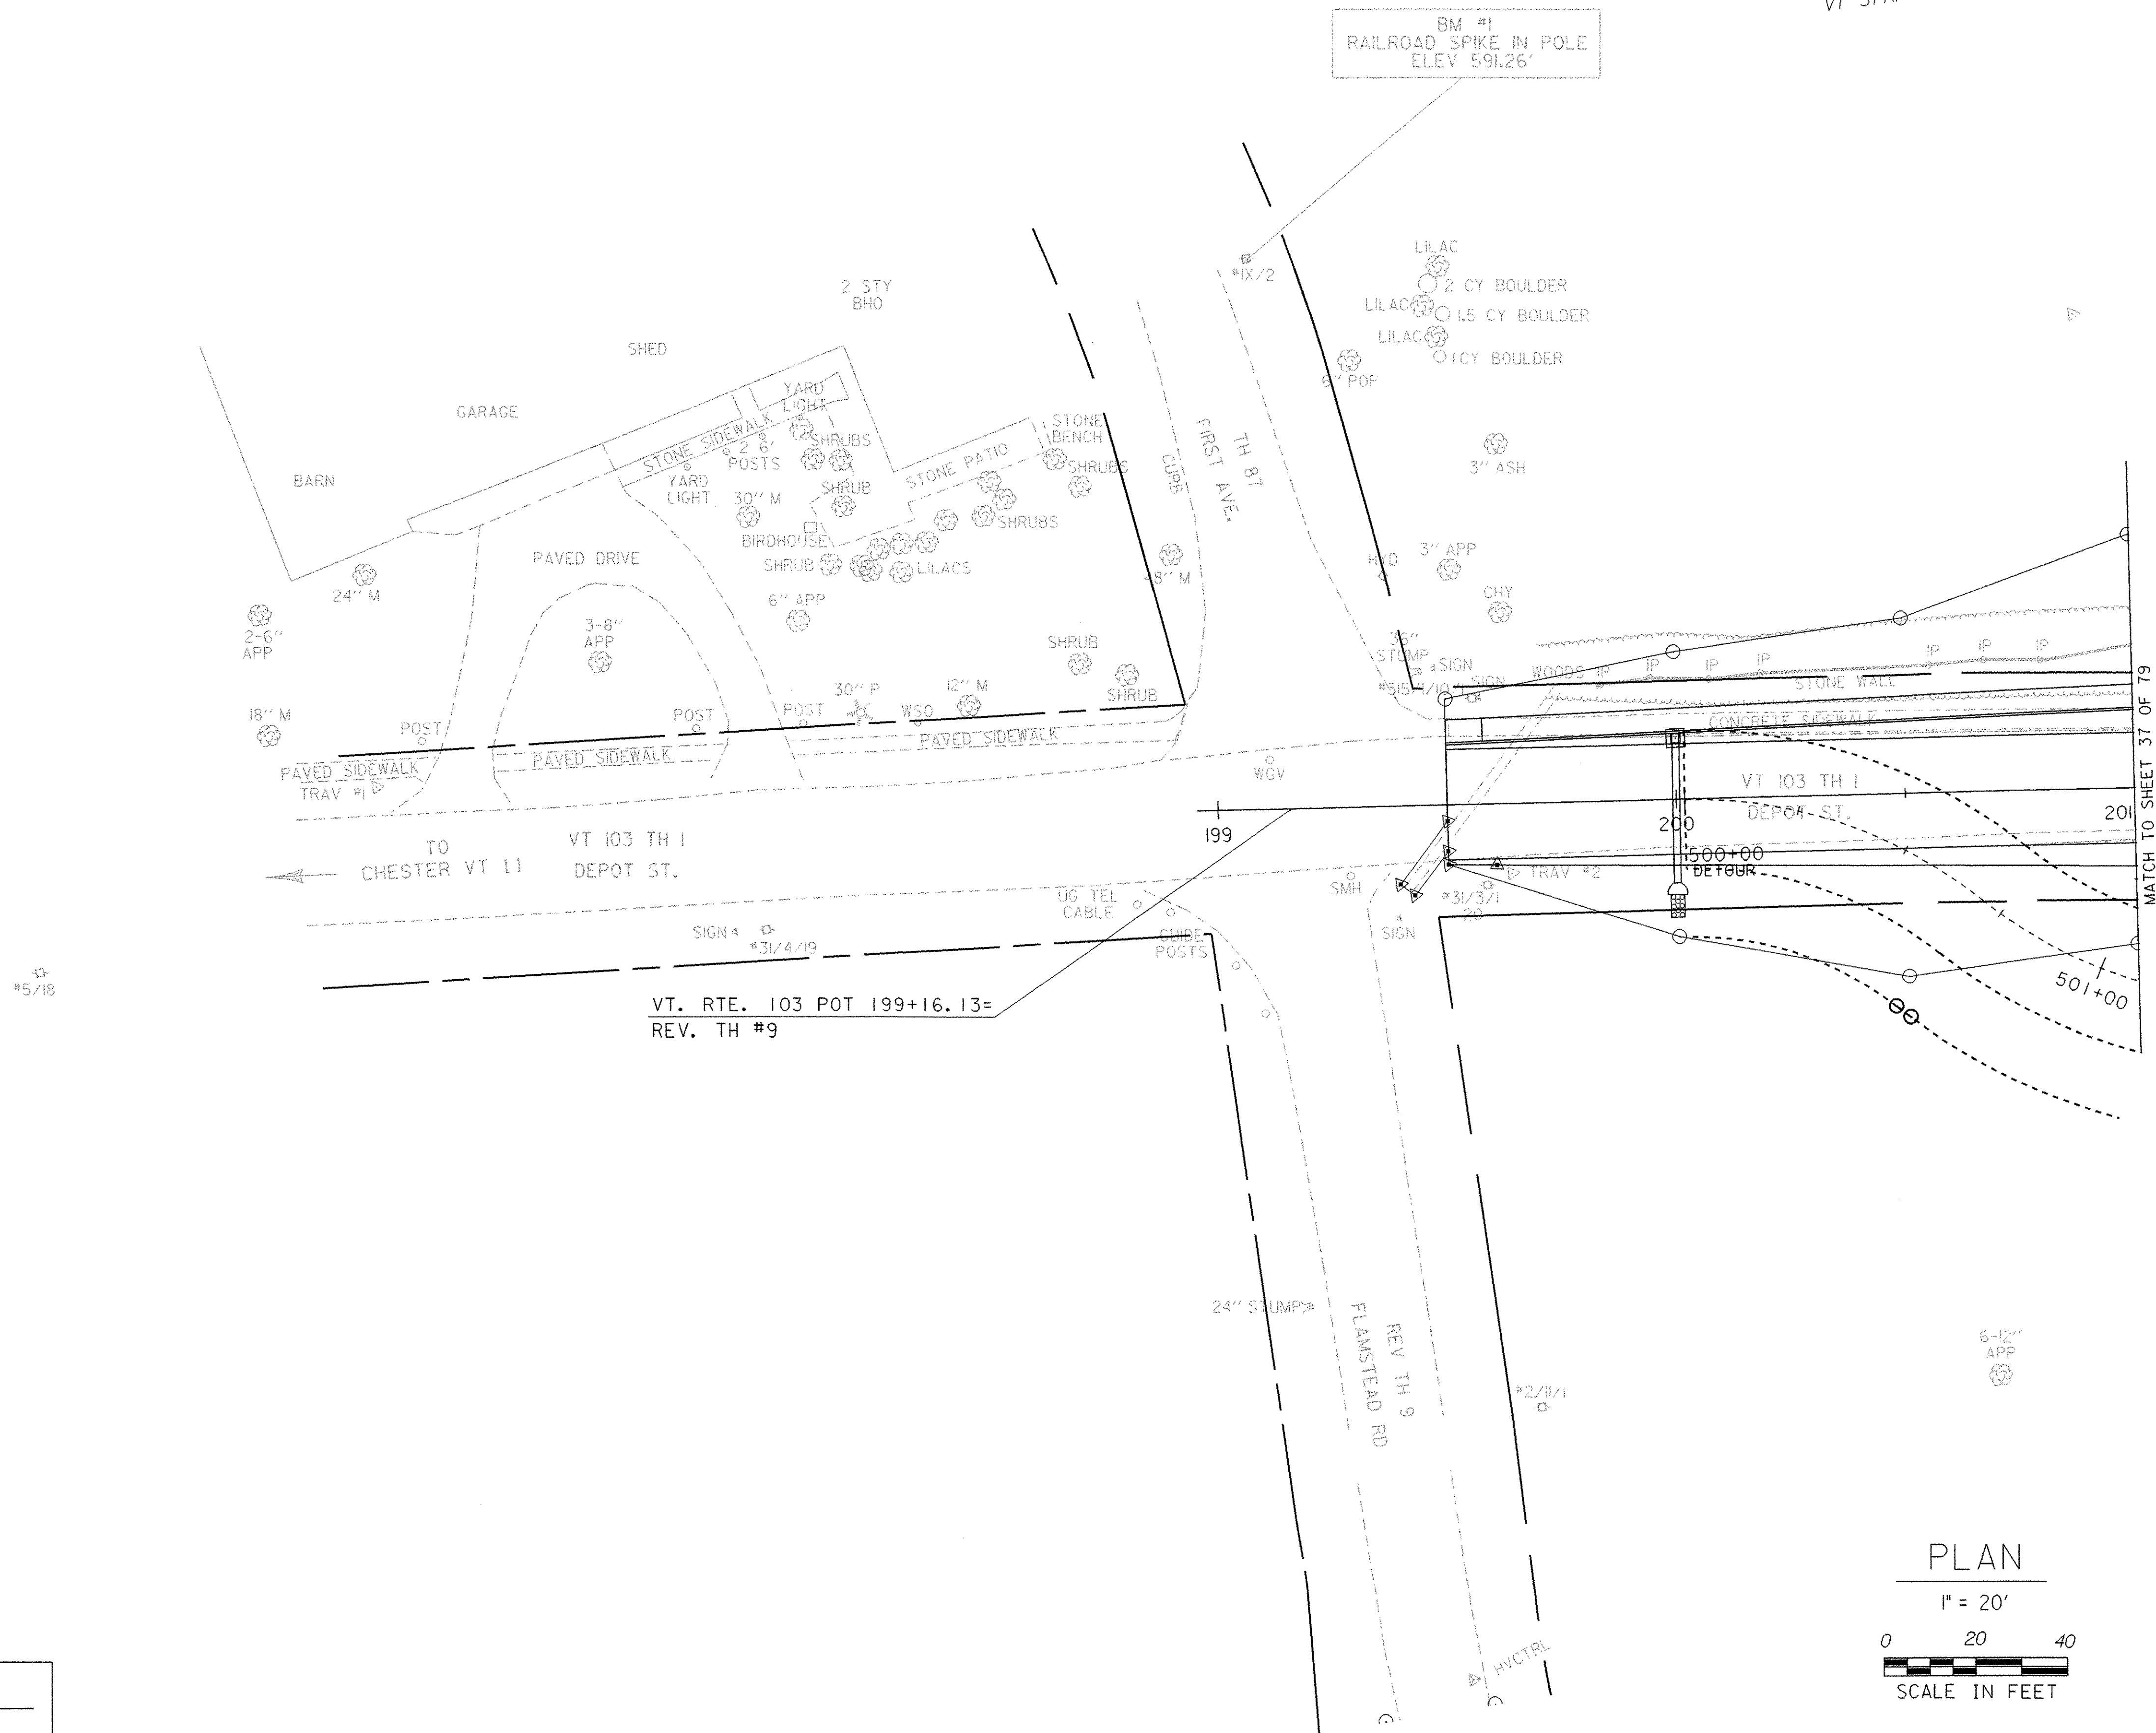

DATUM
VERTICAL NGVD 1929
HORIZONTAL NAD 1927

PLAN

1" = 20'

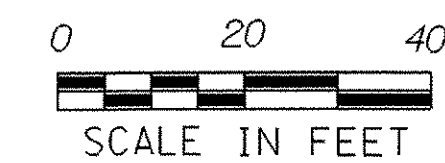

SURVEYED BY	SHERIDAN	DATE	08-90
DRAWN BY	L. BULLOCK	DATE	11-90
SQUAD LEADER	PORTALUPI		
DESIGN FILE NO.	M:\1549101\VA0T-Chester Curv		
PRF FILE	z:\f134u\l1	DATE PLOTTED	28-MAY-2003
PROJ. NAME	CHESTER		
PROJ. NO.	BRF 025-1(35)		
SHEET	36	OF	79 SHEETS